


Consultants:
 CIVIL:
 GLENN ENGINEERING CORP
 STRUCTURAL:
 SHW GROUP, LLP
 MEP:
 ESTES MCLURE AND ASSOCIATES.
 FOOD SERVICE:
 H. G. RICE Inc.
 LANDSCAPING:
 GRUBBS RAMSEY

FINAL PLANS
 FOR BIDDING AND CONSTRUCTION

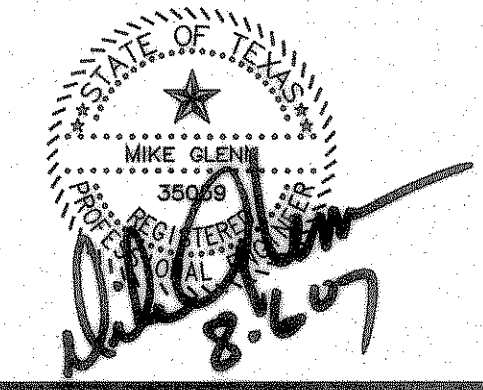

Rockwall Independent School District

ROCKWALL ELEMENTARY SCHOOL #12
 ROCKWALL, TEXAS

Project Number: 1441.05.020
 Drawing Date: 7/18/2006
 Drawn: R. HOWMAN
 Checked: RAH
 Scale: AS SHOWN
 ACAD File: FONTANNA-ENG-6_CITYcomments.d
 © 2006 SHW Group, LLP

Revisions:
 1 06/01/2006 CITY COMMENTS
 2 08/15/2006 CITY COMMENTS
 3 10/23/2006 WATER REVISIONS

RECORD DRAWING
 This is to certify that changes and corrections have been made to conform to the contractor's record of this project.
 Signed: *J. Glenn* 8-6-07
 Glenn Engineering Corporation



OVERALL SITE PLAN
 SCALE: 1" = 100'

LEGEND
 - BUILDING ENTRANCE
 - PROPOSED BUILDING OUTLINE
 - PROPOSED CONCRETE SIDEWALK
 NOTE:
 ADJACENT RESIDENTIAL DEVELOPER WILL INSTALL 6" WOOD SCREENING FENCE AS LOTS ARE DEVELOPED

Sheet Title:
OVERALL SITE PLAN

CS 1.00