


**BENCH MARKS:**

BENCHMARK:  
 SQUARE CUT ON TOP OF HEADWALL AT THE MOST NORTHERLY CORNER OF BRIDGE,  
 NORTHEASTERLY SIDE OF FM 205. 1860' +/- NORTHWEST OF CL. OF WINS ROAD.  
 ELEVATION = 529.11

BENCHMARK:  
 CITY OF ROCKWALL, TEXAS CONTROL MONUMENT #929. TOP OF HEADWALL IN NORTHWEST  
 CORNER OF BRIDGE OVER SQUABBLE CREEK. SOUTHWESTERLY SIDE OF FM 205.  
 ELEVATION = 524.55

These Drawings have been modified to conform to the  
 Construction Records.  
 Glenn Engineering Corporation  
 By *[Signature]* Date: 12-15-04

**DRAINAGE AREA MAP**  
 SCALE: 1" = 50'

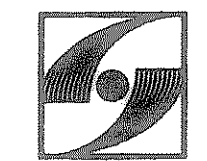


**GLENN  
 ENGINEERING**

PHONE 972-77-9881 FAX 972-77-6270  
 105 DECKER COURT - SUITE 100 PIANO, TEXAS 75082

DATE: May 8, 2003  
 DRAWN BY: TJC  
 CHECKED: TJC  
 CDMM NO: 144102110  
 REVISED: Aug. 12, 2003

**SPRINGER ELEMENTARY SCHOOL  
 ROCKWALL INDEPENDENT SCHOOL DISTRICT  
 ROCKWALL, TEXAS**

FINAL PLANS FOR BIDDING  
 AND CONSTRUCTION

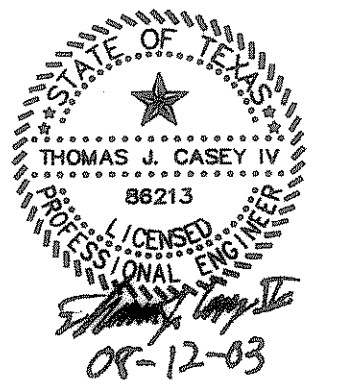

*[Signature]*  
**SHW Group Inc.**  
 Architects + Engineers

SHEET NUMBER **C**  
**2.11**  
 OF  
 SET NUMBER