


**SPRINGER ELEMENTARY SCHOOL  
 ROCKWALL INDEPENDENT SCHOOL DISTRICT  
 ROCKWALL, TEXAS**

FINAL PLANS FOR BIDDING AND CONSTRUCTION



**SHW Group Inc.**  
 Architects + Engineers

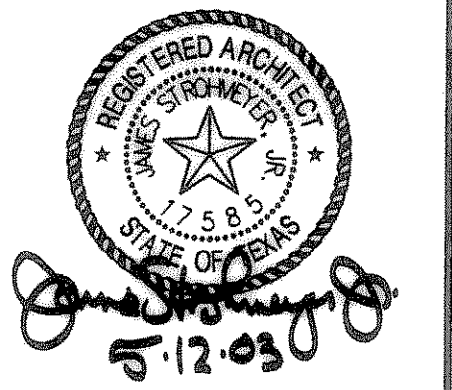