


NOTE:
 1. AT ALL LOCATIONS OF DOWNSPOUTS AND ROOF DRAINS A 6" PVC PIPE IS TO BE INSTALLED FROM THE 12" PVC LINE TO THE FOUNDATION AND EXTEND UP ABOVE THE FINISH FLOOR ELEV. SEE ARCH. PLAN FOR THE CONNECTION DETAIL AND THE ROOF PLAN FOR ACTUAL DOWNSPOUT AND ROOF DRAIN LOCATIONS.

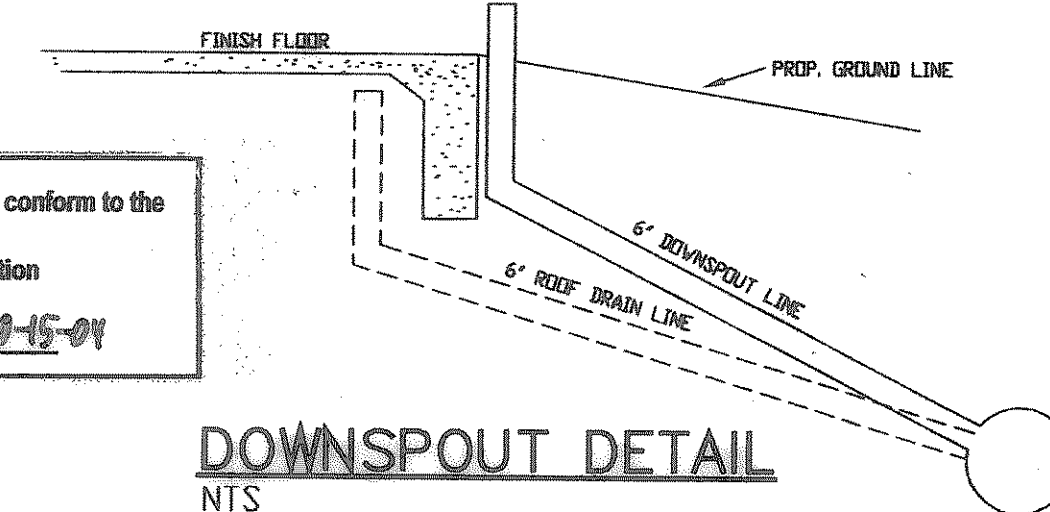

These Drawings have been modified to conform to the Construction Records.
 Glenn Engineering Corporation
 By *[Signature]* Date: 10-15-01

NOTE:
 SEE SHEET MB.0 FOR DOWNSPOUT & ROOF DRAIN LOCATIONS. ALL ROOF DRAINS & DOWNSPOUTS SHALL BE CONNECTED TO STORM SEWER SYSTEM.

BENCH MARKS:

BENCHMARK:
 SQUARE CUT ON TOP OF HEADWALL AT THE MOST NORTHERLY CORNER OF BRIDGE, NORTHEASTERLY SIDE OF FM 205. 1880 +/- NORTHWEST OF CL OF MIMS ROAD.
 ELEVATION = 529.11

BENCHMARK:
 CITY OF ROCKWALL, TEXAS CONTROL MONUMENT #929, TOP OF HEADWALL IN NORTHWEST CORNER OF BRIDGE OVER SQUABLE CREEK, SOUTHWESTERLY SIDE OF FM 205.
 ELEVATION = 524.55

STORM SEWER PROFILES


SCALE: 1" = 40' H
 1" = 5' V

GLENN ENGINEERING
 PHONE 972-717-8881 FAX 972-717-8778
 100 DECKER COURT - SUITE 810 IRVING, TEXAS 75062

DATE: May 8, 2003
 DRAWN BY: TJC
 CHECKED: TJC
 COMM NO: 144102110
 REVISION: Aug. 12, 2003

**SPRINGER ELEMENTARY SCHOOL
 ROCKWALL INDEPENDENT SCHOOL DISTRICT
 ROCKWALL, TEXAS**

FINAL PLANS FOR BIDDING AND CONSTRUCTION

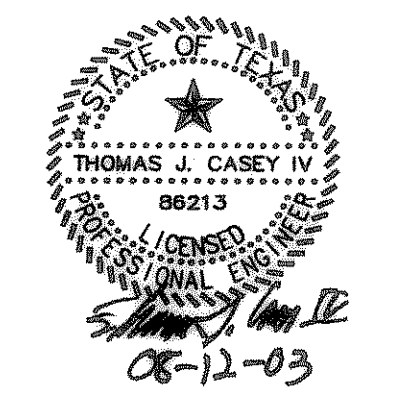

[Signature]
SHW Group Inc.
 Architects + Engineers

SHEET NUMBER: **C 2.14**
 OF: _____
 SET NUMBER: _____