

DATE: May 8, 2003
 DRAWN BY: TJC
 CHECKED: TJC
 CDM NO: 144102110
 REVISED:

**SPRINGER ELEMENTARY SCHOOL
 ROCKWALL INDEPENDENT SCHOOL DISTRICT
 ROCKWALL, TEXAS**


GENERAL TOPOGRAPHIC NOTES

1. TOPOGRAPHIC SURVEY BY DOWDEY, ANDERSON & ASSOCIATES, INC., 5225 VILLAGE CREEK DRIVE, STE 200, PLANO TEXAS, (972)-931-0694
2. LIMESTONE HILL LANE TO BE CONSTRUCTED BY OTHERS IN ACCORDANCE WITH PLANS PREPARED BY DOWDEY, ANDERSON & ASSOCIATES, INC.
3. SPOT GRADES SHOWN ON LIMESTONE HILL LANE AND ADJACENT RESIDENTIAL SUBDIVISION, HICKORY RIDGE PHASE FOUR, LOTS 12, 13, 14, 15 & 16 BASED ON GRADING PLANS PREPARED BY DOWDEY, ANDERSON & ASSOCIATES, INC.

FOR INFORMATION ONLY

These Drawings have been modified to conform to the Construction Records.
 Glenn Engineering Corporation
 By: [Signature] Date: 10-15-04

TOPOGRAPHIC SURVEY
 SCALE: 1" = 40'

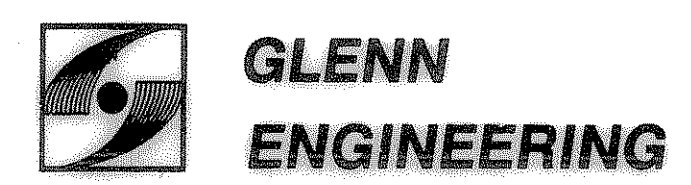

PHONE 972-717-9181 FAX 972-717-2178
 105 DECKER COURT - SUITE 910 ROCKWALL, TEXAS 75082

Delta=0'13'50"
 R=1150.16'
 T=23.16'
 L=46.32'
 Chd=N42°10'30"W 46.32'

FINAL PLANS FOR BIDDING AND CONSTRUCTION



SHEET NUMBER: **C**
2.0
 OF 32
 SET NUMBER