

WATER PROFILE

SCALE: 1" = 40' H
1" = 5' V

BENCH MARKS:

BENCHMARK:
SQUARE CUT ON TOP OF HEADWALL AT THE MOST NORTHERLY CORNER OF BRIDGE,
NORTHEASTERLY SIDE OF FM 205. 1680' +/- NORTHWEST OF CL OF MIMS ROAD.
ELEVATION = 529.11


BENCHMARK:
CITY OF ROCKWALL, TEXAS CONTROL MONUMENT #929, TOP OF HEADWALL IN NORTHWEST
CORNER OF BRIDGE OVER SQUABBLE CREEK, SOUTHWESTERLY SIDE OF FM 205.
ELEVATION = 524.55

These Drawings have been modified to conform to the
Construction Records.
Glenn Engineering Corporation
By: *[Signature]* Date: 11-15-01

**GLENN
ENGINEERING**
PHONE 972-777-5101 FAX 972-777-2706
335 DECKER COURT - SUITE 810 IRVING, TEXAS 75062

SHEET NUMBER **C**
2.21
OF
SET NUMBER

FINAL PLANS FOR BIDDING
AND CONSTRUCTION

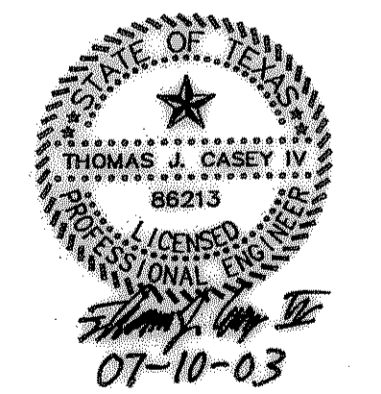

**SPRINGER ELEMENTARY SCHOOL
ROCKWALL INDEPENDENT SCHOOL DISTRICT
ROCKWALL, TEXAS**

DATE: May 8, 2003
DRAWN BY: TJC
CHECKED: TJC
CADD NO: 144102110
REVISED: May 23, 2003