

Copyright Reserved
 The Contractor shall verify and be responsible for all dimensions. DO NOT scale the drawing - any errors or omissions shall be reported to Stantec without delay.
 The Copyrights to all designs and drawings are the property of Stantec. Reproduction or use for any purpose other than that authorized by Stantec is forbidden.


Consultants
GLENN ENGINEERING
 T.B.P.E. FIRM REGISTRATION NO. F - 303
 PHONE 972-717-5151 FAX 972-717-2176
 4500 FULLER DRIVE - SUITE 220 IRVING, TEXAS 75038

Notes

8 - RFI #40 RAH CMG 2020.05.13
 7 - RFI #79 - PC 20 - REV RAH CMG 2020.03.13
 6 - RFI #116 AND #117 RAH CMG 2020.01.13
 5 - RFI #20 AND #21 RAH CMG 2019.07.23
 4 - RFI #16 RAH CMG 2019.07.12
 3 - CITY COMMENTS RAH CMG 2019.04.30
 2 - ASI #1 - CITY COMMENTS RAH CMG 2019.04.02

Revision By Appd YYYY.MM.DD

100%CD - For Bidding and Construction RAH CMG 2019.03.01
 Issued By Appd YYYY.MM.DD

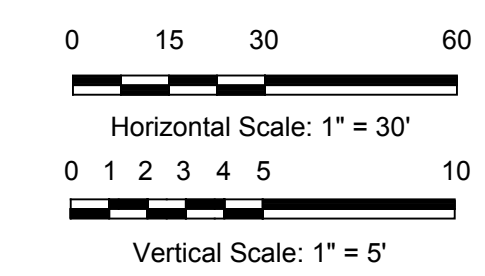

RECORD DRAWING
 THIS IS TO CERTIFY THAT CHANGES AND CORRECTIONS HAVE BEEN MADE TO CONFORM TO THE CONTRACTOR'S RECORD OF THIS PROJECT.
 SIGN: *Charlynn Amis*
 DATE: 06/01/2020
 Glenn Engineering Corporation

Permit-Seal

 Client/Project
 Rockwall ISD
 Elementary School #15
 2911 Greenway Drive
 Rockwall, TX 75087
 Title
SANITARY SEWER PROFILES
 Project No. 214000654 Scale AS SHOWN
 Revision Drawing No.

Plotted: Jun 1, 2020, 1:58 PM by user: jphn - Saved: 6/1/2020 by user: jphn
 R:\ROCKWALL\STONE CREEK ELEM\BID\STONE CREEK ELEM ENG - RECORD SET.dwg