


*MODIFICATION

1. INSTALL GREEN EMS DISK AT PROPERTY LINE

2. WYES ONLY. NO TEES



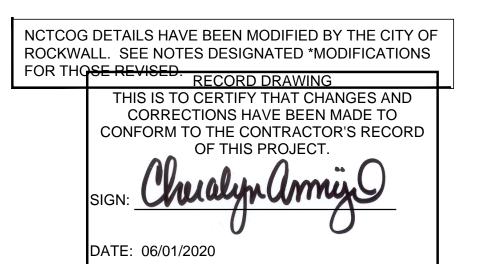

Stantec Architecture Inc.
5717 Legacy Drive Suite 250
Plano, TX 75024-4246
Tel: (214) 473-2400 / Fax: (214) 473-2401
www.stantec.com

Copyright Reserved

The Contractor shall verify and be responsible for all dimensions. DO NOT scale the drawing - any errors or omissions shall be reported to Stantec without delay.

The Copyrights to all designs and drawings are the property of Stantec. Reproduction or use for any purpose other than that authorized by Stantec is forbidden.

Consultants



FAX 972-717-2176

IRVING, TEXAS 75038

PHONE 972-717-5151 4500 FULLER DRIVE - SUITE 220

Notes

Notes


8 - RFI #40	RAH	CMG	2020.05.13
7 - RFI #79 - PC 20 - REV	RAH	CMG	2020.03.13
6 - RFI #116 AND #117	RAH	CMG	2020.01.13
5 - RFI #20 AND #21	RAH	CMG	2019.07.23
4 - RFI #16	RAH	CMG	2019.07.12
3 - CITY COMMENTS	RAH	CMG	2019.04.30
2 - ASI #1 -CITY COMMENTS	RAH	CMG	2019.04.02
Revision	Ву	Appd	YYYY.MM.DD

100%CD - For Bidding and ConstructionRAHCMG2019.03.01IssuedByAppdYYYY.MM.DD

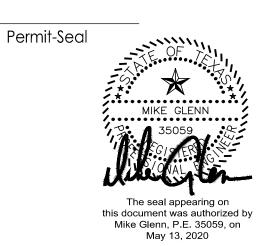

Client/Project
Rockwall ISD

Elementary School #15

2911 Greenway Drive

Title

Rockwall, TX 75087

SANITARY SEWER DETAILS

Project No. Scale
214000654 AS SHOWN

Revision Drawing No.



05.11

NOTE: THE CITY OF ROCKWALL CONSTRUCTION STANDARDS APPLY, WHETHER INDICATED ON THESE PLANS OR NOT.

6