

Copyright Reserved

The Contractor shall verify and be responsible for all dimensions. DO NOT scale the drawing - any errors or omissions shall be reported to Stantec without delay. The Copyrights to all designs and drawings are the property of Stantec. Reproduction or use for any purpose other than that authorized by Stantec is forbidden.

Consultants



T.B.P.E. FIRM REGISTRATION NO. F - 303

PHONE 972-717-5151 FAX 972-717-5178  
4500 FULLER DRIVE - SUITE 220 IRVING, TEXAS 75038

Notes



Revision	By	Appd	YYYY.MM.DD
8 - RH #40	RAH	CMG	2020.05.13
7 - RH #79 - PC 20 - REV	RAH	CMG	2020.03.13
6 - RH #116 AND #117	RAH	CMG	2020.01.13
5 - RH #20 AND #21	RAH	CMG	2019.07.23
4 - RH #16	RAH	CMG	2019.07.12
3 - CITY COMMENTS	RAH	CMG	2019.04.30
2 - ASI #1 - CITY COMMENTS	RAH	CMG	2019.04.02

Revision	By	Appd	YYYY.MM.DD
100%CD - For Bidding and Construction	RAH	CMG	2019.03.01

Issued

Permit-Seal



The seal appearing on this document was authorized by Mike Glenn, P.E. 35059, on May 13, 2020

Client/Project

Rockwall ISD

Elementary School #15

2911 Greenway Drive  
Rockwall, TX 75087

Title

PAVING PLAN

Project No.

214000654

Revision

8

Scale

AS SHOWN

Drawing No.

C

06.00

**GENERAL PAVING NOTES:**

THE INITIAL SOIL TEST AND REPORT BY FUGRO SOUTH, INC. PROJECT NO.0703-1081 AND ANY AND ALL SUBSEQUENT REPORTS PREPARED FOR THIS PROJECT BY FUGRO SOUTH OR BY OTHER FIRM, AGENCY OR ENTITY, EVEN THOUGH NO SPECIFIC REFERENCE TO ANY SUCH REPORTS ARE CONTAINED IN THE PLANS, AND/OR SPECIFICATIONS FOR THIS PROJECT, ARE A PART OF THIS PLAN. A COPY CAN BE OBTAINED THROUGH THE ARCHITECT OR ENGINEER.

I. PAVEMENT SUB GRADE FOR A & B, BELOW

THE CLAY SOILS ENCOUNTERED NEAR THE EXISTING GROUND SURFACE WILL PROBABLY CONSTITUTE THE SUB GRADE FOR MOST OF THE PARKING AND DRIVE AREAS. THEREFORE, IT IS RECOMMENDED THAT THESE SOILS BE IMPROVED PRIOR TO CONSTRUCTION OF THE PAVEMENTS

IT IS RECOMMENDED THAT THE EXISTING CLAY SOILS IN DRIVE AND PARKING AREAS BE EXCAVATED TO ACHIEVE FINAL SUB GRADE ELEVATION. THE EXPOSED SURFACE OF THE CLAYS SHOULD BE SCARIFIED TO A DEPTH OF AT LEAST 6 INCHES AND MIXED WITH AN ESTIMATED 7 PERCENT OF HYDRATED LIME (BY DRY UNIT WEIGHT) IN CONFORMANCE WITH TEXAS HIGHWAY DEPARTMENT ITEM 200. ASSUMING AN IN PLACE UNIT WEIGHT OF 100 PCF FOR THE PAVEMENT SUB GRADE SOILS, THIS PERCENTAGE OF LIME EQUATES TO ABOUT 32 LBS OF LIME PER SQ. YARD OF SUB GRADE TREATED. THE ACTUAL AMOUNT OF LIME REQUIRED SHOULD BE DETERMINED BY ADDITIONAL LABORATORY TESTS. IT IS RECOMMENDED THAT THE LIME STABILIZATION PROCEDURES EXTEND AT LEAST 4 FT. BEYOND THE EDGE OF THE PAVEMENT TO MINIMIZE THE EFFECTS OF SEASONAL SHRINKING UPON THE EXTREME EDGES OF PAVEMENT. THE SOIL-LIME MIXTURE SHOULD THEN BE COMPACTED TO AT LEAST 95 PERCENT OF STANDARD PROCTOR MAXIMUM DRY DENSITY (ASTM D 698) WITHIN 3 PERCENTAGE POINTS OF THE OPTIMUM MOISTURE CONTENT. IN ALL AREAS WHERE HYDRATED LIME IS USED TO STABILIZE THE SUB GRADE SOILS, ROUTINE ATTERBERG-LIMIT TESTS SHOULD BE PERFORMED TO ASSURE THAT THE RESULTING PLASTICITY INDEX OF THE SOIL-LIME MIXTURE IS AT OR BELOW 15.

THE CLIENT SHOULD BE AWARE THAT MECHANICAL LIME STABILIZATION OF THE PAVEMENT SUB GRADE SOILS WILL NOT PREVENT DEEP SEATED MOVEMENT OF THE UNDERLYING UNTREATED MATERIALS. FUTURE MAINTENANCE OF PAVEMENTS SHOULD BE EXPECTED OVER THE LIFE OF THE STRUCTURE.

II. PAVING

CONCRETE DRIVEWAY APPROACHES SHALL BE A MINIMUM OF 6 INCHES THICK. CONCRETE DRIVEWAY APPROACHES SHALL HAVE A RISE OF NOT LESS THAN 6 INCHES NOR MORE THAN 9 INCHES FROM THE FLOW LINE OF THE GUTTER TO A POINT 10 FEET BEHIND THE FACE OF THE GUTTER. CONCRETE FOR DRIVEWAYS SHALL BE A MINIMUM OF 3,600 PSI, MIN. 6.5 SACK MIX, IN 28 DAYS CONCRETE WITH 3-6 PERCENT ENTRAINED AIR. THE GRADE BELOW THE DRIVEWAY, INCLUDING 4 FOOT OUTWAY SHALL BE COMPACTED TO 95% STANDARD PROCTOR DENSITY, AND AS INDICATED IN THE "PAVEMENT SUB GRADE NOTES".

DRIVEWAYS SHALL HAVE CONTRACTION JOINTS NOT MORE THAN 15 FEET APART, BOTH TRANSVERSELY AND LONGITUDINALLY ONE-HALF INCH EXPANSION JOINT SHALL BE PLACED ON THE PROPERTY LINES BETWEEN THE APPROACH AND THE DRIVEWAY. THE JOINTS SHALL BE FILLED WITH PRE MOLDED GRAY BITUMINOUS EXPANSION JOINT FILLER AND SHALL EXTEND THE ENTIRE DEPTH AND LENGTH OF THE CONCRETE SECTIONS.

A. FINISHING SHALL BE AS INDICATED IN SECTION III.

NOTE: NO CONCRETE SHALL BE PLACED FOR PAVING UNTIL THE SUB GRADE, REINFORCEMENT PLACEMENT HAS BEEN INSPECTED AND APPROVED BY THE CITY OR STATE (WHICHEVER IS APPLICABLE).

B. PARKING LOTS

PARKING LOT SUB GRADE SHALL BE AS INDICATED IN SECTION I.

PAVING SHALL BE 5" REINFORCED CONCRETE IN LIGHT TRAFFIC AREAS AND 6" REINFORCED CONCRETE IN HEAVY TRAFFIC AREAS 3,600 PSI, MIN. 6.5 SACK MIX. IN 28 DAYS CONCRETE WITH 3-6% ENTRAINED AIR. JOINTS SHALL BE FILLED WITH 1/2" INCH PRE MOLDED GRAY BITUMINOUS EXPANSION JOINT FILLER AND SHALL EXTEND THE ENTIRE DEPTH AND WIDTH OF THE CONCRETE SECTION.

FINISHING SHALL BE AS INDICATED IN SECTION III.

C. ON-SITE SIDEWALKS

CONCRETE SIDEWALKS SHALL BE A WIDTH AS DESIGNATED ON SITE PLAN AND A MINIMUM OF 4 INCHES THICK, CONSTRUCTED OF 3,600 PSI (6.5 SACK), IN 28 DAYS CONCRETE WITH 3-6% ENTRAINED AIR AND REINFORCED WITH #3 BARS AT 18" O.C.E.W. TOoled CONSTRUCTION JOINTS SHALL BE 5'-0" O.C. ONE-HALF INCH EXPANSION JOINT SHALL BE PLACED EVERY 40 FEET AND WHERE NEW WORK IS CONSTRUCTED ADJACENT TO OTHER CONCRETE WORK (WALLS, FOUNDATION CURB, ETC.) THE JOINTS SHALL BE FILLED WITH 1/2" INCH PRE MOLDED GRAY BITUMINOUS EXPANSION JOINT FILLER AND SHALL EXTEND THE ENTIRE DEPTH AND WIDTH OF THE CONCRETE SECTION.

NISH OF SIDEWALKS SHALL BE WITH A BROOM FINISH PER ENGINEER. WALKS SHALL HAVE TOLED CURB EDGES & TOLED JOINTS.

FINISHING FOR CONCRETE DRIVEWAY, PARKING LOT AND STREET CURBS

THE EXPOSED SURFACES OF DRIVEWAYS AND PARKING LOT SHALL HAVE A MONOLITHIC FINISH BY FLOATING WITH A WOODEN FLAT UNTIL A SLIGHT EXCESS OF SAND APPEARS ON THE SURFACES. IN NO CASE SHALL THE SURFACE BE LEFT SLICK OR WITH A GLOSSY FINISH. EXPOSED SURFACES OF SIDEWALKS SHALL HAVE A MONOLITHIC FINISH BY TROWLING WITH A STEEL TROWEL AND BRUSHED LIGHTLY WITH AN APPROVED BROOM. THE EDGE OF ALL CONCRETE SHALL BE NEATLY ROUNDED TO THE REQUIRED RADI WITH AN EDGING TOOL.

THE EXPOSED SURFACE OF CURBS AND CURBS WITH GUTTER SHALL BE SHAPED WITH A "MULE" AND BRUSHED WITH A WET BRUSH AT RIGHT ANGLE TO THE LINE OF THE CURB TO PRODUCE A UNIFORM TEXTURED SURFACE. THE EDGES SHALL BE NEATLY ROUNDED OFF TO THE REQUIRED RADI. USE OF GROUT OVER A ROUGH FINISHED TEXTURE WILL NOT BE TOLERATED.

RECORD DRAWING  
THIS IS TO CERTIFY THAT CHANGES AND CORRECTIONS HAVE BEEN MADE TO CONFORM TO THE CONTRACTOR'S RECORD OF THIS PROJECT.  
*Cheryl Armijo*  
SIGN: \_\_\_\_\_  
DATE: 06/01/2020  
Glenn Engineering Corporation

**PAVING LEGEND**


	PROPOSED 6" REINFORCED CONCRETE PAVEMENT 3,600 P.S.I. CONCRETE, 6 1/2 SACK HAND FINISH 6 SACK MACHINE FINISH WITH #4 REBARS ON 18" CENTERS EACH WAY OVER 6 INCHES 6% LIME STABILIZED SUBGRADE PER CITY STANDARDS
	PROPOSED 5" REINFORCED CONCRETE PAVEMENT 3,600 P.S.I. CONCRETE, 6 1/2 SACK HAND FINISH 6 SACK MACHINE FINISH WITH #4 REBARS ON 18" CENTERS EACH WAY OVER 6 INCHES 6% LIME STABILIZED SUBGRADE PER CITY STANDARDS
	PROPOSED 4" REINFORCED CONCRETE PAVEMENT 3,600 P.S.I. CONCRETE, 6 1/2 SACK HAND FINISH 6 SACK MACHINE FINISH WITH #4 REBARS ON 18" CENTERS EACH WAY OVER 6 INCHES 6% LIME STABILIZED SUBGRADE PER CITY STANDARDS
	PROPOSED 7" REINFORCED CONCRETE PAVEMENT 3,600 P.S.I. CONCRETE, 6 1/2 SACK HAND FINISH 6 SACK MACHINE FINISH WITH #4 REBARS ON 18" CENTERS EACH WAY OVER 6 INCHES 6% LIME STABILIZED SUBGRADE PER CITY STANDARDS (PUBLIC STREET PAVING)
	PROPOSED 9" REINFORCED CONCRETE PAVEMENT 3,600 P.S.I. CONCRETE, 6 1/2 SACK HAND FINISH 6 SACK MACHINE FINISH WITH #4 REBARS ON 18" CENTERS EACH WAY. (FIRE LANE PAVING)

PAVING ALTERNATE: DELETE LIME AS CALL OUT ABOVE AND ADD AN ADDITIONAL CONCRETE TO ALL PAVING DEPTH CALL OUT ABOVE.

NOTE: NO SAND WILL BE PERMITTED UNDER PAVEMENT.

NOTE: SEE LANDSCAPE PLAN LS 1.01 FOR SLEEVES UNDER ALL PAVING WALKS, DRIVES AND PARKING. SEE M.E.P. PLANS ES 1.01 FOR ALL SLEEVE LOCATIONS FOR LIGHTING.

NOTE:  
1. ALL DETENTION FACILITIES SHALL BE INSTALLED AND FUNCTIONAL PER PLANS PRIOR TO ANY PAVING BEING PLACED ON SITE INCLUDING BUILDING FOUNDATION.  
2. ALL SIDES, SLOPES AND TOP OF DETENTION BASIN SHALL BE SODDED OR ANCHORED ON SEEDED CURLEX PRIOR TO ANY PAVING BEING PLACED INCLUDING BUILDING FOUNDATION.  
3. WHERE SIDEWALKS ARE ABUTTING CURB, SIDEWALK WILL BE DOWELED INTO CURB. SEE DETAIL C06.03

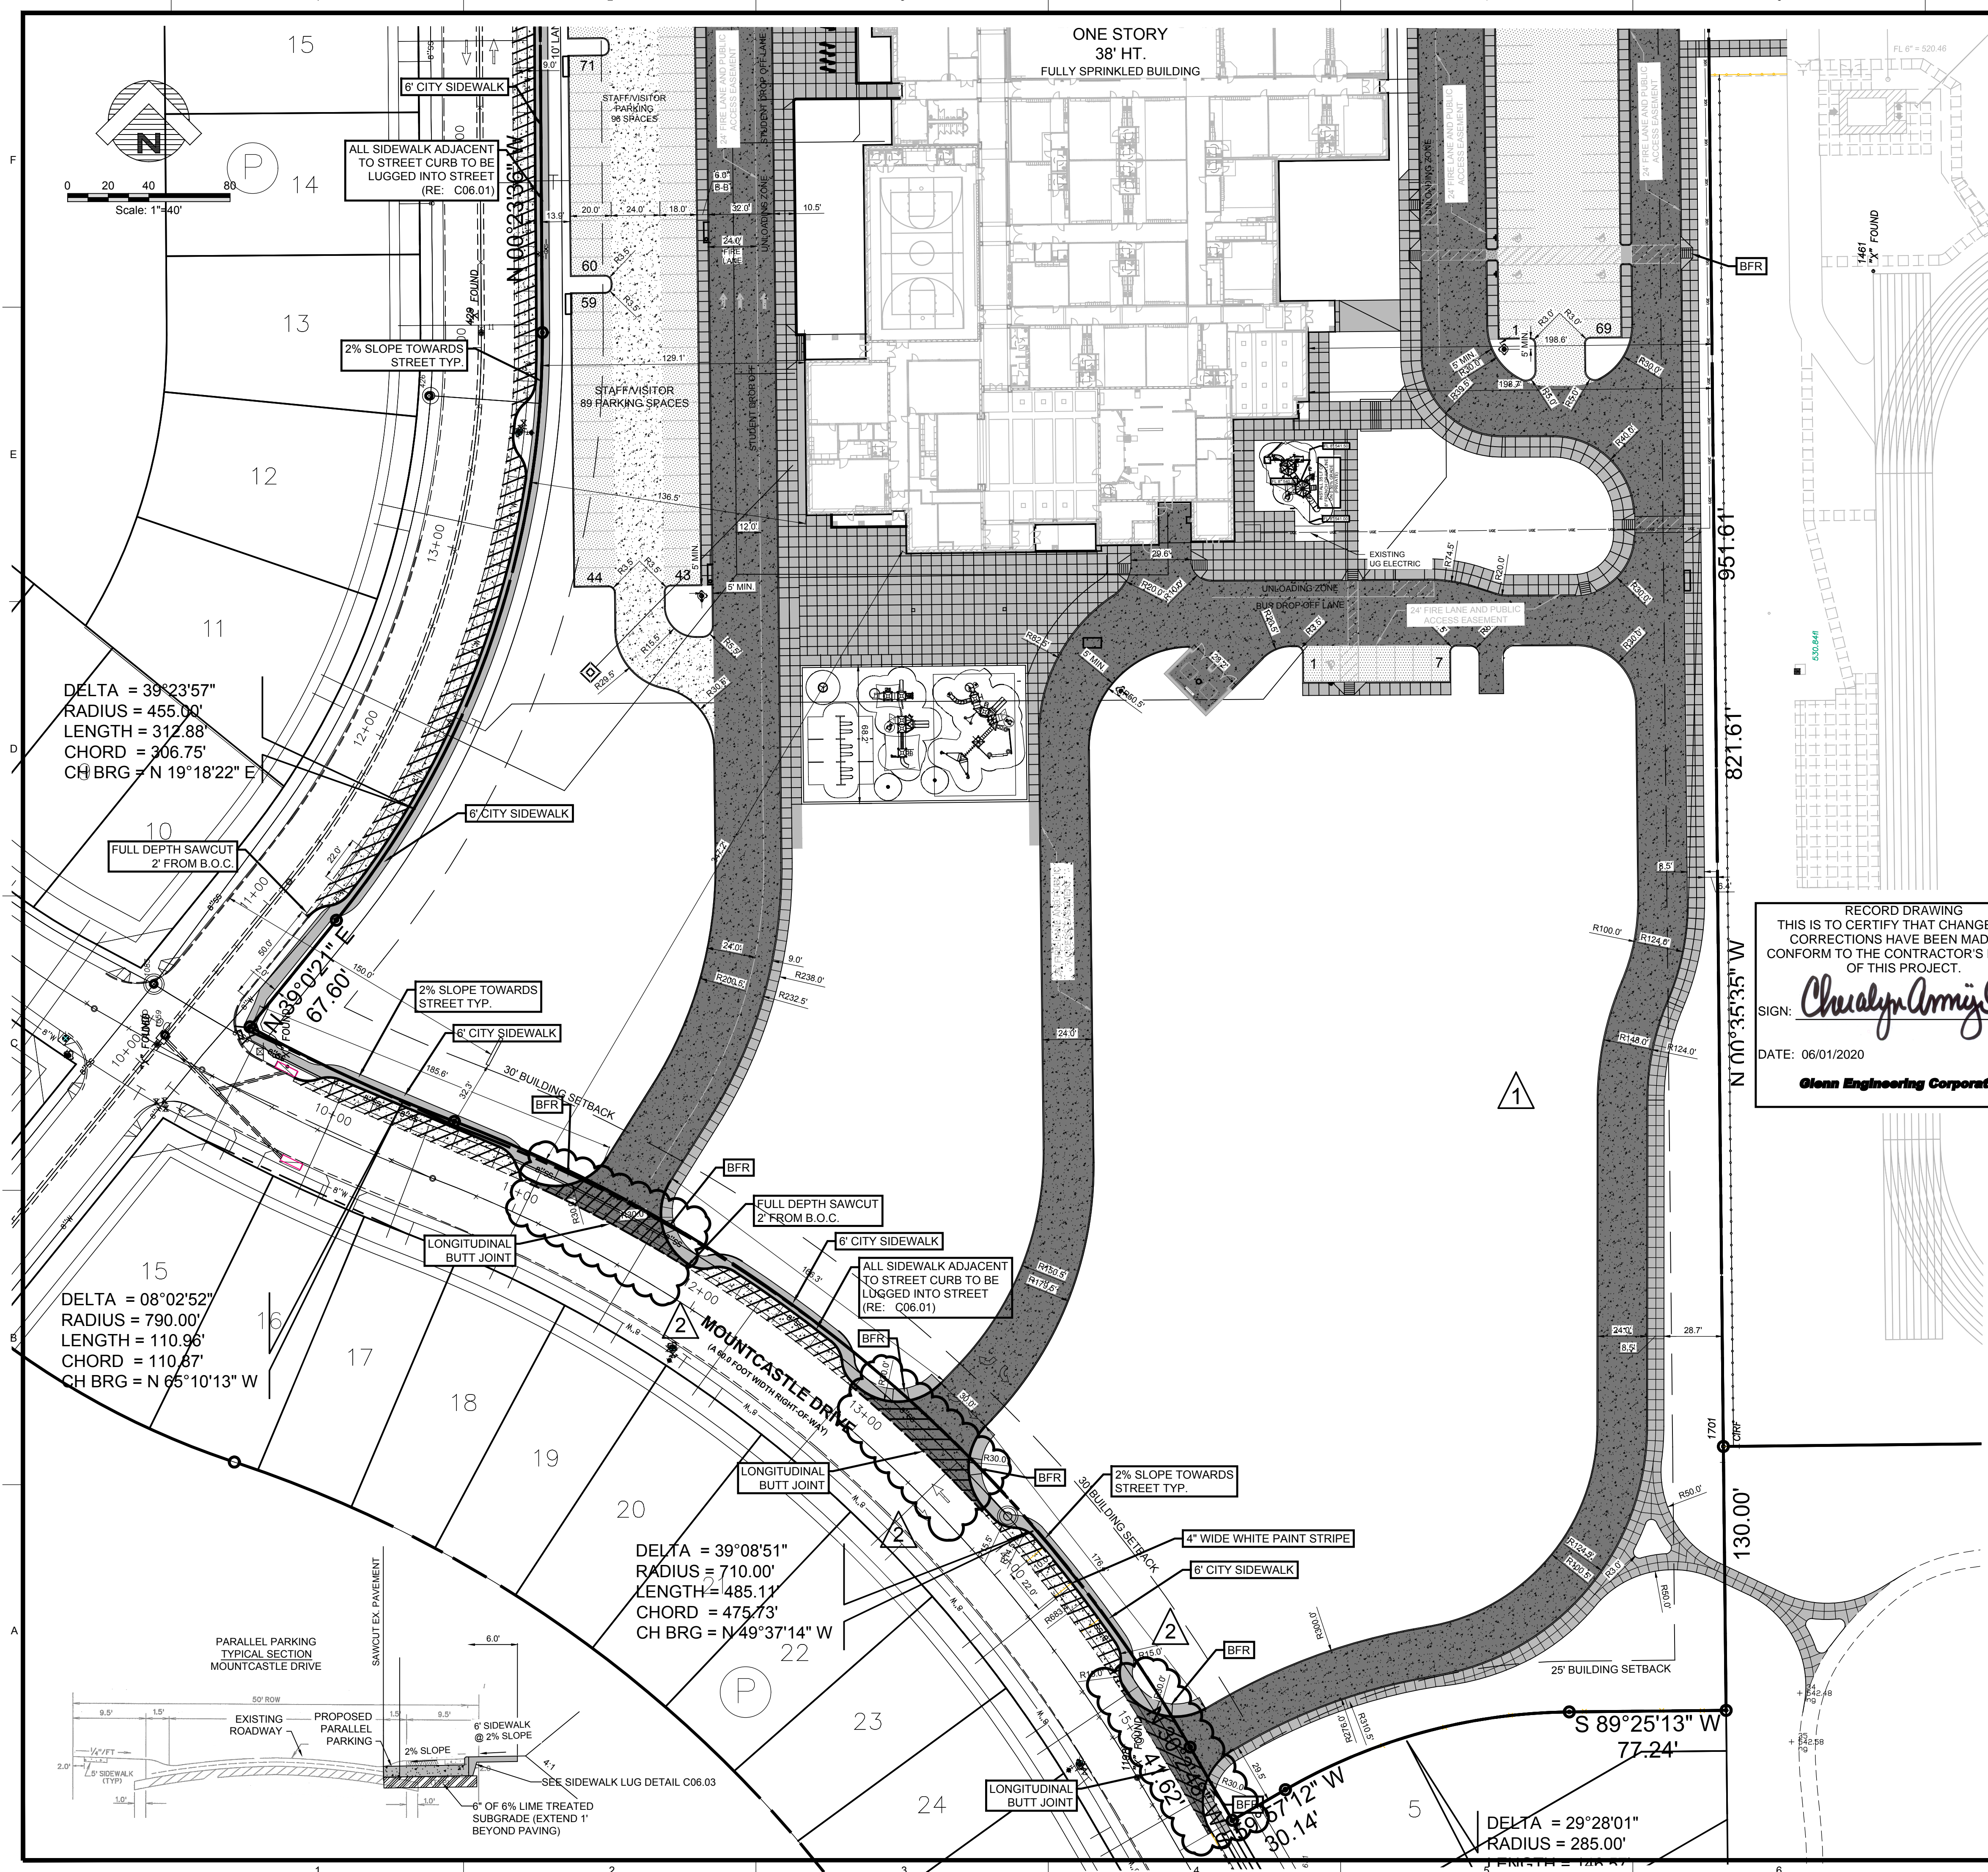

Plotted: Jun 1, 2020, 2:3 PM by user: pohn - Saved: 6/1/2020 by user: pohn  
 R:\ROCKWALL\STONE CREEK\ELMIDSET\STONE CREEK\ELM ENG - RECORD SET.dwg