


- GENERAL NOTES:**
1. STRIPING & SIGNAGE DIMENSIONS ARE FROM FACE OF CURB
 2. ALL FIRE LANES, PARKING STRIPING, HOCP PARKING STRIPING & SIGNAGE ARE TO BE IN ACCORDANCE WITH CITY OF ROCKWALL REQUIREMENTS, TYP.
 3. PRIOR TO ANY CONSTRUCTION THE CONTRACTOR SHALL FAMILIARIZE HIMSELF WITH THE CONTRACT DOCUMENTS AND SPECIFICATIONS, THE PLANS INCLUDING ALL NOTES, THE CITY OF ROCKWALL SPECIFICATIONS AND ANY OTHER APPLICABLE STANDARDS OR SPECIFICATIONS RELEVANT TO THE PROPER COMPLETION OF THE WORK SPECIFIED. FAILURE ON THE PART OF THE CONTRACTOR TO FAMILIARIZE HIMSELF WITH ALL STANDARDS OR SPECIFICATIONS PERTAINING TO THIS WORK SHALL IN NO WAY RELIEVE THE CONTRACTOR OF RESPONSIBILITY FOR PERFORMING THE WORK IN ACCORDANCE WITH ALL SUCH APPLICABLE STANDARDS AND SPECIFICATIONS.
 4. CONTRACTOR SHALL HAVE IN HIS POSSESSION, PRIOR TO CONSTRUCTION, ALL NECESSARY PERMITS, LICENSES, ETC. CONTRACTOR SHALL HAVE AT LEAST ONE SET OF APPROVED ENGINEERING PLANS AND SPECIFICATIONS ON-SITE AT ALL TIMES.
 5. ALL WORK SHALL CONFORM TO THE CITY OF ROCKWALL SPECIFICATIONS, STANDARDS, AND DETAILS.
 6. IF UNFORESEEN PROBLEMS OR CONFLICTS ARE ENCOUNTERED IN THE CONSTRUCTION, FOR WHICH AN IMMEDIATE SOLUTION IS NOT APPARENT, THE ENGINEER AND OWNER SHALL BE NOTIFIED IMMEDIATELY.
 7. IT WILL BE THE RESPONSIBILITY OF EACH CONTRACTOR TO PROTECT ALL EXISTING PUBLIC AND PRIVATE UTILITIES THROUGHOUT THE CONSTRUCTION OF THIS PROJECT. CONTRACTOR SHALL CONTACT THE APPROPRIATE UTILITY COMPANIES FOR LINE LOCATIONS, PRIOR TO COMMENCEMENT OF CONSTRUCTION AND SHALL ASSUME FULL LIABILITY TO THOSE COMPANIES FOR ANY DAMAGES CAUSED TO THEIR FACILITIES.
 8. CONTRACTORS SHALL BE RESPONSIBLE FOR FIELD LOCATING EXISTING UTILITIES AND IMPROVEMENTS PRIOR TO CONSTRUCTION.
 9. TRENCH SAFETY DESIGN WILL BE THE RESPONSIBILITY OF THE UTILITY CONTRACTOR. CONTRACTOR SHALL SUBMIT DESIGN TO THE CITY OF ROCKWALL ENGINEERING DEPARTMENT FOR REVIEW.
 10. ALL FIRE LANES SHALL BE 3600 PSI CONCRETE WITH MINIMUM 6 SACK FOR MACHINE PLACEMENT 6 1/2 SACK FOR HAND PLACEMENT IN ACCORDANCE WITH THE CITY OF ROCKWALL STANDARDS.
 11. MARK FIRE LANE TO CITY SPECIFICATION. "NO PARKING FIRE LANE" EVERY 25' WHITE 4" LETTERS ON A 6" RED STRIPED BACKGROUND.
 12. SEE M.E.P. PLANS FOR THE ROUTING OF WATER LINE TO NEW WATER FOUNTAINS.

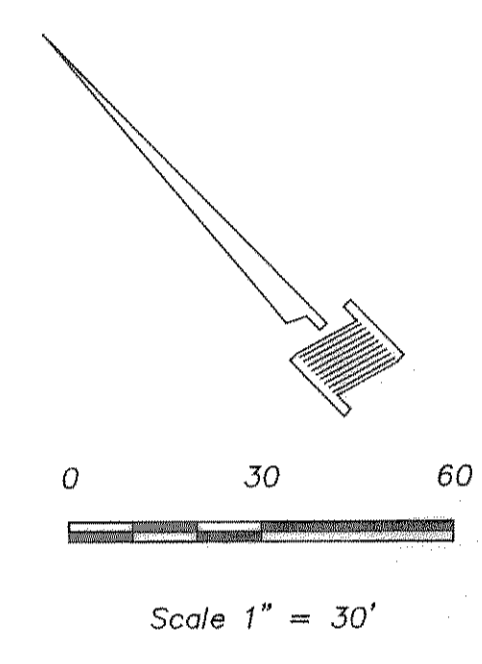


DETAILS AND SPECIFICATIONS NOTE:
 REFERENCE DETAILS AND SPECIFICATIONS FROM WILKERSON SANDERS STADIUM RENOVATIONS SET THAT IS UNDER CONSTRUCTION AT THIS TIME ON THE SAME SITE.

Aug 11, 2009 - 5:10pm User: HP_Administrator
 C:\CROCKISD\TUTLEY\2008 ADDITIONS\IBID SET\2009 TENNIS CENTER\BIDSET\2008WILKERSON-SANDERS-REV11 TENNIS.dwg

SHW GROUP
 ARCHITECTS | ENGINEERS | PLANNERS
 5717 Legacy Drive
 Suite 250
 Plano, TX 75024
 P 214.473.2400
 F 214.473.2731

GLENN ENGINEERING
 T.B.P.E. FIRM REGISTRATION NO. F - 303
 PHONE 972-717-5151 FAX 972-717-2176
 105 DECKER COURT-SUITE 910 IRVING, TEXAS 75062

Final Plans for Bidding and Construction

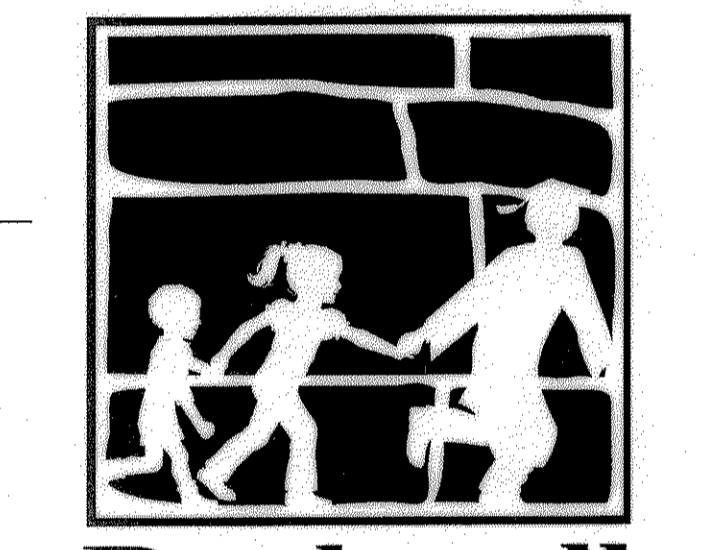

Rockwall
 INDEPENDENT SCHOOL DISTRICT
 TENNIS COMPLEX AT
 WILKERSON SANDERS
 STADIUM
 ROCKWALL, TEXAS

CHECKED:
 File:
 © 2009 SHW Group LLP
 ISSUE: 07/30/2009

Revisions:

| | | |
|---|----------|----------------|
| 1 | 08/06/09 | CITY REVISIONS |
| 2 | 08/11/09 | CITY REVISIONS |

RECORD DRAWING
 This is to certify that changes and corrections have been made to conform to the Contractor's record of this project.
 Signed: *J. Glenn* Date: 8-26-10
 Glenn Engineering Corporation

Sheet Title:
DETAILED SITE PLAN

CS 1.02