


Aug 11, 2009 - 4:00pm User: HP\_Administrator  
 C:\ROCKNSD\CAD\2008 ADDITIONS\BID SET\2009 TENNIS CENTER\BIDSET\2008\WILKERSON-SANDERS-REV11 TENNIS.dwg





5717 Legacy Drive  
 Suite 250  
 Plano, TX 75024  
 P 214.473.2400  
 F 214.473.2731

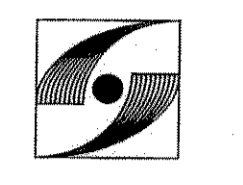

**GLENN ENGINEERING**  
 T.B.P.E. FIRM REGISTRATION NO. F - 303  
 PHONE 972-717-5151 FAX 972-717-2176  
 105 DECKER COURT-SUITE 810 IRVING, TEXAS 75062

Final Plans for Bidding and Construction

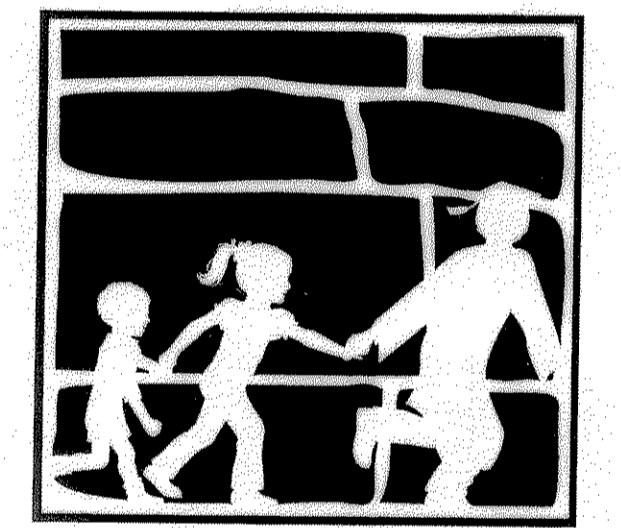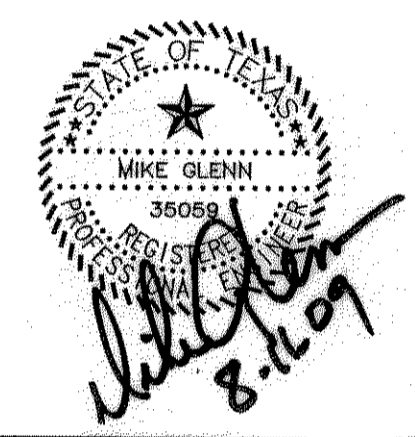

**Rockwall**  
 INDEPENDENT SCHOOL DISTRICT  
**TENNIS COMPLEX AT WILKERSON SANDERS STADIUM**  
 ROCKWALL, TEXAS

CHECKED:  
 File:  
 © 2009 SHW Group LLP  
 ISSUE: 07/30/2009

Revisions:		
1	08/06/09	CITY REVISIONS
2	08/11/09	CITY REVISIONS

Sheet Title:  
**OVERALL SITE PLAN**

**RECORD DRAWING**  
 This is to certify that changes and corrections have been made to conform to the contractor's record of this project.  
 Signed: *M. Glenn* Date: 5.26.10  
 Glenn Engineering Corporation

**CS 1.01**