


- SEDIMENT CONTROL NOTES:**
- CONTRACTOR TO CHOOSE LOCATION OF CONSTRUCTION ENTRANCE. THIS ENTRANCE MUST BE USED BY ALL TRAFFIC ENTERING OR EXITING THE SITE. SEE SHEET C.27 FOR STABILIZED CONSTRUCTION ENTRANCE DETAILS.
 - SEDIMENT CONTROL DEVICES SHALL BE INSTALLED ACCORDING TO THE CONTRACT DOCUMENTS AND AS DIRECTED BY THE ENGINEER. ALL DEVICES SHALL BE MAINTAINED SUCH THAT THEY FUNCTION AS INTENDED THROUGHOUT THE ENTIRE CONSTRUCTION PERIOD. THE STONE FROM ROCK CHECK DAMS SHALL BE USED AS ENERGY DISSIPATORS FOR PROPOSED STORM SEWER AT CONSTRUCTION COMPLETION.
 - CURB INLET PROTECTION SHALL BE INSTALLED AS SOON AS STORM DRAINAGE HAS BEEN CONSTRUCTED.
 - PLYWOOD INLET PROTECTION TO BE PLACED AT UPSTREAM END OF ALL UNFINISHED PIPING AT DAYS END.
 - ALL SEDIMENT CONTROL MEASURES TO REMAIN IN PLACE UNTIL ENTIRE SITE IS STABILIZED.
 - THE EXTENT AND DURATION OF DISTURBANCE TO THE DRAINAGEWAYS SHALL BE MINIMIZED. THE FOLLOWING CONSTRUCTION SEQUENCE SHALL BE FOLLOWED:
 - INSTALL STABILIZED CONSTRUCTION ENTRANCE.
 - INSTALL SILT FENCE PRIOR TO DISTURBING SOIL. PERIMETER SILT FENCE TO BE INSTALLED OUTSIDE OF ANY POINT TO BE DISTURBED.
 - DURING CONSTRUCTION, INLET PROTECTION SHALL BE INSTALLED AS NEEDED. ALL SEDIMENT CONTROL MEASURES SHALL BE INSPECTED AND MAINTAINED PER CONTRACT REQUIREMENTS. ALL DISTURBED AREAS WHICH ARE INACTIVE FOR LONG PERIODS OF TIME SHALL BE VEGETATED.
 - ONLY WHEN ENTIRE SITE IS STABILIZED AND CONSTRUCTION IS COMPLETE, SHALL SEDIMENT CONTROL MEASURES BE REMOVED.
 - CONTRACTOR SHALL CONTROL MUD ACCUMULATION ON ALL STREETS SURROUNDING THE PROJECT. NO MUD ACCUMULATION WILL BE ALLOWED IN PUBLIC STREETS.
 - MAINTAIN ALL FILTERS DURING CONSTRUCTION TO PREVENT ANY BLOCKAGES FROM ACCUMULATED SEDIMENT. ADDITIONAL HAY BALES MAY BE REQUIRED DURING CONSTRUCTION AS SPECIFIED BY ENGINEER OR CITY INSPECTOR.
 - ALL PROPOSED PARKING AREAS TO BE PAVED AS SOON AS POSSIBLE AFTER SUBGRADE IS PREPARED.
 - CONTRACTOR SHALL REMOVE ALL TEMPORARY EROSION AND SEDIMENT CONTROLS ONLY WHEN THERE IS A SUFFICIENT GROWTH OF GROUND COVER TO PREVENT FURTHER EROSION (75% GROUND COVER MINIMUM MOWABLE, 1'-2" TALL).

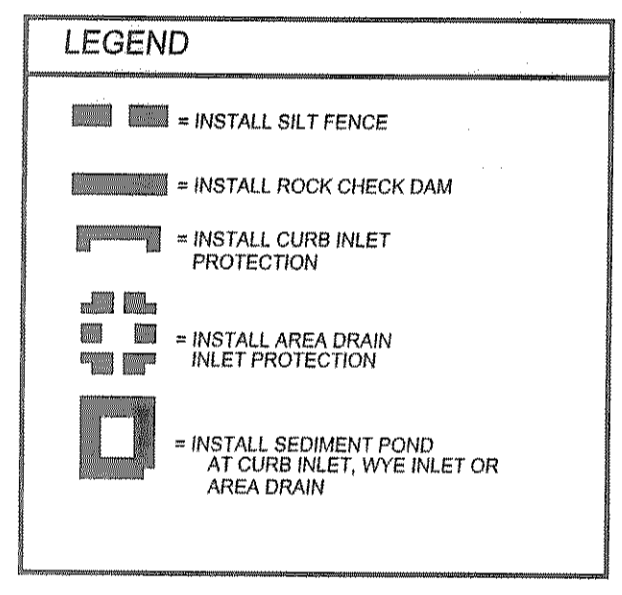


NOTE:
SEE SEDIMENT CONTROL DETAIL SHEET

NOTE:
THE SIDES AND BOTTOM OF THE POND TO BE STABILIZED WITH ANCHORED SEEDED CURLEX OR SOD PRIOR TO PAVING.

RECORD DRAWING
This is to certify that changes and corrections have been made to conform to the contractor's record of this project.
Signed: *[Signature]* Date: 5.26.10
Glenn Engineering Corporation





SHW GROUP
ARCHITECTS | ENGINEERS | PLANNERS
5717 Legacy Drive
Suite 250
Plano, TX 75024
P 214.473.2400
F 214.473.2731

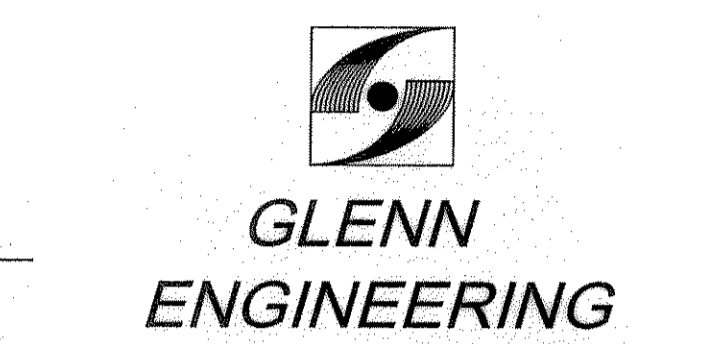

GLENN ENGINEERING
T.B.P.E. FIRM REGISTRATION NO. F - 303
PHONE 972-717-5151 FAX 972-717-2176
105 DECKER COURT-SUITE 910 IRVING, TEXAS 75062

Final Plans for Bidding and Construction

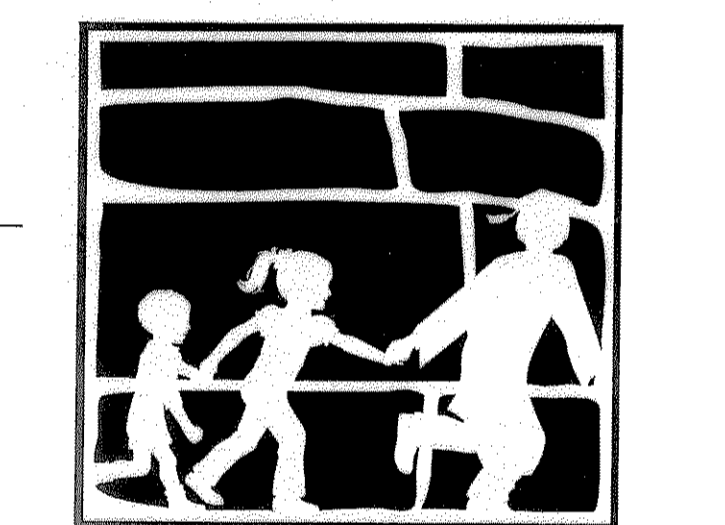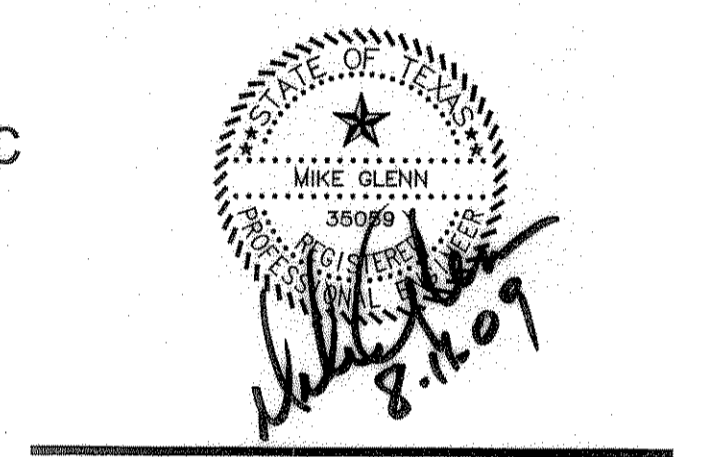

Rockwall
INDEPENDENT SCHOOL DISTRICT
TENNIS COMPLEX AT
WILKERSON SANDERS
STADIUM
ROCKWALL, TEXAS

CHECKED:
File:
© 2009 SHW Group LLP
ISSUE: 07/30/2009

Revisions:

1	08/06/09	CITY REVISIONS
2	08/11/09	CITY REVISIONS

Sheet Title:
SWPPP PLAN

CG 1.02
SHW Project: 4109.045.00

Aug 11, 2009 - 4:01pm User: HP_Administrator
 C:\ROCKWALL\TENNIS\2009 ADDITIONS\BID SET\2009 TENNIS CENTER\BIDSET\2008WILKERSON-SANDERS-REV111 TENNIS.dwg