
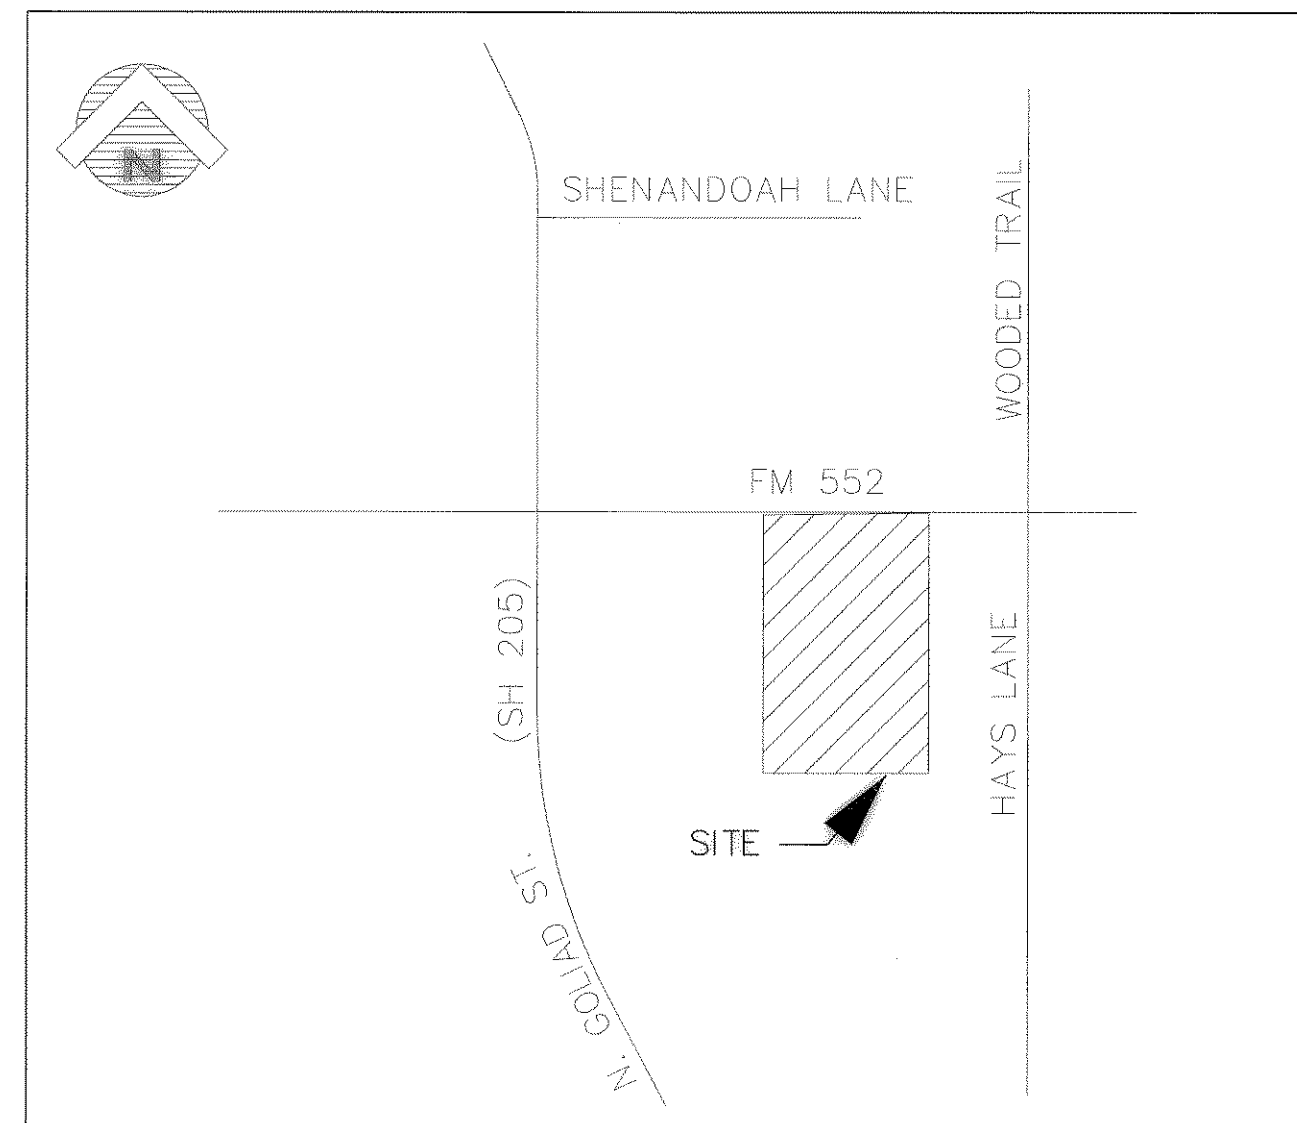


ENGINEERING PLANS FOR ROCKWALL MIDDLE SCHOOL #4 ROCKWALL, TEXAS

LOCATION MAP

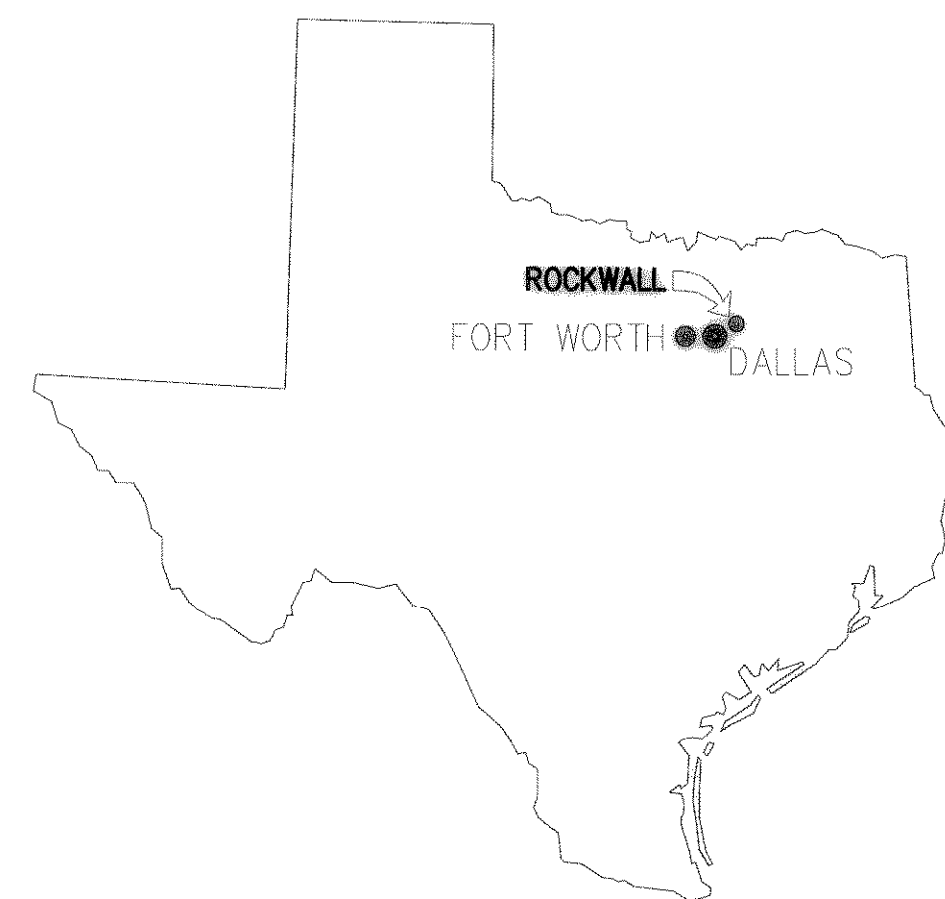

VICINITY MAP
NOT TO SCALE


INDEX OF DRAWINGS

GENERAL

G1.1* COVER SHEET

CIVIL

C2.11*	TOPOGRAPHIC SURVEY
C2.12*	PLAT
C2.13*	PLAT
C2.14*	OVERALL SITE PLAN
C2.15*	NORTH SITE PLAN
C2.16*	SOUTH SITE PLAN
C2.17*	DEMOLITION PLAN
C2.18*	OVERALL GRADING PLAN
C2.19*	NORTHWEST GRADING PLAN
C2.20*	NORTHEAST GRADING PLAN
C2.21*	SOUTHEAST GRADING PLAN
C2.22*	SOUTHWEST GRADING PLAN
C2.23*	DRAINAGE AREA MAP
C2.23a*	OFFSITE DRAINAGE AREA MAP
C2.23b*	STORM SEWER CALCS
C2.24*	NORTH STORM SEWER PLAN
C2.24a*	SOUTH STORM SEWER PLAN
C2.24b*	STORM SEWER PLAN
C2.25*	STORM SEWER PROFILES
C2.26*	STORM SEWER PROFILES
C2.27*	STORM SEWER DETAILS
C2.28*	STORM SEWER DETAILS
C2.29*	PAVING PLAN
C2.30*	PAVING DETAILS
C2.31*	PAVING DETAILS
C2.32*	UTILITY PLAN
C2.32a*	EAST UTILITY PLAN
C2.33*	SANITARY SEWER PROFILES
C2.34*	SANITARY SEWER DETAILS
C2.35*	WATER DETAILS
C2.36*	WATER DETAILS
C2.37*	SEDIMENT CONTROL PLAN
C2.38*	SEDIMENT CONTROL DETAILS
C2.39*	SEDIMENT CONTROL DETAILS
C2.40*	UNDERFLOOR GRADING PLAN (NOT INCLUDED)
C2.41*	ROOF DRAIN DETAILS (NOT INCLUDED)
C2.42*	TRACK LAYOUT (NOT INCLUDED)
C2.43*	TRACK STORM SEWER (NOT INCLUDED)
C2.44*	TRACK DETAILS (NOT INCLUDED)
C2.45*	TRACK DETAILS (NOT INCLUDED)
C2.46*	TRACK DETAILS (NOT INCLUDED)
C2.47*	TRENCH DRAIN DETAILS
C2.48*	TRENCH DRAIN DETAILS
C2.49*	TENNIS COURT DETAILS (NOT INCLUDED)
C2.50*	TENNIS COURT DETAILS (NOT INCLUDED)
C2.51*	F.M. 552 IMPROVEMENT PLAN
C2.52*	F.M. 552 ROADWAY SECTION
TCP NOTES 98*	TXDOT TRAFFIC CONTROL PLAN
TCP(2-1)-98*	TXDOT TRAFFIC CONTROL PLAN
TCP(2-2)-98*	TXDOT TRAFFIC CONTROL PLAN
TCP(2-3)-98*	TXDOT TRAFFIC CONTROL PLAN
TCP(2-4)-98*	TXDOT TRAFFIC CONTROL PLAN
TCP(2-5)-98*	TXDOT TRAFFIC CONTROL PLAN
TCP(2-6)-98*	TXDOT TRAFFIC CONTROL PLAN
TCP(2-7)-98*	TXDOT TRAFFIC CONTROL PLAN
TCP(2-8)-98*	TXDOT TRAFFIC CONTROL PLAN
BC(1)-98*	TXDOT BARRICADE STANDARDS
BC(2)-98*	TXDOT BARRICADE STANDARDS
BC(3)-98*	TXDOT BARRICADE STANDARDS
BC(4)-98*	TXDOT BARRICADE STANDARDS
BC(5)-98*	TXDOT BARRICADE STANDARDS
BC(6)-98*	TXDOT BARRICADE STANDARDS
BC(7)-98*	TXDOT BARRICADE STANDARDS
WZ(1D)-98*	TXDOT WORK ZONE SIGNING
MC-8-13*	MULTIPLE BOX CULVERTS 8'-0" SPAN
FW-0*	FLARED WINGS FOR 0° SKEW BOX CULVERTS
SET (1) (FW)*	TYPE II SAFETY END TREATMENT

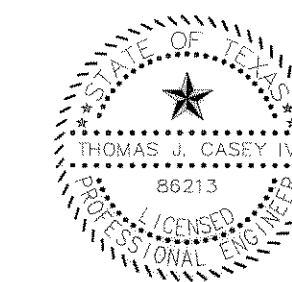

NOTE:

• THE STANDARD SHEETS, SPECIFICALLY IDENTIFIED IN THIS INDEX OF SHEETS, HAVE BEEN SELECTED BY ME OR UNDER MY RESPONSIBLE SUPERVISION AS BEING APPLICABLE TO THIS PROJECT.

SPECIFICATIONS ADOPTED BY THE TEXAS DEPARTMENT OF TRANSPORTATION, MARCH 1, 1993, AND SPECIFICATION ITEMS LISTED AND DATED AS ABOVE SHALL GOVERN THIS PROJECT.

DATE NOV. 9, 2001
DRAWN BY TUC
CHECKED RAH
COM NO 144101044
REVISIONS FEBRUARY 6, 2002

ROCKWALL MIDDLE SCHOOL #4
ROCKWALL INDEPENDENT SCHOOL DISTRICT
ROCKWALL, TEXAS

FINAL PLANS FOR BIDDING AND CONSTRUCTION



SHEET NUMBER	G 1.1
OF	
SET NUMBER	

OWNER

ROCKWALL INDEPENDENT SCHOOL DISTRICT
801 EAST WASHINGTON STREET
ROCKWALL, TEXAS 75087
(972) 771-0605

ARCHITECT

SHW GROUP, INC.
4000 McEWEN ROAD NORTH
DALLAS, TEXAS 75244
(972) 701-0700

ENGINEER

CIVIL ENGINEER
GLENN ENGINEERING
100 DECKER COURT, SUITE 250
IRVING, TEXAS 75062
(972) 717-5151