


LINE "A"


BENCH MARK:
 #1 CITY OF ROCKWALL MONUMENT ROAD, 84 NAIL W/SHINER IN POWER POLE, LOCATED IN THE SOUTHWEST QUADRANT OF THE INTERSECTION OF S.H. 205 AND F.M. 552 AND DALTON ROAD APPROXIMATELY 26' SOUTH OF THE CENTERLINE OF DALTON ROAD, AND 133.5' WEST OF THE CENTERLINE OF S.H. 205. ELEVATION = 542.34

SANITARY SEWER PROFILE
 SCALE: H-1" = 40', V-1" = 5'

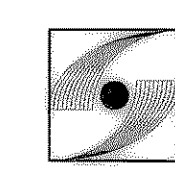

GLENN
 ENGINEERING

PHONE 972-770-8888
 800 DECKER COURT - SUITE 200
 ROCKWALL, TEXAS 75087
 FAX 972-770-8889
 8700 W. TEXAS 75088

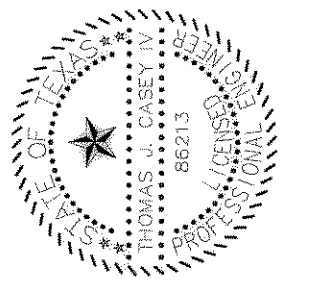

Glenn
 SHW Group Inc.
 Architects + Engineers

SHEET NUMBER C
 OF 2.33
 SET NUMBER

©2001 SHW Group, Inc.

ROCKWALL MIDDLE SCHOOL #4
 ROCKWALL INDEPENDENT SCHOOL DISTRICT
 ROCKWALL, TEXAS

DATE NOV. 9, 2001
 DRAWN BY TUC
 CHECKED RAH
 COMM NO 144101044
 REVISED
 FEBRUARY 6, 2002

FINAL PLANS FOR BIDDING
 AND CONSTRUCTION