


BENCH MARK:  
 #1 CITY OF ROCKWALL MONUMENT 0008, 84 NAIL W/SHINER IN POWER POLE, LOCATED IN THE SOUTHWEST QUADRANT OF THE INTERSECTION OF S.H. 205 AND E.M. 552 AND DALTON ROAD APPROXIMATELY 26' SOUTH OF THE CENTERLINE OF DALTON ROAD, AND 133.5' WEST OF THE CENTERLINE OF S.H. 205. ELEVATION = 542.34

**STORM SEWER PROFILES**  
 SCALE: H-1" = 40', V-1" = 5'

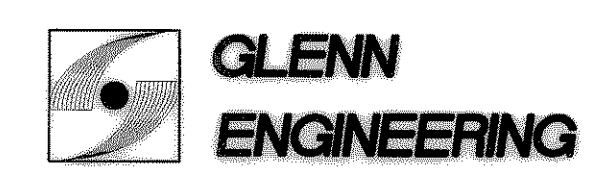


PHONE 972-717-8800  
 810 DECKEN COURT - SUITE 200  
 ROCKWALL, TEXAS 75087  
 FAX 972-717-8800  
 8100 N. TEXAS 75088

DATE: NOV. 9, 2001  
 DRAWN BY: TUC  
 CHECKED: RAH  
 COM. NO.: 144101044  
 REVISION:  
 JANUARY 23, 2002

**ROCKWALL MIDDLE SCHOOL #4**  
**ROCKWALL INDEPENDENT SCHOOL DISTRICT**  
**ROCKWALL, TEXAS**

FINAL PLANS FOR BIDDING AND CONSTRUCTION

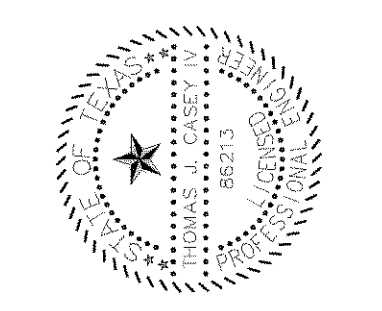

SHEET NUMBER: C  
 OF: 2.26  
 SET NUMBER