

E. TEAL SURVEY
ABSTRACT NO. 207

CHRISTOPHER REYNOLSO
DEED
INSTR. NO. 2010-00430231
84 S.F. (0.0019 ACRE)
REM = 24,806 S.F.
(0.5649 ACRE)

MARK ADLE
DEED
INSTR. NO. 2009-00420428
84 S.F. (0.0019 ACRE)
REM = 43,916 S.F.
(1.0082 ACRES)

NOTE: PARCEL 34 DELETED

LAFAYETTE POINT JOINT VENTURE
DEED
INSTR. NO. 2009-00418892
260 S.F. (0.0059 ACRE)
REM = 4,703 S.F.
(0.1080 ACRE)

JOHN ROBLES
DEED
INSTR. NO. 2009-00414167
664 S.F. (0.0152 ACRE)
REM = 39,473 S.F.
(0.9062 ACRE)

RAYMOND ROBLES AND
TERESA ROBLES
DEED
INSTR. NO. 2009-00415077
PART 1 - 198 S.F. (0.0045 ACRE)
PART 2 - 31 S.F. (0.0007 ACRE)
REM = 42,460 S.F.
(0.9747 ACRE)

BC GOLF LIMITED
DEED
INSTR. NO. 2009-00418052
216,322 S.F. (4.9660 ACRES)
EAST REM = 158,2651 AC.
WEST REM = 8.0439 AC.

JOHN ROBLES
DEED
INSTR. NO. 2009-00418893
229 S.F. (0.0052 ACRE)
REM = 7,081 S.F.
(0.1626 ACRE)


FRANK AND LOURDES MORALES
DEED
INSTR. NO. 2010-00430230
31 S.F. (0.0007 ACRE)
REM = 22,121 S.F.
(0.5078 ACRE)

WELLINGTON/HEATH
LIMITED PARTNERSHIP
DEED
INSTR. NO. 2009-00424469
200 S.F. (0.0046 ACRE)
REM = 13,716 S.F.
(0.3149 ACRE)

RONALD AND KATHY ENSOR
DEED
INSTR. NO. 2009-00426999
200 S.F. (0.0046 ACRE)
REM = 23,672 S.F.
(0.5434 ACRE)

CAROLYN HETZEL
DEED
INSTR. NO. 2009-00424963
147 S.F. (0.0034 ACRE)
REM = 14,955 S.F.
(0.3433 ACRE)


EDDIE & PATSY MEIL, TRSUTEES
DEED
INSTR. NO. 2009-00418048
396 S.F. (0.0091 ACRE)
REM = 20,180 S.F.
(0.4633 ACRE)

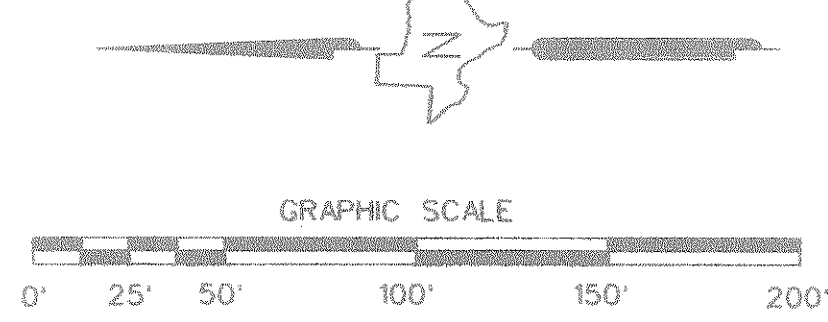

PARCEL 38 SKETCH
N.T.S.

E. TEAL SURVEY
ABSTRACT NO. 207

E. TEAL SURVEY
ABSTRACT NO. 207

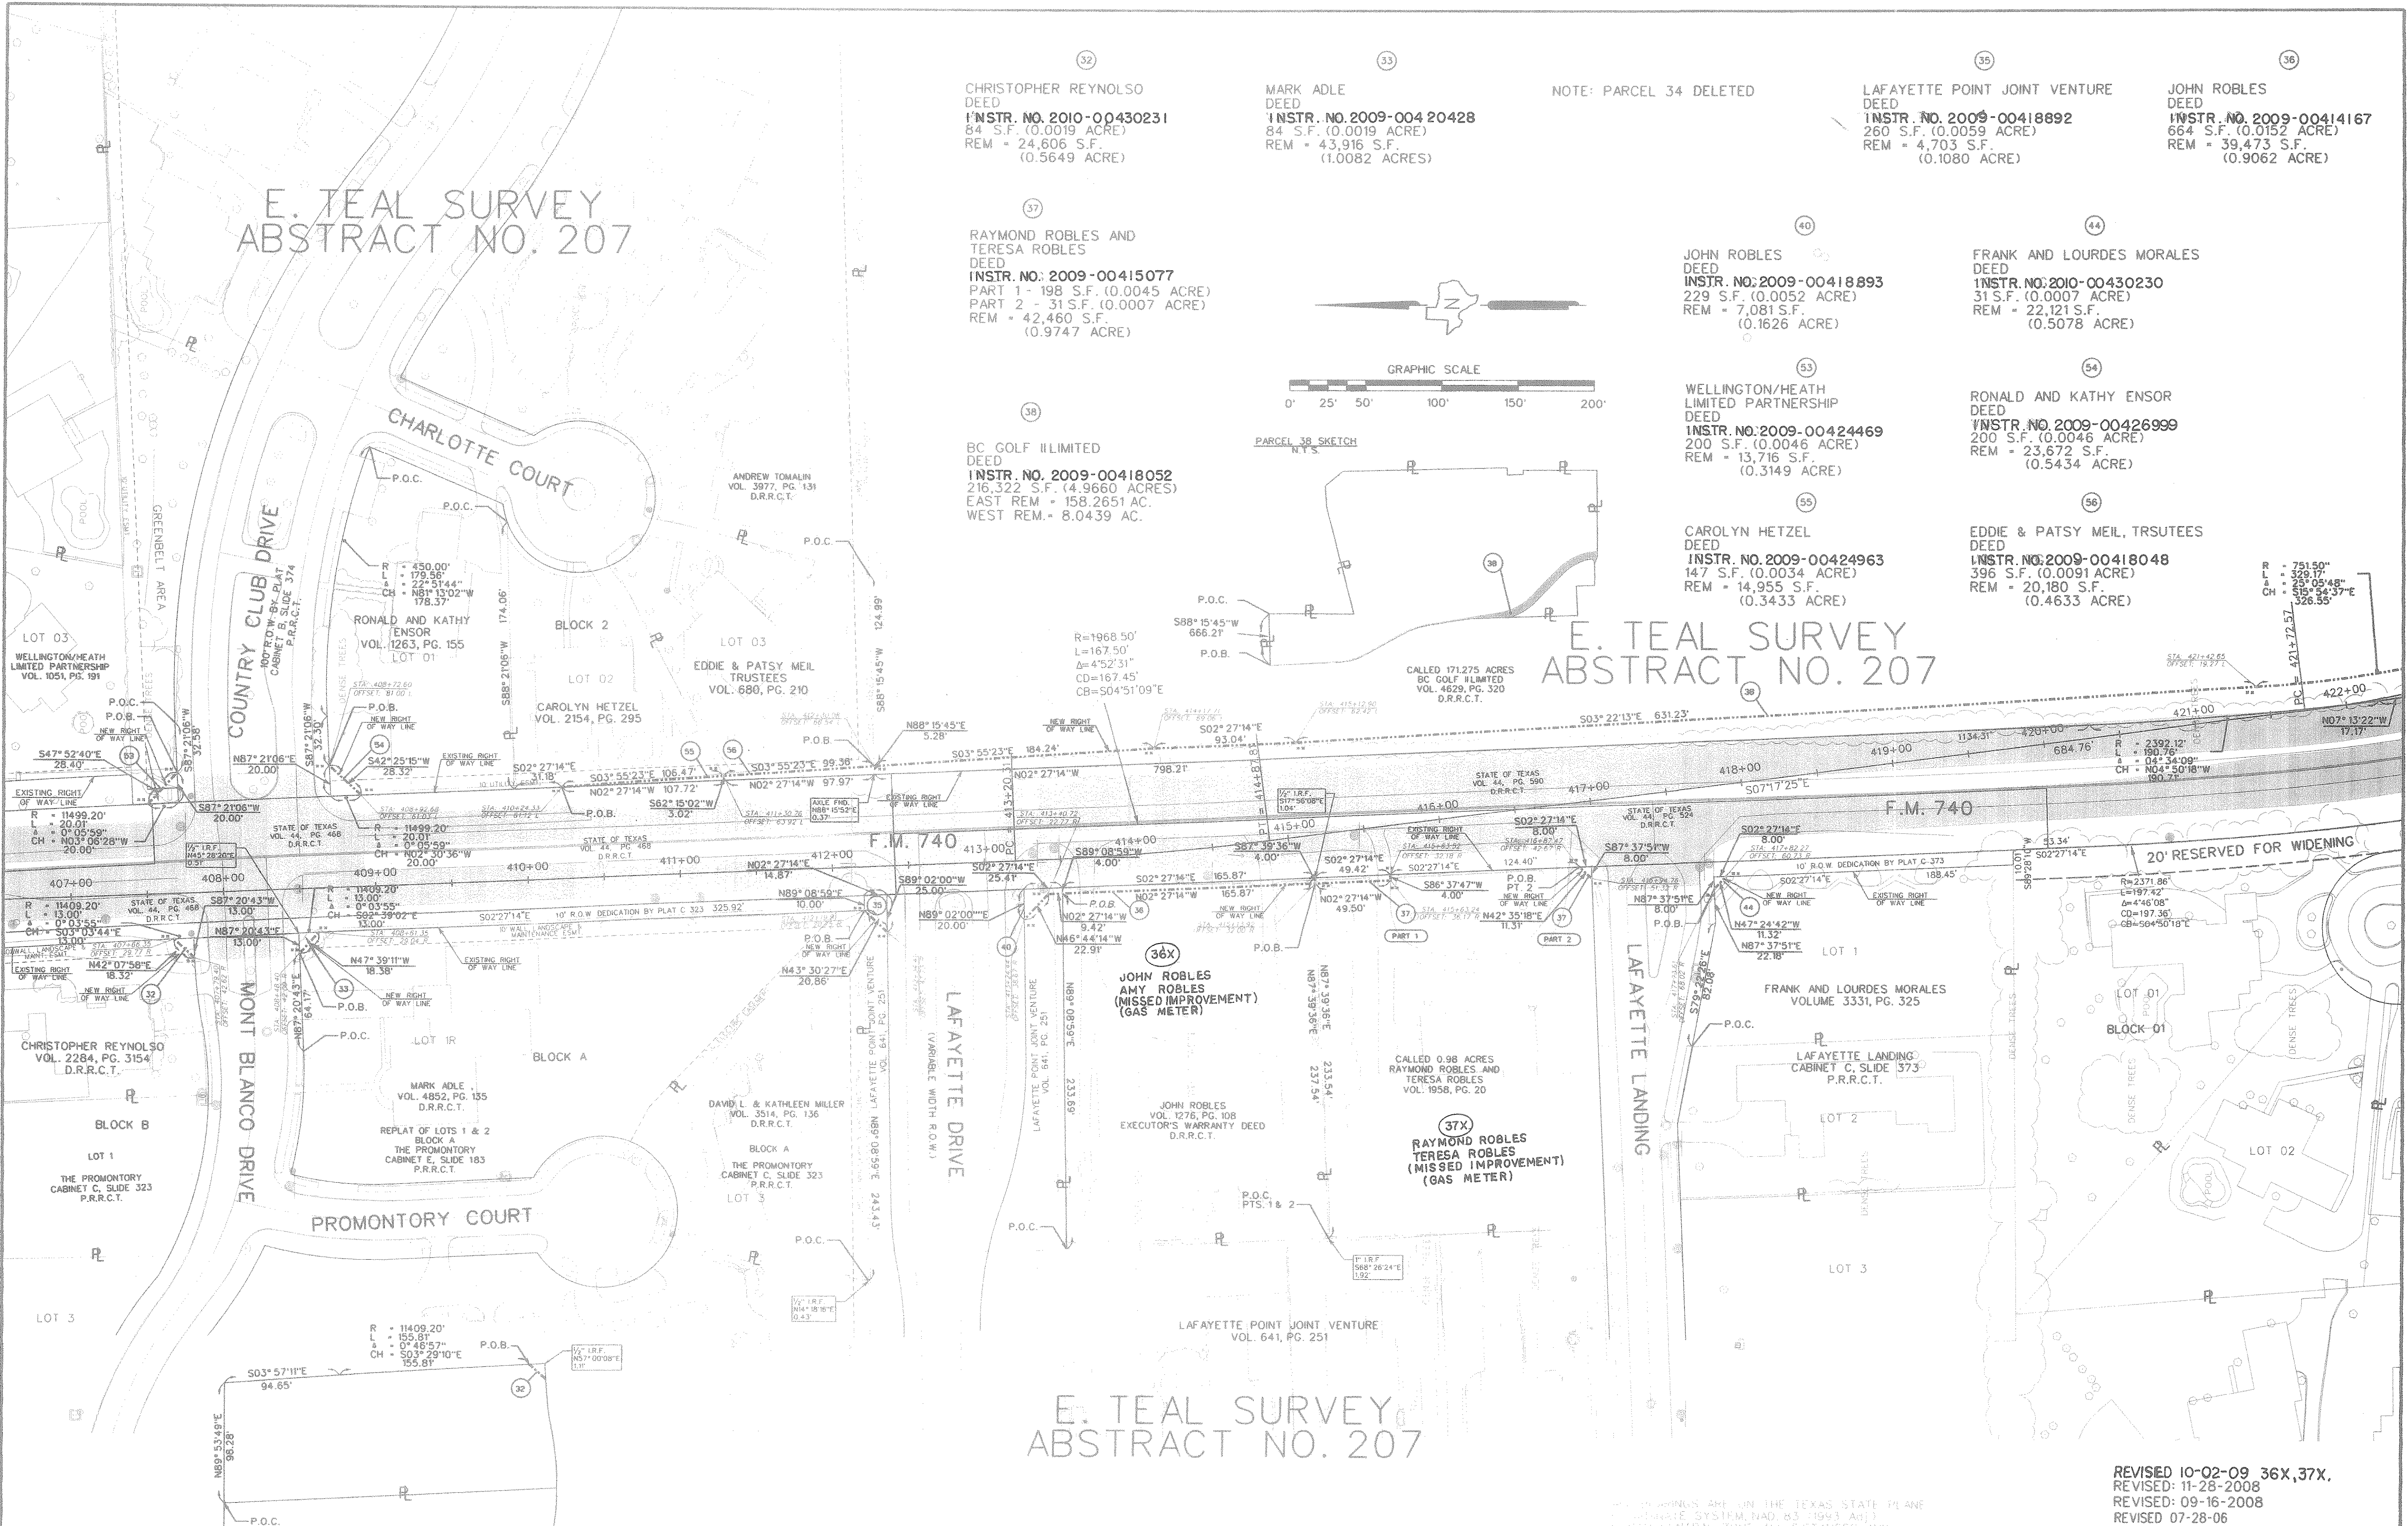

PARCEL 32 SKETCH
N.T.S.

REVISED 10-02-09 36X, 37X,
REVISED: 11-28-2008
REVISED: 09-16-2008
REVISED 07-28-06

FED. PROJ. NO.	STATE	FEDERAL AID PROJECT NO.	HIGHWAY NO.
6	TEXAS		FM 740
STATE PROJECT NO.	COUNTY	CONTROL	SECTION
18	ROCKWALL	1014	03 047
			SHEET NO. 8

ALL DIMENSIONS ARE ON THE TEXAS STATE PLANE
NAD 83 (1983) SYSTEM, NAD 83 (1993 ADJ.)
WITH CENTRAL ZONE, ALL DISTANCES AND
COORDINATES SHOWN ARE SURFACE AND MAY
BE ADJUSTED TO GRID BY DIVIDING BY 1.000146135