

CL-22 TY "I" (15)
 35.5' LT @ STA 156+90
 TC 492.05; F/L (30') 485.42
 F/L (36') 484.92

F/L (30') 485.42

EXISTING HEADWALL
(TO BE REMOVED)

EL 484.92


EXISTING 30" x 69 LF (TO BE REMOVED)

EXISTING HEADWALL
(TO BE REMOVED)

104 LF 36" @ 2.60%

DI-6 TY "C" 2 GRATE
 69' RT @ STA 156+90
 TOP 492.62 F/L 487.62

STA 156+90
 PROPOSED 36" x 104 LF RCP (CL III)
 WITH DI-6 UPSTREAM

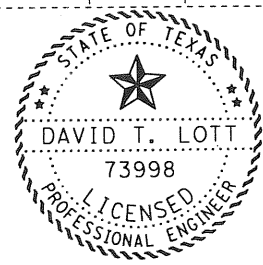

8/16/1999

David Lott, P.E.

DRAINAGE SHEET
 SHEET 9 OF 15
 SCALE: HORIZONTAL 1"=10'
 VERTICAL 1"=10'

FED. RD. DIV. NO.	FEDERAL AID PROJECT NO.	SHEET NO.
6	STP 99(413)MM	97
STATE	STATE DIS. NO.	COUNTY
TEXAS	18	ROCKWALL
CONT.	SECT.	JOB
1014	03	033
		HIGHWAY NO.
		FM 740