


REMOVE OLD CONCRETE (CURB & GUTTER)
 REMOVE OLD CONCRETE (MEDIAN)

- REMOVE ASPHALT
- REMOVE OLD CONCRETE (DRIVEWAY)

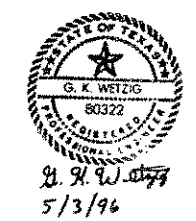

REMOVAL SHEETS
 SHEET 1 OF 3

FED. RD. DIST. NO.	FEDERAL AID PROJECT NO.	SHEET NO.
6	STP 96 (830)MM	28
STATE	STATE DISTRICT	COUNTY
TEXAS	DALLAS	ROCKWALL
CONTROL SECTION	JOB	HIGHWAY NO.
1014	03 041	FM 740