


0 50 100
SCALE IN FEET
HORIZONTAL

0 5 10
SCALE IN FEET
VERTICAL

DGN=6:\JOBS\22451C-SH205\UHT\11\Y2451\wp14.dgn, ON=10-11, 13-623
 3/22/2006 Plotted 22-MAR-2006 15:19

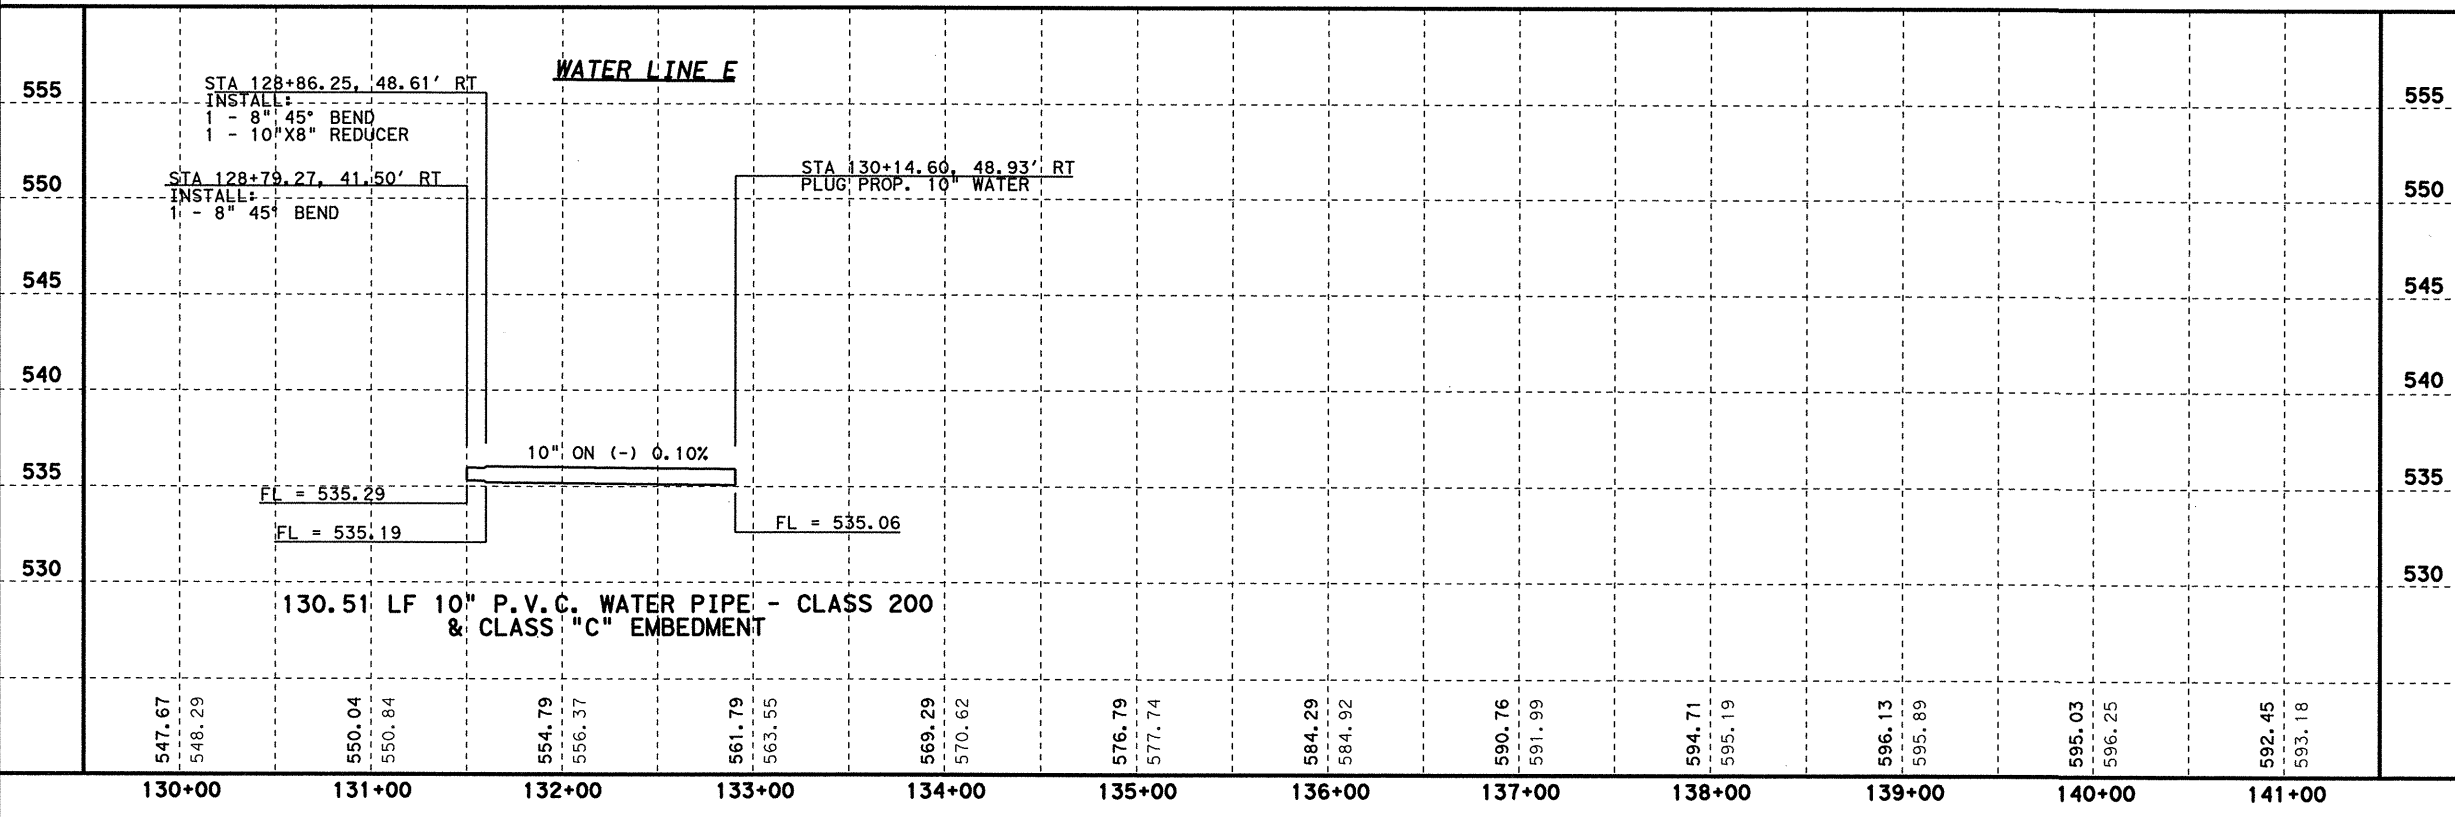

3-22-06

Richard T. Grice

PB Parsons Brinckerhoff Quade & Douglas, Inc.
 2777 Stemmons Freeway
 Suite 1333
 192 Dallas, TX 75207

Texas Department of Transportation
 © 2006

SH 205

WATER LINE
 NB COUPLET
 PLAN & PROFILE
 STA 130+00 TO 141+00

SHEET 14 OF 19

FED. RD. DIV. NO.	FEDERAL AID PROJECT NO.	HIGHWAY NO.
6	(SEE TITLE SHEET)	SH 205
STATE	DIST.	COUNTY
TEXAS	DALLAS	ROCKWALL
CONT.	SECT.	JOB
0451	01	032, ETC
		SHEET NO.
		523