


Office 972.937.9200  
Fax 972.937.9255  
Toll Free 866.907.9200

Date \_\_\_\_\_  
Page \_\_\_\_\_ Of \_\_\_\_\_ Pages

Project \_\_\_\_\_



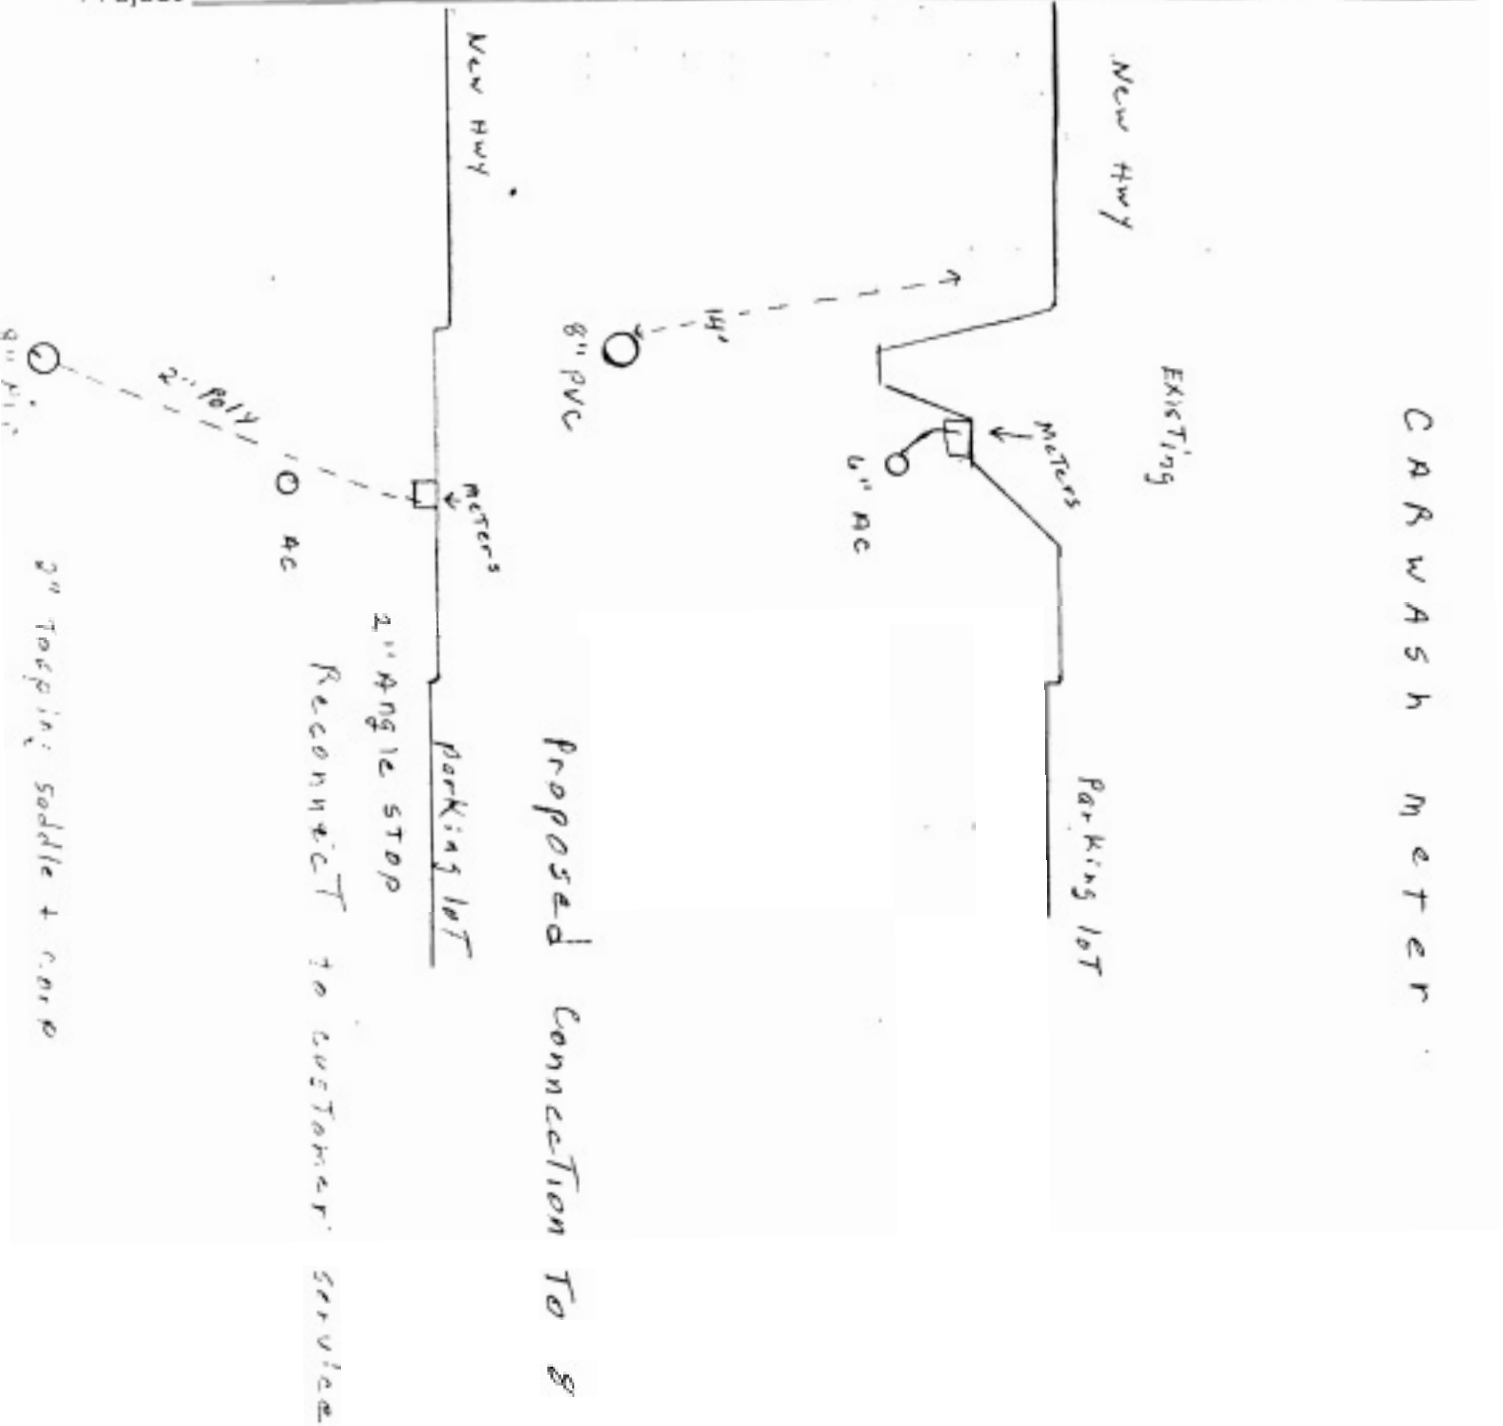



Office 972.937.9200  
Fax 972.937.9255  
Toll Free 866.907.9200

Date \_\_\_\_\_  
Page \_\_\_\_\_ Of \_\_\_\_\_ Pages

Project \_\_\_\_\_

