
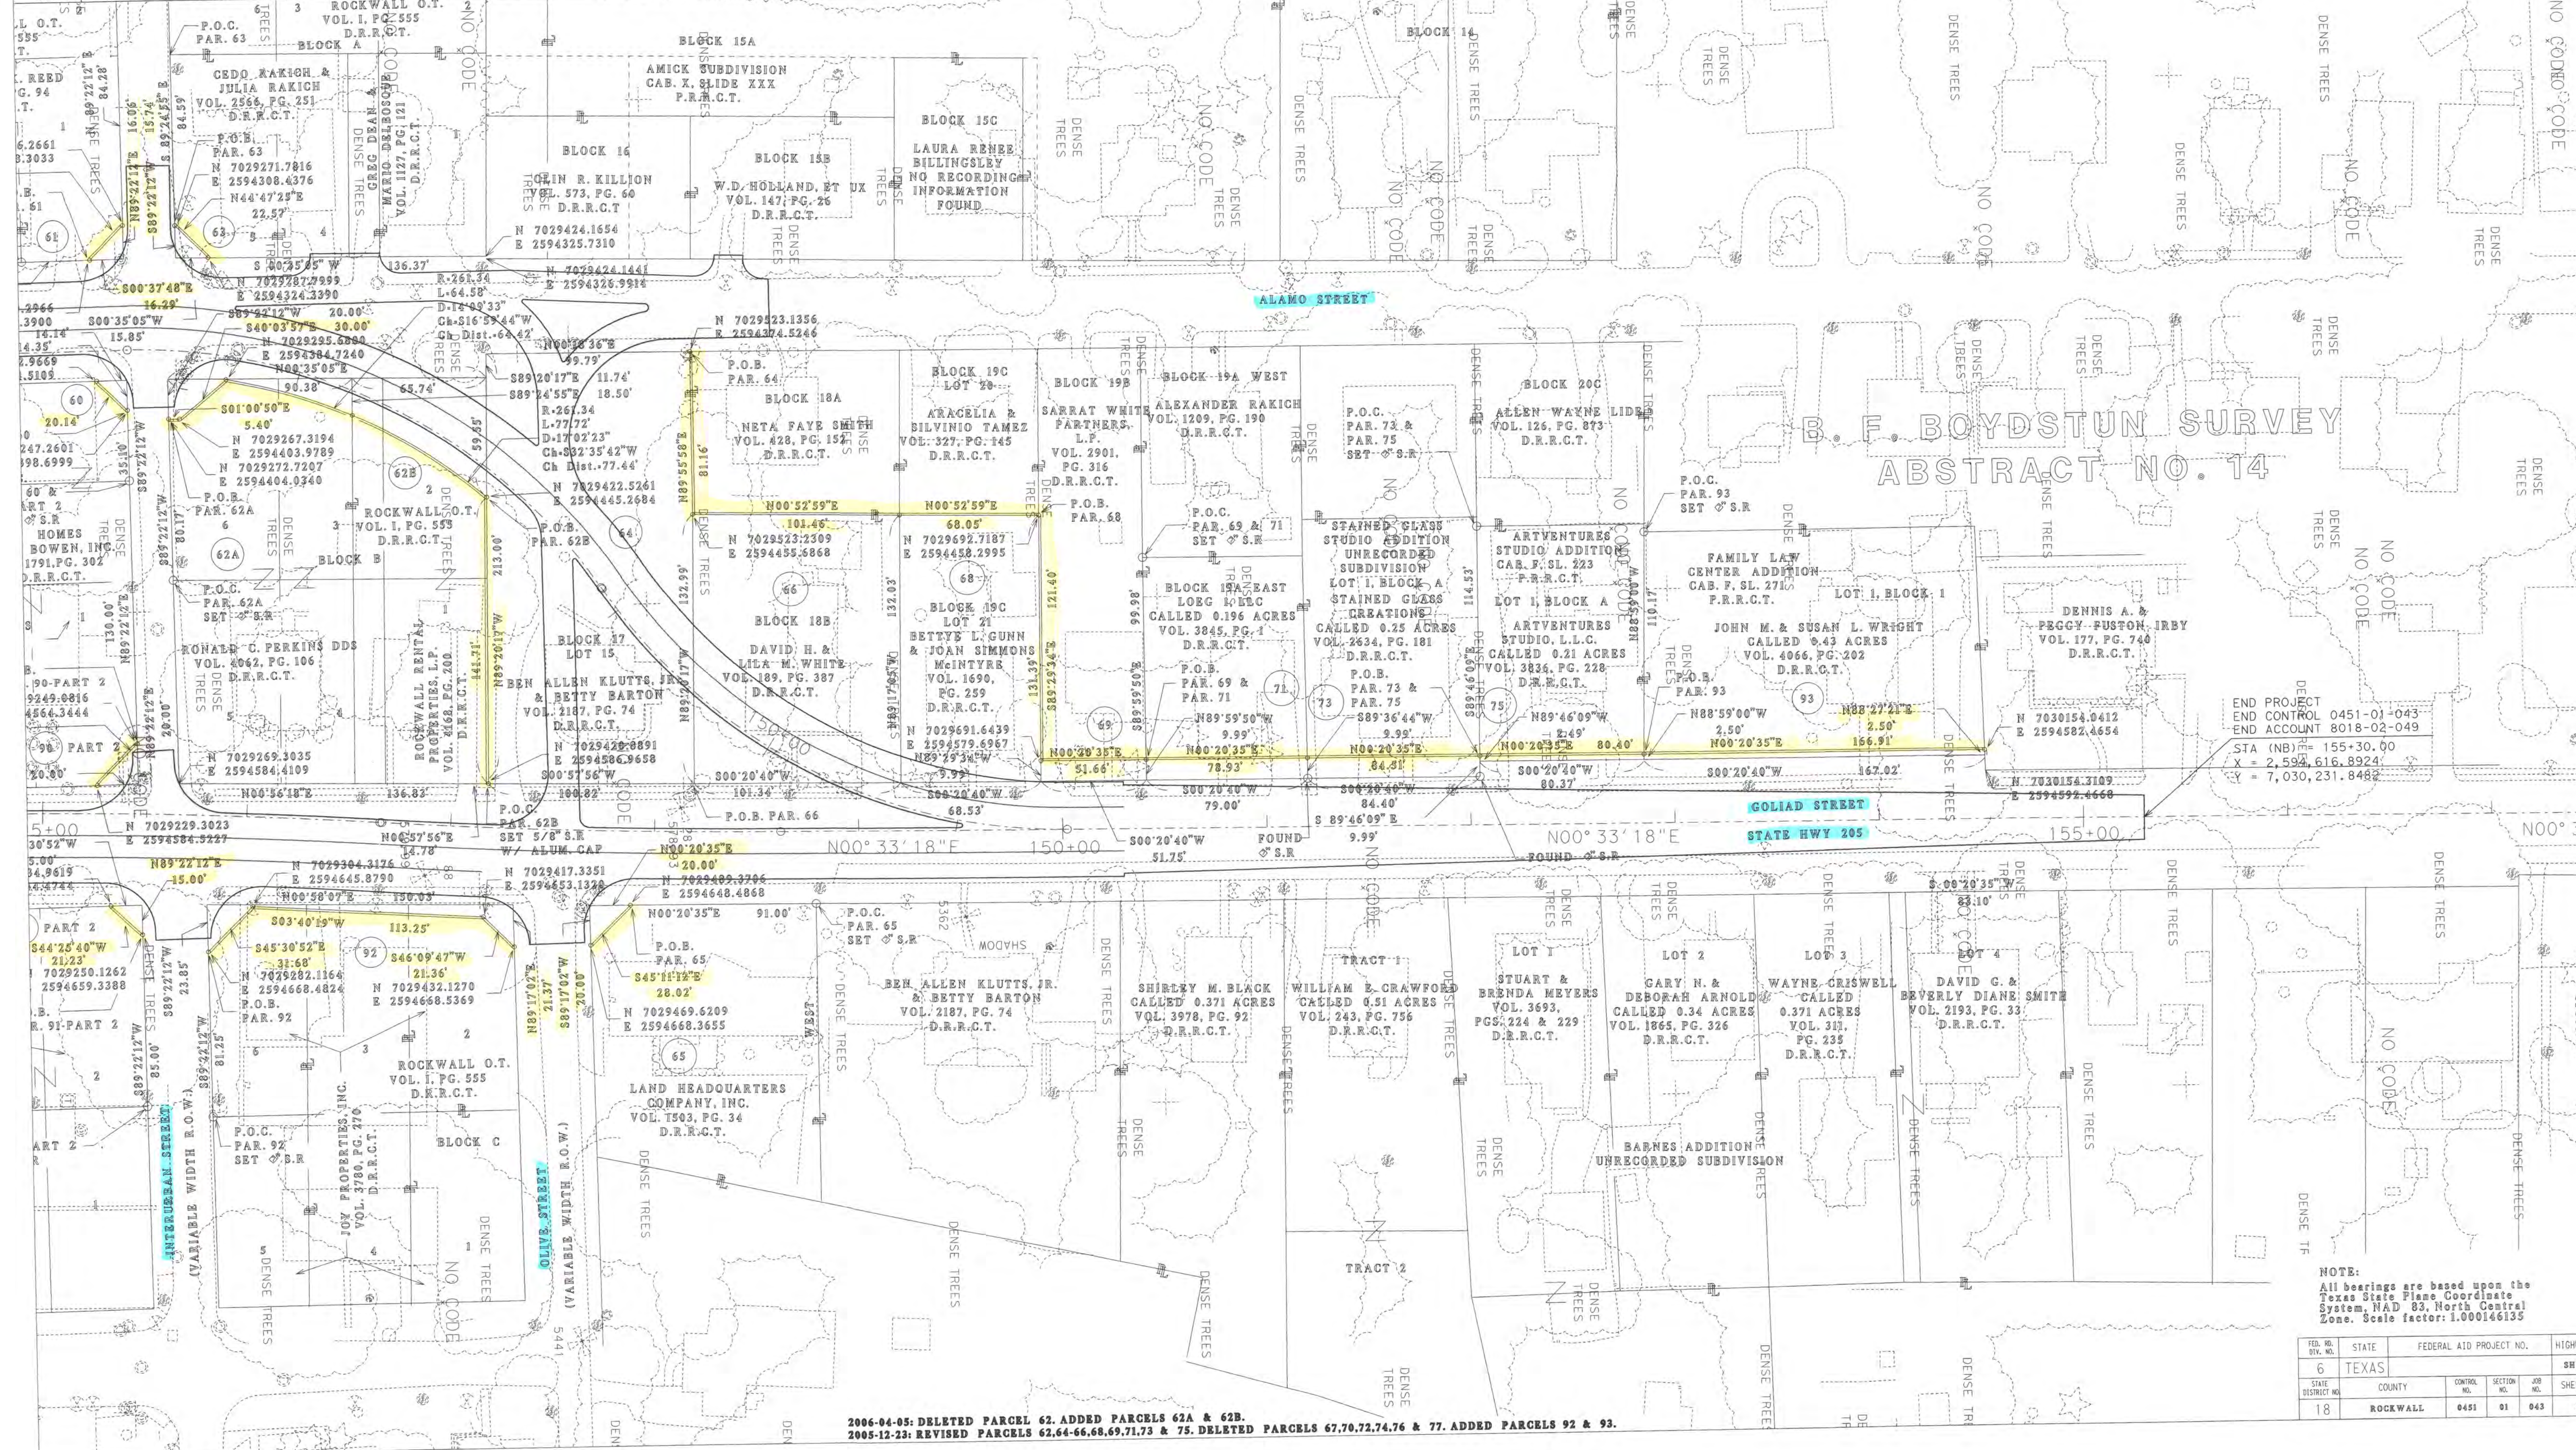


PAR. NO.	STATION TO STATION	OWNER	TYPE OF CONV.	CONVEYANCE		REMAINDER	
				COUNTY CLERK'S NO.	AREA TO BE ACC.	LEFT	RIGHT
62A	146-34.45 - 147-24.76	RONALD C. PERKINS, DDS	FEE	C.C. NO. 2007-00369757	0.0192 AC.		0.39 AC.
62B	147-24.76 - 148-12.83	ROCKWALL RENTAL PROPERTIES, L.P.	FEE	C.C. NO. 2007-00388859	0.0555 AC.		0.25 AC.
63	146-35.29 - 146-48.78	CEDO RAKICH AND WIFE, JULIA RAKICH	FEE	C.C. NO. 2006-00360099	0.0029 AC.	0.19 AC.	
64	147-73.11 - 149-80.81	BEN ALLEN KLUTTS, JR.	FEE	C.C. NO. 2006-00361659	0.4933 AC.	0.00 AC.	0.00 AC.
65	147-68.90 - 147-88.64	FAIR ROAD PROPERTIES INC.	FEE	C.C. NO. 2006-00364456	0.0046 AC.		0.34 AC.
66	148-19.34 - 149-21.04	DAVID H. & LILA M. WHITE	FEE	C.C. NO. 2006-00363909	0.3085 AC.	0.00 AC.	
68	149-21.04 - 149-89.56	BETTYE L. GUNN	FEE	C.C. NO. 2006-00360640	0.2065 AC.	0.00 AC.	
69	149-89.56 - 150-41.31	SARRAT WHITE PARTNERS, L.P.	FEE	C.C. NO. 2006-00357069	0.0119 AC.	0.24 AC.	
71	150-41.31 - 151-20.31	SARRAT WHITE PARTNERS, L.P.	FEE	C.C. NO. 2006-00359023	0.0181 AC.	0.18 AC.	
73	151-20.31 - 152-04.71	STAINED GLASS CREATIONS	FEE	C.C. NO. 2007-00373092	0.0194 AC.	0.23 AC.	
75	152-04.71 - 152-84.97	ARTVENTURES STUDIO, L.L.C.	FEE	C.C. NO. 2006-00364015	0.0046 AC.	0.21 AC.	
92	145-81.63 - 147-31.86	JOY PROPERTIES, INC.	FEE	C.C. NO. 2007-00371112	0.0202 AC.		0.66 AC.
93	152-84.97 - 154-52.33	JOHN M. & SUSAN L. WRIGHT	FEE	C.C. NO. 2007-00375965	0.0096 AC.	0.42 AC.	

LEGEND

- PROPOSED ROW
- EXISTING ROW
- PROPERTY LINE
- COUNTY LINE
- CONTROL OF ACCESS LINE
- SURVEY LINE
- FENCE LINE
- CITY LIMITS
- EASEMENT
- RAILROADS
- STRUCTURE
- P.O.C.
- P.O.B.
- POINT OF COMMENCING
- POINT OF BEGINNING
- FOUND CONG. MONUMENT
- SET 5/8" STEEL ROD WITH ALUMINUM TXDOT CAP
- SET OR FOUND MONUMENTATION

GRAPHIC SCALE

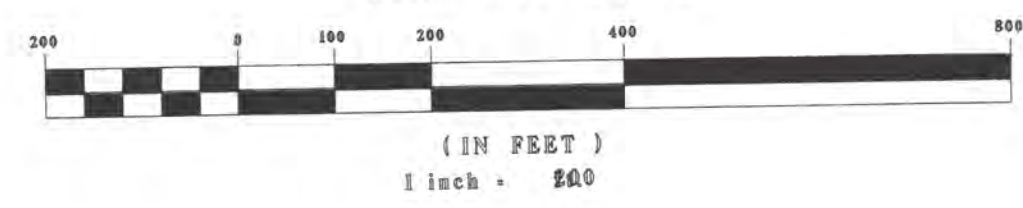

END PROJECT  
 END CONTROL 0451-01-043  
 END ACCOUNT 8018-02-049  
 STA (NB) = 155+30.00  
 X = 2,592,616.8924  
 Y = 7,030,231.8482

NOTE:  
 All bearings are based upon the Texas State Plane Coordinate System, NAD 83, North Central Zone. Scale factor: 1.000146135

2006-04-05: DELETED PARCEL 62. ADDED PARCELS 62A & 62B.  
 2005-12-23: REVISED PARCELS 62.64-66,68,69,71,73 & 75. DELETED PARCELS 67,70,72,74,76 & 77. ADDED PARCELS 92 & 93.

FED. PROJ. NO.	STATE	FEDERAL AID PROJECT NO.	HIGHWAY		
6	TEXAS		SH		
STATE PROJECT NO.	COUNTY	CONTROL	SECTION	JOB NO.	SHEET
18	ROCKWALL	0451	01	043	11