


- GENERAL NOTES**
- CURB INLETS STATION AND OFFSET ARE MEASURED TO THE MIDPOINT OF THE FACE OF MAIN INLET. GRATE INLETS STATION AND OFFSET ARE MEASURED TO THE CENTER OF THE INLET.
 - JUNCTION BOX STATION AND OFFSET ARE MEASURED TO THE CENTER OF THE JUNCTION BOX.
 - ALL PIPE ARE CLASS III UNLESS OTHERWISE NOTED.

- LEGENDS**
- (G) EX. GAS LINE CROSSING ELEVATION UNKNOWN
 - (T) EX. SW BELL CABLE CROSSING ELEVATION UNKNOWN

PLAN
SCALE 1"=100'

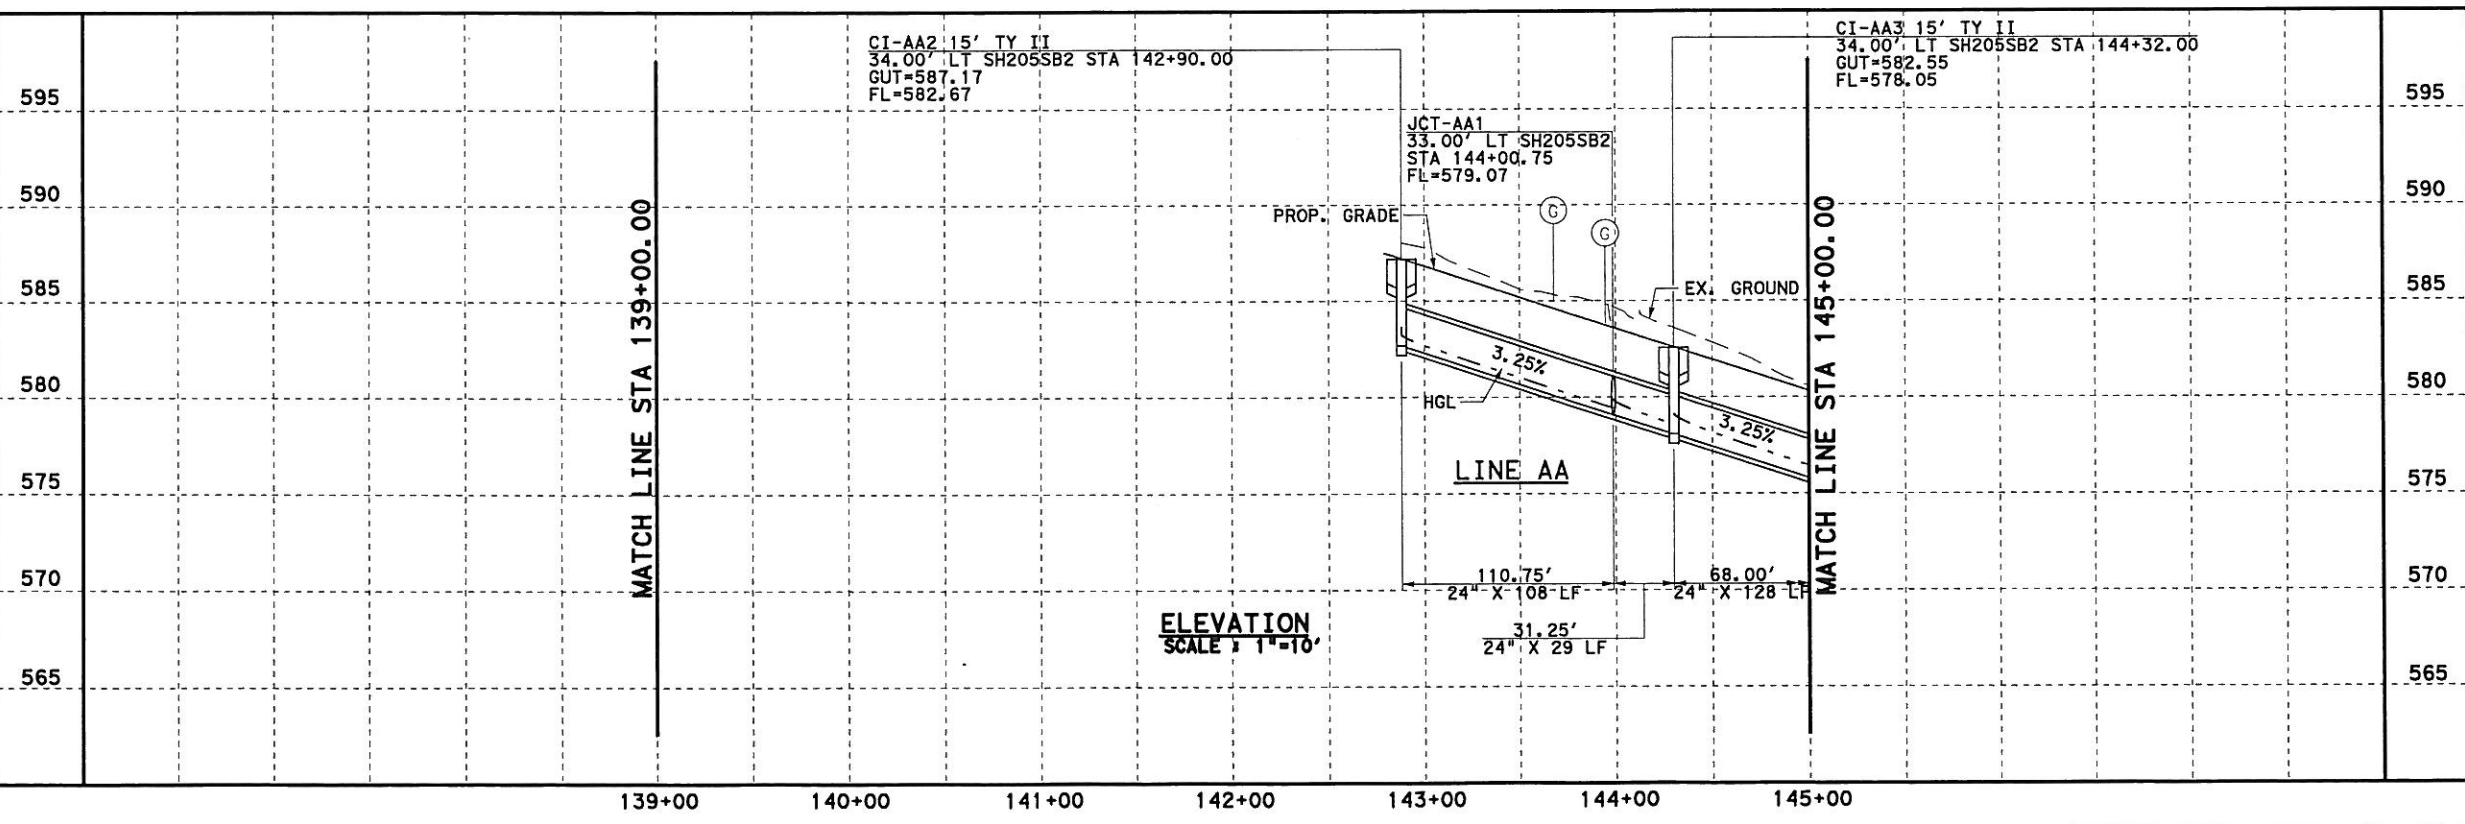

ELEVATION
SCALE 1"=10'



PB Parsons Brinckerhoff Quade & Douglas, Inc.
2777 Stemmons Freeway
Suite 1333
Dallas, TX 75207

Texas Department of Transportation
© 2006

SH 205
SOUTHBOUND DRAINAGE
SB COUPLET
STORM SEWER PLAN & PROFILE
STA 139+00 TO 145+00
SHEET 37 OF 57

FED. RD. DIV. NO.	FEDERAL AID PROJECT NO.	HIGHWAY NO.
6	(SEE TITLE SHEET)	SH 205
STATE	DIST.	COUNTY
TEXAS	DALLAS	ROCKWALL
CONT.	SECT.	JOB
0451	01	032, ETC
SHEET NO.		
437		

DGN: G:\JOBS\22451C-SH205\Drawings\2451cdps18.dgn, ON: 10-11, 13-621
 3/25/2006 Plotted 25-MAR-2006 03:00