


- GENERAL NOTES**
1. CURB INLETS STATION AND OFFSET ARE MEASURED TO THE MIDPOINT OF THE FACE OF MAIN INLET. GRATE INLETS STATION AND OFFSET ARE MEASURED TO THE CENTER OF THE INLET.
 2. JUNCTION BOX STATION AND OFFSET ARE MEASURED TO THE CENTER OF THE JUNCTION BOX.
 3. ALL PIPES ARE CLASS III RCP UNLESS OTHERWISE NOTED.

- LEGENDS**
- (G) EX. GAS LINE CROSSING ELEVATION UNKNOWN
 - (T) EX. SW BELL CABLE CROSSING ELEVATION UNKNOWN

PLAN
SCALE 1"=100'

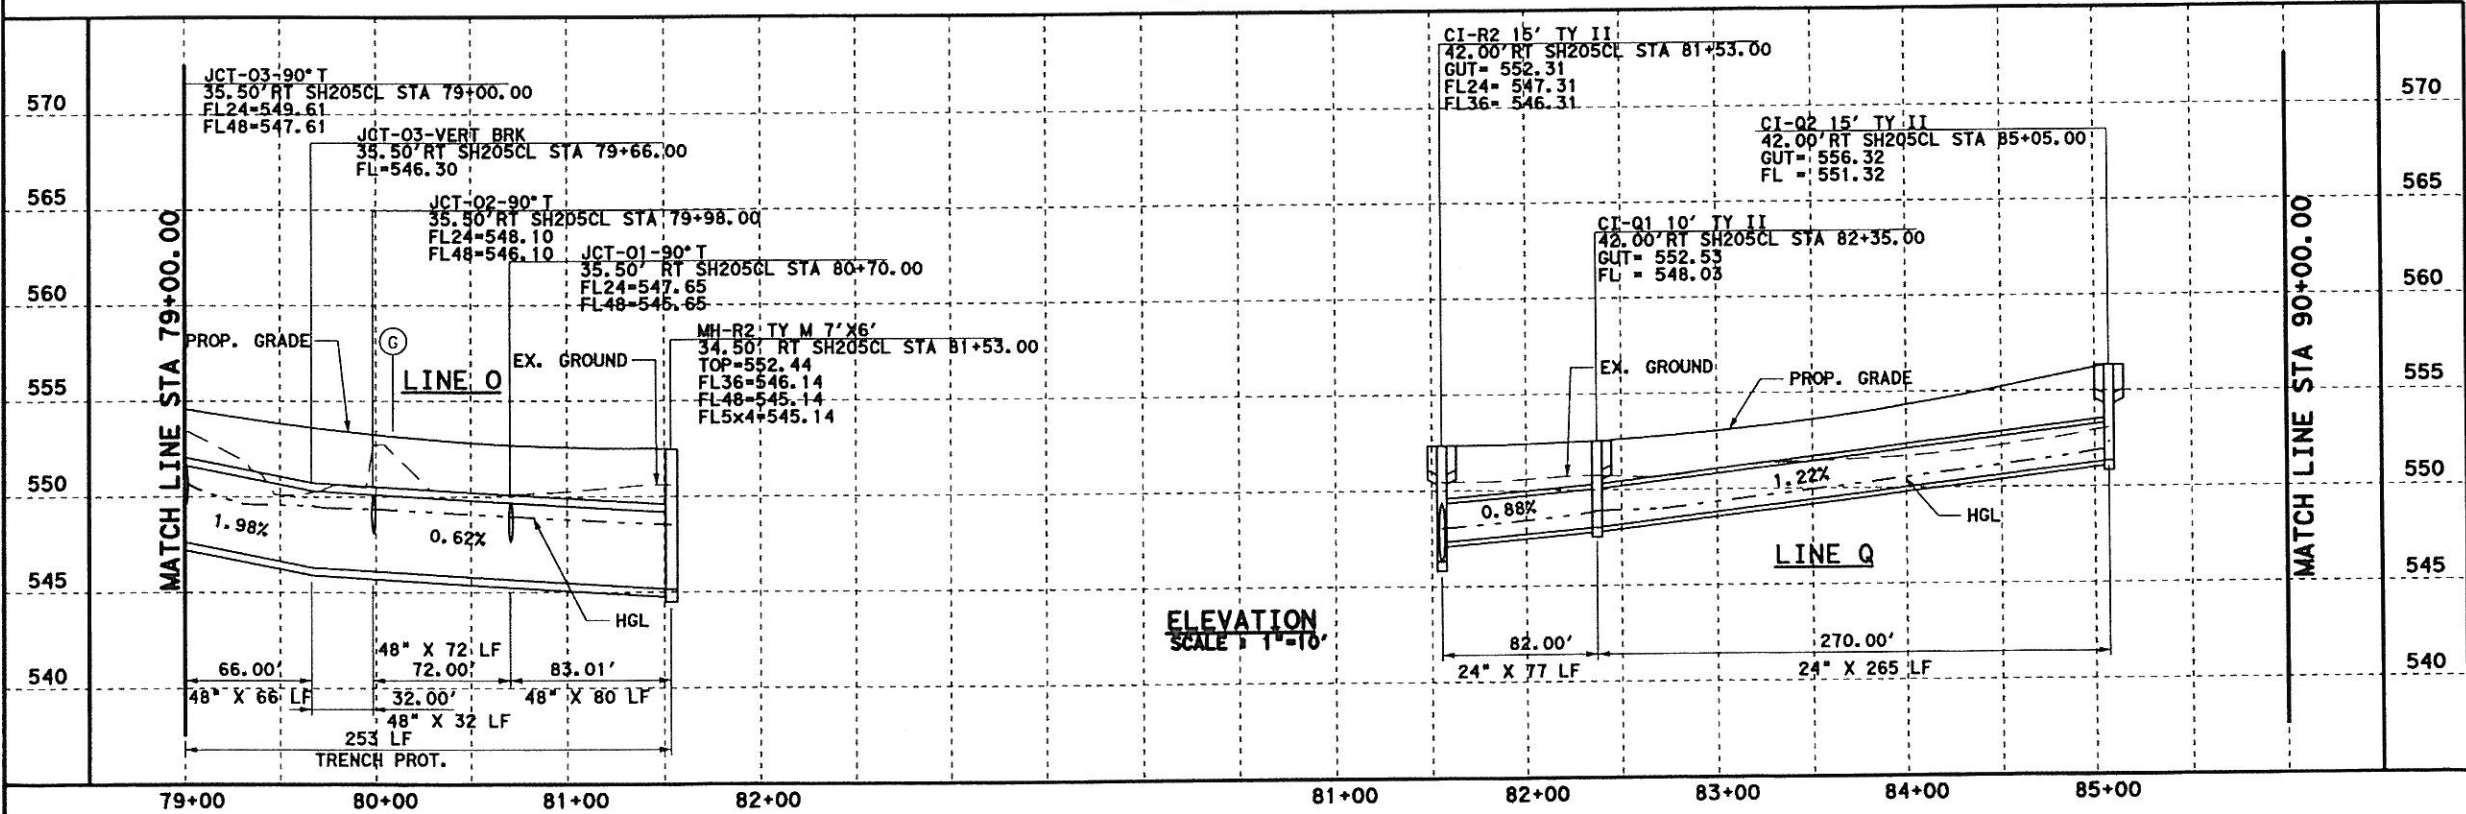

ELEVATION
SCALE 1"=10'





PB Parsons Brinckerhoff Quade & Douglas, Inc.
2777 Stemmons Freeway
Suite 1333
Dallas, TX 75207

Texas Department of Transportation
© 2006

SH 205
NORTHBOUND DRAINAGE
STORM SEWER PLAN & PROFILE
STA 79+00 TO 90+00
SHEET 11 OF 57


FED. AID PROJECT NO.	HIGHWAY NO.		
6	SH 205		
(SEE TITLE SHEET)			
STATE	DIST.	COUNTY	SHEET NO.
TEXAS	DALLAS	ROCKWALL	411
CONT.	SECT.	JOB	
0451	01	032, ETC	

D:\H-G\JOBS\22451C-SH205\Drawings\2451\cddp\09.dgn, ON=10-11, 13-622
 5/9/2006 P:\cadd\09-MAY-2006 12:57

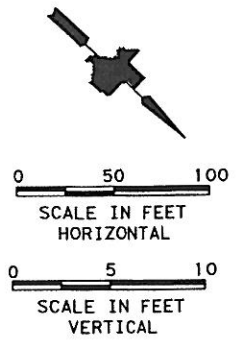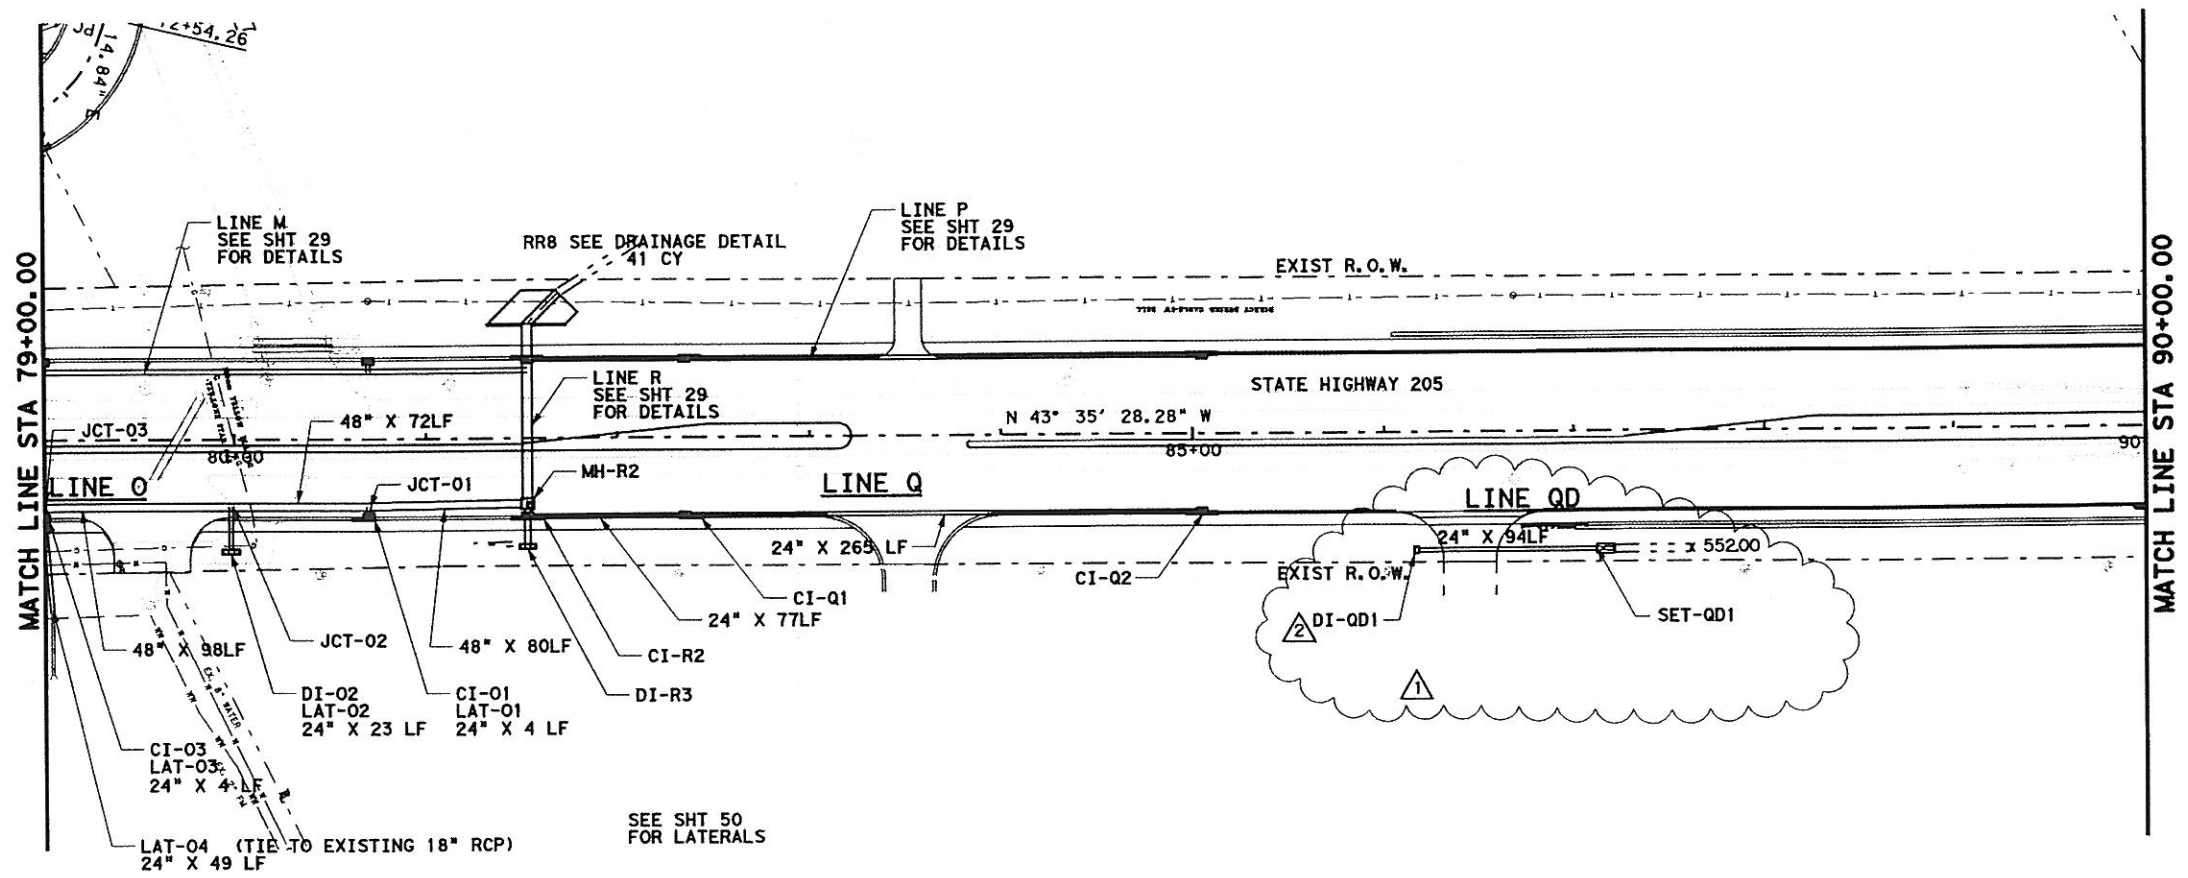


- GENERAL NOTES**
1. CURB INLETS STATION AND OFFSET ARE MEASURED TO THE MIDPOINT OF THE FACE OF MAIN INLET. GRATE INLETS STATION AND OFFSET ARE MEASURED TO THE CENTER OF THE INLET.
 2. JUNCTION BOX STATION AND OFFSET ARE MEASURED TO THE CENTER OF THE JUNCTION BOX.
 3. ALL PIPES ARE CLASS III RCP UNLESS OTHERWISE NOTED.

- LEGENDS**
- (G) EX. GAS LINE CROSSING ELEVATION UNKNOWN
 - (T) EX. SW BELL CABLE CROSSING ELEVATION UNKNOWN

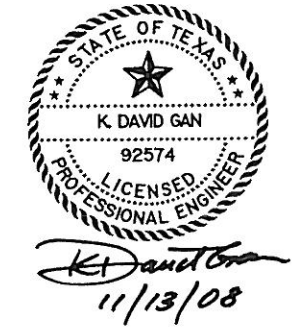

PLAN
SCALE: 1"=100'

Change Order #58

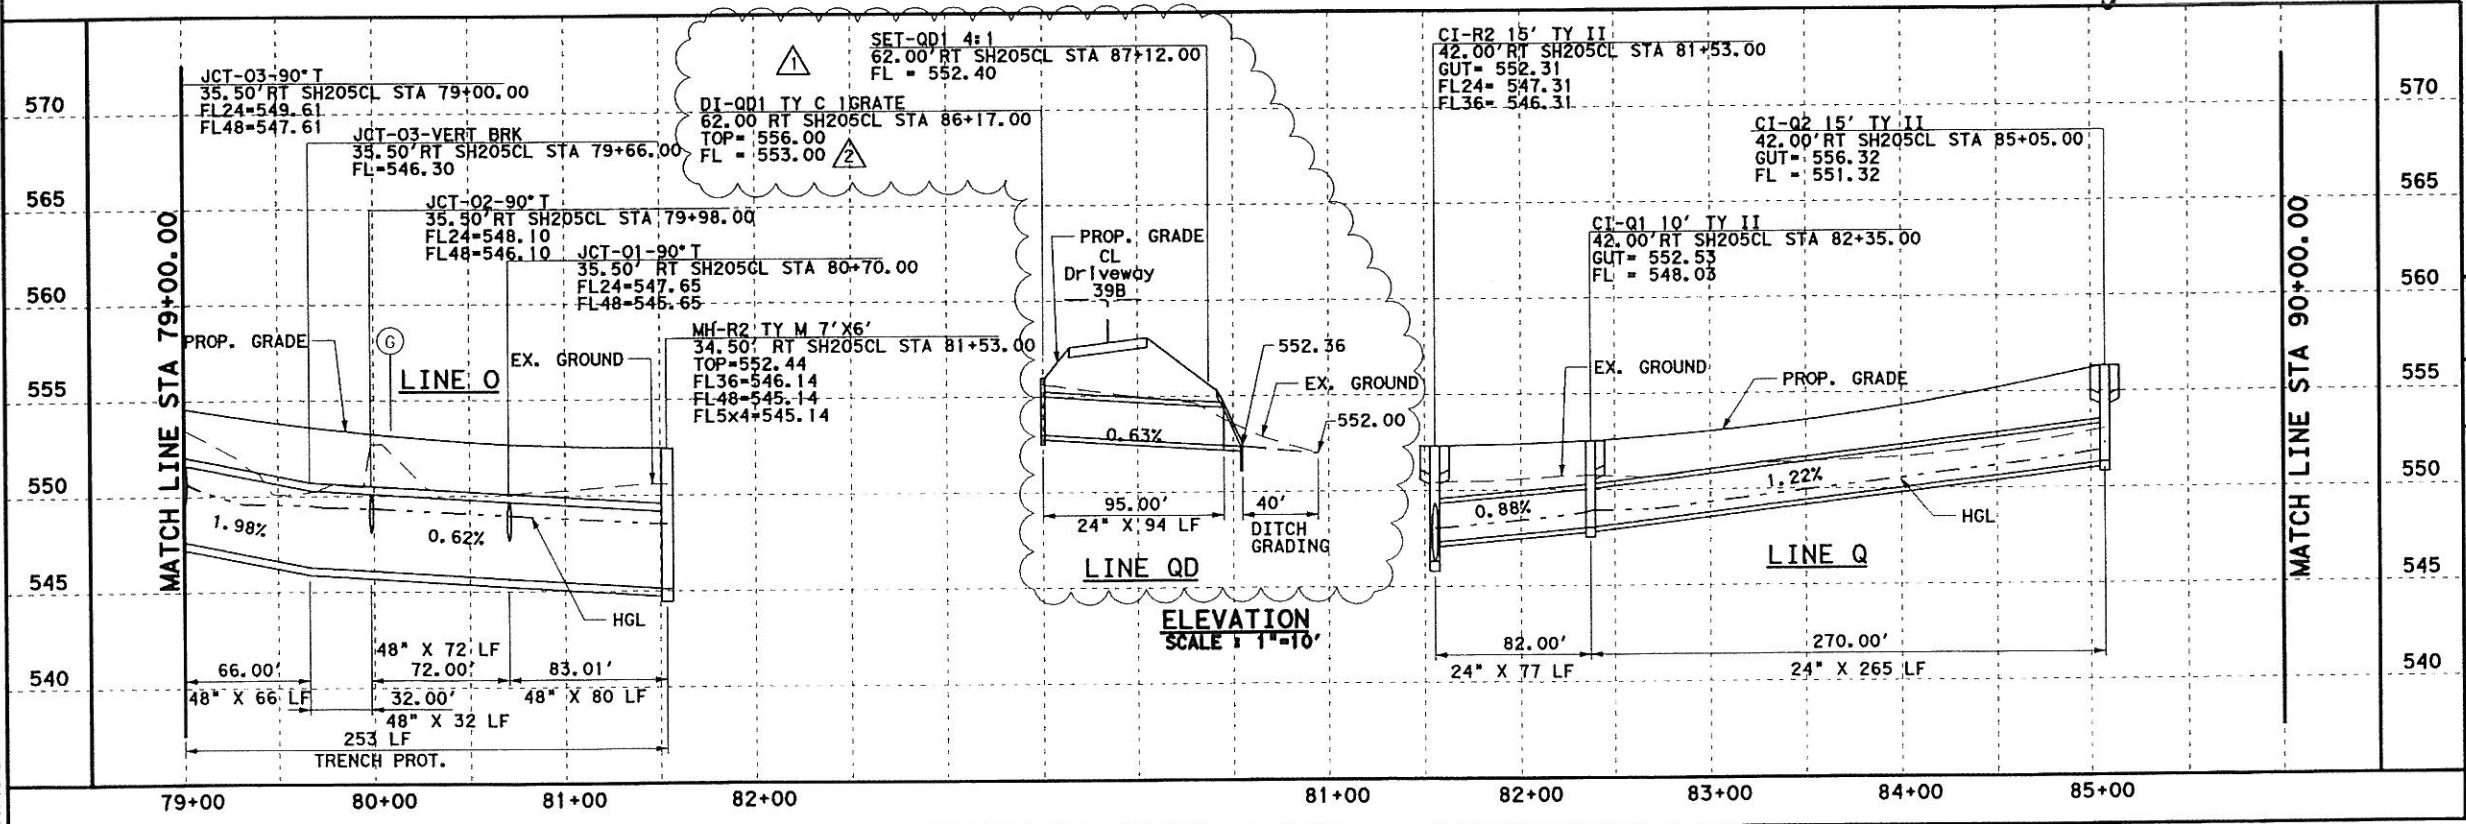

ELEVATION
SCALE: 1"=10'

2 RELOCATED INLET DI-QD1
 1 ADDED LINE QD FOR DRIVEWAY 39B

PB Parsons Brinckerhoff Quade & Douglas, Inc.
 2777 Stemmons Freeway
 Suite 1333
 Dallas, TX 75207



T Texas Department of Transportation
 © 2008

SH 205
 NORTHBOUND DRAINAGE
 STORM SEWER PLAN & PROFILE
 STA 79+00 TO 90+00
 SHEET 11 OF 57

FED. NO. DIV. NO.	FEDERAL AID PROJECT NO.	HIGHWAY NO.
6	(SEE TITLE SHEET)	SH 205
STATE	DIST.	COUNTY
TEXAS	DALLAS	ROCKWALL
CONT.	SECT.	JOB
0451	01	032, ETC

SHEET NO. 411A

DGN: G:\JOBS\22451\C-SH205\Drawings\cspn09-REV1-06.dgn, ON: 10-11, 13-627
 11/13/2008 Plotfile: 13-NOV-2008 10:27

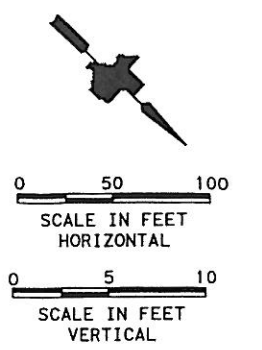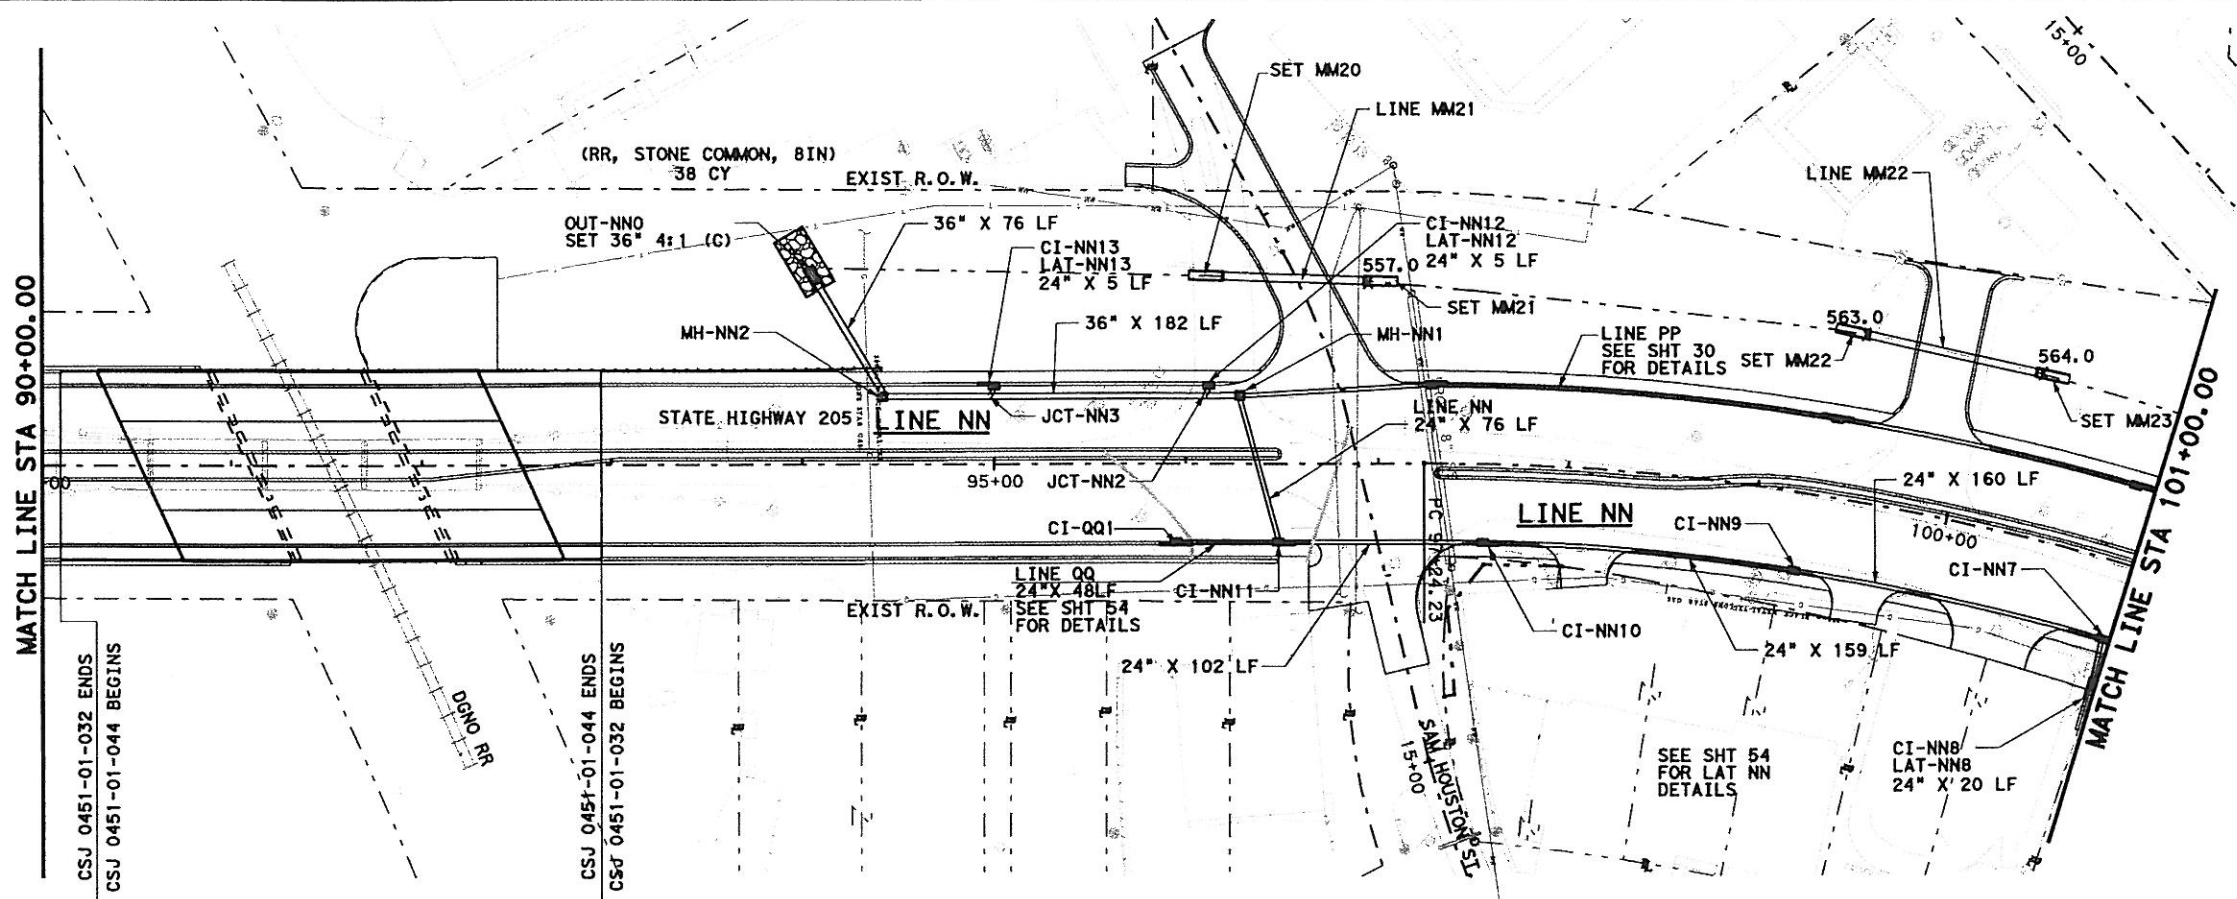


- GENERAL NOTES**
- CURB INLETS STATION AND OFFSET ARE MEASURED TO THE MIDPOINT OF THE FACE OF MAIN INLET. GRATE INLETS STATION AND OFFSET ARE MEASURED TO THE CENTER OF THE INLET.
 - JUNCTION BOX STATION AND OFFSET ARE MEASURED TO THE CENTER OF THE JUNCTION BOX.
 - ALL PIPES ARE CLASS III RCP UNLESS OTHERWISE NOTED.


- LEGENDS**
- (C) EX. GAS LINE CROSSING ELEVATION UNKNOWN
 - (I) EX. SW BELL CABLE CROSSING ELEVATION UNKNOWN

- ① OUT-NNO 4:1
103.00' LT SH205CL STA 94+03.00
FL = 552.47
- ② MH-NN2 TY M MH 5X5
35.50' LT SH205CL STA 94+41.98
TOP = 563.79
FL = 552.71
- ③ JCT-NN3 60°Y
35.50' LT SH205CL STA 94+97.69
FL24=553.88
FL36=552.88
- ④ JCT-NN2 60°Y
35.50' LT SH205CL STA 96+09.69
FL24=554.21
FL36=553.21
- ⑤ MH-NN1 TY M 5'X5'
35.50' LT SH205CL STA 96+28.00
TOP = 559.69
FL24=554.27
FL36= 553.27
- ⑥ CI-NN11 10' TY II
42.00' RT SH205CL STA 96+48.00
GUT = 559.51
FL = 555.01
- ⑦ CI-NN10 10' TY II
42.00' RT SH205CL STA 97+56.00
GUT = 560.98
FL = 556.48
- ⑧ CI-NN9 5' TY II
42.00' RT SH205CL STA 99+25.00
GUT = 564.78
FL = 560.28
- ⑨ CI-NN7 10' TY II
42.00' RT SH205CL STA 100+96.00
GUT=568.63
FL=562.76

PLAN
SCALE 1"=100'

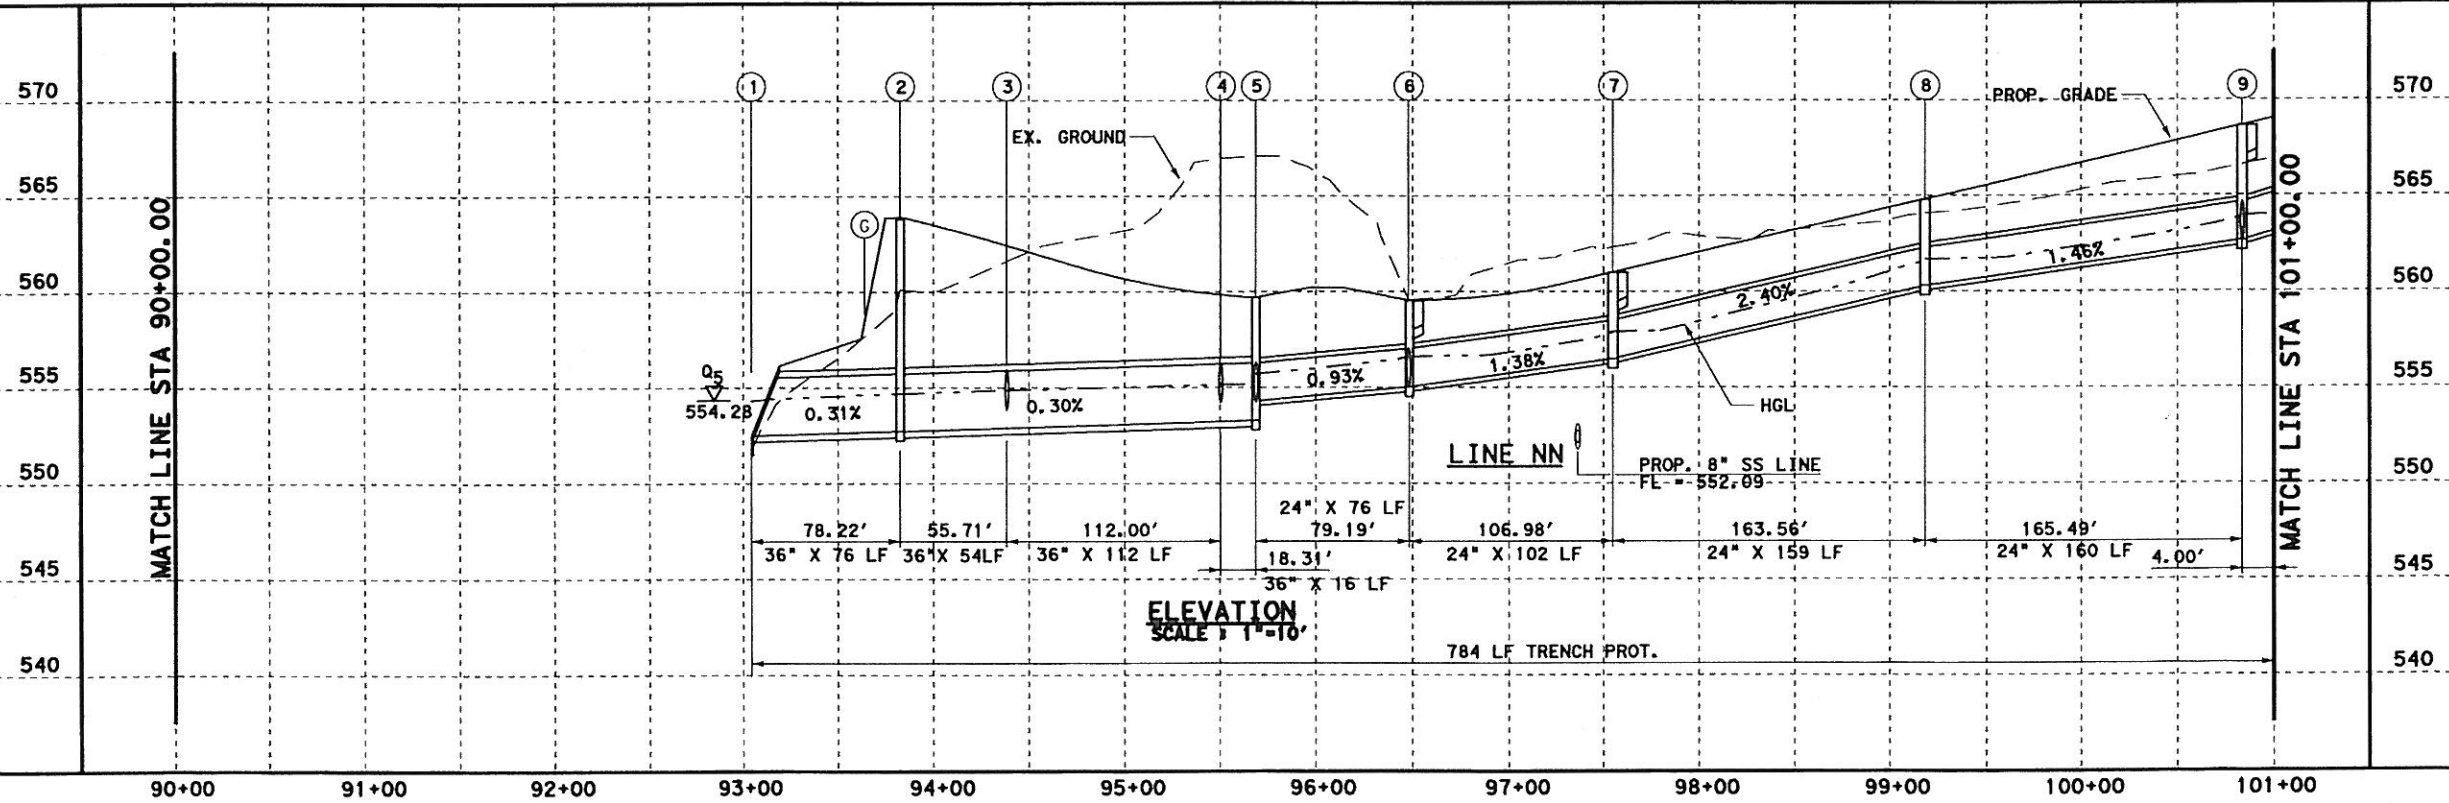

ELEVATION
SCALE 1"=10'

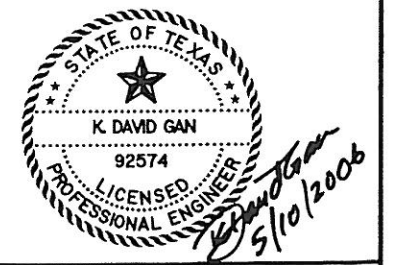



Parsons Brinckerhoff Quade & Douglas, Inc.
2777 Stammons Freeway
Suite 1333
Dallas, TX 75207

Texas Department of Transportation
© 2006

SH 205
NORTHBOUND DRAINAGE
STORM SEWER PLAN & PROFILE
STA 90+00 TO 101+00
SHEET 12 OF 57

FED. AID DIST. NO.	FEDERAL AID PROJECT NO.	HIGHWAY NO.
6	(SEE TITLE SHEET)	SH 205
STATE	DIST.	COUNTY
TEXAS	DALLAS	ROCKWALL
CONT.	SECT.	JOB
0451	01	032. ETC
		SHEET NO.
		412

D:\G:\JOBS\2451C-SH205\Drawings\2451c\shp10.dgn, ON=CO-11, 13-623
 5/10/2006 Plotted 10-MAY-2006 09:23

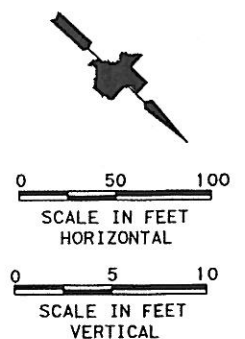
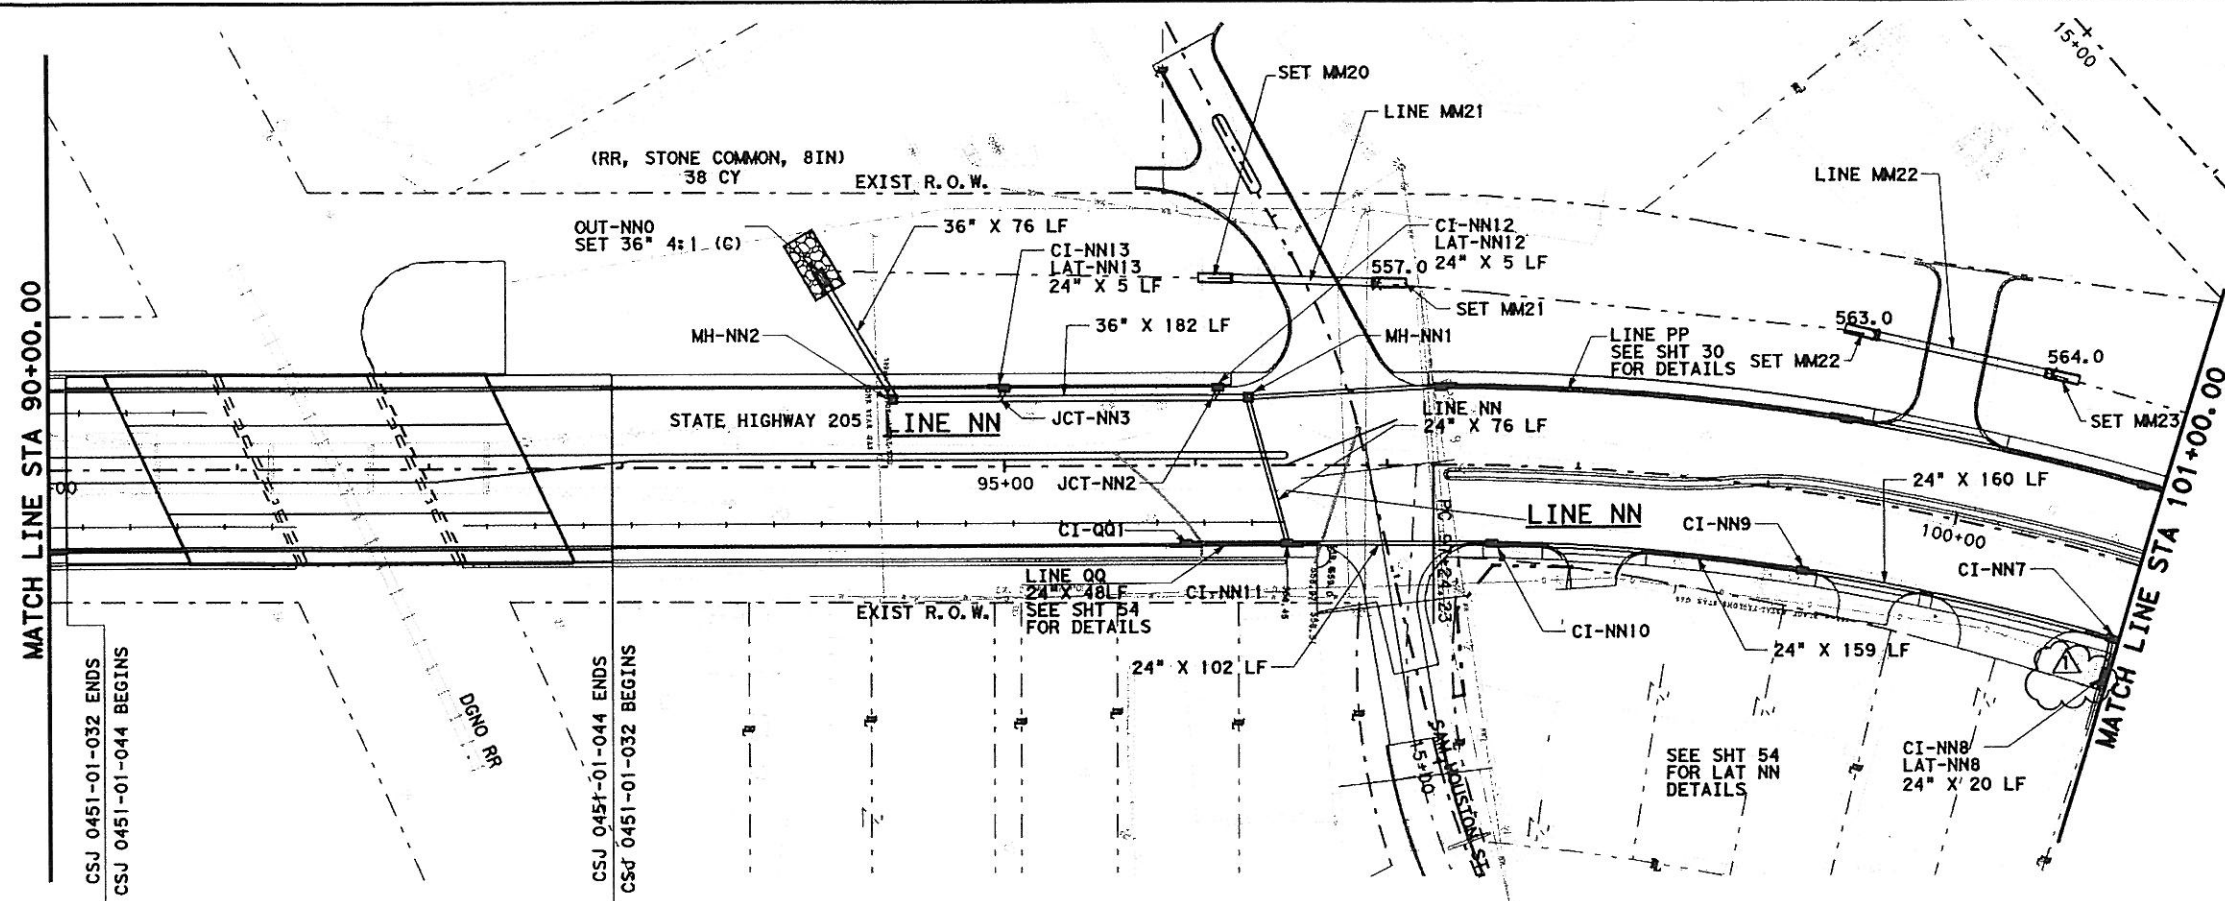


- GENERAL NOTES**
1. CURB INLETS STATION AND OFFSET ARE MEASURED TO THE MIDPOINT OF THE FACE OF MAIN INLET. GRATE INLETS STATION AND OFFSET ARE MEASURED TO THE CENTER OF THE INLET.
 2. JUNCTION BOX STATION AND OFFSET ARE MEASURED TO THE CENTER OF THE JUNCTION BOX.
 3. ALL PIPES ARE CLASS III RCP UNLESS OTHERWISE NOTED.

- LEGENDS**
- (G) EX. GAS LINE CROSSING ELEVATION UNKNOWN
 - (T) EX. SW BELL CABLE CROSSING ELEVATION UNKNOWN

- ① OUT-NN0 4:1
103.00' LT SH205CL STA 94+03.00
FL = 552.47
- ② MH-NN2 TY M MH 5X5
35.50' LT SH205CL STA 94+41.98
TOP = 563.79
FL = 552.71
- ③ JCT-NN3 60°Y
35.50' LT SH205CL STA 94+97.69
FL24=553.88
FL36=552.88
- ④ JCT-NN2 60°Y
35.50' LT SH205CL STA 96+09.69
FL24=554.21
FL36=553.21
- ⑤ MH-NN1 TY M 5'X5'
35.50' LT SH205CL STA 96+28.00
TOP = 559.69
FL24=554.27
FL36= 553.27
- ⑥ CI-NN11 10' TY II
42.00' RT SH205CL STA 96+48.00
GUT = 559.51
FL = 555.01
- ⑦ CI-NN10 10' TY II
42.00' RT SH205CL STA 97+56.00
GUT = 560.98
FL = 556.48
- ⑧ CI-NN9 5' TY II
42.00' RT SH205CL STA 99+25.00
GUT = 564.78
FL = 560.28
- ⑨ CI-NN7 10' TY II
42.00' RT SH205CL STA 100+96.00
GUT = 568.63
FL = 562.63



PLAN
SCALE 1"=100'

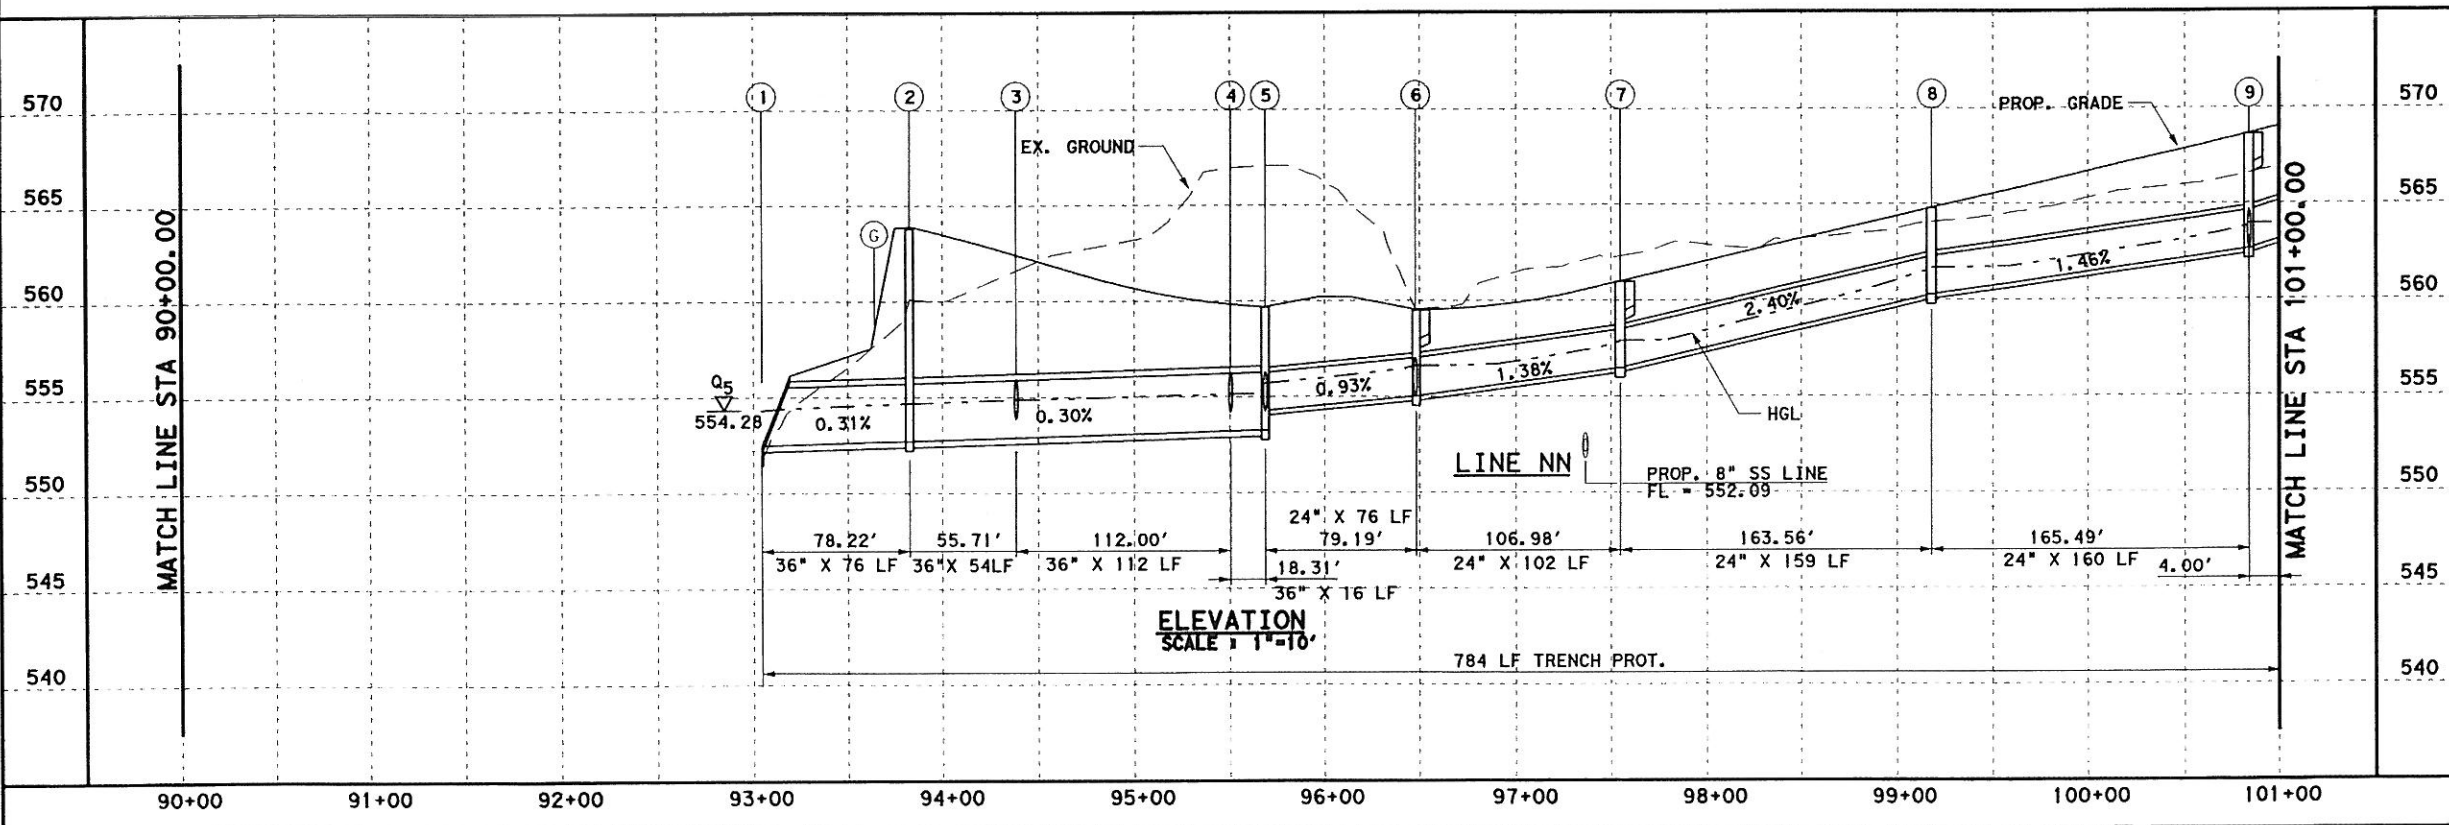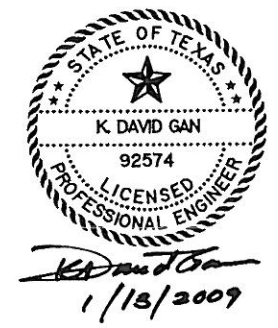

ELEVATION
SCALE 1"=10'

1109-05-08	REV NN7 FL, NN8 ORIENT	AM
Parsons Brinckerhoff Quade & Douglas, Inc. 2777 Stemmons Freeway Suite 1333 128 Dallas, TX 75207		
Texas Department of Transportation © 2008		
SH 205		
NORTHBOUND DRAINAGE		
STORM SEWER PLAN & PROFILE STA 90+00 TO 101+00		
SHEET 12 OF 57		
FED. RD. DIST. NO.	FEDERAL AID PROJECT NO.	HIGHWAY NO.
6	(SEE TITLE SHEET)	SH 205
STATE	DIST.	COUNTY
TEXAS	DALLAS	ROCKWALL
CONT.	SECT.	JOB
0451	01	032, ETC
		SHEET NO.
		412A

D:\n\0451\22451C-SH205\Drawings\2451\sdn10.dgn, ON=10-11, 13-623
 1/13/2009 Plotted 13-JAN-2009 19:46

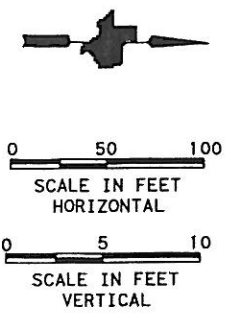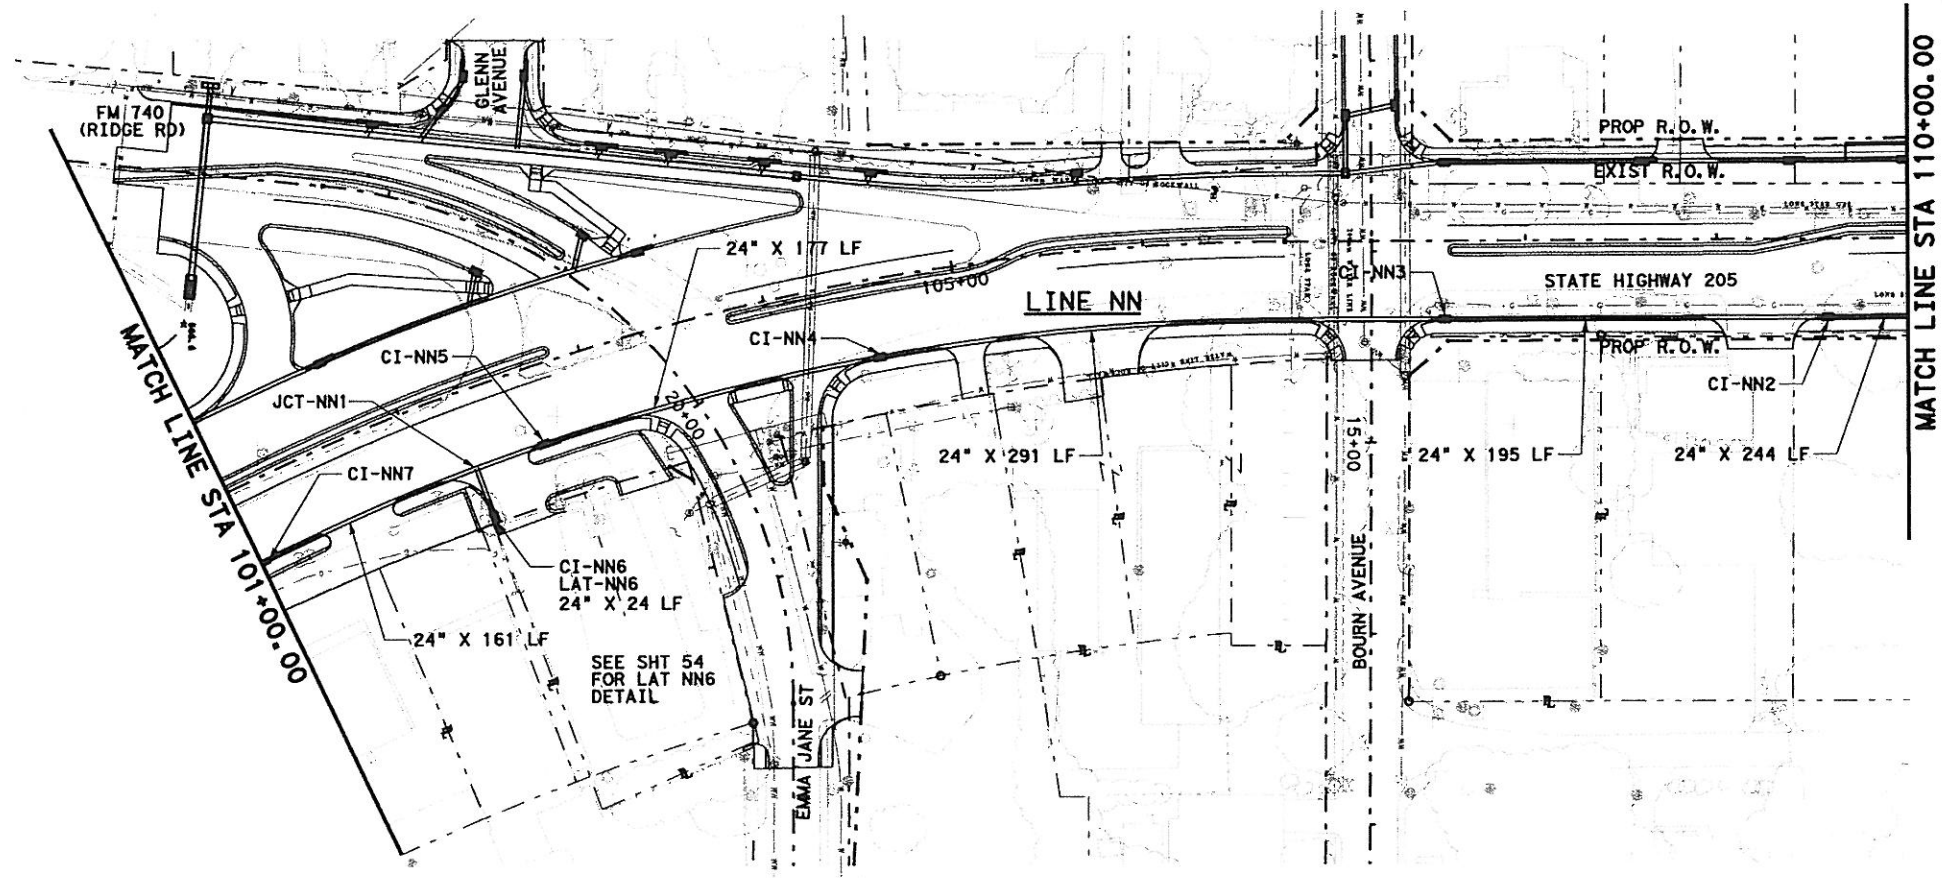

GENERAL NOTES


1. CURB INLETS STATION AND OFFSET ARE MEASURED TO THE MIDPOINT OF THE FACE OF MAIN INLET. GRATE INLETS STATION AND OFFSET ARE MEASURED TO THE CENTER OF THE INLET.
2. JUNCTION BOX STATION AND OFFSET ARE MEASURED TO THE CENTER OF THE JUNCTION BOX.
3. ALL PIPES ARE CLASS III RCP UNLESS OTHERWISE NOTED.

LEGENDS


- (G) EX. GAS LINE CROSSING
ELEVATION UNKNOWN
- (T) EX. SW BELL CABLE CROSSING
ELEVATION UNKNOWN

CI-NN7 10' TY II
42.00' RT SH205CL STA 100+96.00
GUT = 568.63
FL = 562.63

PLAN
SCALE 1" = 100'

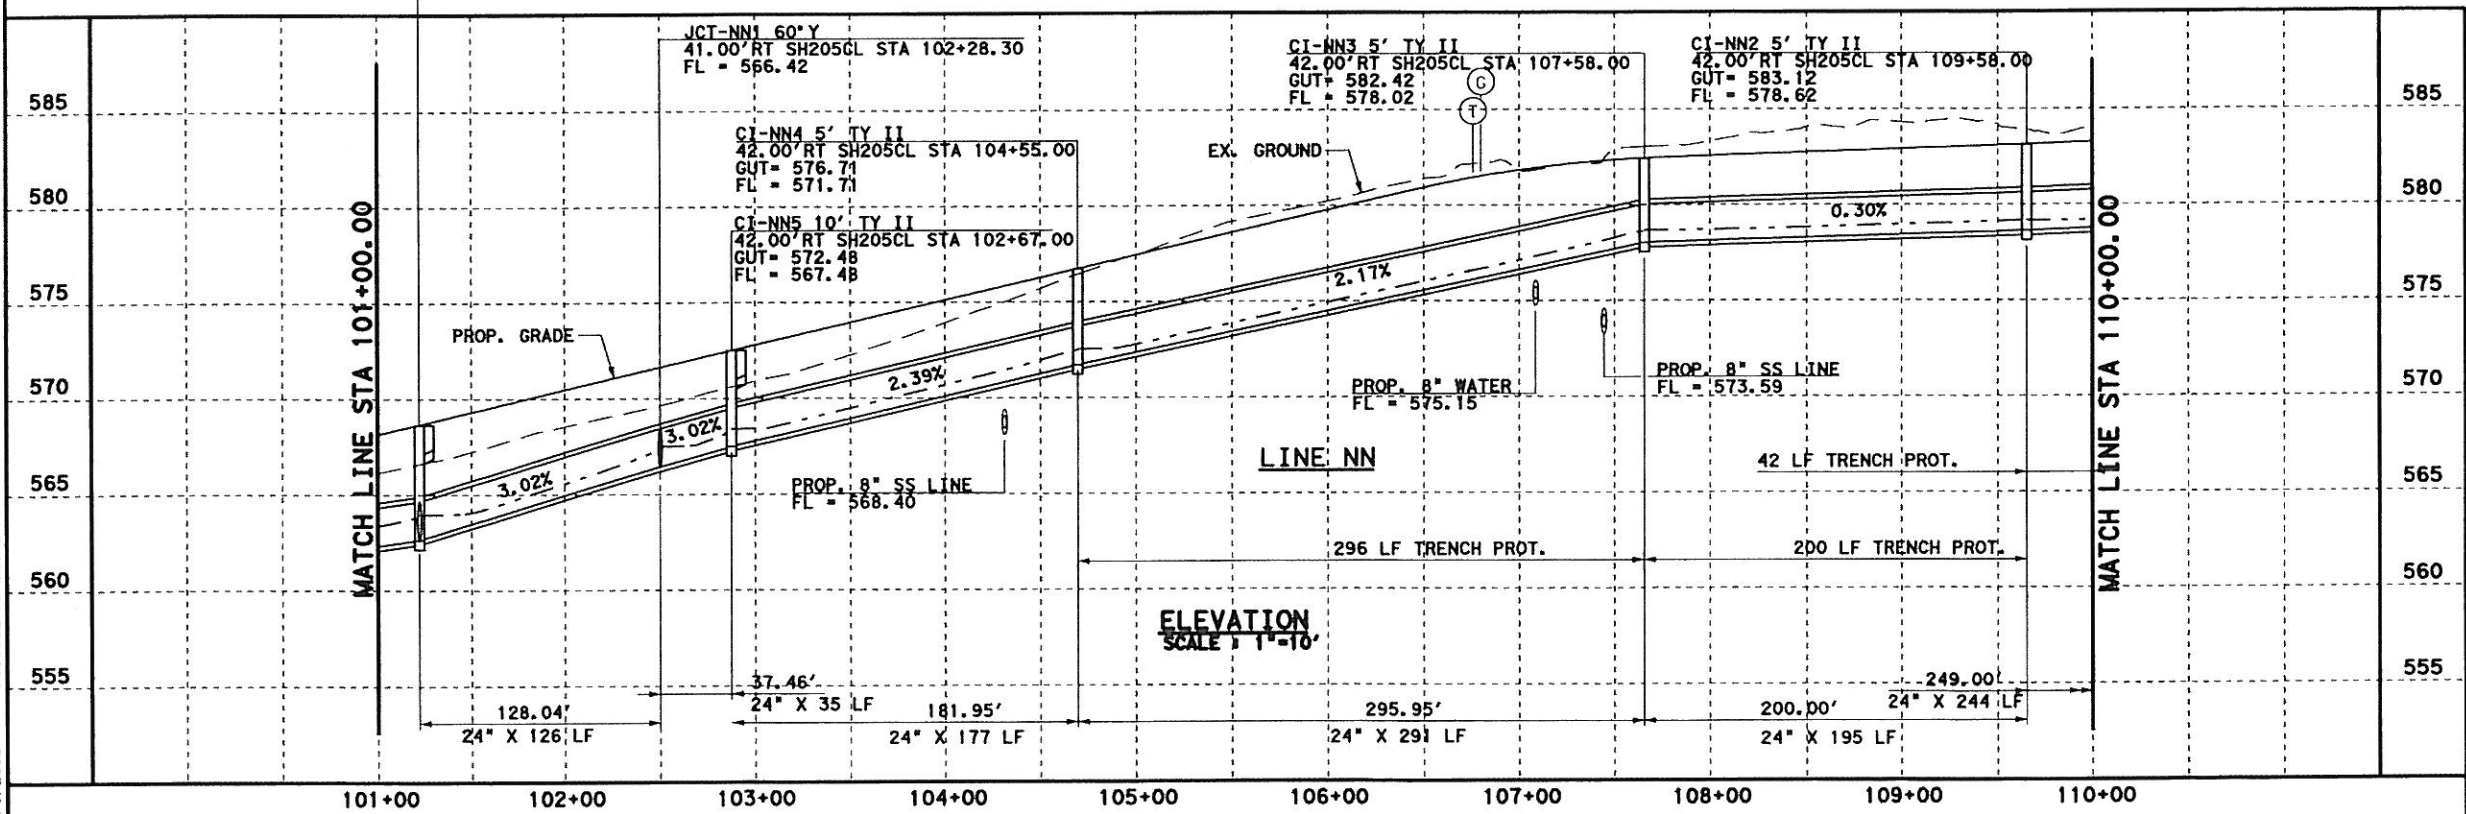

ELEVATION
SCALE 1" = 10'

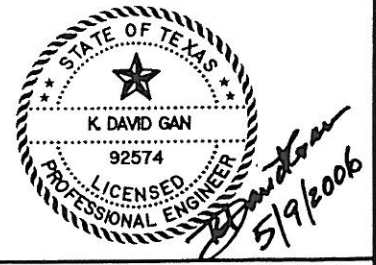



PB Parsons Brinckerhoff Quade & Douglas, Inc.
2777 Stemmons Freeway
Suite 1333
Dallas, TX 75207

Texas Department of Transportation
© 2006

SH 205
NORTHBOUND DRAINAGE
STORM SEWER PLAN & PROFILE
STA 101+00 TO 110+00
SHEET 13 OF 57


FED. PROJ. NO.	FEDERAL AID PROJECT NO.	HIGHWAY NO.
6	(SEE TITLE SHEET)	SH 205
STATE	DIST.	COUNTY
TEXAS	DALLAS	ROCKWALL
CONT.	SECT.	JOB
0451	01	032, ETC

DGN: g1\JOBS\22451C-SH205.Dwg
 P:\Jobs\22451C-SH205.Dwg
 5/9/2006

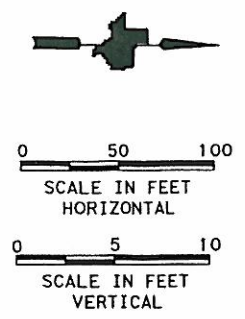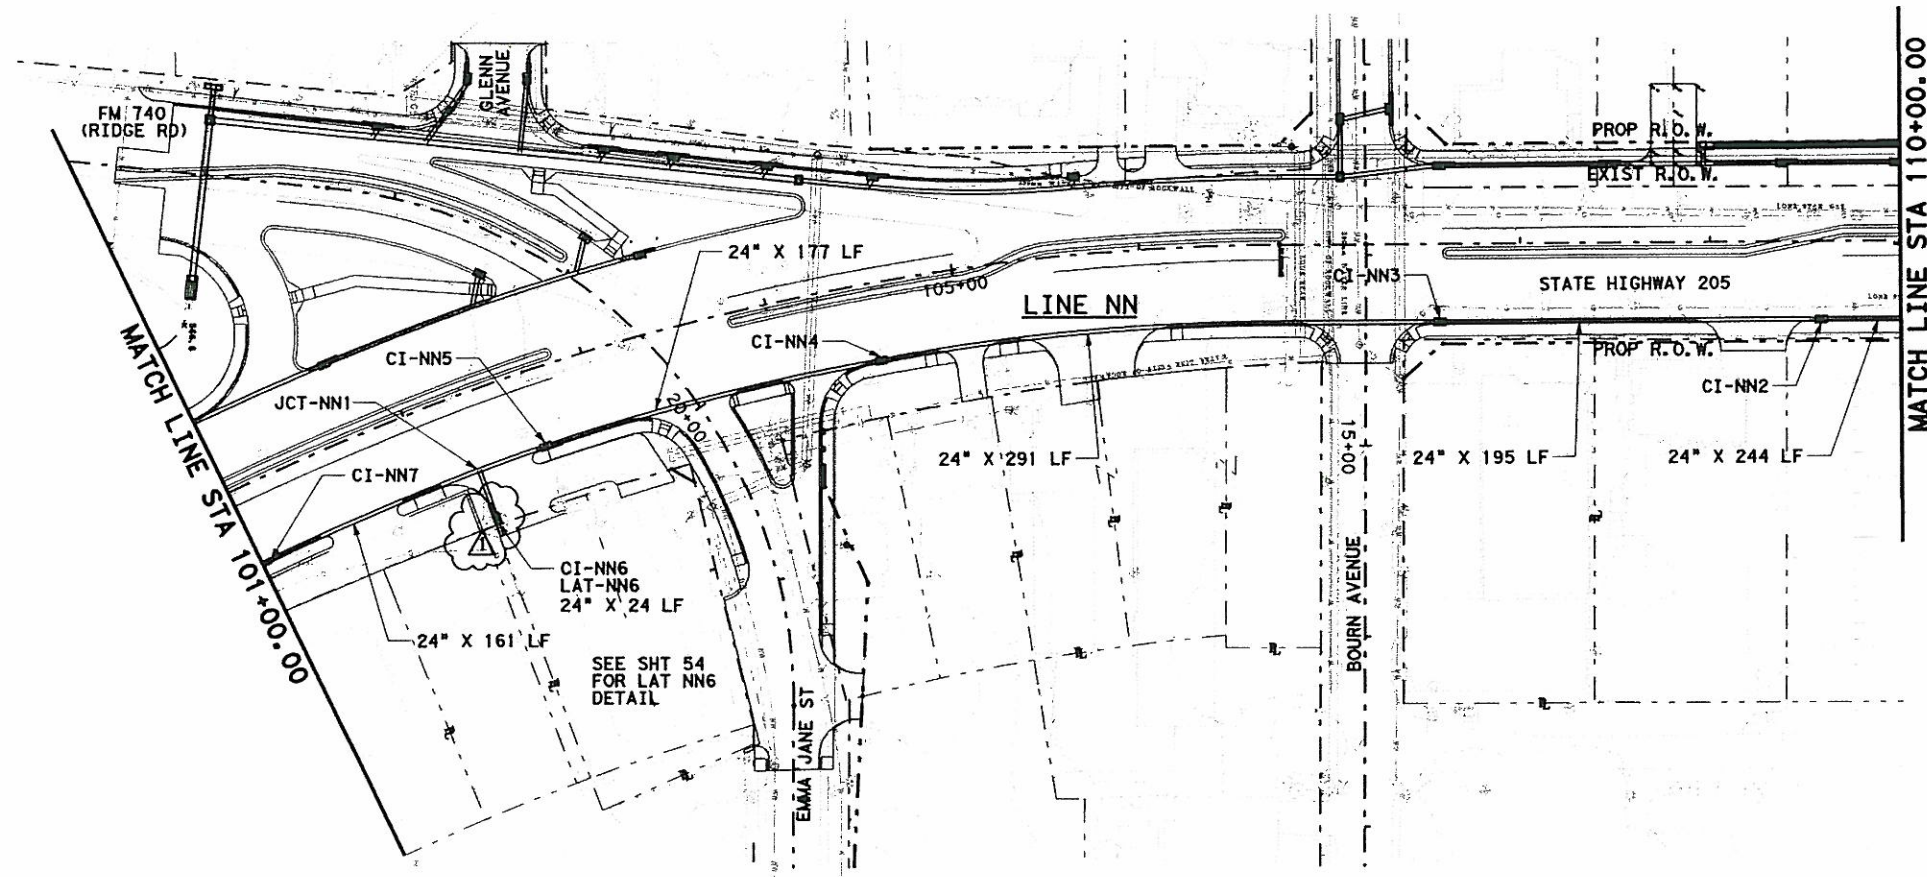


- GENERAL NOTES**
1. CURB INLETS STATION AND OFFSET ARE MEASURED TO THE MIDPOINT OF THE FACE OF MAIN INLET. GRATE INLETS STATION AND OFFSET ARE MEASURED TO THE CENTER OF THE INLET.
 2. JUNCTION BOX STATION AND OFFSET ARE MEASURED TO THE CENTER OF THE JUNCTION BOX.
 3. ALL PIPES ARE CLASS III RCP UNLESS OTHERWISE NOTED.

- LEGENDS**
- (G) EX. GAS LINE CROSSING ELEVATION UNKNOWN
 - (T) EX. SW BELL CABLE CROSSING ELEVATION UNKNOWN

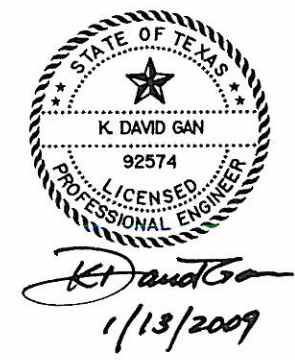

CI-NN7 10' TY II
 42.00' RT SH205CL STA 100+96.00
 GUT = 568.63
 FL = 562.63

PLAN
 SCALE 1" = 100'

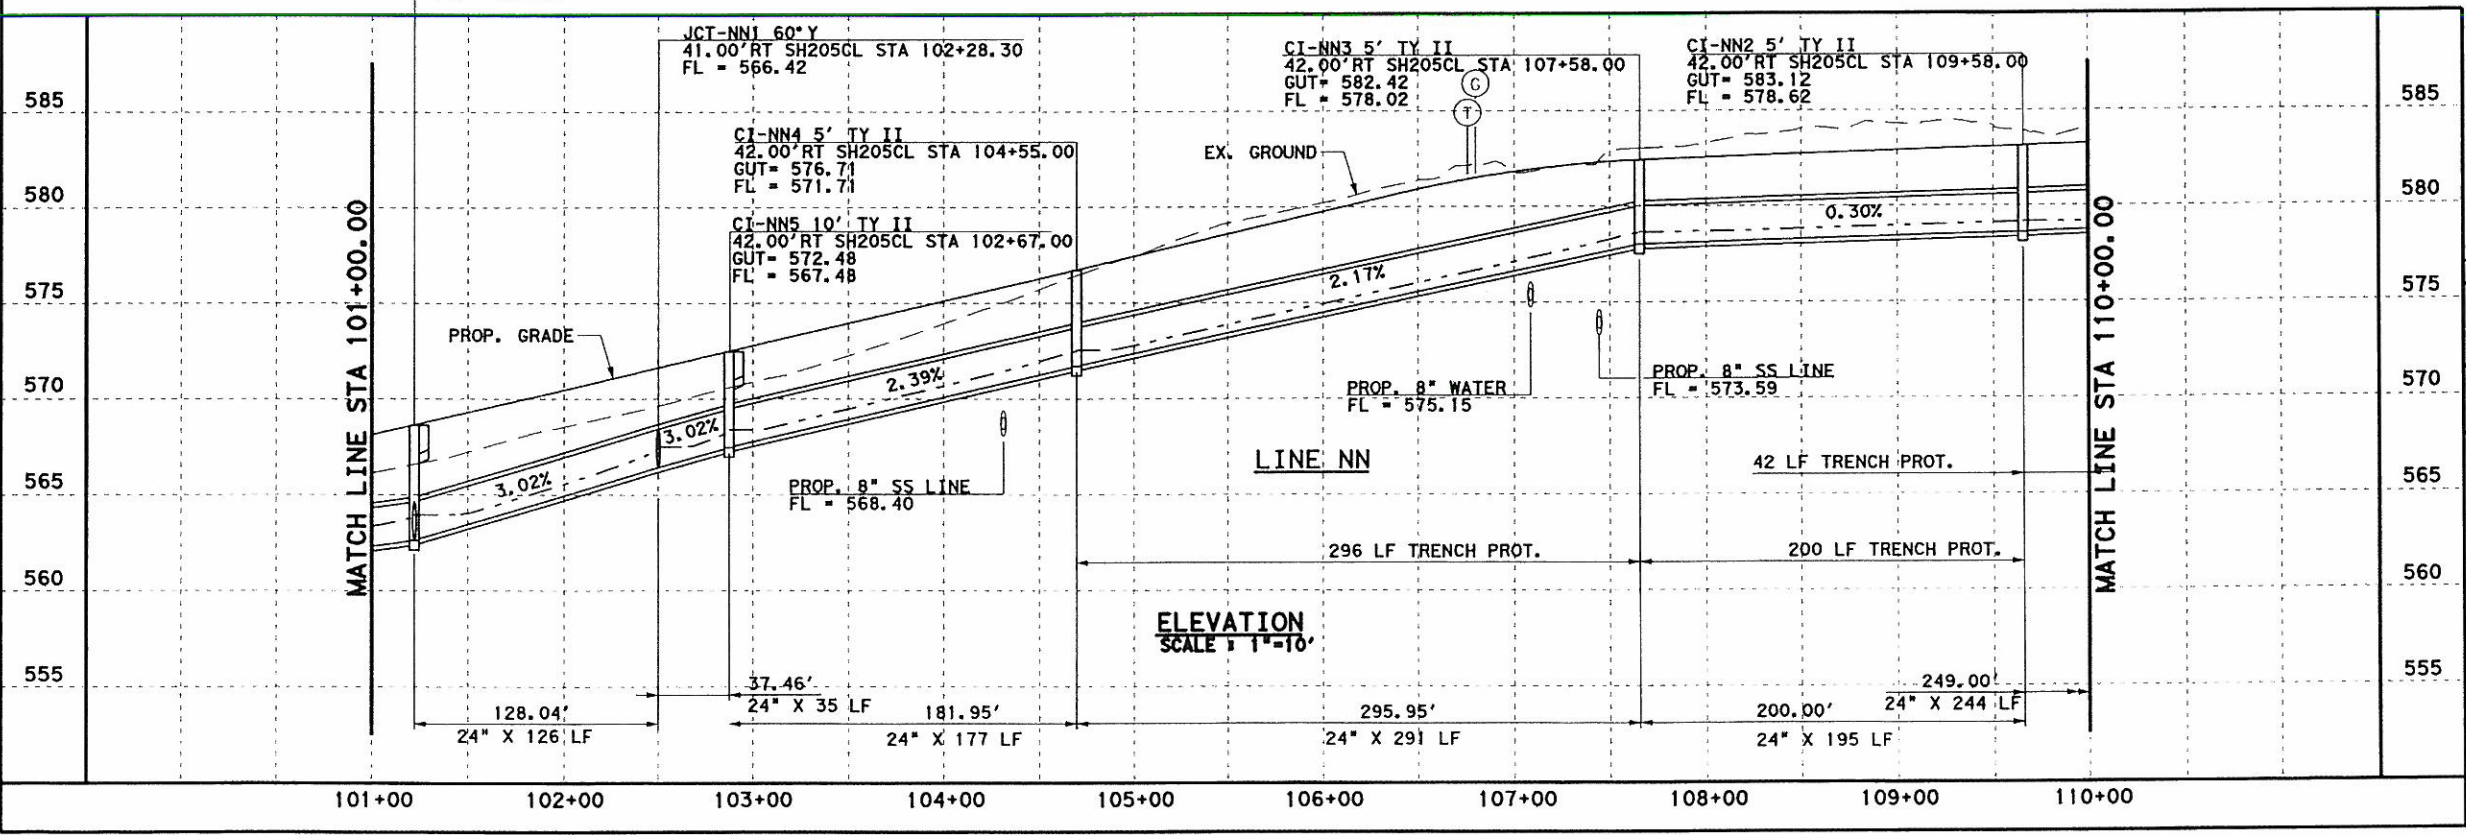



ELEVATION
 SCALE 1" = 10'

1/09-05-08 CI-INLET ORIENTATION AM
 Parsons Brinckerhoff Quade & Douglas, Inc.
 2777 Stemmons Freeway
 Suite 1333
 Dallas, TX 75207

Texas Department of Transportation
 © 2008

SH 205			
NORTHBOUND DRAINAGE			
STORM SEWER PLAN & PROFILE			
STA 101+00 TO 110+00			
SHEET 13 OF 57			
FED. NO. DIV. NO.	FEDERAL AID PROJECT NO.	HIGHWAY NO.	
6	(SEE TITLE SHEET)	SH 205	
STATE	DIST.	COUNTY	SHEET NO.
TEXAS	DALLAS	ROCKWALL	413A
CONT.	SECT.	JOB	
0451	01	032, ETC	


DGN: G:\JOBS\22451C-SH205\Drawings\2451cdpN11.dgn, ON: 10-11, 13-623
 1/13/2009 Plotted 13-JAN-2009 19:46

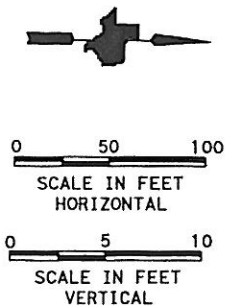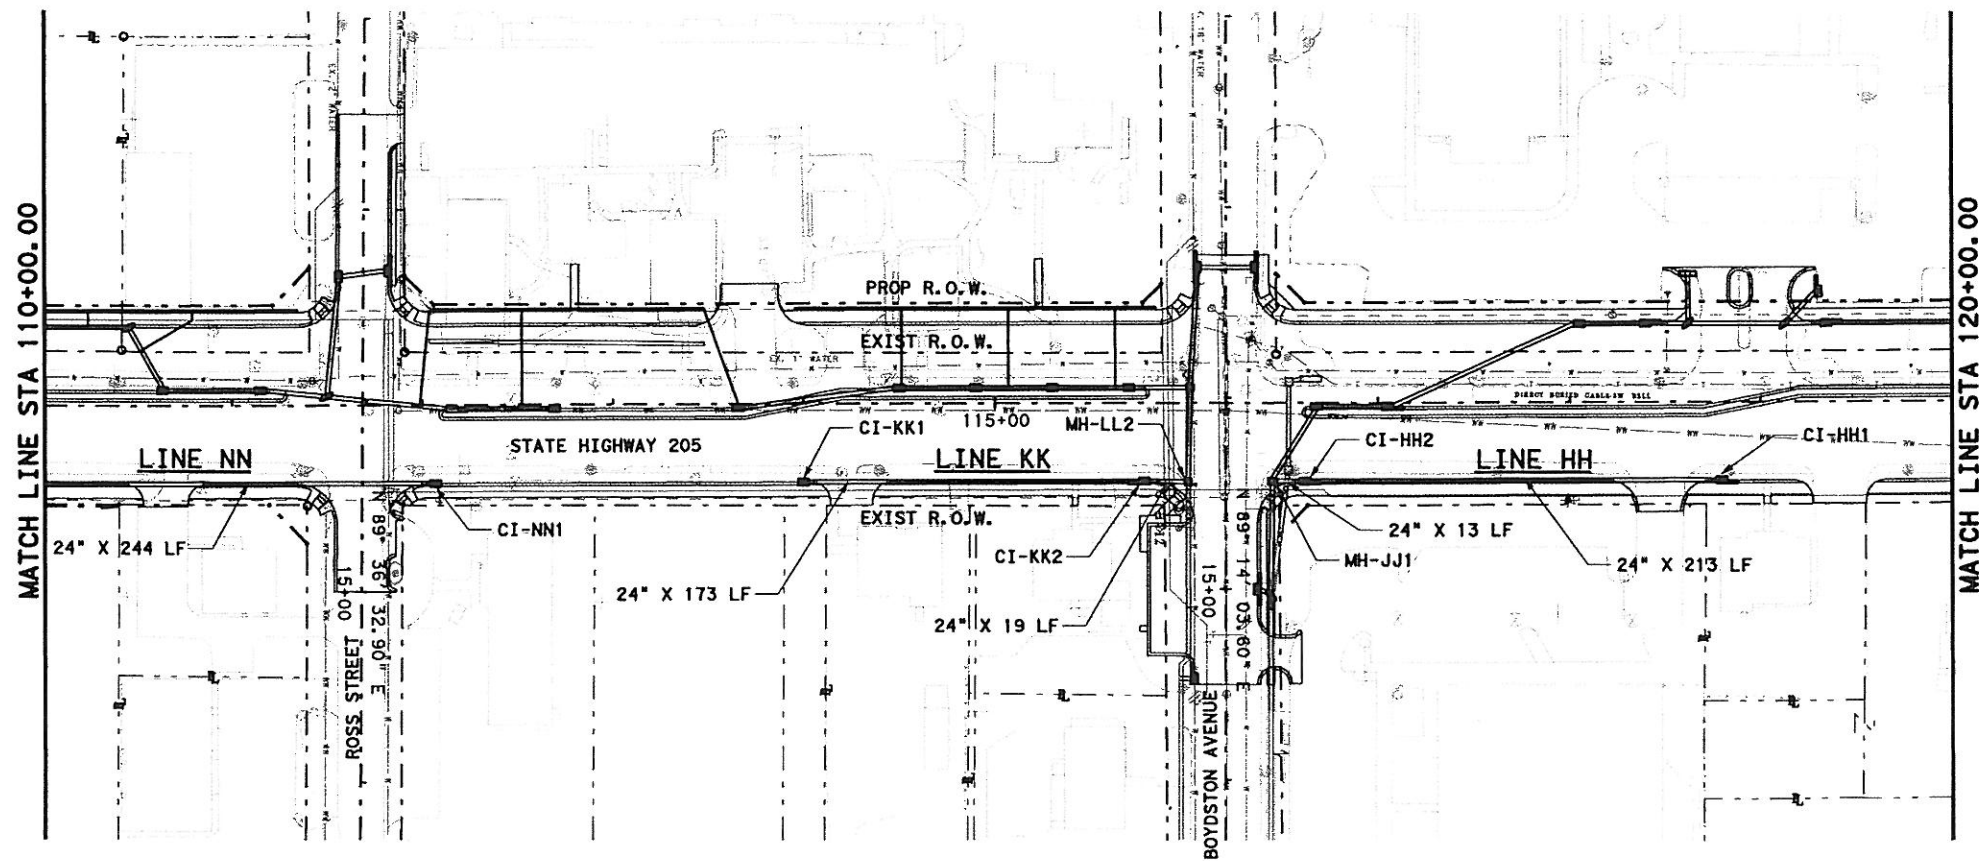

- GENERAL NOTES**
1. CURB INLETS STATION AND OFFSET ARE MEASURED TO THE MIDPOINT OF THE FACE OF MAIN INLET. GRATE INLETS STATION AND OFFSET ARE MEASURED TO THE CENTER OF THE INLET.
 2. JUNCTION BOX STATION AND OFFSET ARE MEASURED TO THE CENTER OF THE JUNCTION BOX.
 3. ALL PIPES ARE CLASS III RCP UNLESS OTHERWISE NOTED.

PLAN
SCALE: 1"=100'

D:\G1\JOBS\22451C-SH205\Drawings\2451cdp12.dwg, ON=10-11, 13-58, 60-621
 5/9/2006 P:\cadd\09-MAY-2006 12:57


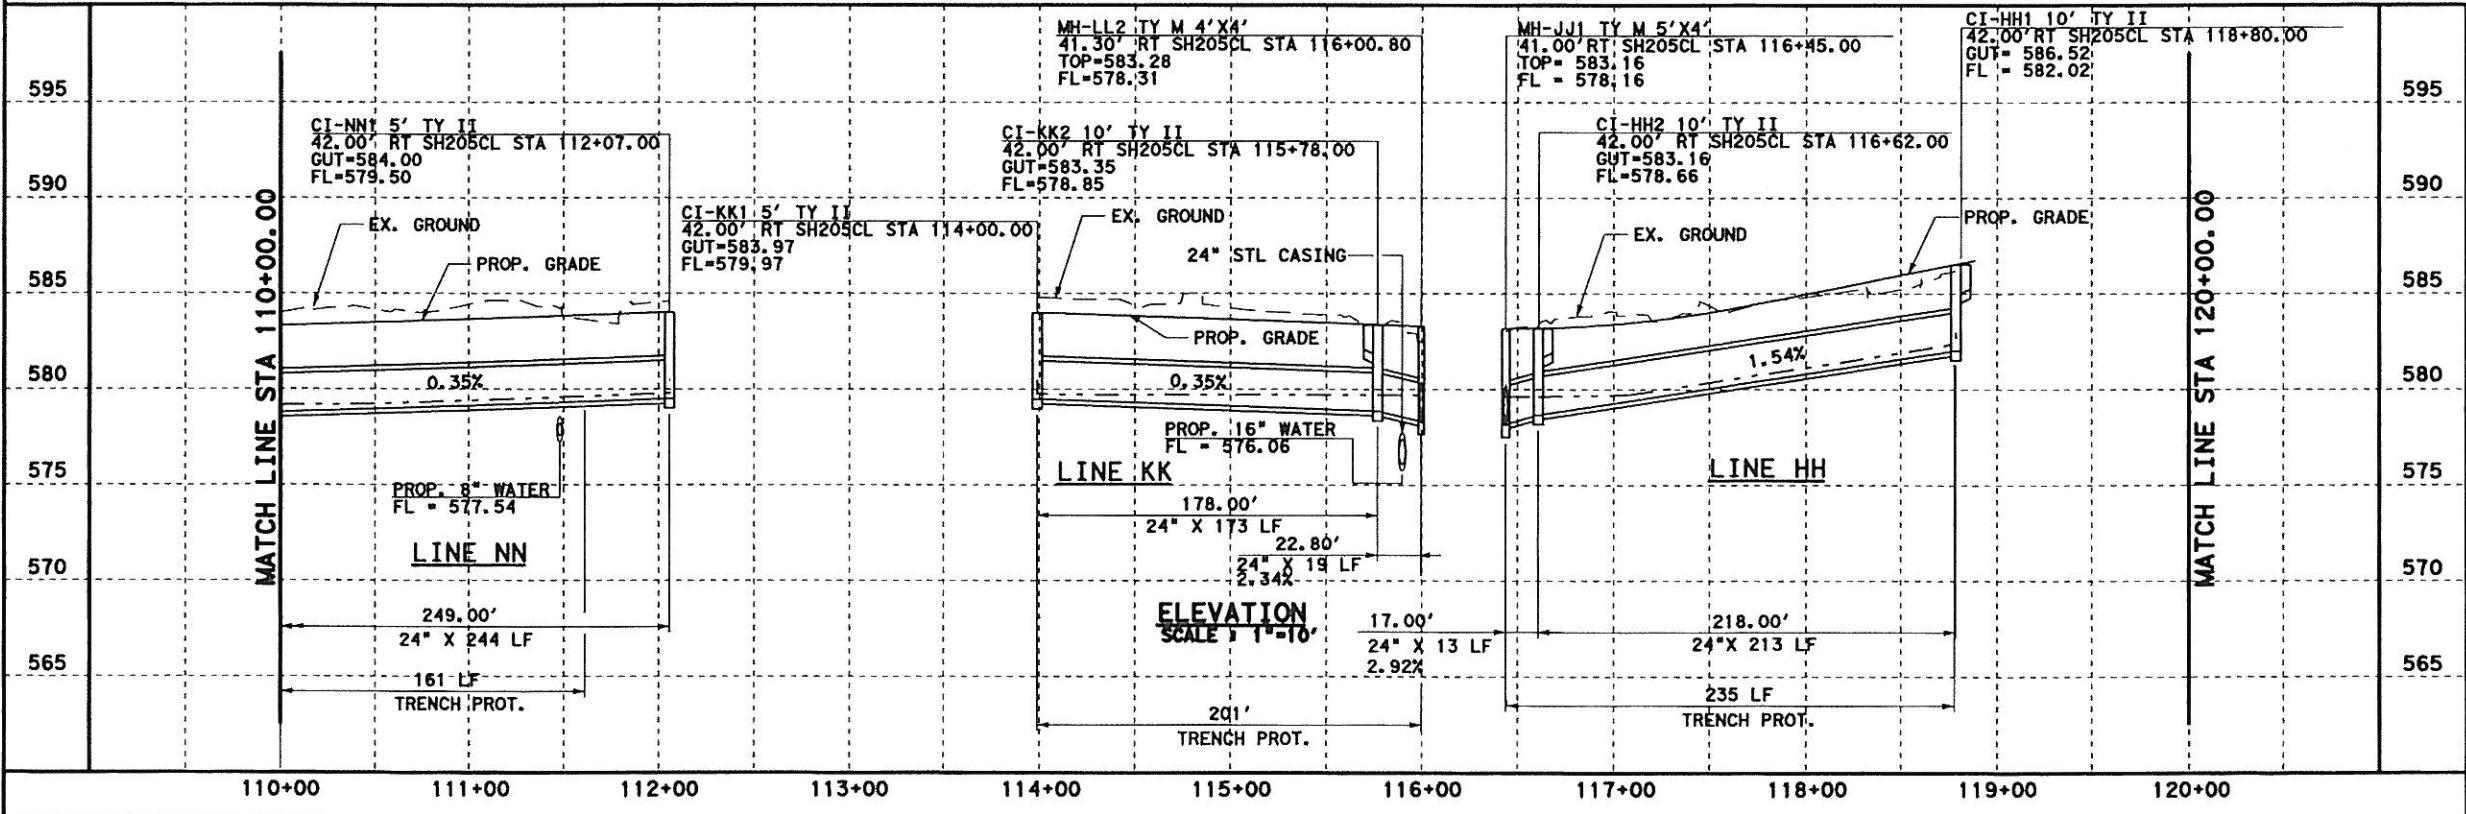


Parsons Brinckerhoff Quade & Douglas, Inc.
 2777 Stemmons Freeway
 Suite 1333
 Dallas, TX 75207

Texas Department of Transportation
 © 2006


SH 205
 NORTHBOUND DRAINAGE
 STORM SEWER PLAN & PROFILE
 STA 110+00 TO 120+00
 SHEET 14 OF 57

FED. AID DIST. NO.	FEDERAL AID PROJECT NO.	HIGHWAY NO.
6	(SEE TITLE SHEET)	SH 205
STATE	DIST.	COUNTY
TEXAS	DALLAS	ROCKWALL
CONT.	SECT.	JOB
0451	01	032. ETC
		SHEET NO.
		414

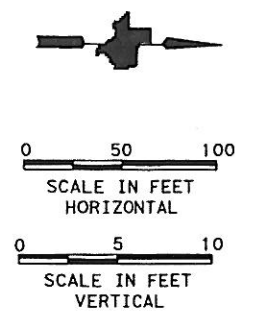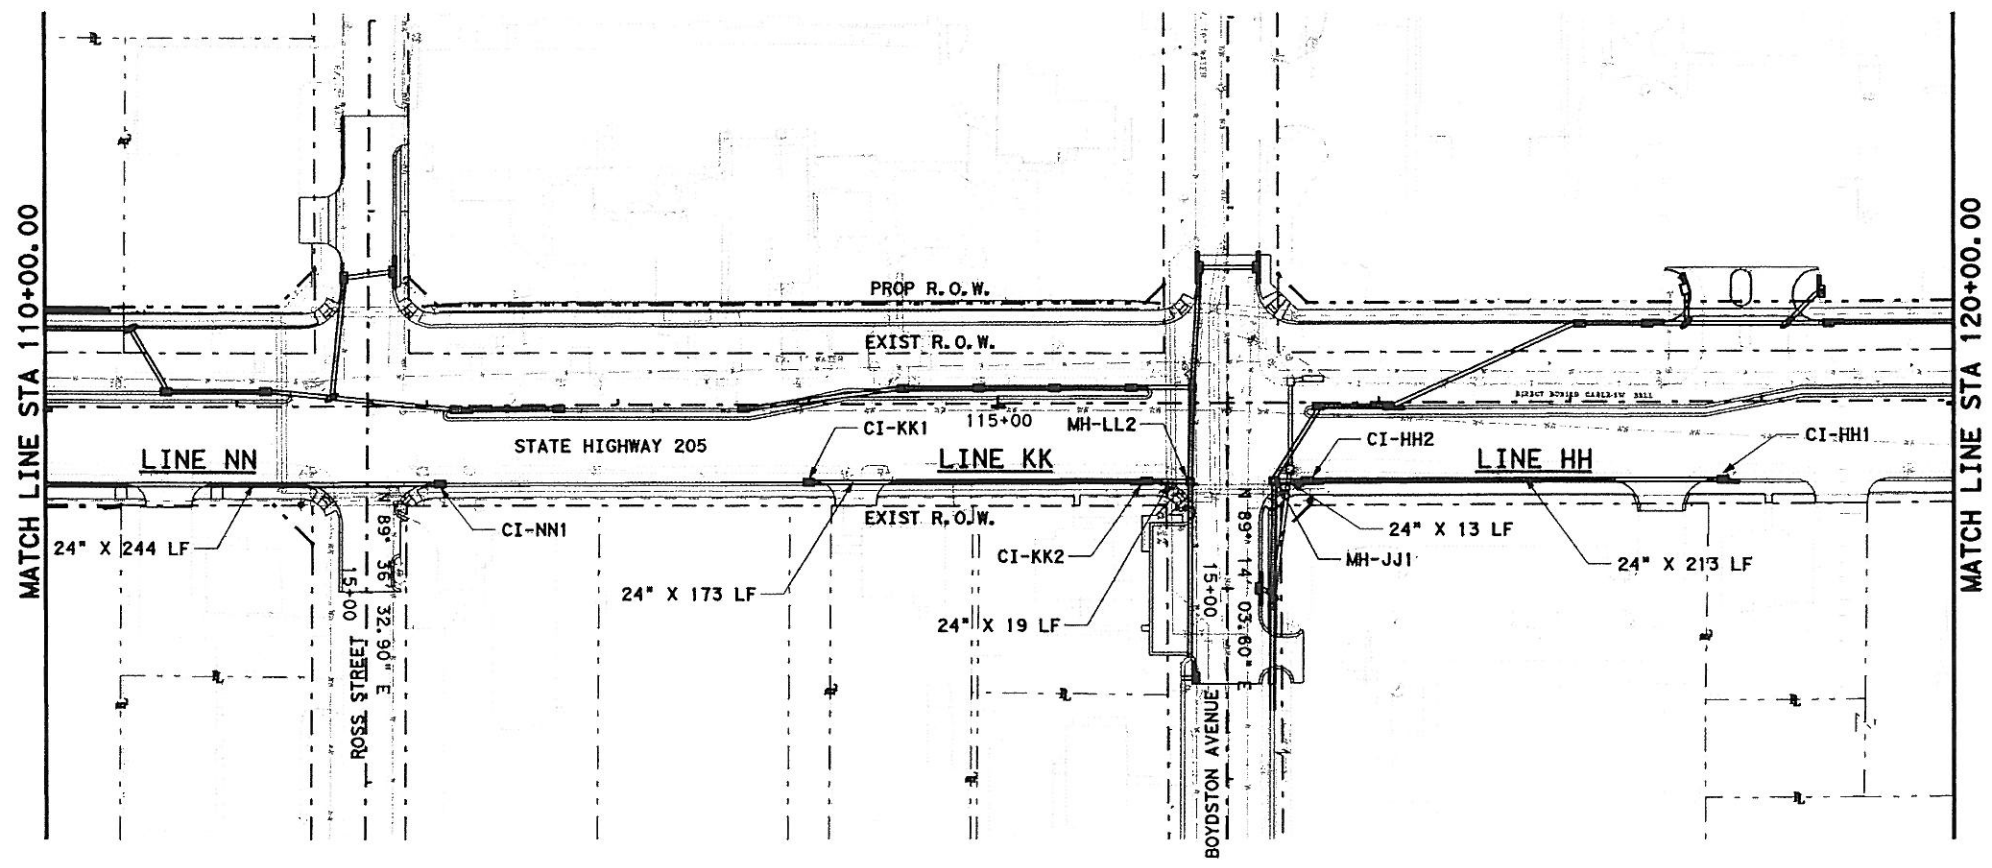

- GENERAL NOTES**
1. CURB INLETS STATION AND OFFSET ARE MEASURED TO THE MIDPOINT OF THE FACE OF MAIN INLET. GRATE INLETS STATION AND OFFSET ARE MEASURED TO THE CENTER OF THE INLET.
 2. JUNCTION BOX STATION AND OFFSET ARE MEASURED TO THE CENTER OF THE JUNCTION BOX.
 3. ALL PIPES ARE CLASS III RCP UNLESS OTHERWISE NOTED.

PLAN
SCALE 1"=100'

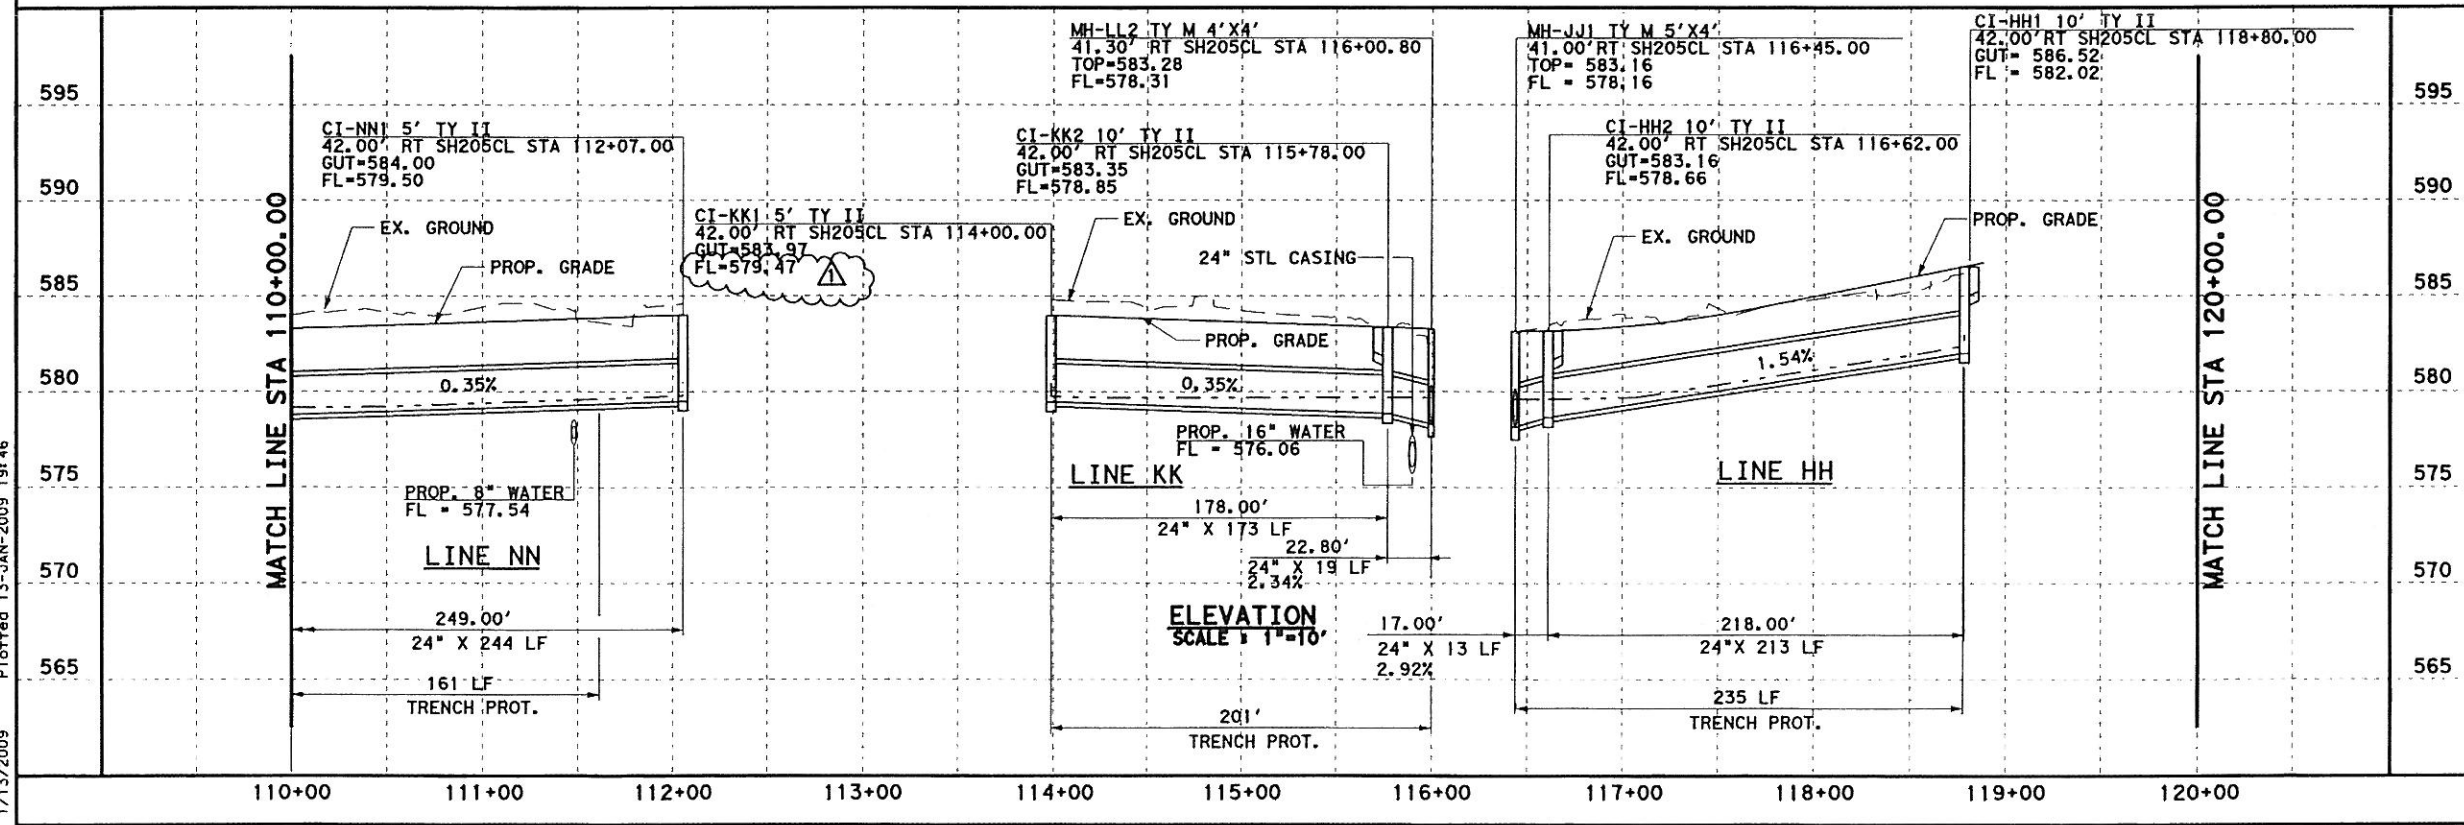



1	09-05-08	REVISED FL ELEV.	AM
---	----------	------------------	----

Parsons Brinckerhoff Quade & Douglas, Inc.
2777 Stemmons Freeway
Suite 1333
128 Dallas, TX 75207

Texas Department of Transportation
© 2008

SH 205			
NORTHBOUND DRAINAGE			
STORM SEWER PLAN & PROFILE			
STA 110+00 TO 120+00			
SHEET 14 OF 57			
FED. DIST. NO.	FEDERAL AID PROJECT NO.	HIGHWAY NO.	
6	(SEE TITLE SHEET)	SH 205	
STATE	DIST.	COUNTY	SHEET NO.
TEXAS	DALLAS	ROCKWALL	414A
CENT.	SECT.	JOB	
0451	01	032, ETC	


DGN:G:\JOBS\22451C-SH205\Drawings\2451cdp012.dgn, ON:10-11, 13-58, 60-62, 1/13/2009

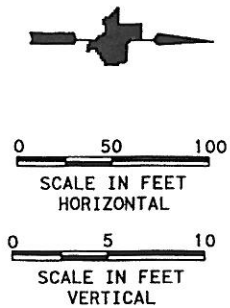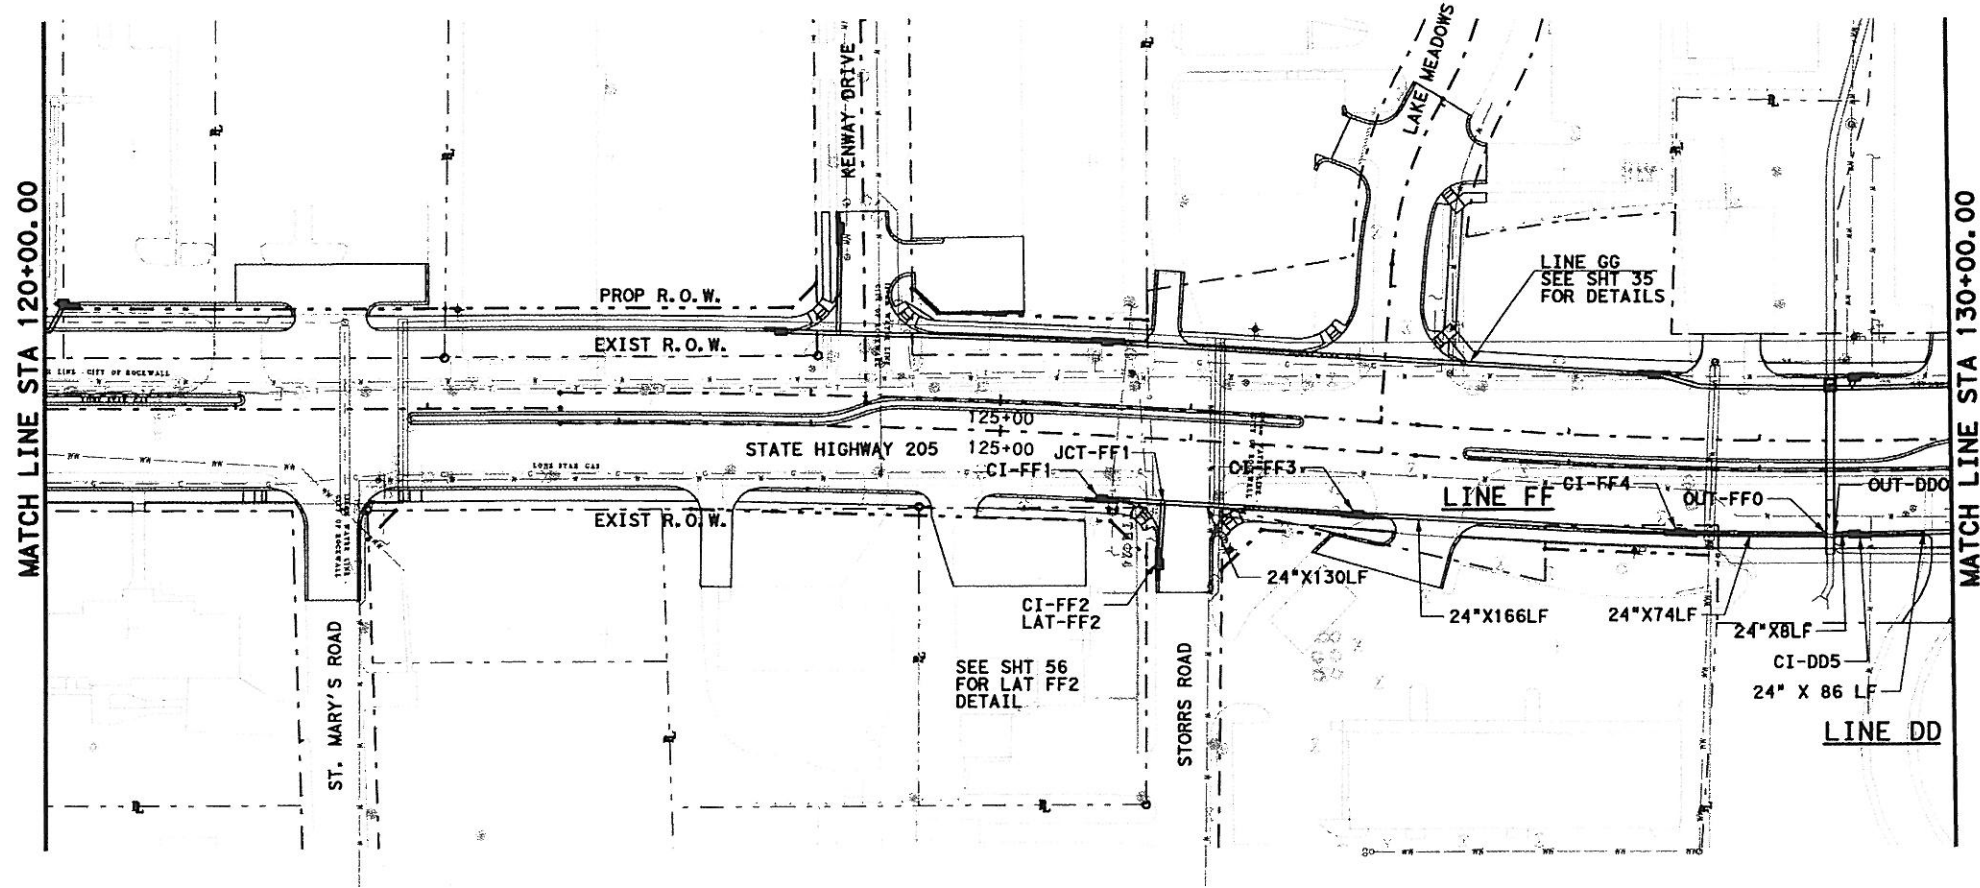


- GENERAL NOTES**
- CURB INLETS STATION AND OFFSET ARE MEASURED TO THE MIDPOINT OF THE FACE OF MAIN INLET. GRATE INLETS STATION AND OFFSET ARE MEASURED TO THE CENTER OF THE INLET.
 - JUNCTION BOX STATION AND OFFSET ARE MEASURED TO THE CENTER OF THE JUNCTION BOX.
 - ALL PIPES ARE CLASS III RCP UNLESS OTHERWISE NOTED.

- LEGENDS**
- (G) EX. GAS LINE CROSSING ELEVATION UNKNOWN
 - (T) EX. SW BELL CABLE CROSSING ELEVATION UNKNOWN

PLAN
SCALE 1"=100'

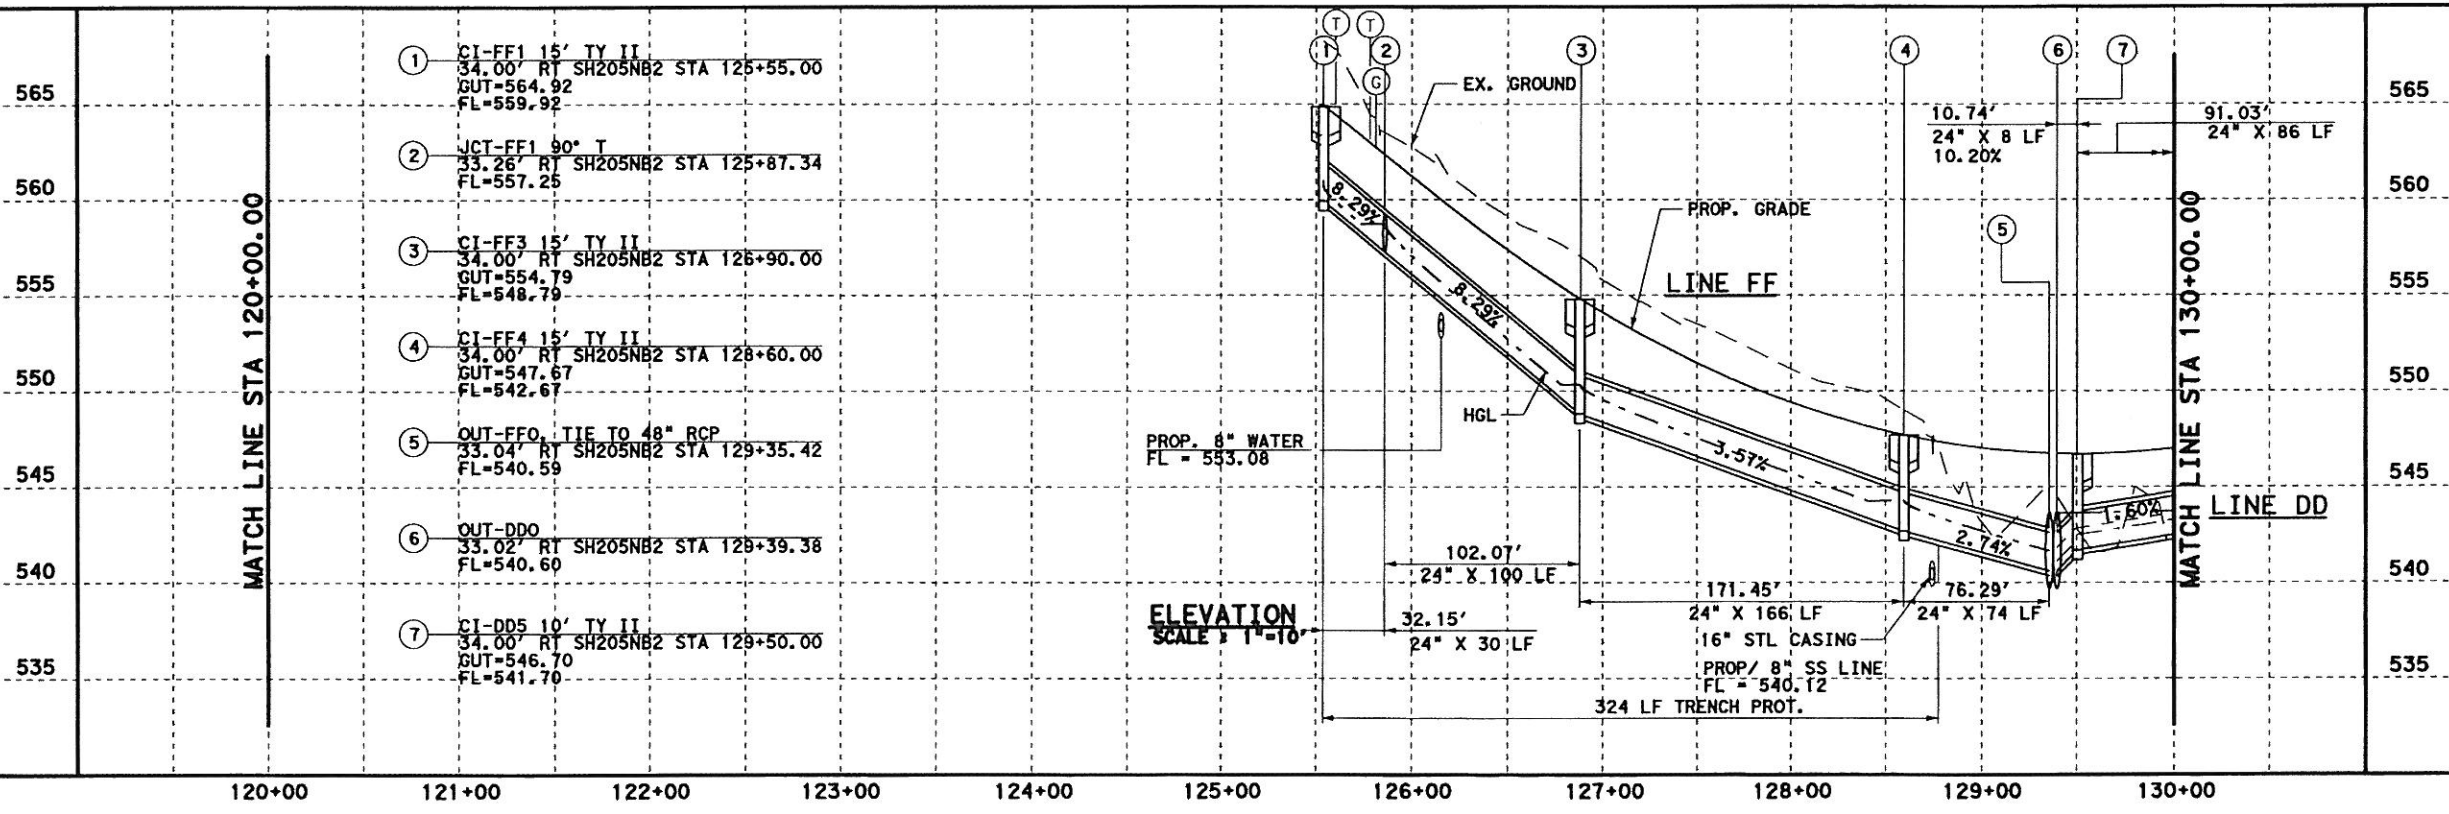

ELEVATION
SCALE 1"=10'

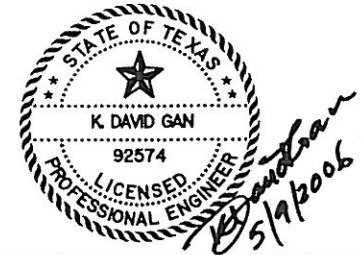



Parsons Brinckerhoff Quade & Douglas, Inc.
2777 Stemmons Freeway
Suite 1333
Dallas, TX 75207

Texas Department of Transportation
© 2006

SH 205
NORTHBOUND DRAINAGE
STORM SEWER PLAN & PROFILE
STA 120+00 TO 130+00
SHEET 15 OF 57

FED. AID PROJECT NO.	HIGHWAY NO.		
6	SH 205		
(SEE TITLE SHEET)			
STATE	DIST.	COUNTY	SHEET NO.
TEXAS	DALLAS	ROCKWALL	415
CONT.	SECT.	JOB	
0451	01	032, ETC	

DGN=C:\JOBS\22451C-SH205.Dra\p00a\2451c.dgn, ON=CO-11, 13-621
 5/9/2006 Plotted 09-MAY-2006 12:57

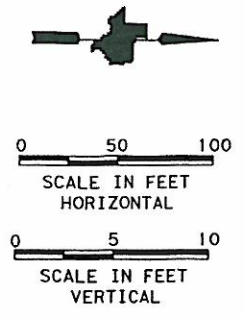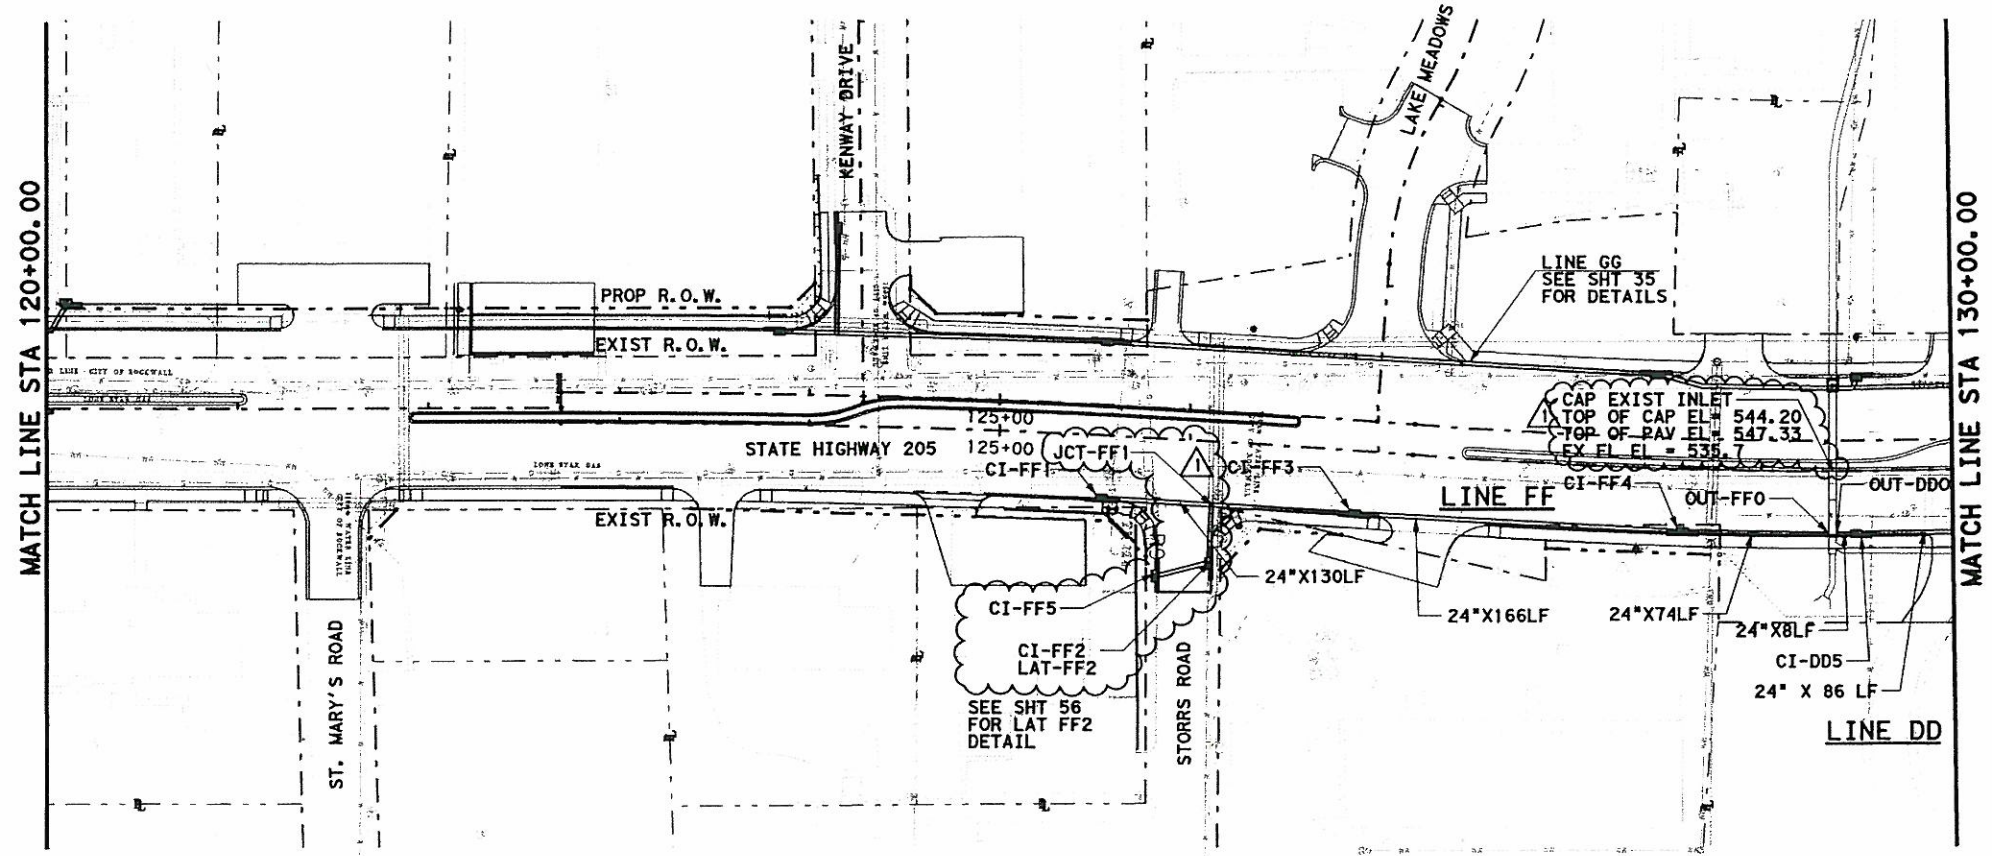


- GENERAL NOTES**
1. CURB INLETS STATION AND OFFSET ARE MEASURED TO THE MIDPOINT OF THE FACE OF MAIN INLET. GRATE INLETS STATION AND OFFSET ARE MEASURED TO THE CENTER OF THE INLET.
 2. JUNCTION BOX STATION AND OFFSET ARE MEASURED TO THE CENTER OF THE JUNCTION BOX.
 3. ALL PIPES ARE CLASS III RCP UNLESS OTHERWISE NOTED.

- LEGENDS**
- (G) EX. GAS LINE CROSSING ELEVATION UNKNOWN
 - (T) EX. SW BELL CABLE CROSSING ELEVATION UNKNOWN



K. David Gan
1/13/2009

PLAN
SCALE 1"=100'

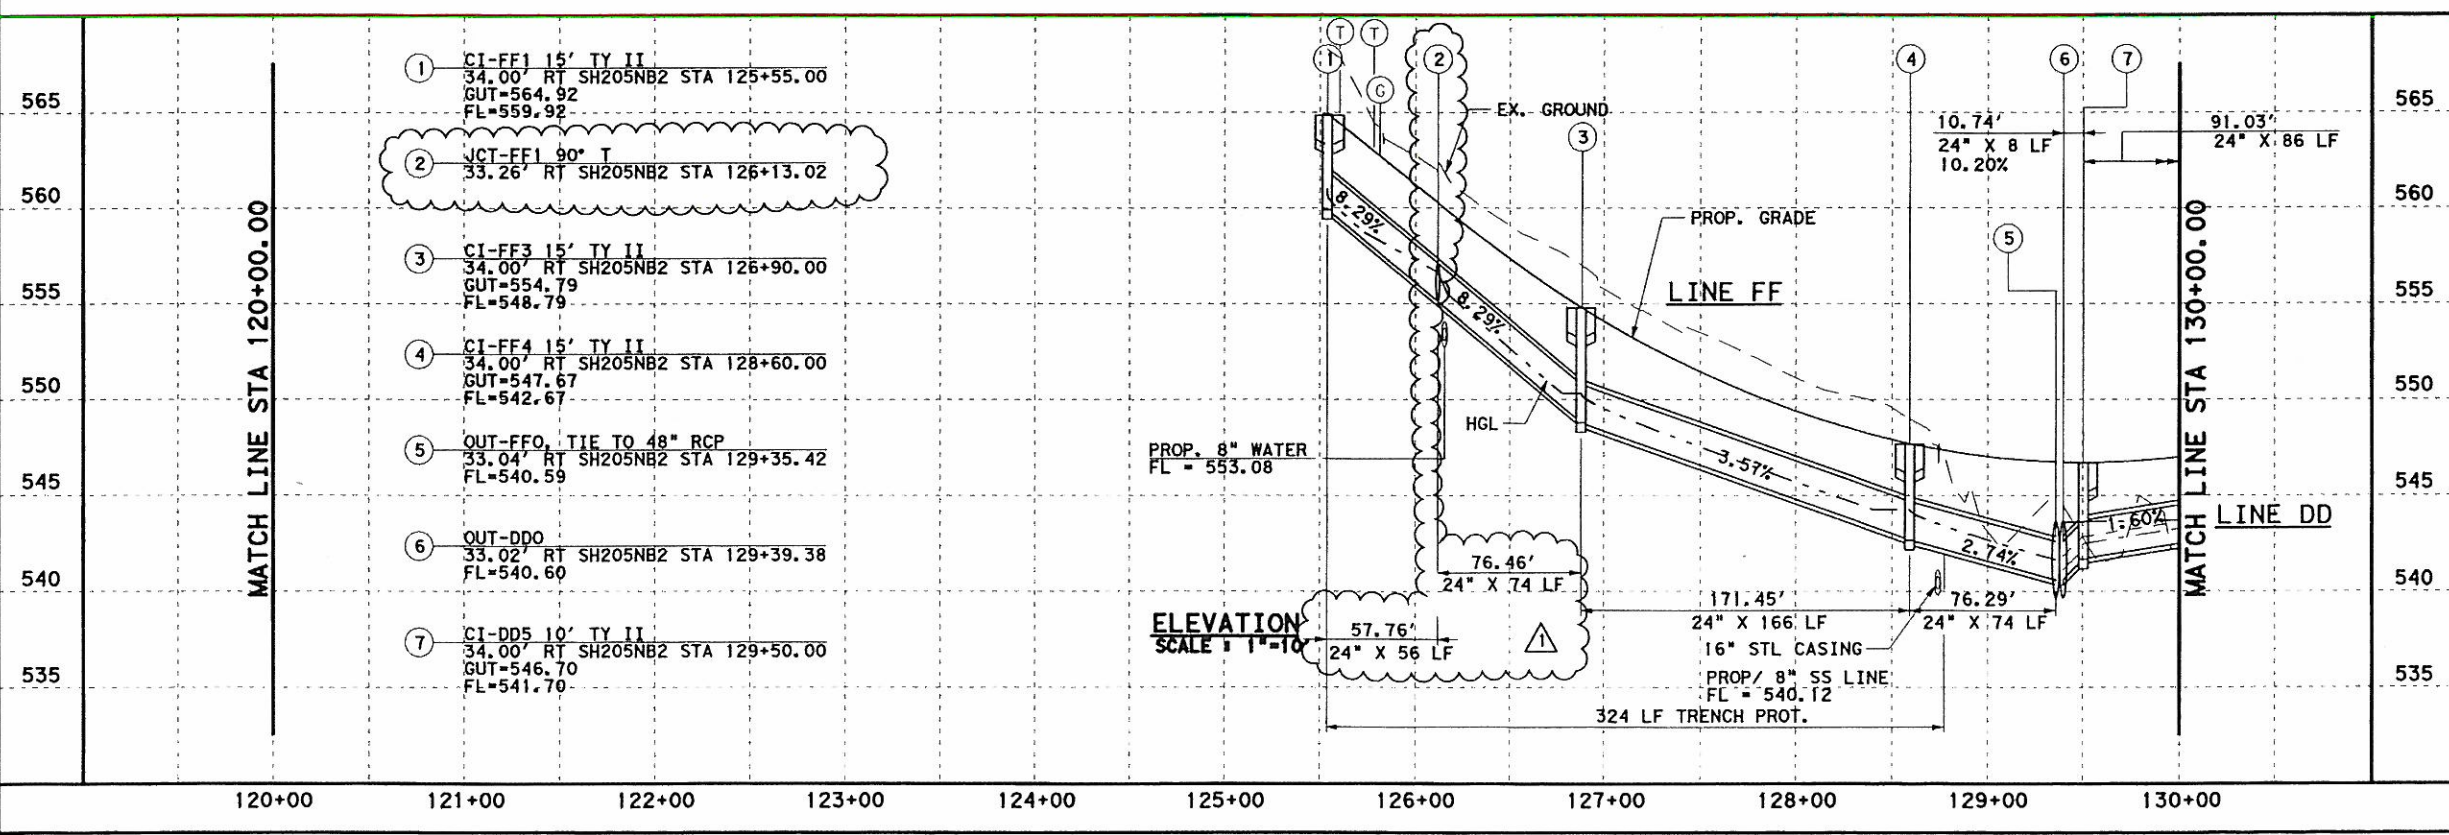

ELEVATION
SCALE 1"=10'



REV CI-FF2& ADDED CI-FF5 10/20/08 -AM
ADDED CAPING EXIST INLET 09/05/08 -KDG

Parsons Brinckerhoff Quade & Douglas, Inc.
2777 Stemmons Freeway
Suite 1333
Dallas, TX 75207

Texas Department of Transportation
© 2008

SH 205			
NORTHBOUND DRAINAGE			
STORM SEWER PLAN & PROFILE			
STA 120+00 TO 130+00			
SHEET 15 OF 57			
FED. RD. DIV. NO.	FEDERAL AID PROJECT NO.	HIGHWAY NO.	
6	(SEE TITLE SHEET)	SH 205	
STATE	DIST.	COUNTY	SHEET NO.
TEXAS	DALLAS	ROCKWALL	415A
CONT.	SECT.	JOB	
0451	01	032, ETC	

DGN:G:\JOBS\22451C-SH205\Drawings\2451.dgn, ON:10-11, 13-623
 1/13/2009 Plotted 13-JAN-2009 19:46

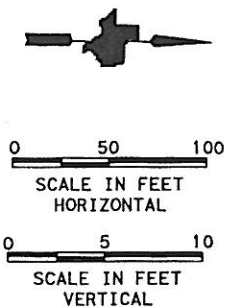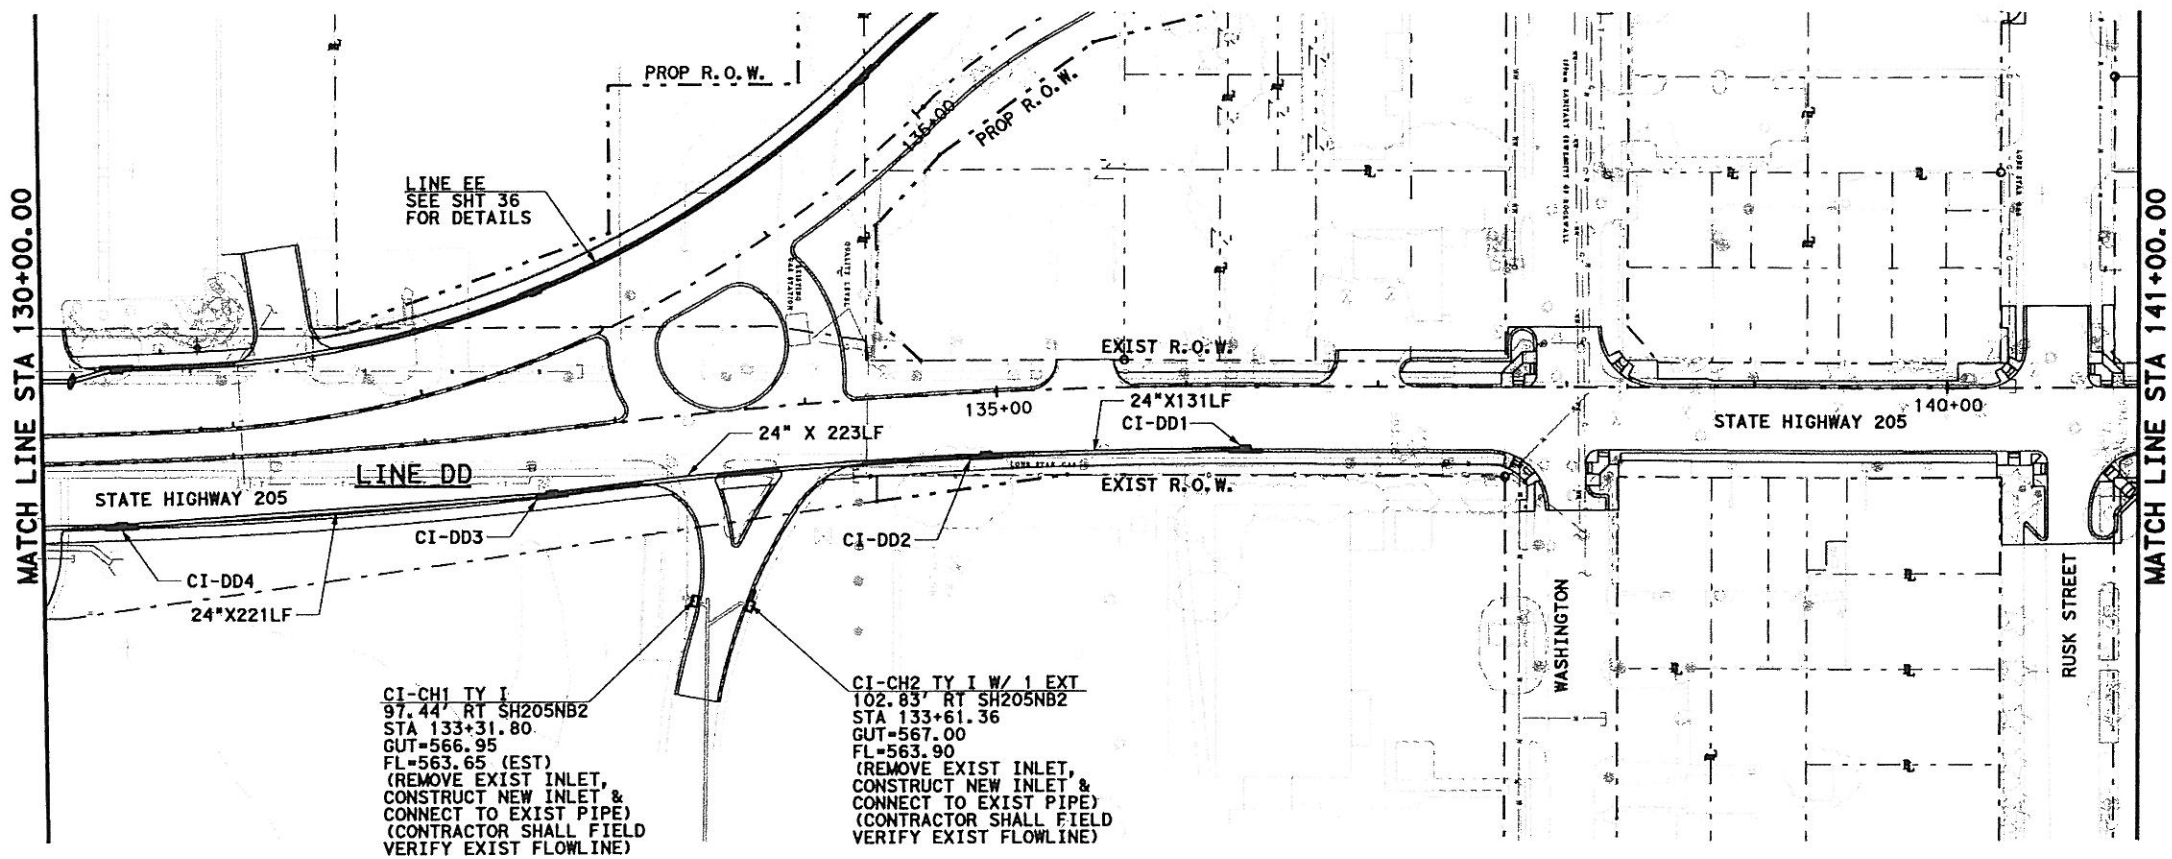


- GENERAL NOTES**
1. CURB INLETS STATION AND OFFSET ARE MEASURED TO THE MIDPOINT OF THE FACE OF MAIN INLET. GRATE INLETS STATION AND OFFSET ARE MEASURED TO THE CENTER OF THE INLET.
 2. JUNCTION BOX STATION AND OFFSET ARE MEASURED TO THE CENTER OF THE JUNCTION BOX.
 3. ALL PIPES ARE CLASS III RCP UNLESS OTHERWISE NOTED.

- LEGENDS**
- (G) EX. GAS LINE CROSSING ELEVATION UNKNOWN
 - (T) EX. SW BELL CABLE CROSSING ELEVATION UNKNOWN

CI-CH1 TY I
 97.44' RT SH205NB2
 STA 133+31.80
 GUT=566.95
 FL=563.65 (EST)
 (REMOVE EXIST INLET,
 CONSTRUCT NEW INLET &
 CONNECT TO EXIST PIPE)
 (CONTRACTOR SHALL FIELD
 VERIFY EXIST FLOWLINE)

CI-CH2 TY I W/ 1 EXT
 102.83' RT SH205NB2
 STA 133+61.36
 GUT=567.00
 FL=563.90
 (REMOVE EXIST INLET,
 CONSTRUCT NEW INLET &
 CONNECT TO EXIST PIPE)
 (CONTRACTOR SHALL FIELD
 VERIFY EXIST FLOWLINE)

PLAN
 SCALE 1"=100'

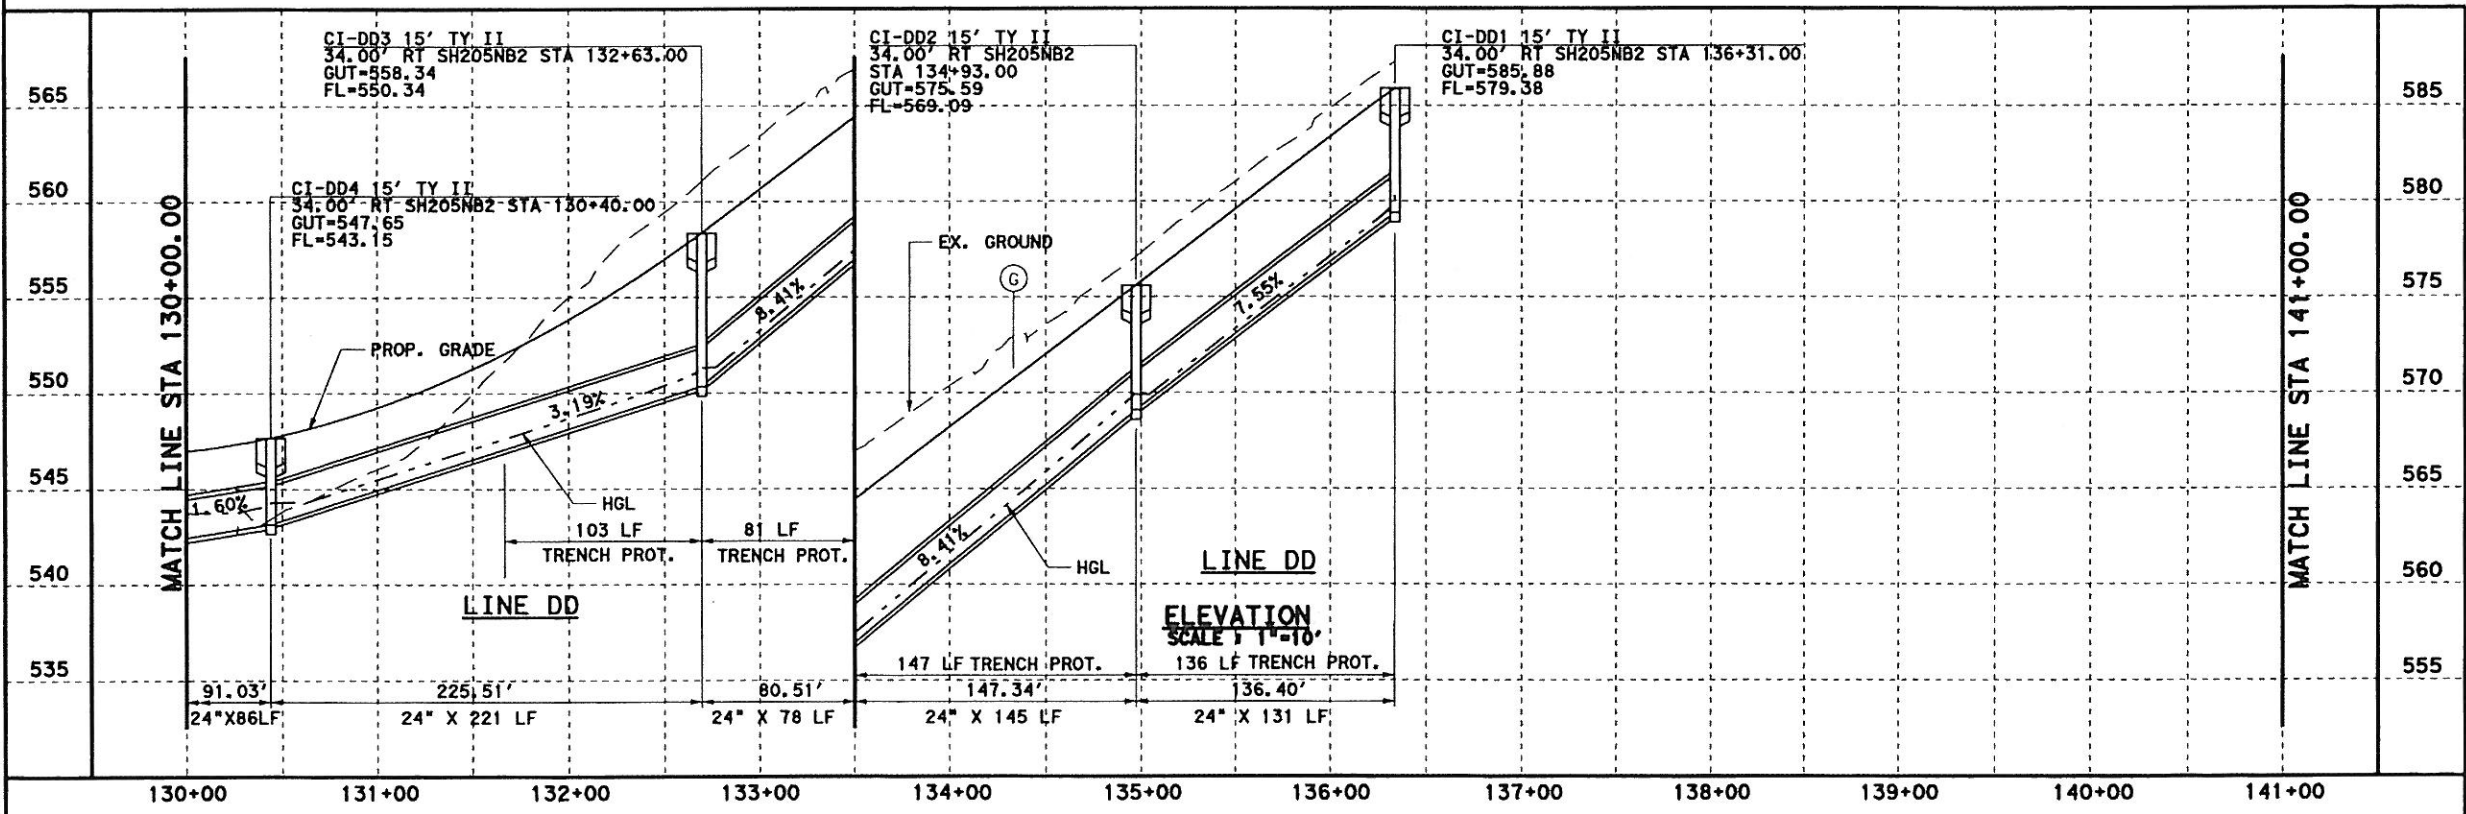

ELEVATION
 SCALE 1"=10'





Parsons Brinckerhoff Quade & Douglas, Inc.
 2777 Stemmons Freeway
 Suite 1333
 Dallas, TX 75207

Texas Department of Transportation
 © 2006

SH 205
 NORTHBOUND DRAINAGE
 NB COUPLET
 STORM SEWER PLAN & PROFILE
 STA 130+00 TO 141+00
 SHEET 16 OF 57

FED. AID DIST. NO.	FEDERAL AID PROJECT NO.	HIGHWAY NO.
6	(SEE TITLE SHEET)	SH 205
STATE	DIST.	COUNTY
TEXAS	DALLAS	ROCKWALL
CONT.	SECT.	JOB
0451	01	032, ETC
		SHEET NO.
		416


D:\CADD\JOBS\22451C-SH205\Drawings\2451\cddn14.dwg, ON:10-11, 13-623
 5/9/2006 Plotted 09-MAY-2006 12:57

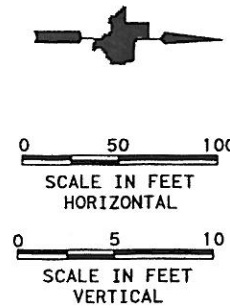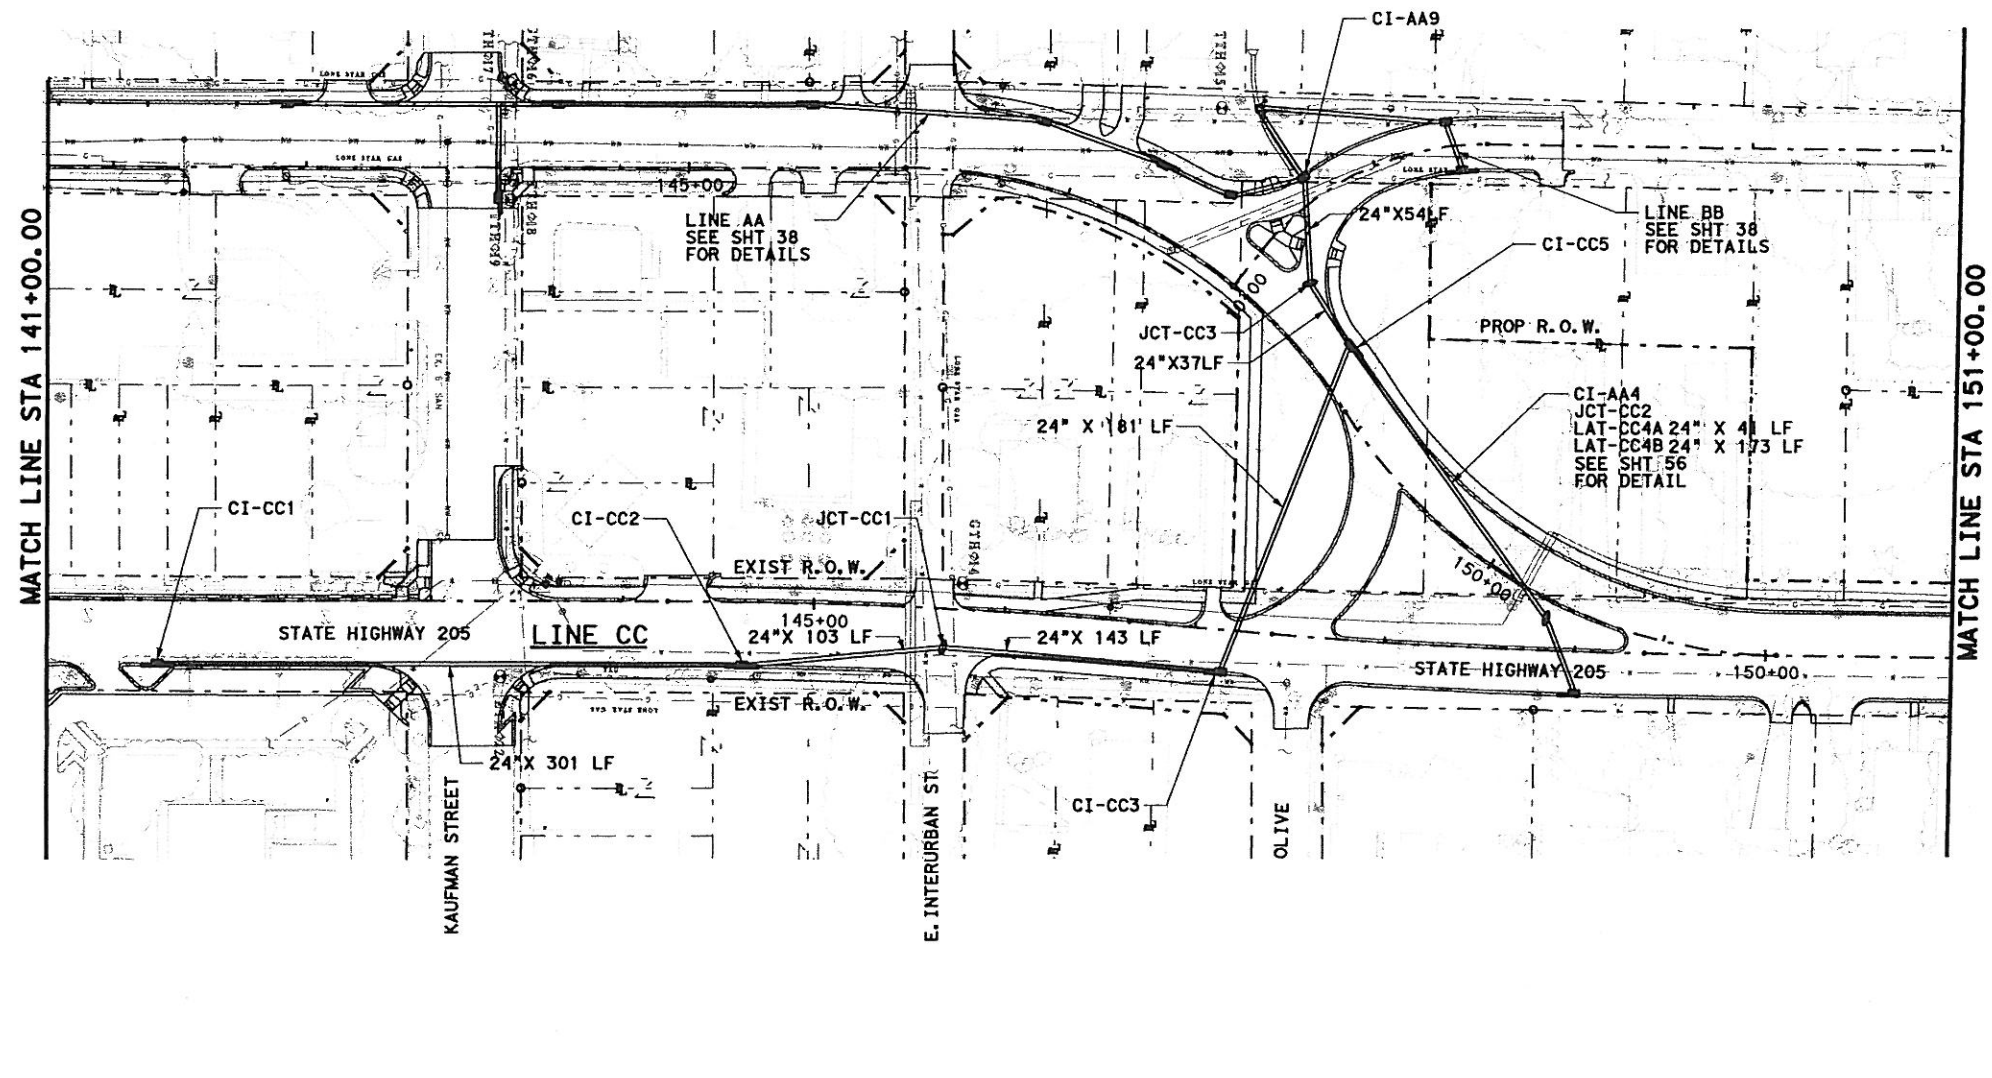


- GENERAL NOTES**
1. CURB INLETS STATION AND OFFSET ARE MEASURED TO THE MIDPOINT OF THE FACE OF MAIN INLET. GRATE INLETS STATION AND OFFSET ARE MEASURED TO THE CENTER OF THE INLET.
 2. JUNCTION BOX STATION AND OFFSET ARE MEASURED TO THE CENTER OF THE JUNCTION BOX.
 3. ALL PIPES ARE CLASS III RCP UNLESS OTHERWISE NOTED.

- LEGENDS**
- (G) EX. GAS LINE CROSSING ELEVATION UNKNOWN
 - (T) EX. SW BELL CABLE CROSSING ELEVATION UNKNOWN

PLAN
SCALE 1"=100'

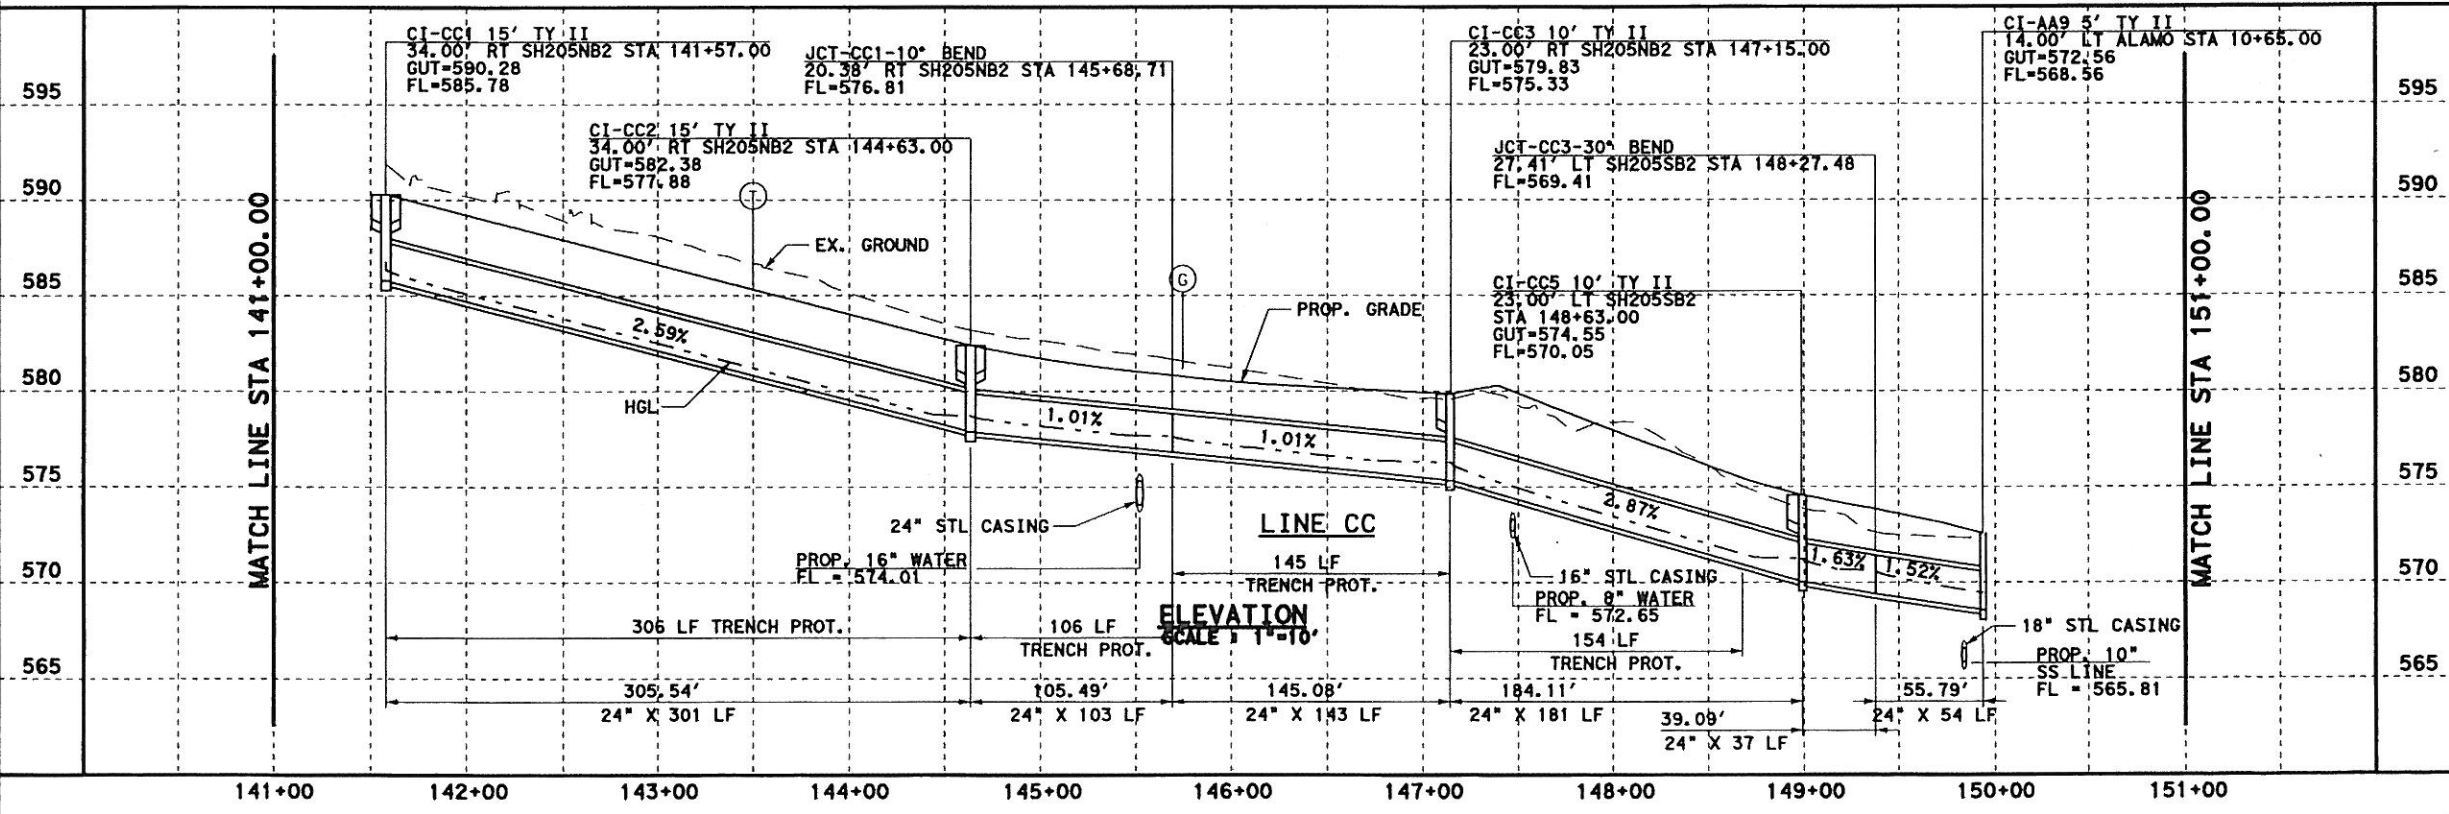

ELEVATION
SCALE 1"=10'

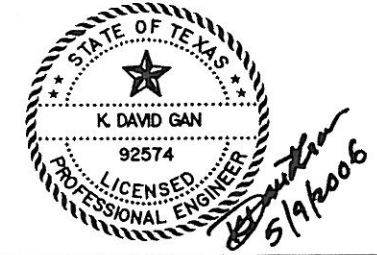



Parsons Brinckerhoff Quade & Douglas, Inc.
2777 Stemmons Freeway
Suite 1333
Dallas, TX 75207

Texas Department of Transportation
© 2006

SH 205
NORTHBOUND DRAINAGE
NB COUPLET
STORM SEWER PLAN & PROFILE
STA 141+00 TO 151+00
SHEET 17 OF 57

FED. DIST. NO.	FEDERAL AID PROJECT NO.	HIGHWAY NO.
6	(SEE TITLE SHEET)	SH 205
STATE	DIST.	COUNTY
TEXAS	DALLAS	ROCKWALL
CONT.	SECT.	JOB
0451	01	032, ETC
		SHEET NO.
		417

DGN=G:\JOBS\22451C-SH205\Drawings\2451\cdp\15.dgn, ON=[0-11, 13-62]
 5/9/2006 Plotted 09-MAY-2006 12:57

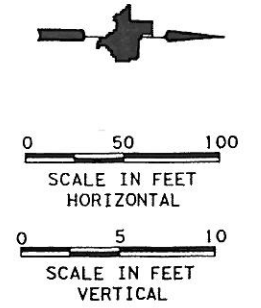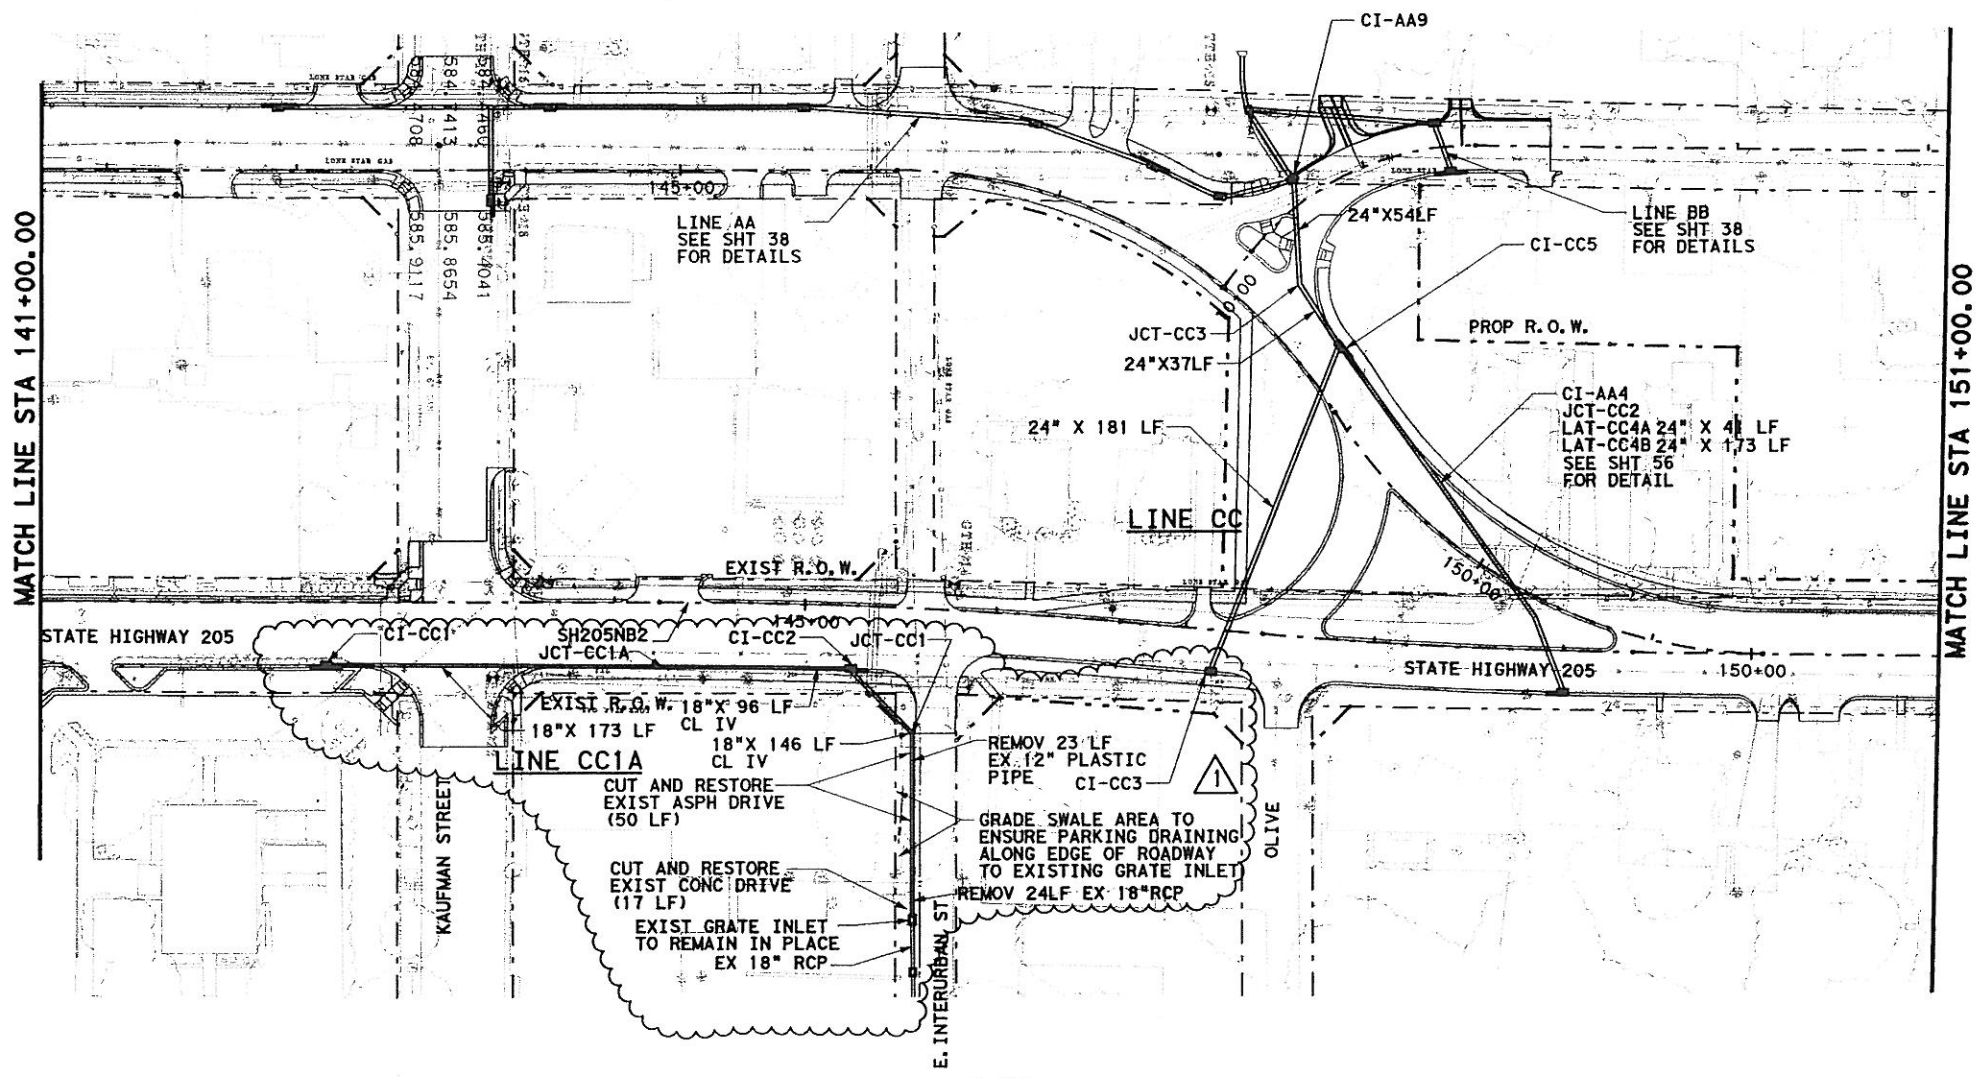

- GENERAL NOTES**
1. CURB INLETS STATION AND OFFSET ARE MEASURED TO THE MIDPOINT OF THE FACE OF MAIN INLET. GRATE INLETS STATION AND OFFSET ARE MEASURED TO THE CENTER OF THE INLET.
 2. JUNCTION BOX STATION AND OFFSET ARE MEASURED TO THE CENTER OF THE JUNCTION BOX.
 3. ALL PIPES ARE CLASS III RCP UNLESS OTHERWISE NOTED.

- LEGENDS**
- G EX. GAS LINE CROSSING ELEVATION UNKNOWN
 - T EX. SW BELL CABLE CROSSING ELEVATION UNKNOWN



K. David Gan 5/4/2009

Change Order #84

Revised Line CC - DG - 4/6/2009


PB Parsons Brinckerhoff Quade & Douglas, Inc.
2777 Stemmons Freeway
Suite 1333
Dallas, TX 75207
TBPE ID 2263

Texas Department of Transportation
© 2008

SH 205
NORTHBOUND DRAINAGE
NB COUPLER
STORM SEWER PLAN & PROFILE
STA 141+00 TO 151+00
SHEET 17 OF 57




FED. RD. DIV. NO.	FEDERAL AID PROJECT NO.	HIGHWAY NO.
6	(SEE TITLE SHEET)	SH 205
STATE	DIST.	COUNTY
TEXAS	DALLAS	ROCKWALL
CONT.	SECT.	JOB
0451	01	032, ETC
		SHEET NO.
		417A

PLAN
SCALE 1" = 100'

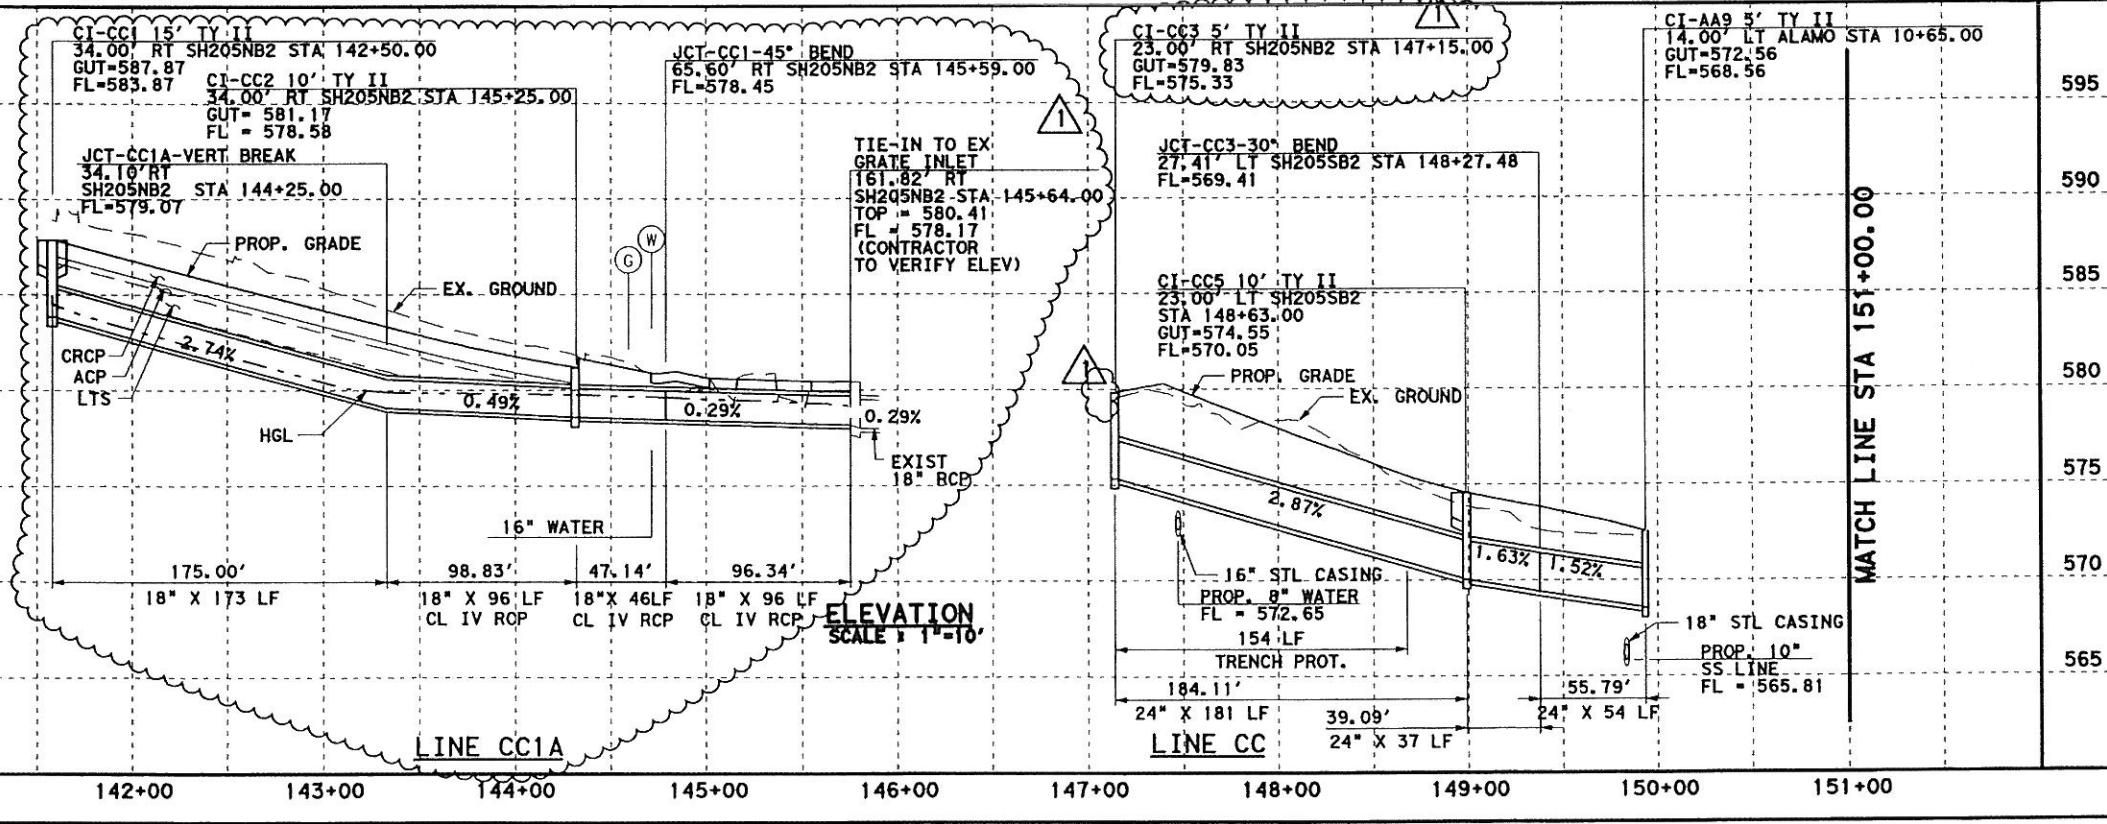

ELEVATION
SCALE 1" = 10'


DON-G:\JOBS\22451C-SH205-NB-drainage\2451.dgn, 04-10-11, 13-622
 Plotted 04-MAY-2009 17:39

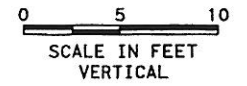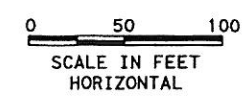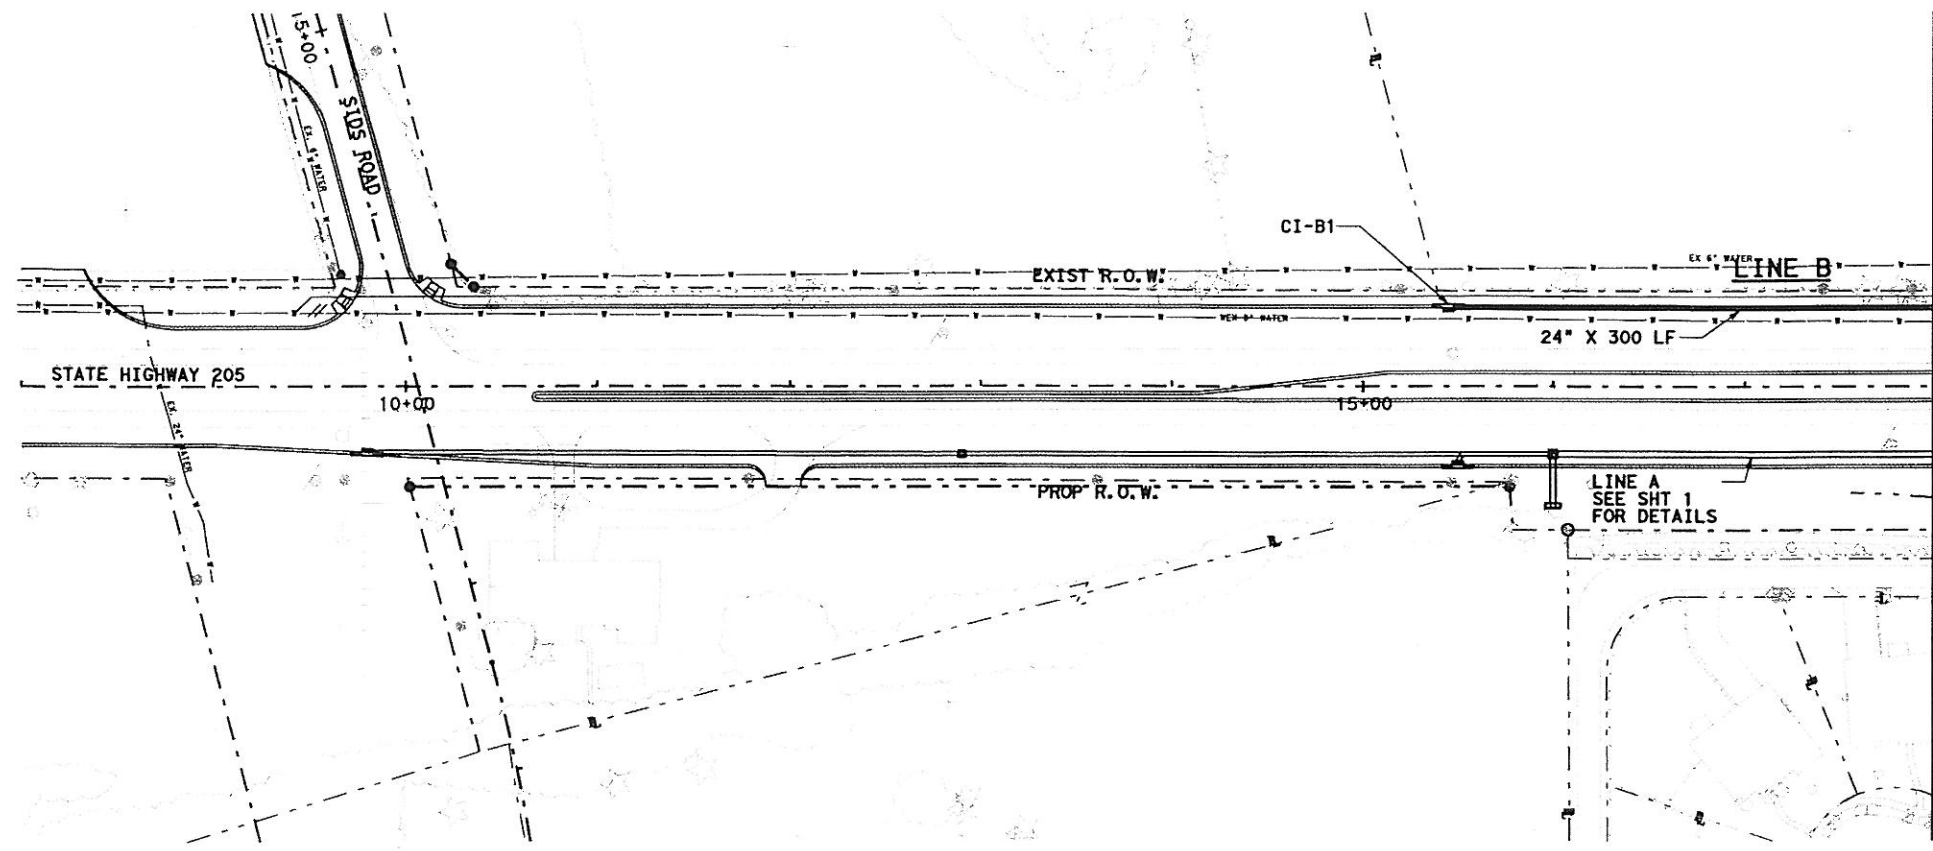


GENERAL NOTES

1. CURB INLETS STATION AND OFFSET ARE MEASURED TO THE MIDPOINT OF THE FACE OF MAIN INLET. GRATE INLETS STATION AND OFFSET ARE MEASURED TO THE CENTER OF THE INLET.
2. JUNCTION BOX STATION AND OFFSET ARE MEASURED TO THE CENTER OF THE JUNCTION BOX.
3. ALL PIPES ARE CLASS III RCP UNLESS OTHERWISE NOTED.

PLAN
SCALE 1"=100'

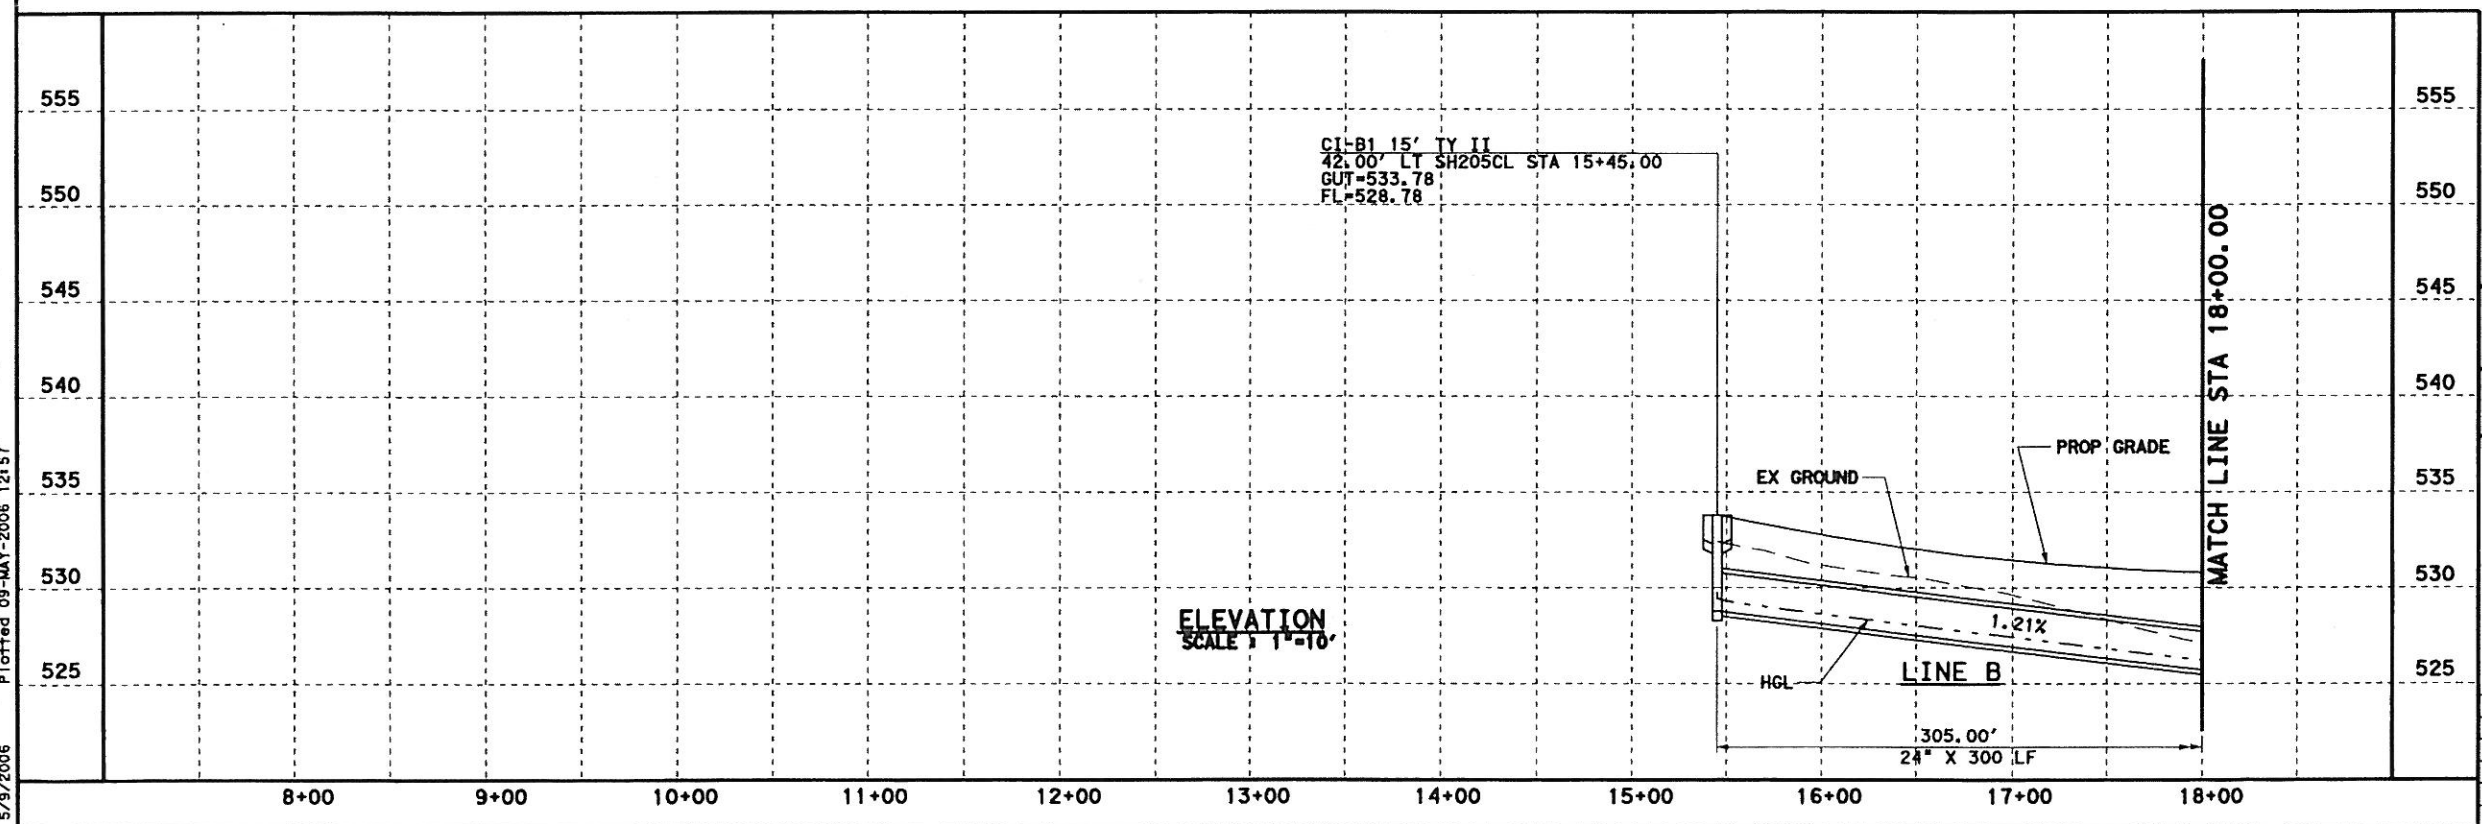

ELEVATION
SCALE 1"=10'

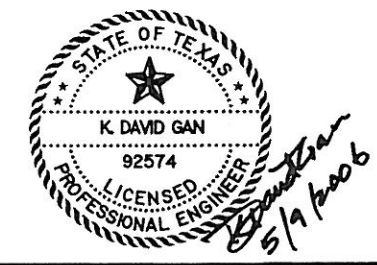



PR Parsons Brinckerhoff Quade & Douglas, Inc.
2777 Stemmons Freeway
Suite 1333
Dallas, TX 75207

T Texas Department of Transportation
© 2006

SH 205
SOUTHBOUND DRAINAGE
STORM SEWER PLAN & PROFILE
STA 8+00 TO 18+00
SHEET 18 OF 57



FEDERAL AID PROJECT NO.		HIGHWAY NO.	
6 (SEE TITLE SHEET)		SH 205	
STATE	DIST.	COUNTY	SHEET NO.
TEXAS	DALLAS	ROCKWALL	418
CONT.	SECT.	JOB	
0451	01	032, ETC	

D:\G:\JOBS\22451C-SH205\Drawings\2451cdps02.dgn, DN+CO-11, 13-623
 5/9/2006 P:\cadd\09-MAY-2006 12:57

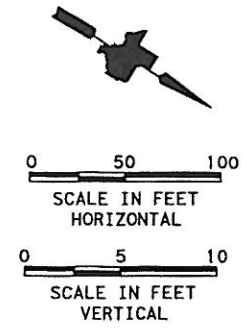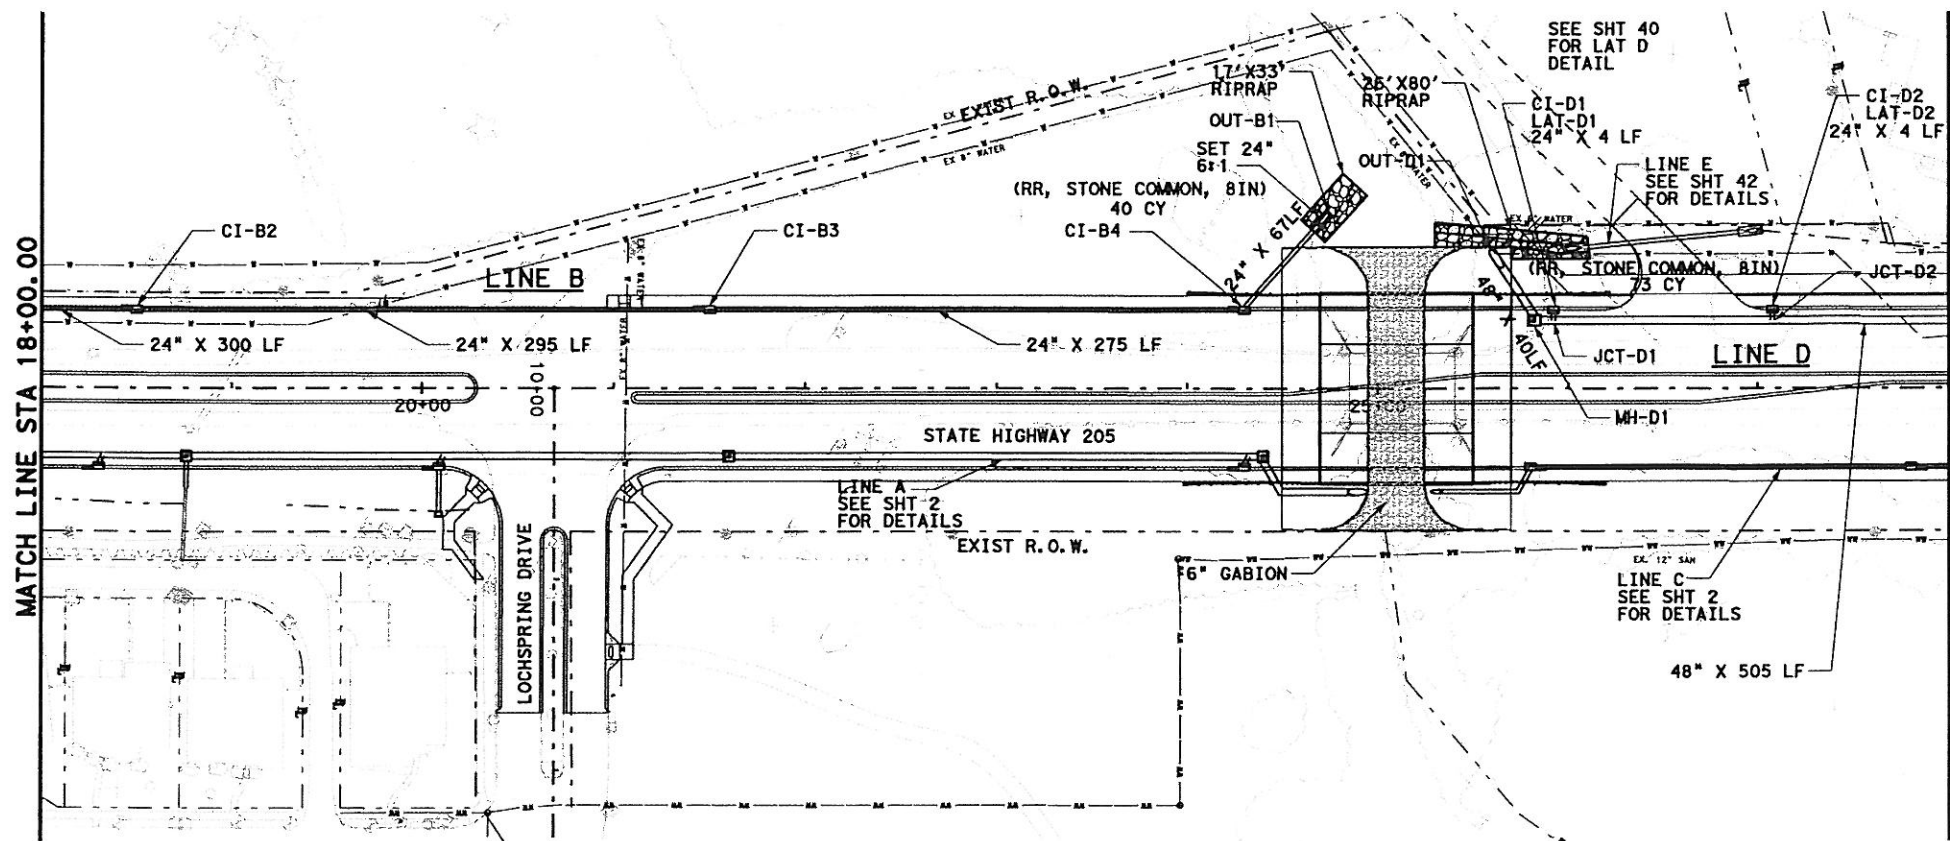

- GENERAL NOTES**
1. CURB INLETS STATION AND OFFSET ARE MEASURED TO THE MIDPOINT OF THE FACE OF MAIN INLET. GRATE INLETS STATION AND OFFSET ARE MEASURED TO THE CENTER OF THE INLET.
 2. JUNCTION BOX STATION AND OFFSET ARE MEASURED TO THE CENTER OF THE JUNCTION BOX.
 3. ALL PIPES ARE CLASS III RCP UNLESS OTHERWISE NOTED.

PLAN
SCALE 1" = 100'

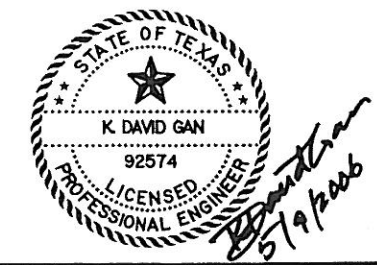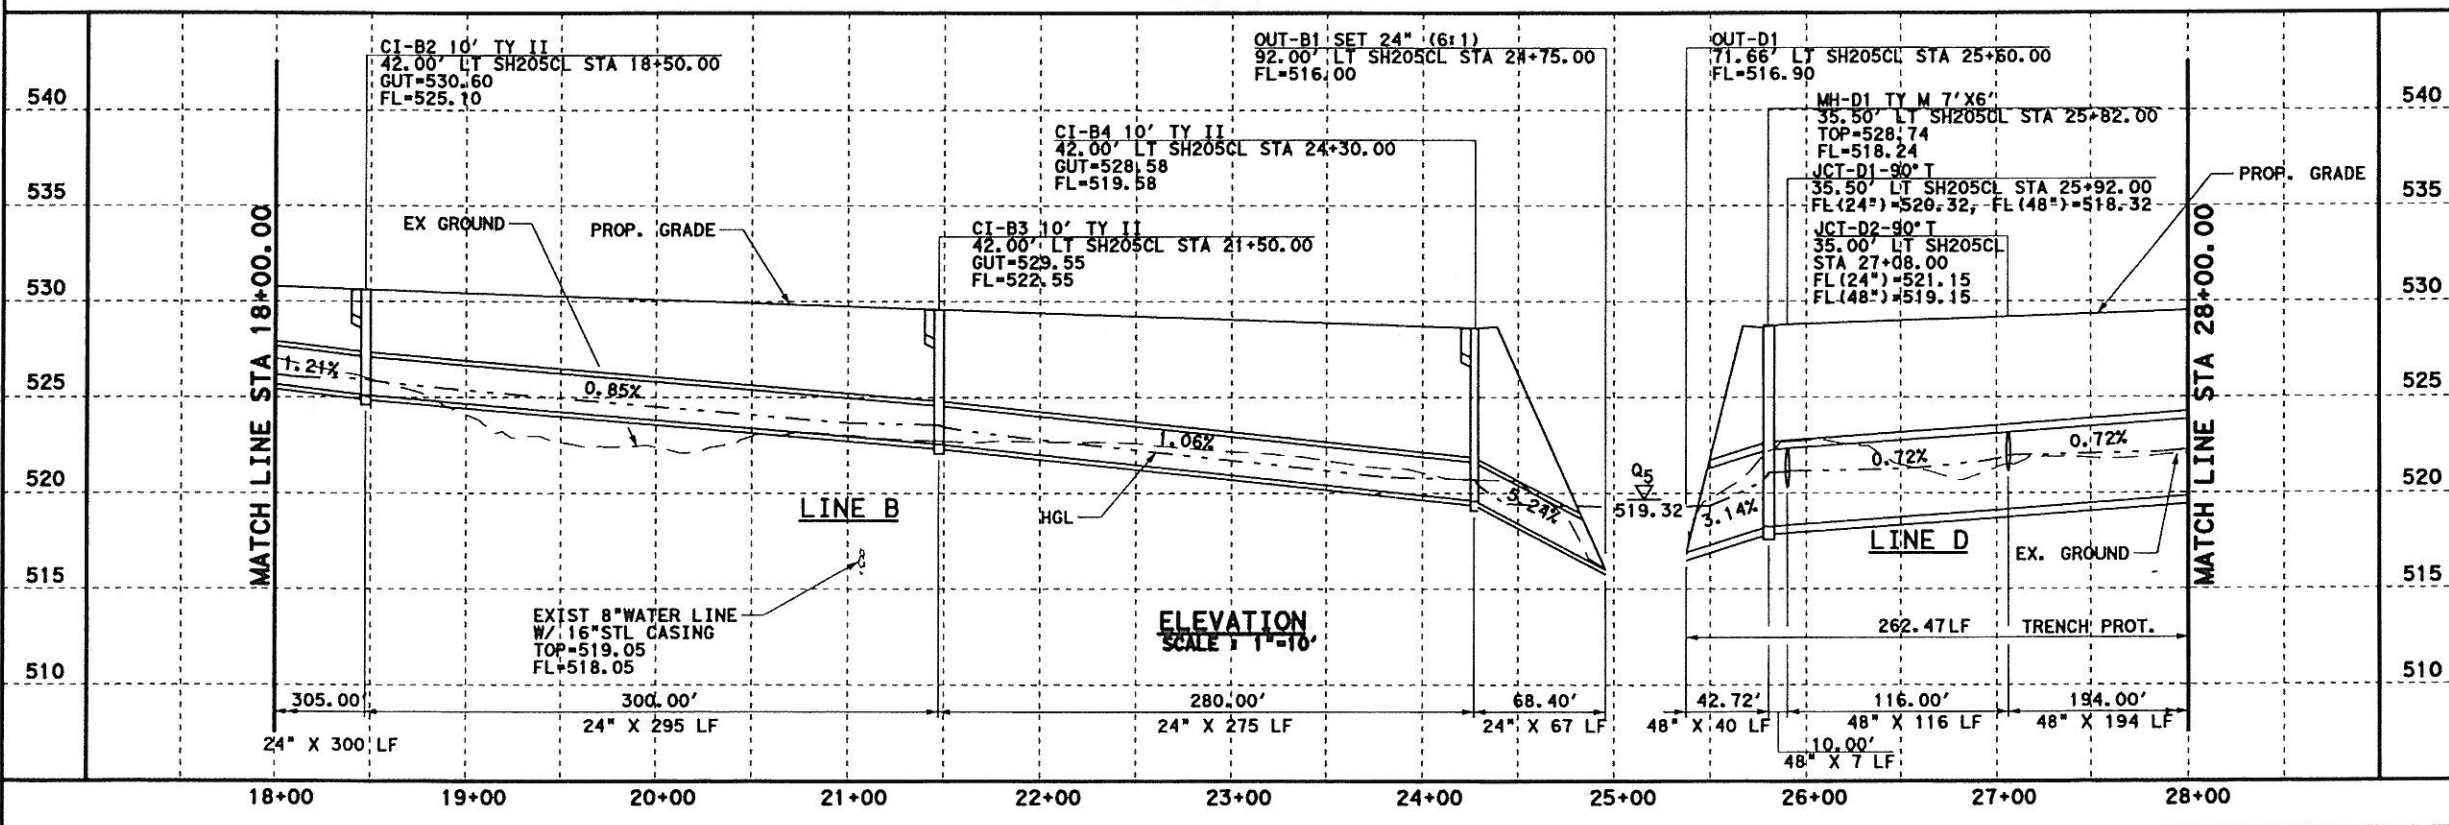



Parsons Brinckerhoff Quade & Douglas, Inc.
2777 Stemmons Freeway
Suite 1333
Dallas, TX 75207

Texas Department of Transportation
© 2006

SH 205
SOUTHBOUND DRAINAGE
STORM SEWER PLAN & PROFILE
STA 18+00 TO 28+00
SHEET 19 OF 57

FED. PROJ. NO.	FEDERAL AID PROJECT NO.	HIGHWAY NO.
6	(SEE TITLE SHEET)	SH 205
STATE	DIST.	COUNTY
TEXAS	DALLAS	ROCKWALL
COUNT.	SECT.	JOB
0451	01	032, ETC
SHEET NO.		419

DGN=G:\JOBS\22451C-SH205\Drawings\2451cads03.dgn, ON=10-11, 13-623
 5/9/2006 Plotted 09-MAY-2006 12:57

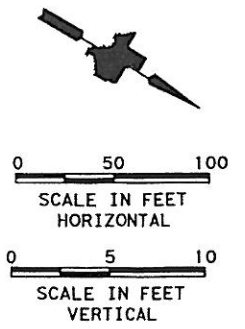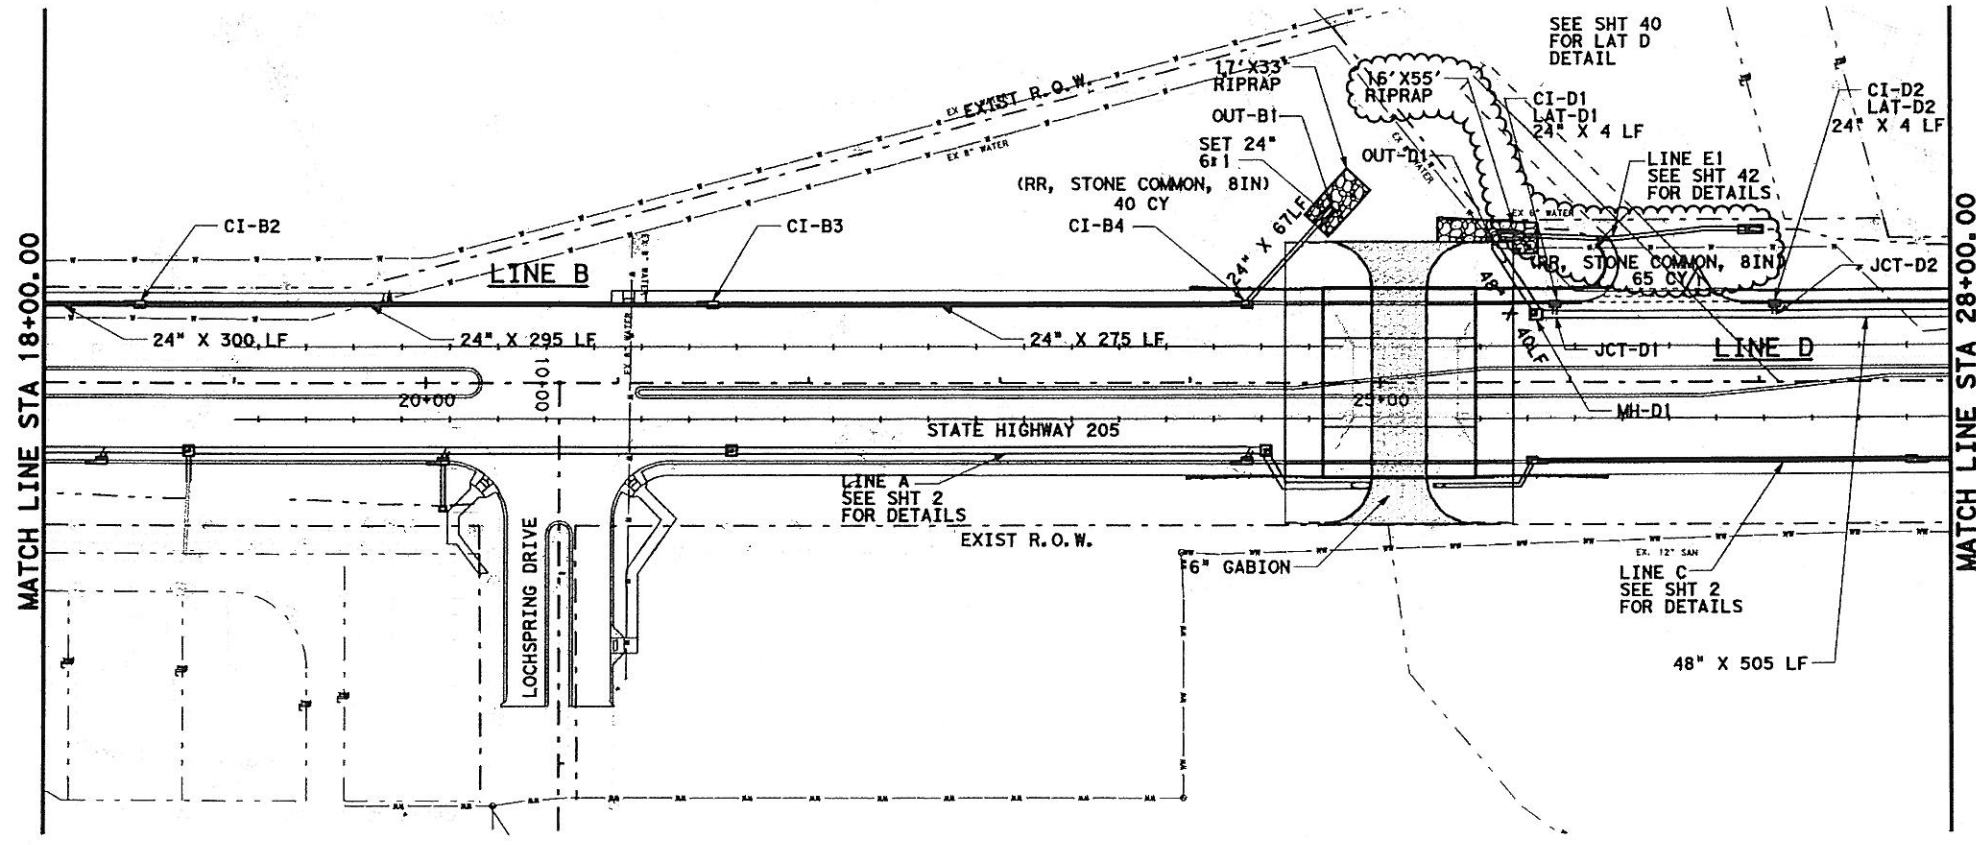

- GENERAL NOTES**
1. CURB INLETS STATION AND OFFSET ARE MEASURED TO THE MIDPOINT OF THE FACE OF MAIN INLET. GRATE INLETS STATION AND OFFSET ARE MEASURED TO THE CENTER OF THE INLET.
 2. JUNCTION BOX STATION AND OFFSET ARE MEASURED TO THE CENTER OF THE JUNCTION BOX.
 3. ALL PIPES ARE CLASS III RCP UNLESS OTHERWISE NOTED.

PLAN
SCALE 1"=100'



Handwritten signature and date: 7/28/08

Change Order #48


REVISD LINE E1 BY DG - 01/03/2008

Parsons Brinckerhoff Quade & Douglas, Inc.
2777 Stemmons Freeway
Suite 1333
Dallas, TX 75207

Texas Department of Transportation
© 2008



SH 205
SOUTHBOUND DRAINAGE
STORM SEWER PLAN & PROFILE
STA 18+00 TO 28+00
SHEET 19 OF 57

FED. RD. DIV. NO.	FEDERAL AID PROJECT NO.	HIGHWAY NO.
6	(SEE TITLE SHEET)	SH 205
STATE	DIST.	COUNTY
TEXAS	DALLAS	ROCKWALL
CONT.	SECT.	JOB
0451	01	032, ETC
		SHEET NO.
		419A

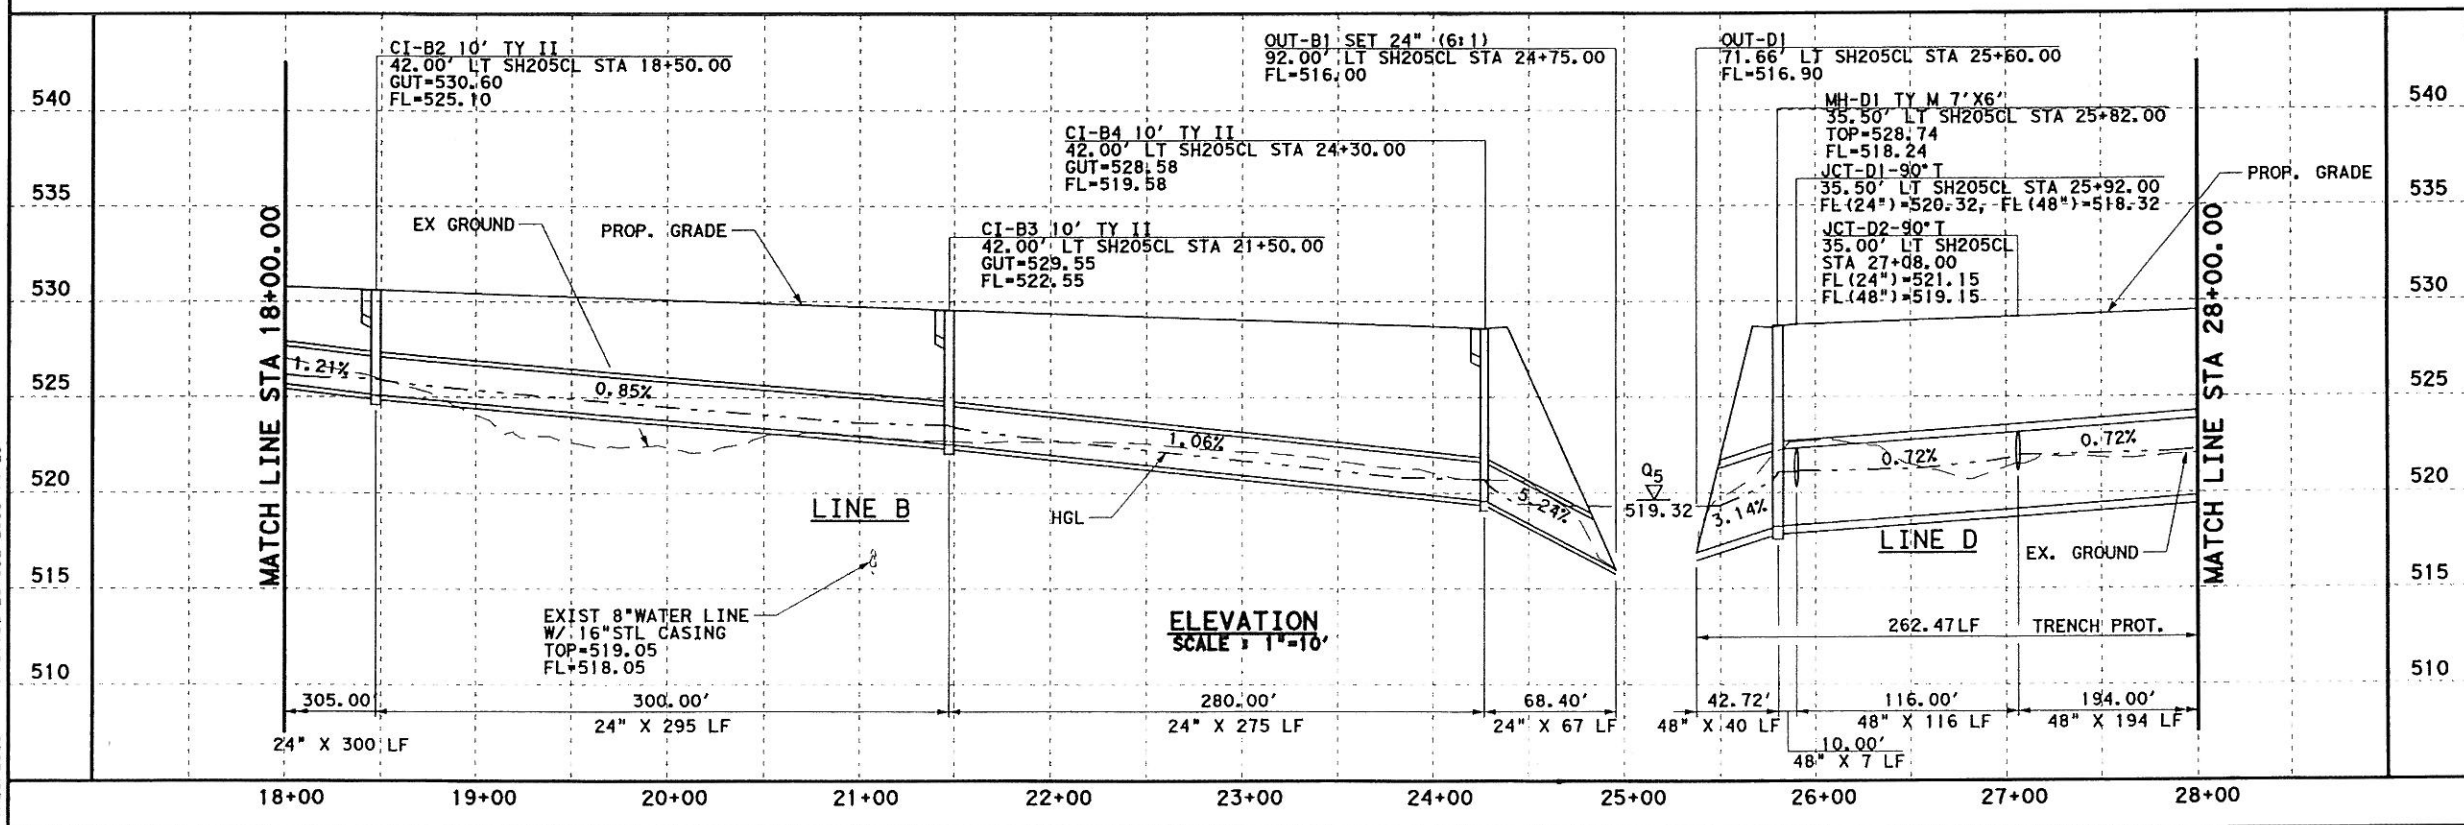



ELEVATION
SCALE 1"=10'

DGN: \\JOBS\22451C-SH205\Drawings\2451\odps03.dgn, ON-[0-11, 13-62]
 7/28/2008 Plotted 28-JUL-2008 14:23

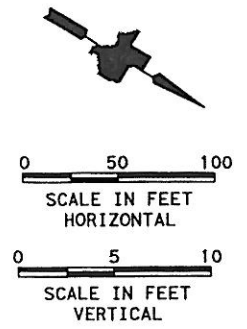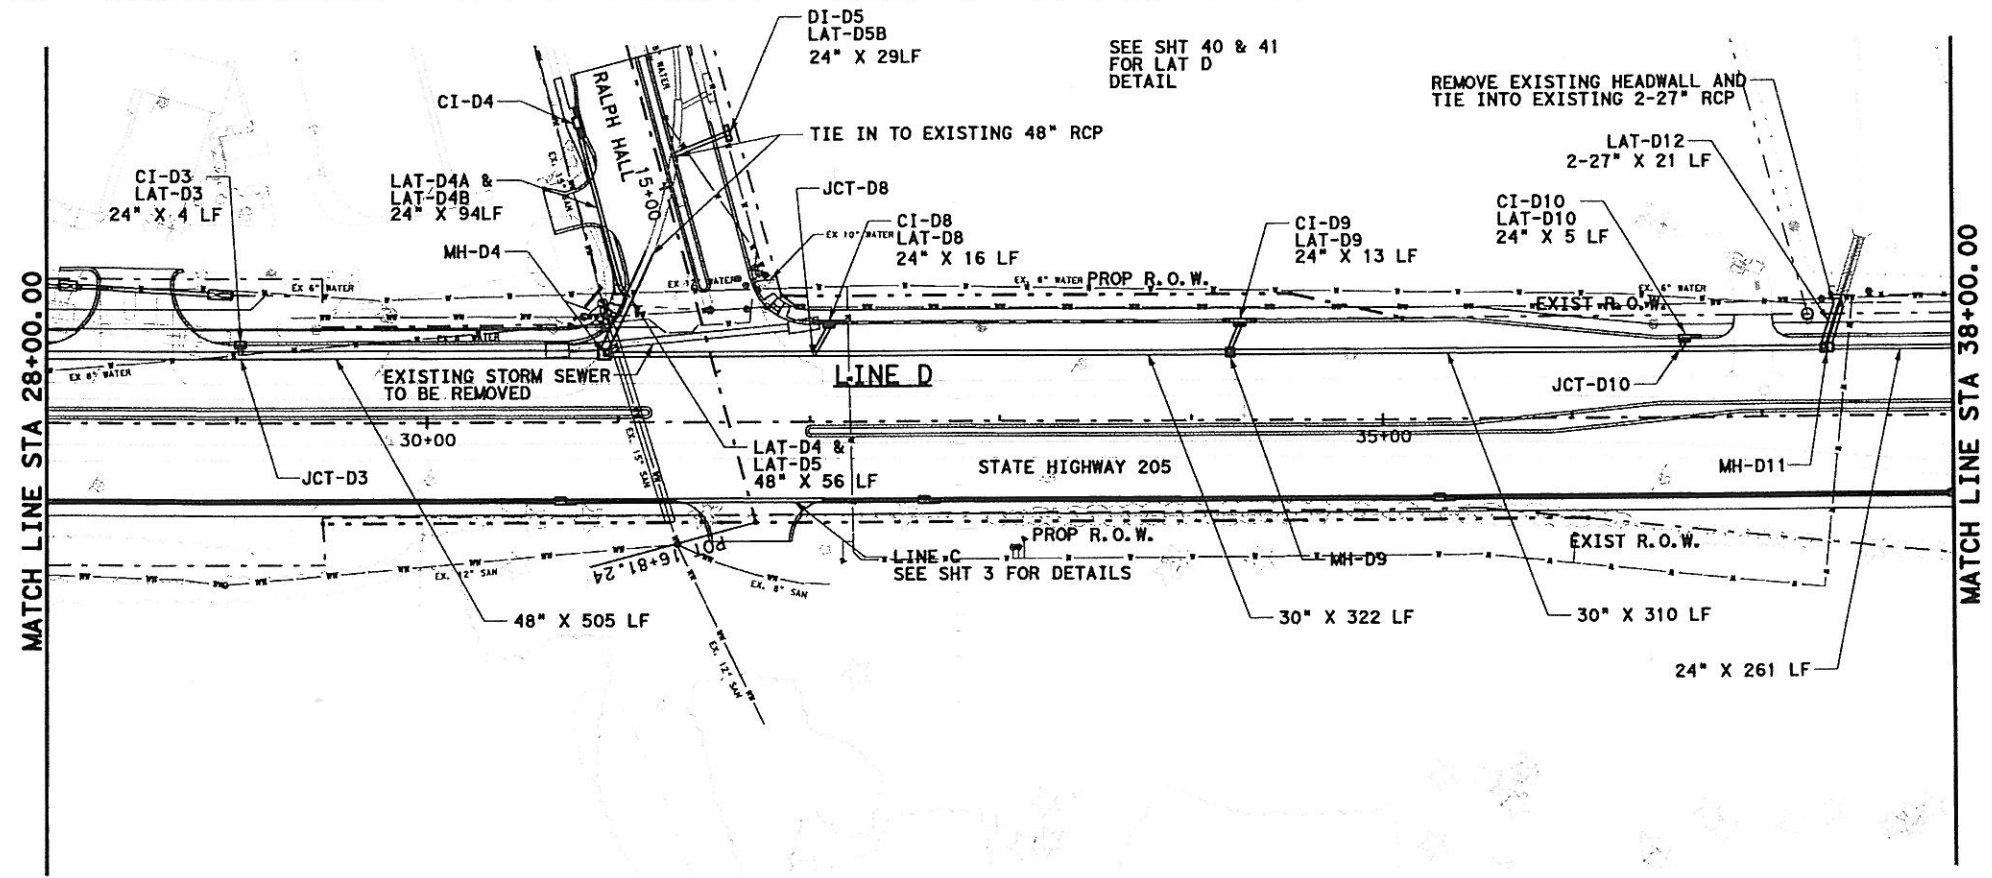

- GENERAL NOTES**
- CURB INLETS STATION AND OFFSET ARE MEASURED TO THE MIDPOINT OF THE FACE OF MAIN INLET. GRATE INLETS STATION AND OFFSET ARE MEASURED TO THE CENTER OF THE INLET.
 - JUNCTION BOX STATION AND OFFSET ARE MEASURED TO THE CENTER OF THE JUNCTION BOX.
 - ALL PIPES ARE CLASS III RCP UNLESS OTHERWISE NOTED.

PLAN
SCALE 1" = 100'

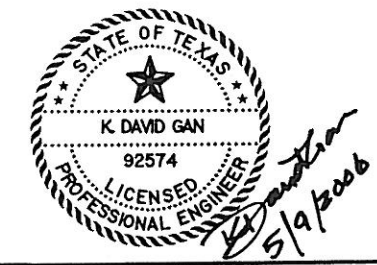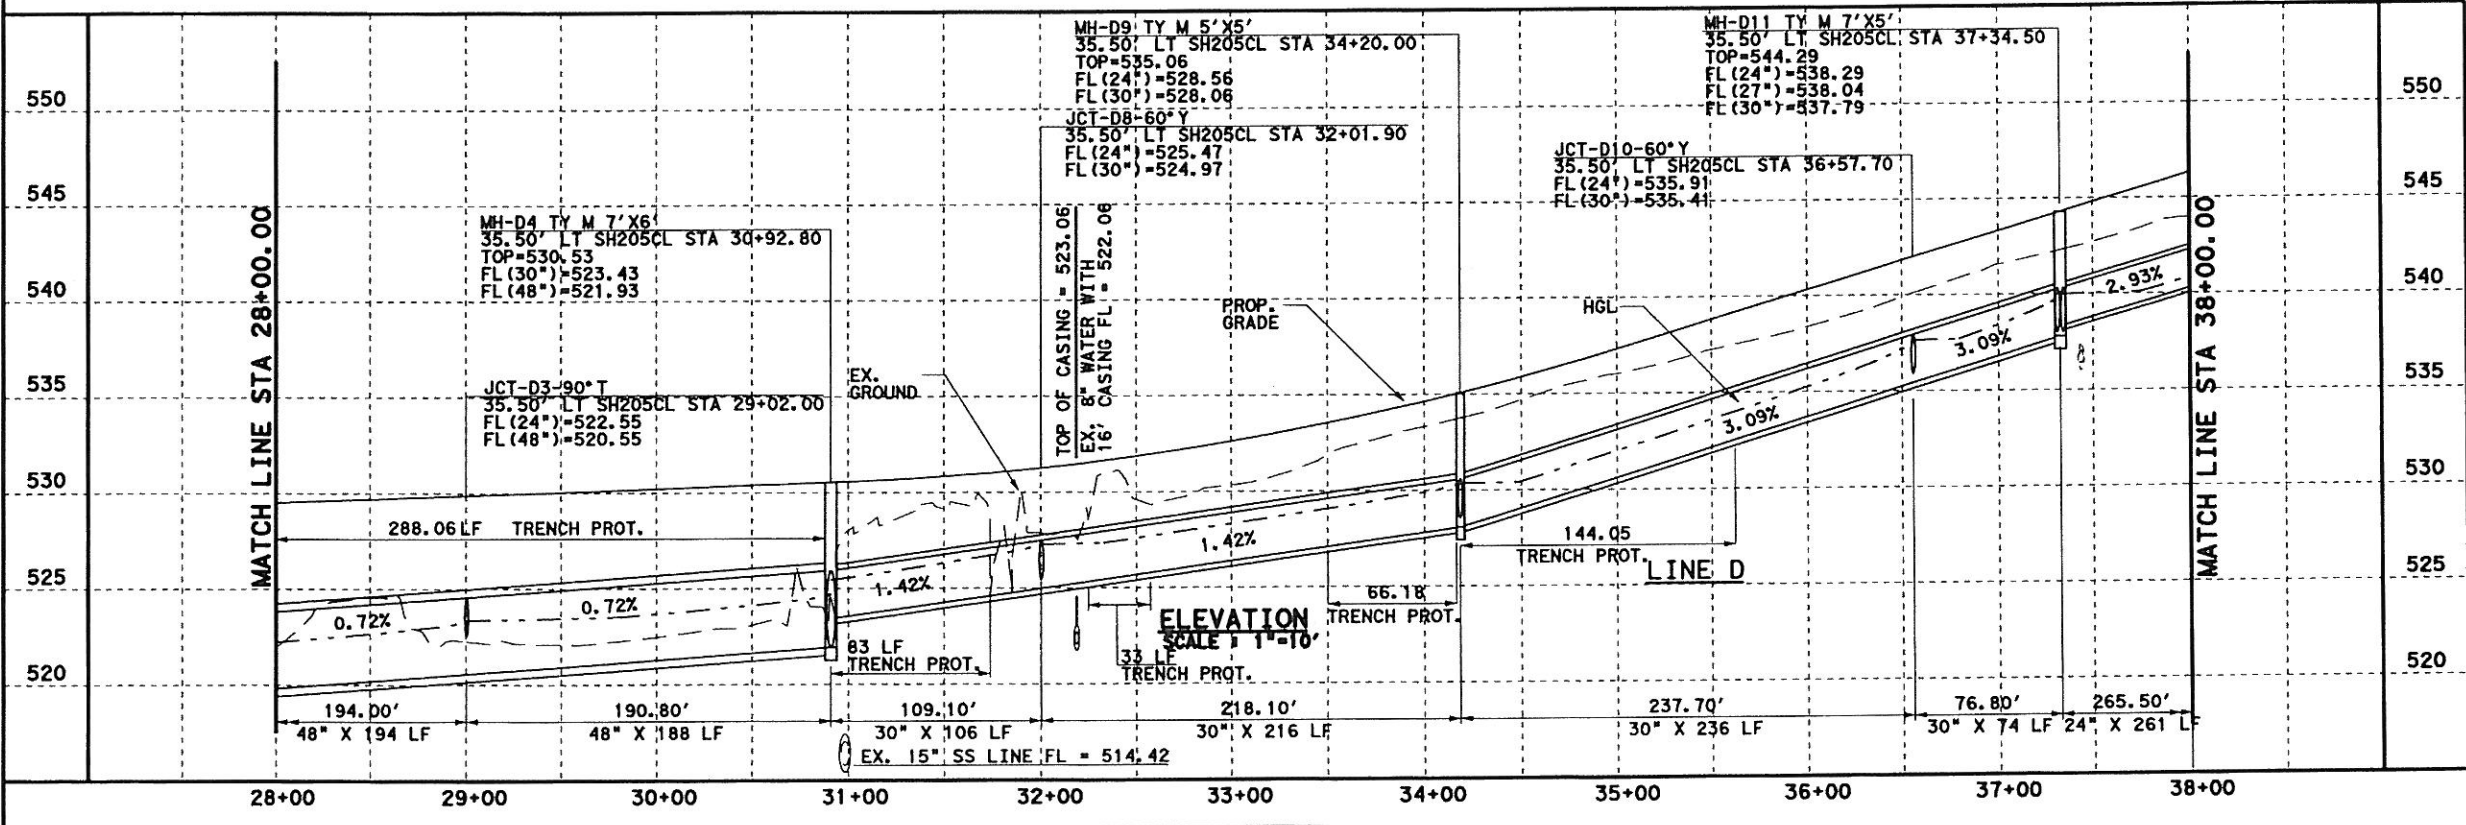

Parsons Brinckerhoff Quade & Douglas, Inc.
2777 Shimmens Freeway
Suite 1333
Dallas, TX 75207

Texas Department of Transportation
© 2006

SH 205
SOUTHBOUND DRAINAGE
STORM SEWER PLAN & PROFILE
STA 28+00 TO 38+00
SHEET 20 OF 57

STATE	DIST.	COUNTY	SHEET NO.
TEXAS	DALLAS	ROCKWALL	420
CONF.	SECT.	JOB	
0451	01	032. F.T.C.	

DGN=C:\JOBS\22451C-SH205\Drawings\2451c\sd04.dgn, ON=10-11, 13-623
 5/9/2006 Plotted 09-MAY-2006 12:58