



DGN=C:\JOBS\224510-SH205\Drawings\2451\add02.dgn, ON=10-623
 5/9/2006 Plotted 09-MAY-2006 12:59

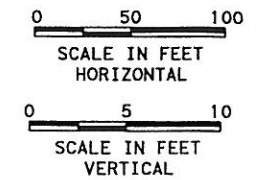

- GENERAL NOTES**
1. CURB INLETS STATION AND OFFSET ARE MEASURED TO THE MIDPOINT OF THE FACE OF MAIN INLET. GRATE INLETS STATION AND OFFSET ARE MEASURED TO THE CENTER OF THE INLET.
 2. JUNCTION BOX STATION AND OFFSET ARE MEASURED TO THE CENTER OF THE JUNCTION BOX.
 3. ALL PIPES ARE CLASS III RCP UNLESS OTHERWISE NOTED.

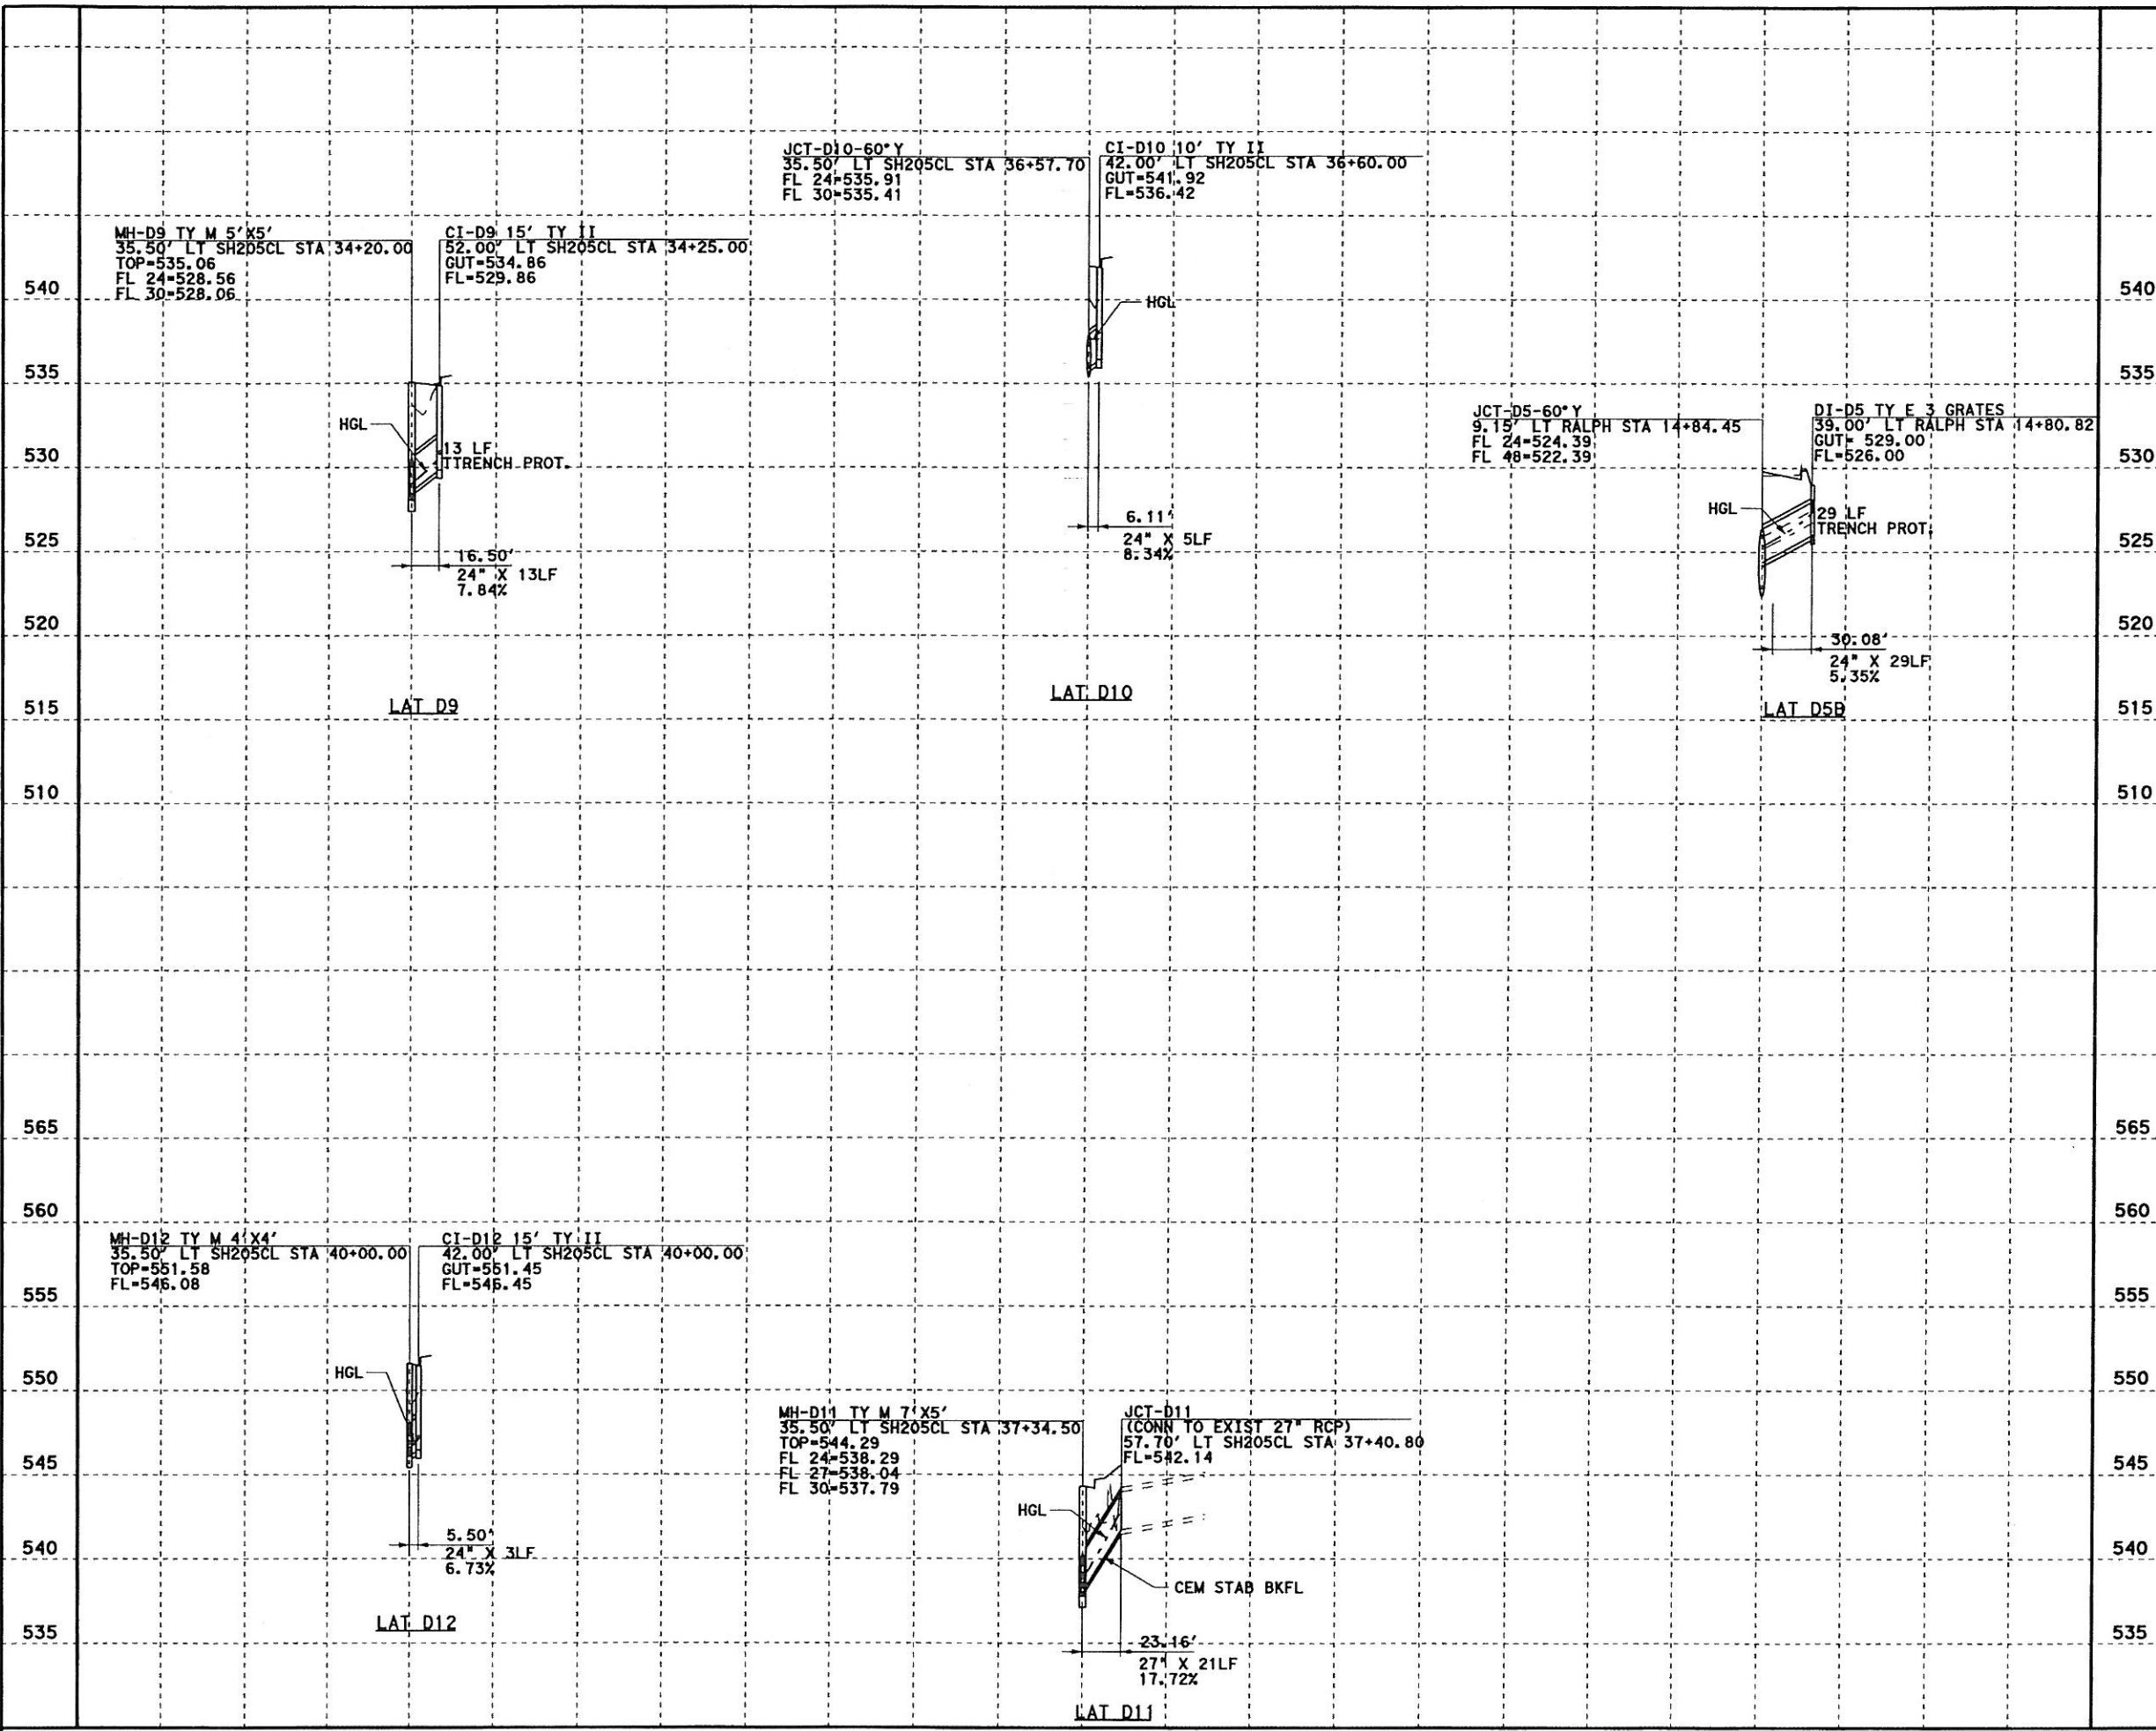

Parsons Brinckerhoff Quade & Douglas, Inc.
 2777 Stemmons Freeway
 Suite 1333
 Dallas, TX 75207

Texas Department of Transportation
 © 2006

SH 205



**DRAINAGE
 LINE D LATERALS**
STORM SEWER LATERAL PROFILES

SHEET 41 OF 57


| | | |
|----------------|-------------------------|-------------|
| FED. PROJ. NO. | FEDERAL AID PROJECT NO. | HIGHWAY NO. |
| 6 | (SEE TITLE SHEET) | SH 205 |
| STATE | DIST. | COUNTY |
| TEXAS | DALLAS | ROCKWALL |
| CONT. | SECT. | JOB |
| 0451 | 01 | 032, ETC. |

441

DGN-61\JOBS\22451C-SH205\Drawings\2451\addE01.dgn, ON=EO-623
 5/9/2006 Plotted 09-MAY-2006 12:59

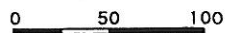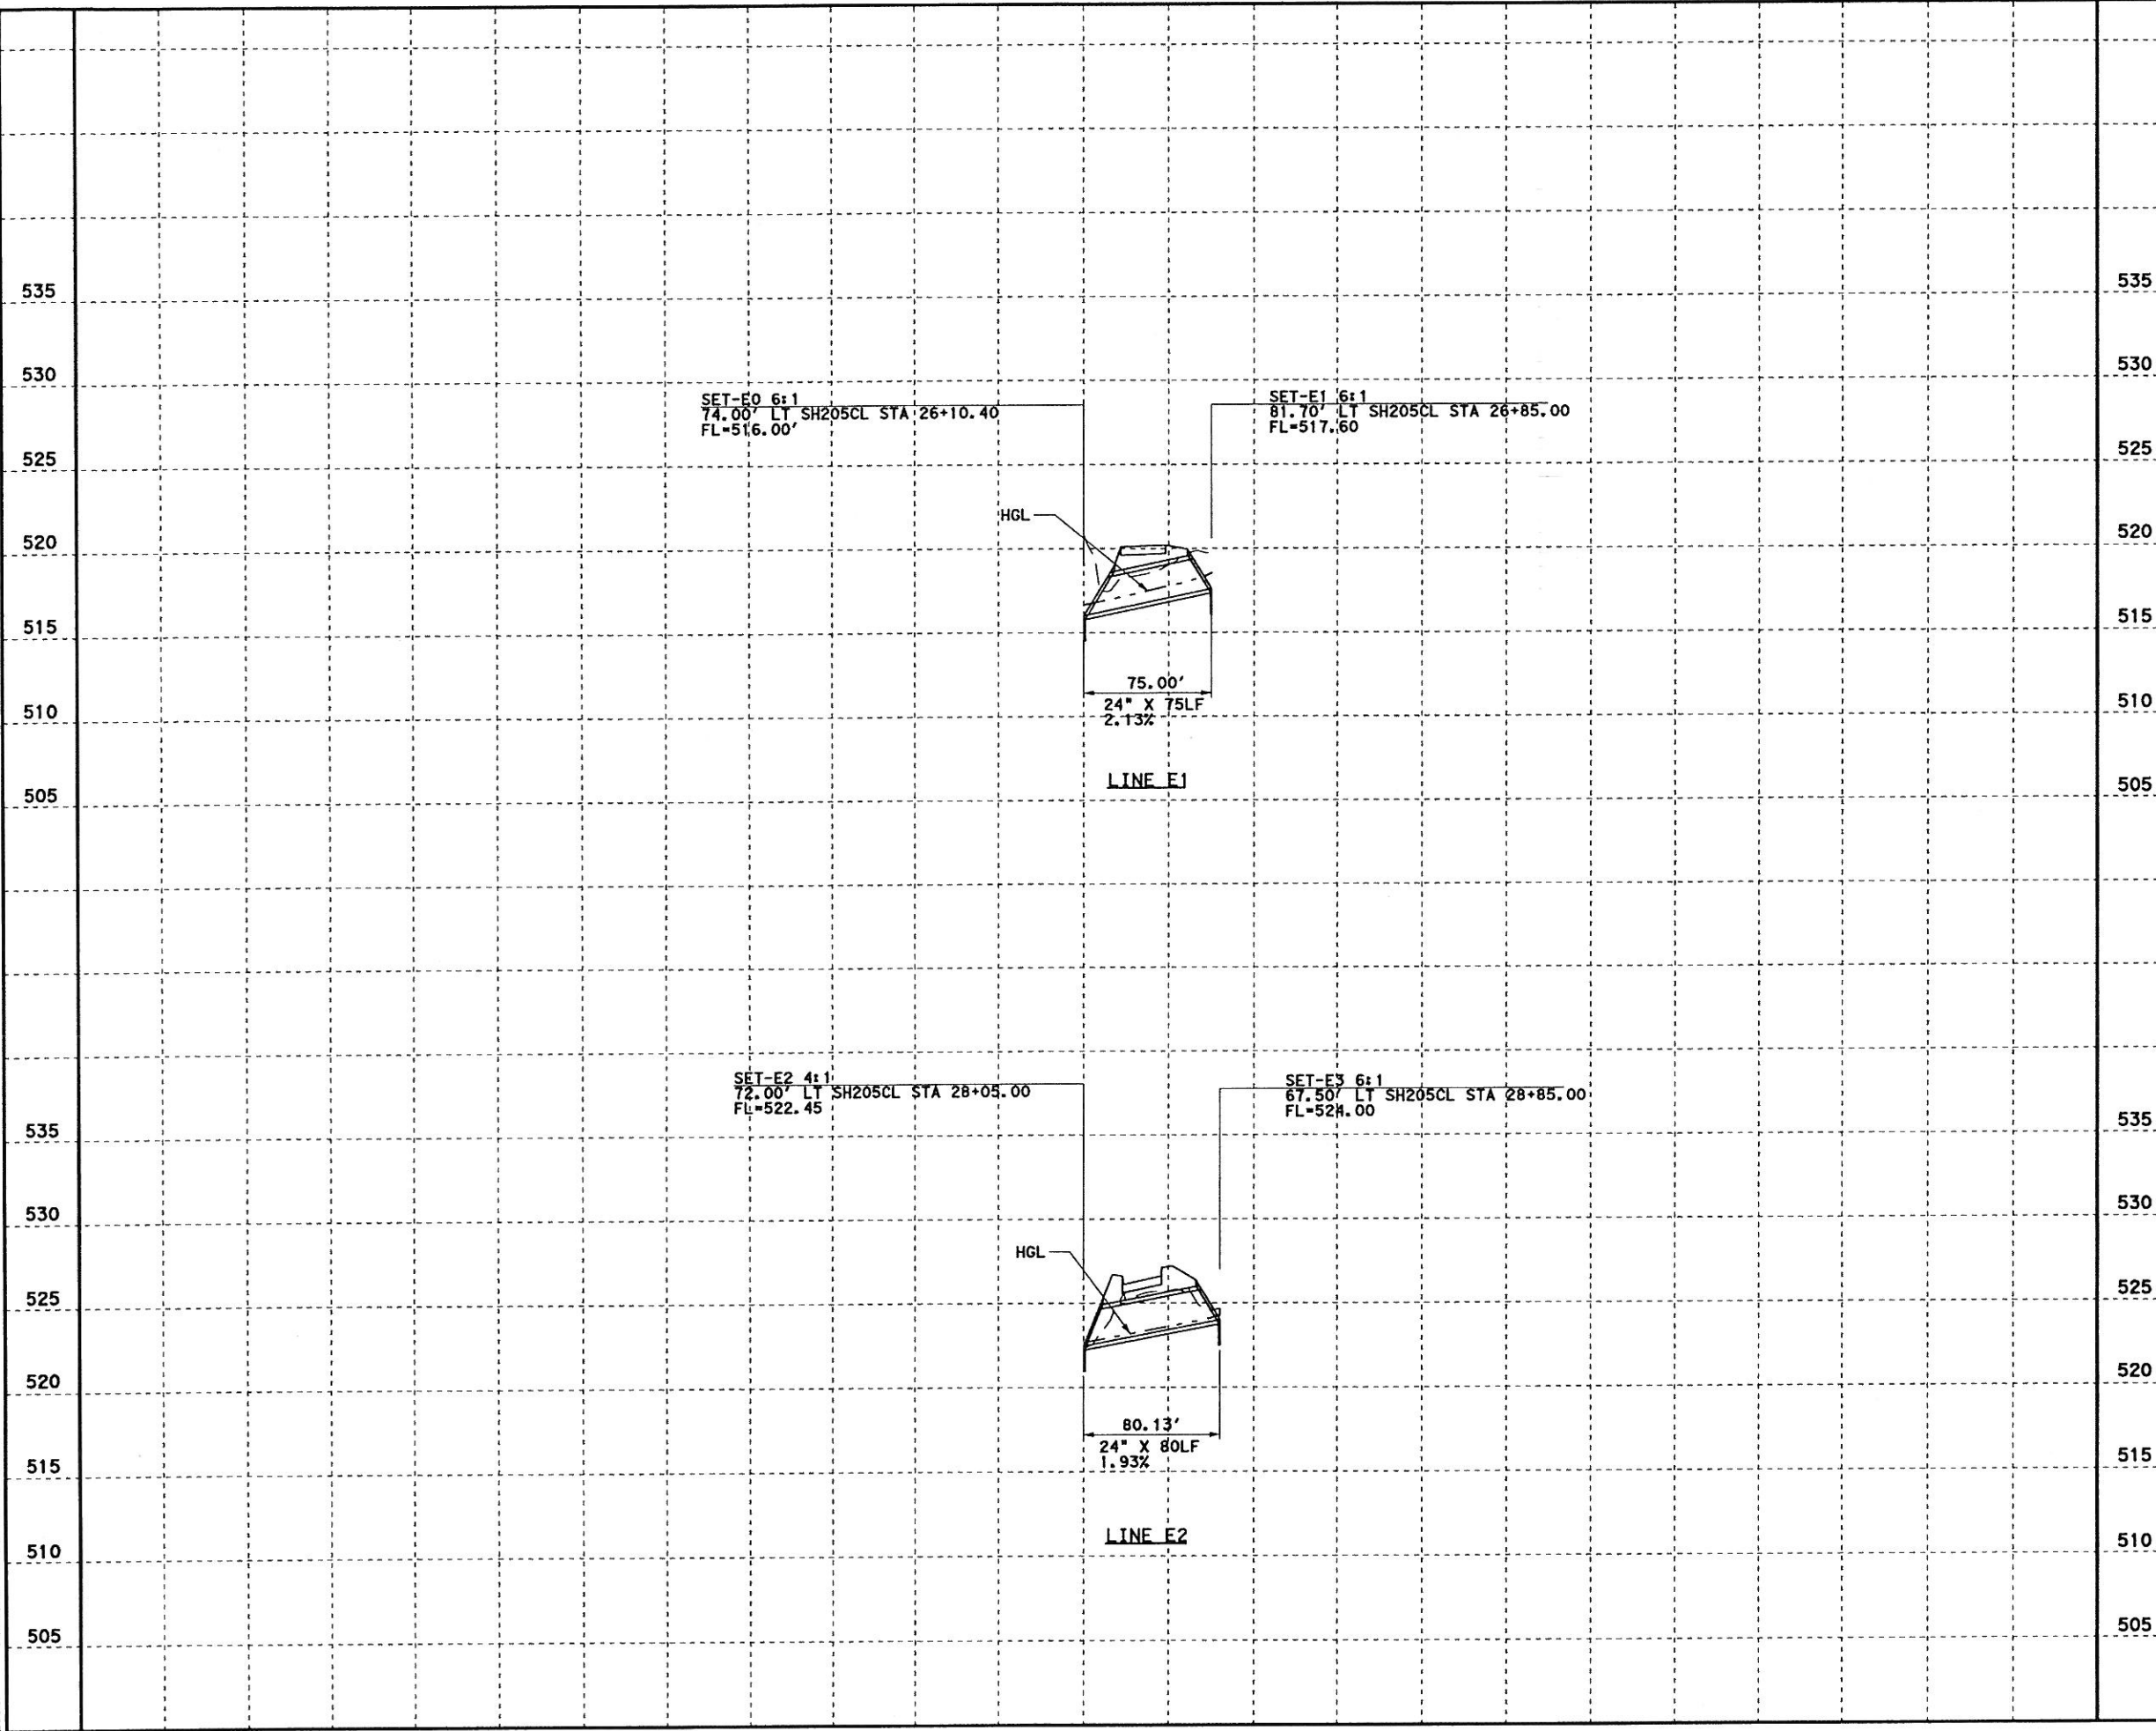

SCALE IN FEET
HORIZONTAL

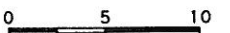

SCALE IN FEET
VERTICAL

GENERAL NOTES

1. CURB INLETS STATION AND OFFSET ARE MEASURED TO THE MIDPOINT OF THE FACE OF MAIN INLET. GRATE INLETS STATION AND OFFSET ARE MEASURED TO THE CENTER OF THE INLET.
2. JUNCTION BOX STATION AND OFFSET ARE MEASURED TO THE CENTER OF THE JUNCTION BOX.
3. ALL PIPES ARE CLASS III RCP UNLESS OTHERWISE NOTED.



Parsons Brinckerhoff Quade & Douglas, Inc.
 2777 Stemmons Freeway
 Suite 1333
 Dallas, TX 75207

Texas Department of Transportation
 © 2006

SH 205



DRAINAGE
LINE E

STORM SEWER LATERAL PROFILES

SHEET 42 OF 57

| | | | |
|----------------------|-------------------------|-------------|-----------|
| FED. PROJ. DIST. NO. | FEDERAL AID PROJECT NO. | HIGHWAY NO. | |
| 6 | (SEE TITLE SHEET) | SH 205 | |
| STATE | DIST. | COUNTY | SHEET NO. |
| TEXAS | DALLAS | ROCKWALL | 442 |
| CONT. | SECT. | JOB | |
| 0451 | 01 | 032, ETC | |

DGN:G:\JOBS\22451C-SH205\Drainage\2451\addE01.dgn, ON:10-623
 7/28/2008 P:\otted 28-JUL-2008 14:23

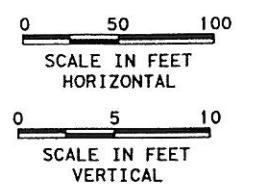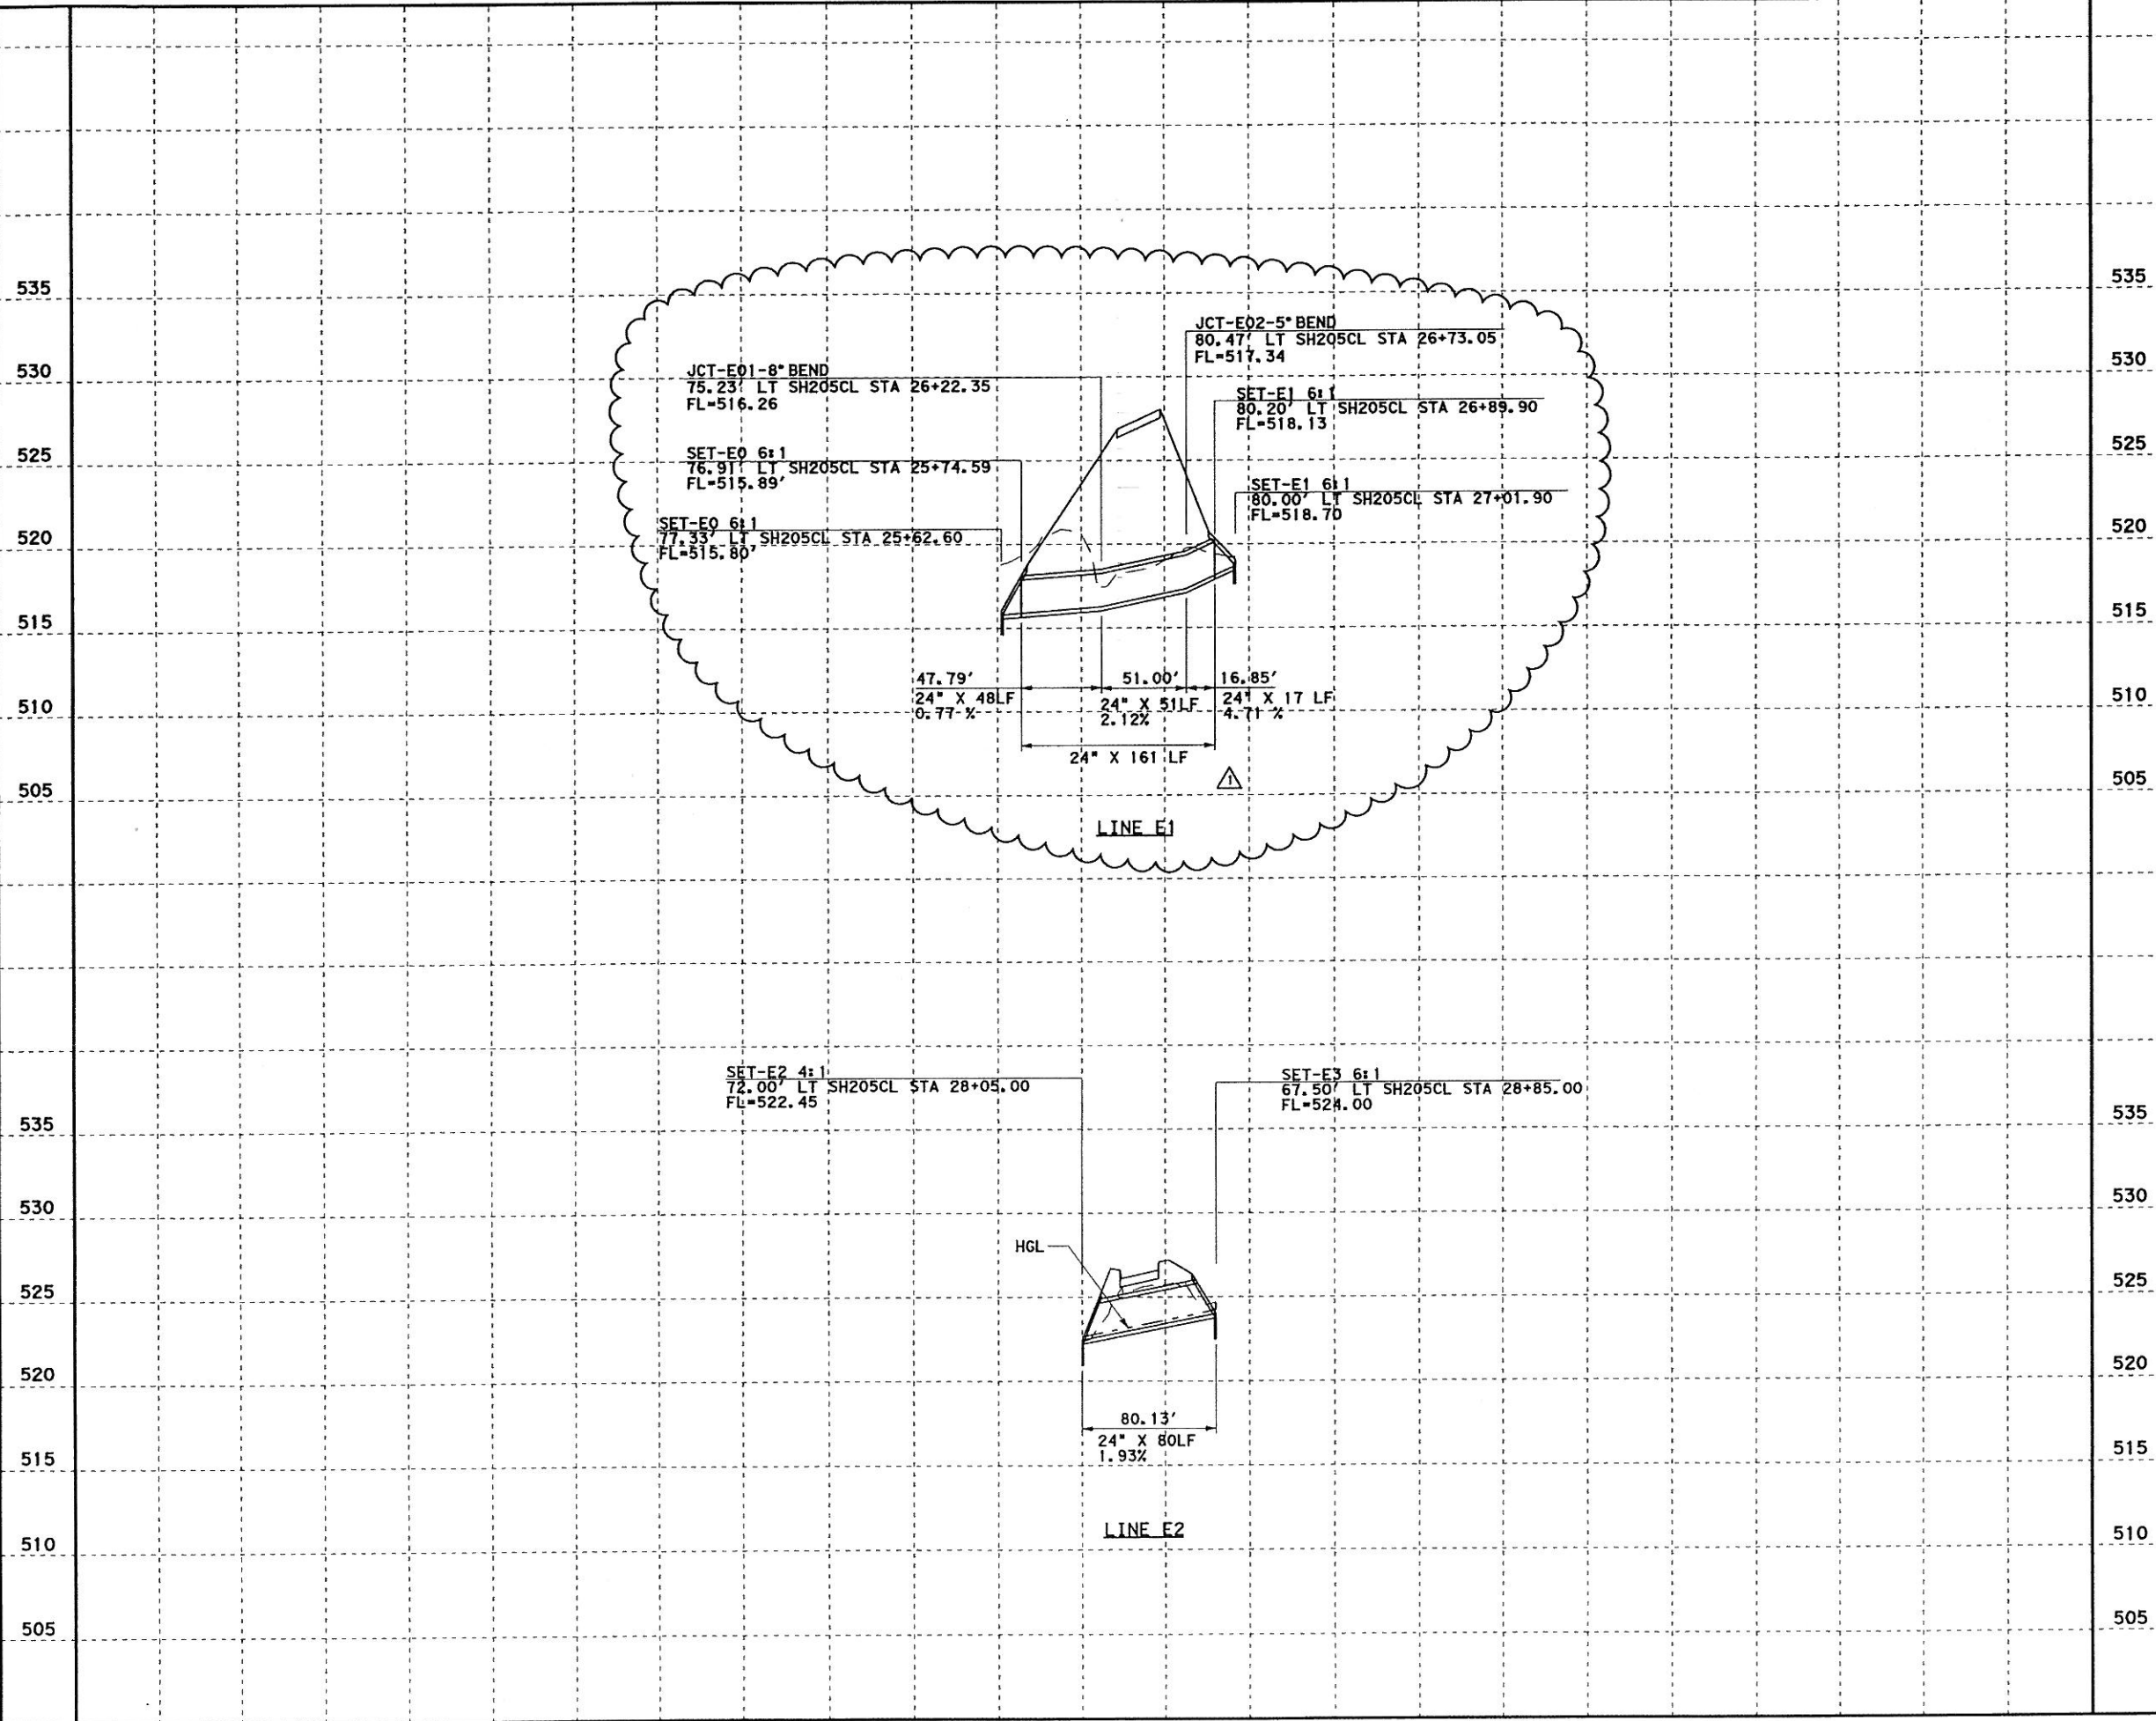

- GENERAL NOTES**
1. CURB INLETS STATION AND OFFSET ARE MEASURED TO THE MIDPOINT OF THE FACE OF MAIN INLET. GRATE INLETS STATION AND OFFSET ARE MEASURED TO THE CENTER OF THE INLET.
 2. JUNCTION BOX STATION AND OFFSET ARE MEASURED TO THE CENTER OF THE JUNCTION BOX.
 3. ALL PIPES ARE CLASS III RCP UNLESS OTHERWISE NOTED.



K. David Gan 7/28/08

Δ Change Order #48
 ▲ REVISED LINE E1 BY DG - 01/03/2008

 Parsons Brinckerhoff Quade & Douglas, Inc.
 2777 Stemmons Freeway
 Suite 1333
 Dallas, TX 75207



 Texas Department of Transportation
 © 2008

SH 205
 DRAINAGE
 LINE E
 STORM SEWER LATERAL PROFILES


SHEET 42 OF 57

| | | |
|-------------------|-------------------------|-------------|
| FED. RD. DIV. NO. | FEDERAL AID PROJECT NO. | HIGHWAY NO. |
| 6 | (SEE TITLE SHEET) | SH 205 |
| STATE | DIST. | COUNTY |
| TEXAS | DALLAS | ROCKWALL |
| CONT. | SECT. | JOB |
| 0451 | 01 | 032, ETC |
| | | SHEET NO. |
| | | 442A |

DON:\C\JOBS\22451C-SH205\Drawings\2451.cdd\F01.dgn, ON+CO-623
 5/9/2006 Plotted 09-MAY-2006 12:59

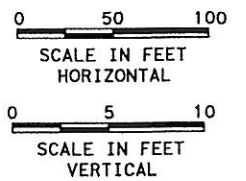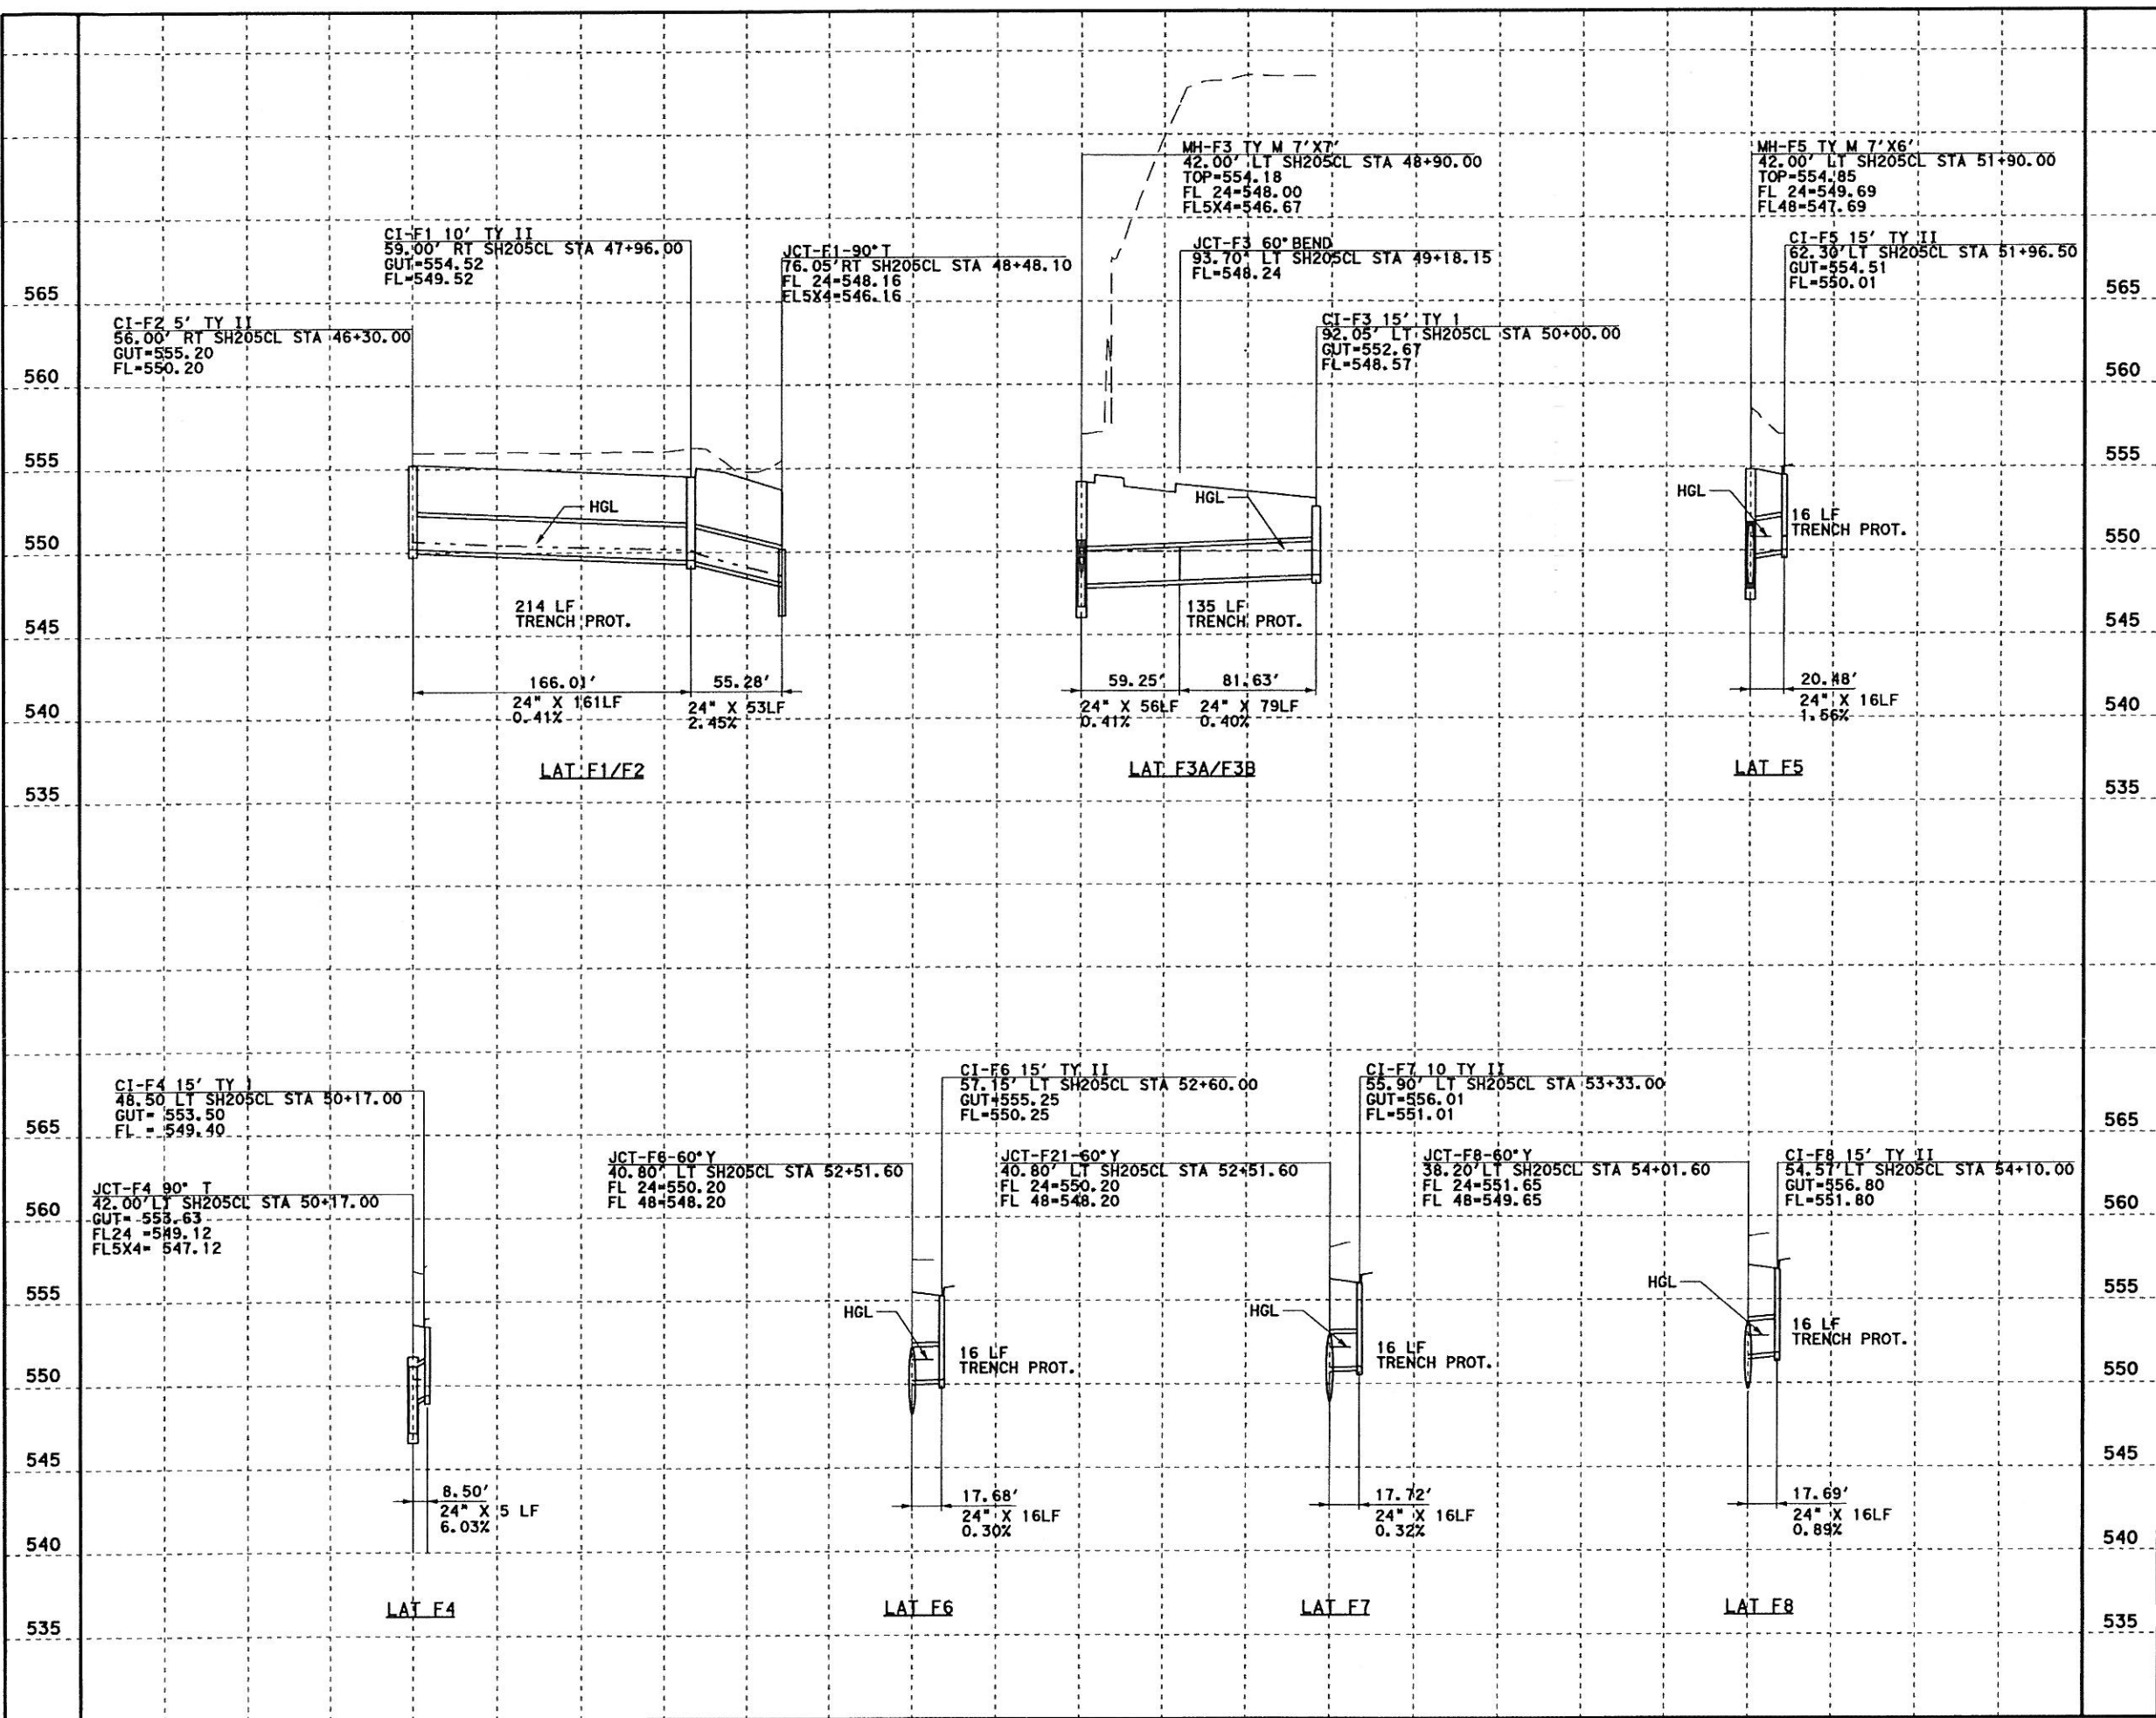

- GENERAL NOTES**
- CURB INLETS STATION AND OFFSET ARE MEASURED TO THE MIDPOINT OF THE FACE OF MAIN INLET. GRATE INLETS STATION AND OFFSET ARE MEASURED TO THE CENTER OF THE INLET.
 - JUNCTION BOX STATION AND OFFSET ARE MEASURED TO THE CENTER OF THE JUNCTION BOX.
 - ALL PIPES ARE CLASS III RCP UNLESS OTHERWISE NOTED.

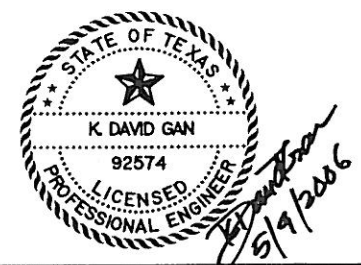



Parsons Brinckerhoff Quade & Douglas, Inc.
 2777 Stemmons Freeway
 Suite 1333
 Dallas, TX 75207

Texas Department of Transportation
 © 2006


SH 205
 DRAINAGE
 LINE F LATERALS
 STORM SEWER LATERAL PROFILES
 SHEET 43 OF 57

| | | |
|----------------|-------------------------|-------------|
| FED. PROJ. NO. | FEDERAL AID PROJECT NO. | HIGHWAY NO. |
| 6 | (SEE TITLE SHEET) | SH 205 |
| STATE | DIST. | COUNTY |
| TEXAS | DALLAS | ROCKWALL |
| CONT. | SECT. | JOB |
| 0451 | 01 | 032, ETC |

DGN=01 \JOBS\224510-SH205\Drawings\2451.cadd\F02.dgn, ON=10-02
5/9/2006 Plotted 09-MAY-2006 12:59

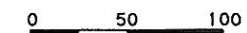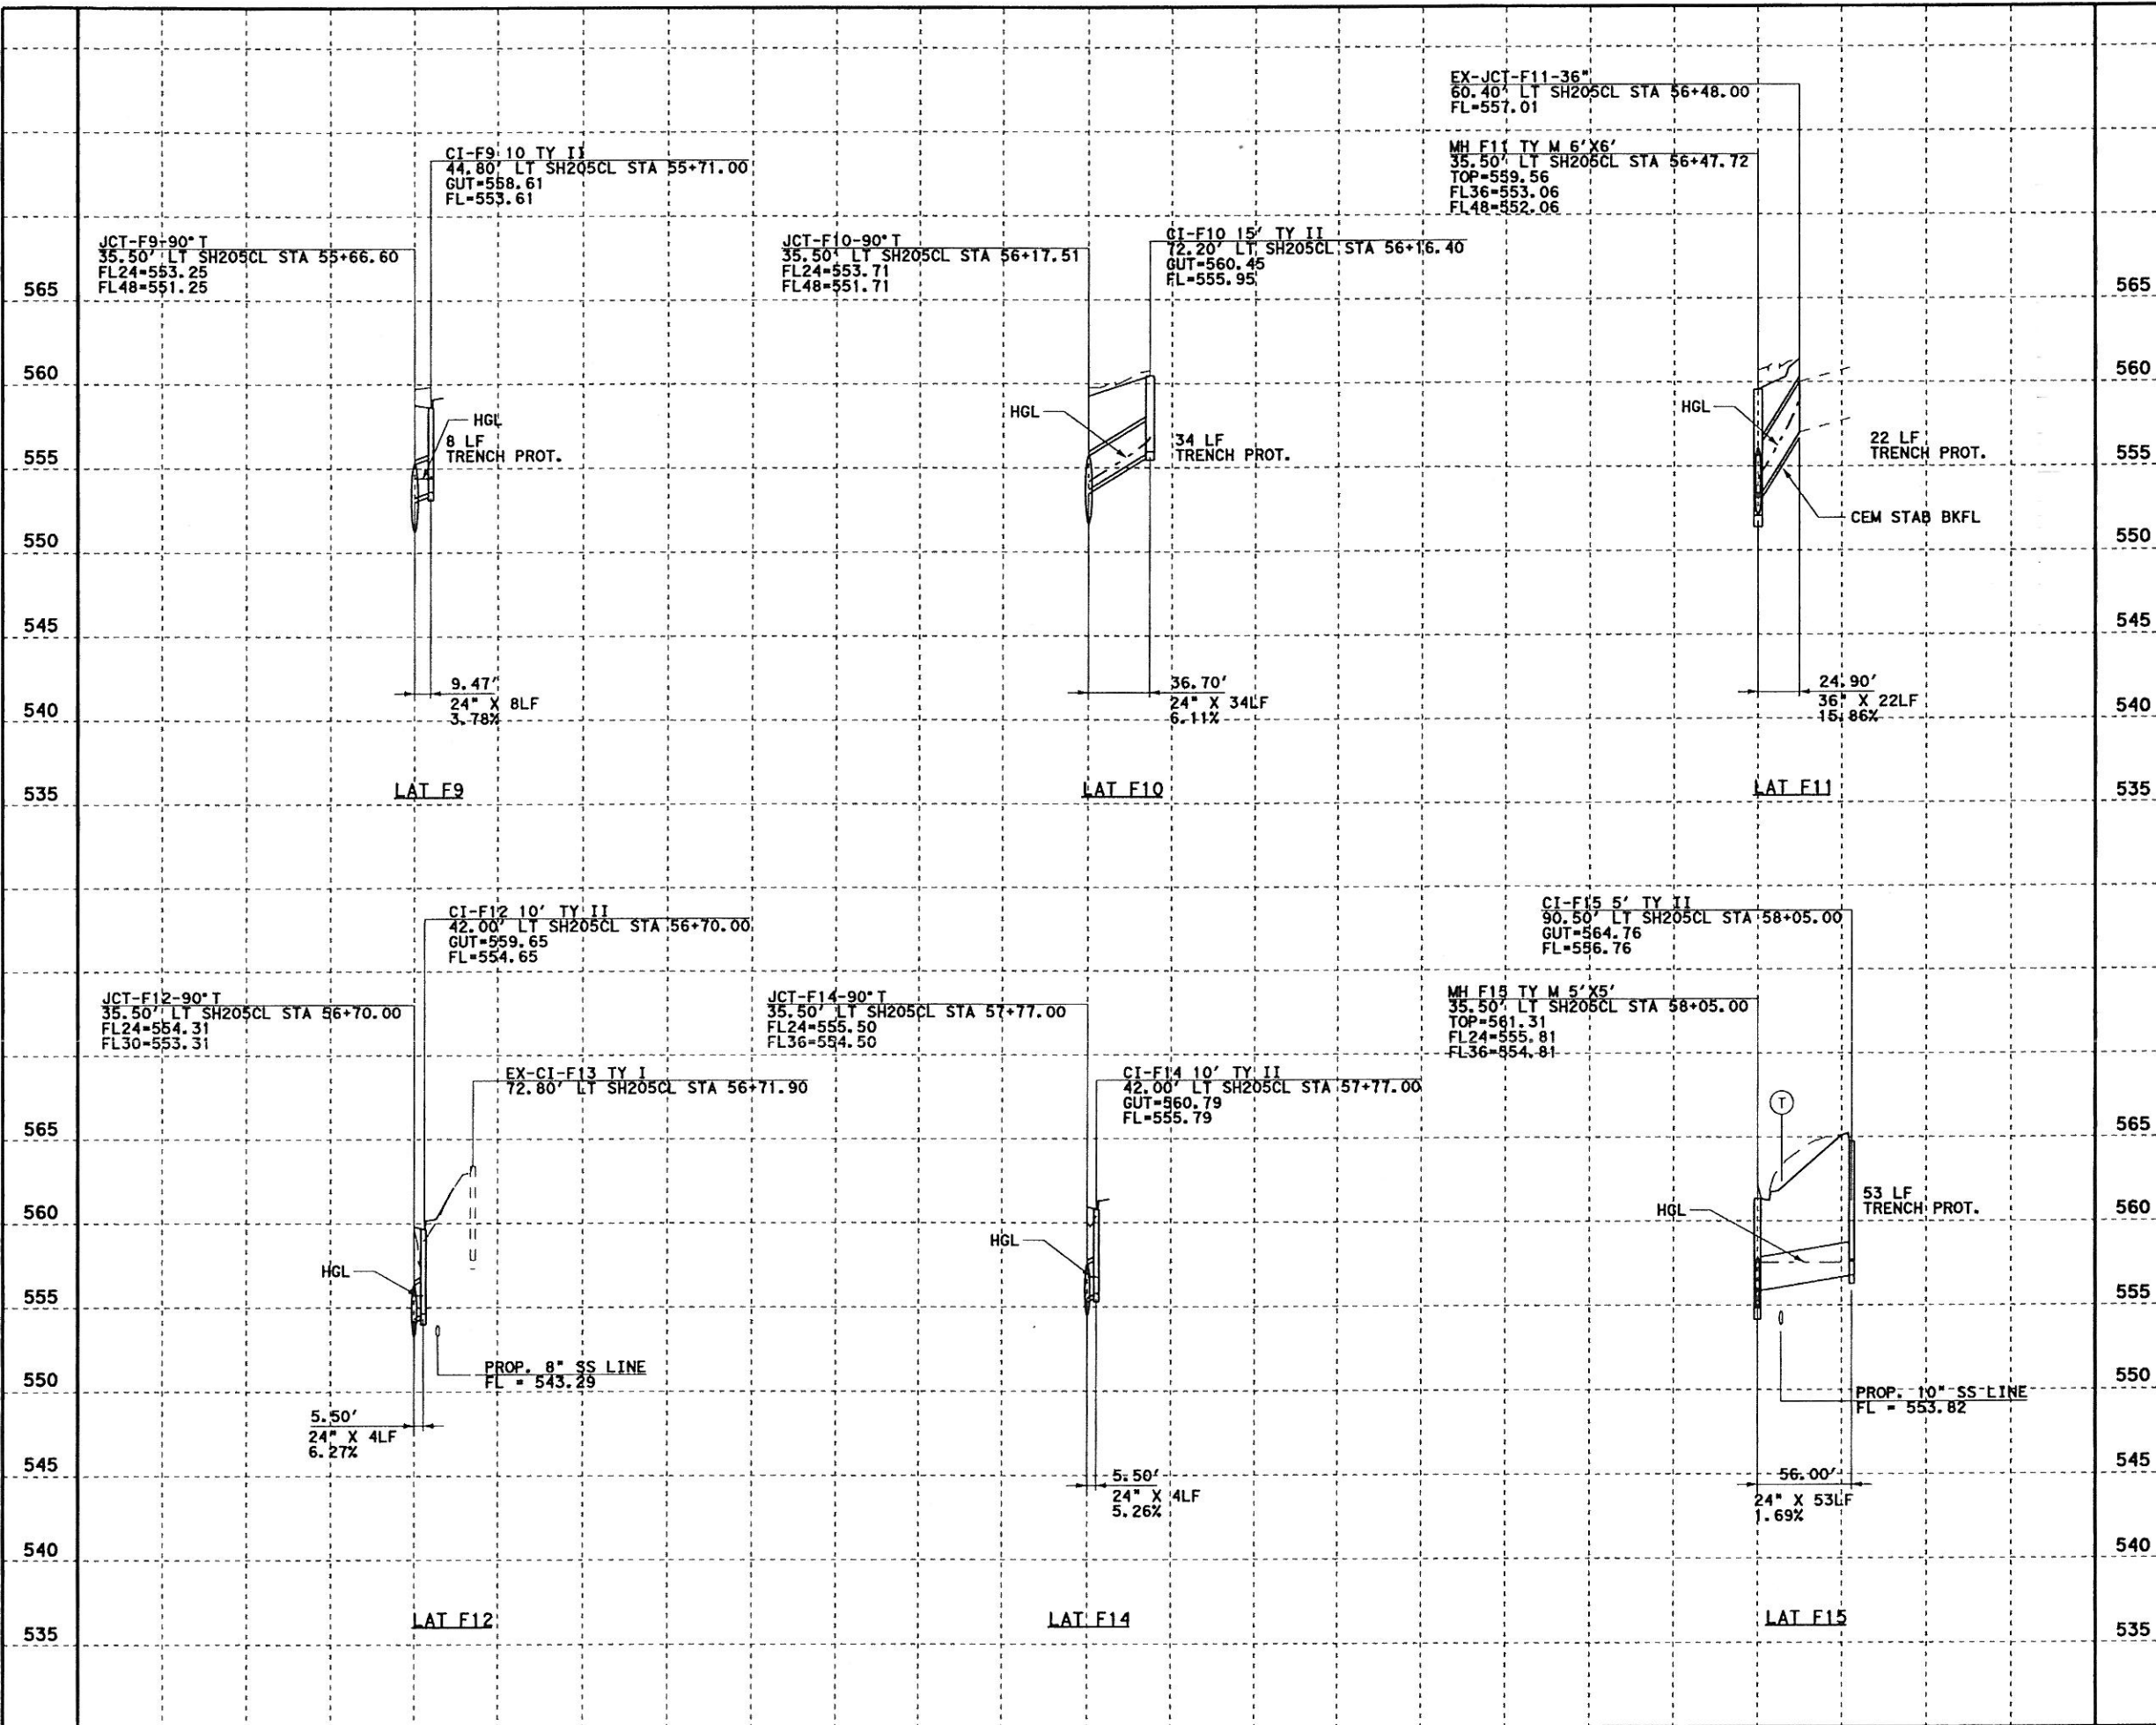

SCALE IN FEET
HORIZONTAL

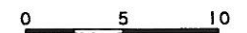

SCALE IN FEET
VERTICAL

GENERAL NOTES

- CURB INLETS STATION AND OFFSET ARE MEASURED TO THE MIDPOINT OF THE FACE OF MAIN INLET. GRATE INLETS STATION AND OFFSET ARE MEASURED TO THE CENTER OF THE INLET.
- JUNCTION BOX STATION AND OFFSET ARE MEASURED TO THE CENTER OF THE JUNCTION BOX.
- ALL PIPES ARE CLASS III RCP UNLESS OTHERWISE NOTED.

LEGENDS

- (G) EX. GAS LINE CROSSING ELEVATION UNKNOWN
- (T) EX. SW BELL CABLE CROSSING ELEVATION UNKNOWN



PB Parsons Brinckerhoff Quade & Douglas, Inc.
2777 Stemmons Freeway
Suite 1333
Dallas, TX 75207

Texas Department of Transportation
© 2006

SH 205

DRAINAGE
LINE F LATERALS
STORM SEWER LATERAL PROFILES

SHEET 44 OF 57

| | | |
|--------------------|-------------------------|-------------|
| FED. AID DIST. NO. | FEDERAL AID PROJECT NO. | HIGHWAY NO. |
| 6 | (SEE TITLE SHEET) | SH 205 |
| STATE | DIST. | COUNTY |
| TEXAS | DALLAS | ROCKWALL |
| CONT. | SECT. | JOB |
| 0451 | 01 | 032, ETC |

444

CI-F18 15' TY II
70.30' LT SH205CL STA 61+25.00
GUT=570.15
FL=565.15




MH F18 TY M 5'x4'
35.50' LT SH205CL STA 61+10.00
TOP=568.04
FL24=562.54
FL30=562.04

CI-F16 15' TY II
70.30' LT SH205CL STA 58+72.00
GUT=566.00
FL=560.50

CI-F17 15' TY II
42.00' LT SH205CL STA 58+95.00
GUT=562.81
FL=557.91

JCT-F16-60°Y
35.50' LT SH205CL STA 58+53.35
FL24=556.88
FL30=556.38

JCT-F17-90°T
35.50' LT SH205CL STA 58+95.00
FL24=557.80
FL30=557.30

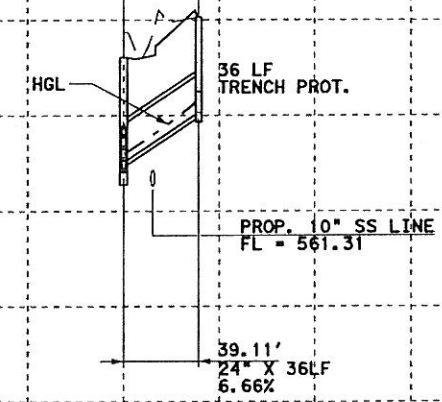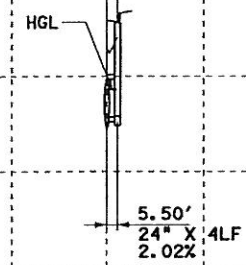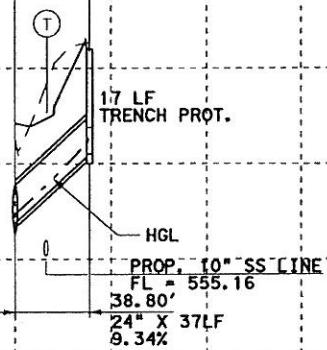

LAT F16


LAT F17

LAT F18


JCT-F22-45° BEND
47.90' LT SH205CL STA 65+24.40
FL=570.40

CI-F22 15' TY I
22.00' LT YELLOW STA 15+10.00
GUT=578.29
FL=573.19

JCT-F22-60°Y
41.00' LT SH205CL STA 65+20.40
FL=569.90

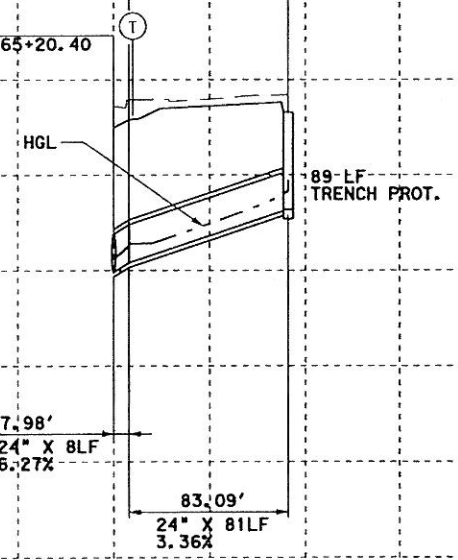

LAT F22A/F22B

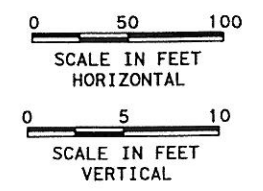

GENERAL NOTES

1. CURB INLETS STATION AND OFFSET ARE MEASURED TO THE MIDPOINT OF THE FACE OF MAIN INLET. GRATE INLETS STATION AND OFFSET ARE MEASURED TO THE CENTER OF THE INLET.
2. JUNCTION BOX STATION AND OFFSET ARE MEASURED TO THE CENTER OF THE JUNCTION BOX.
3. ALL PIPES ARE CLASS III RCP UNLESS OTHERWISE NOTED.

LEGENDS

- (G) EX. GAS LINE CROSSING ELEVATION UNKNOWN
- (T) EX. SW BELL CABLE CROSSING ELEVATION UNKNOWN



PB Parsons Brinckerhoff Quade & Douglas, Inc.
2777 Stemmons Freeway
Suite 1333
Dallas, TX 75207

Texas Department of Transportation
© 2006



SH 205

DRAINAGE
LINE F LATERALS
STORM SEWER LATERAL PROFILES

SHEET 45 OF 57

| | | |
|-------------------|-------------------------|-------------|
| FED. AID DIV. NO. | FEDERAL AID PROJECT NO. | HIGHWAY NO. |
| 6 | (SEE TITLE SHEET) | SH 205 |
| STATE | DIST. | COUNTY |
| TEXAS | DALLAS | ROCKWALL |
| CONT. | SECT. | JOB |
| 0451 | 01 | 032, ETC |
| | | SHEET NO. |
| | | 445 |

D:\G1\JOBS\22451\IC-SH205\Drawings\2451\icd\03.dgn, ON=10-627
 5/9/2006 P:\dred 03-MAY-2006 12:59

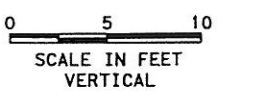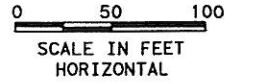

GENERAL NOTES

1. CURB INLETS STATION AND OFFSET ARE MEASURED TO THE MIDPOINT OF THE FACE OF MAIN INLET. GRATE INLETS STATION AND OFFSET ARE MEASURED TO THE CENTER OF THE INLET.
2. JUNCTION BOX STATION AND OFFSET ARE MEASURED TO THE CENTER OF THE JUNCTION BOX.
3. ALL PIPES ARE CLASS III RCP UNLESS OTHERWISE NOTED.



PB Parsons Brinckerhoff Quade & Douglas, Inc.
2777 Simmons Freeway
Suite 1333
Dallas, TX 75207

Texas Department of Transportation
© 2006


SH 205

DRAINAGE
LINE I LATERALS
STORM SEWER LATERAL PROFILES



SHEET 46 OF 57

| | | | |
|----------------------|--|-----------------------|-----------|
| FED. NO. DIV. NO. | FEDERAL AID PROJECT NO. (SEE TITLE SHEET) | HIGHWAY NO. SH 205 | SHEET NO. |
| 6 | | | 446 |
| STATE | DIST. | COUNTY | JOB |
| TEXAS | DALLAS | ROCKWALL | 032, ETC |
| COMT. | SECT. | | |
| 0451 | 01 | | |

DGN:G:\JOBS\22451C-SH205\Drawings\2451add101.dgn, ON:10-621
 5/9/2006 Plotted 09-MAY-2006 12:59

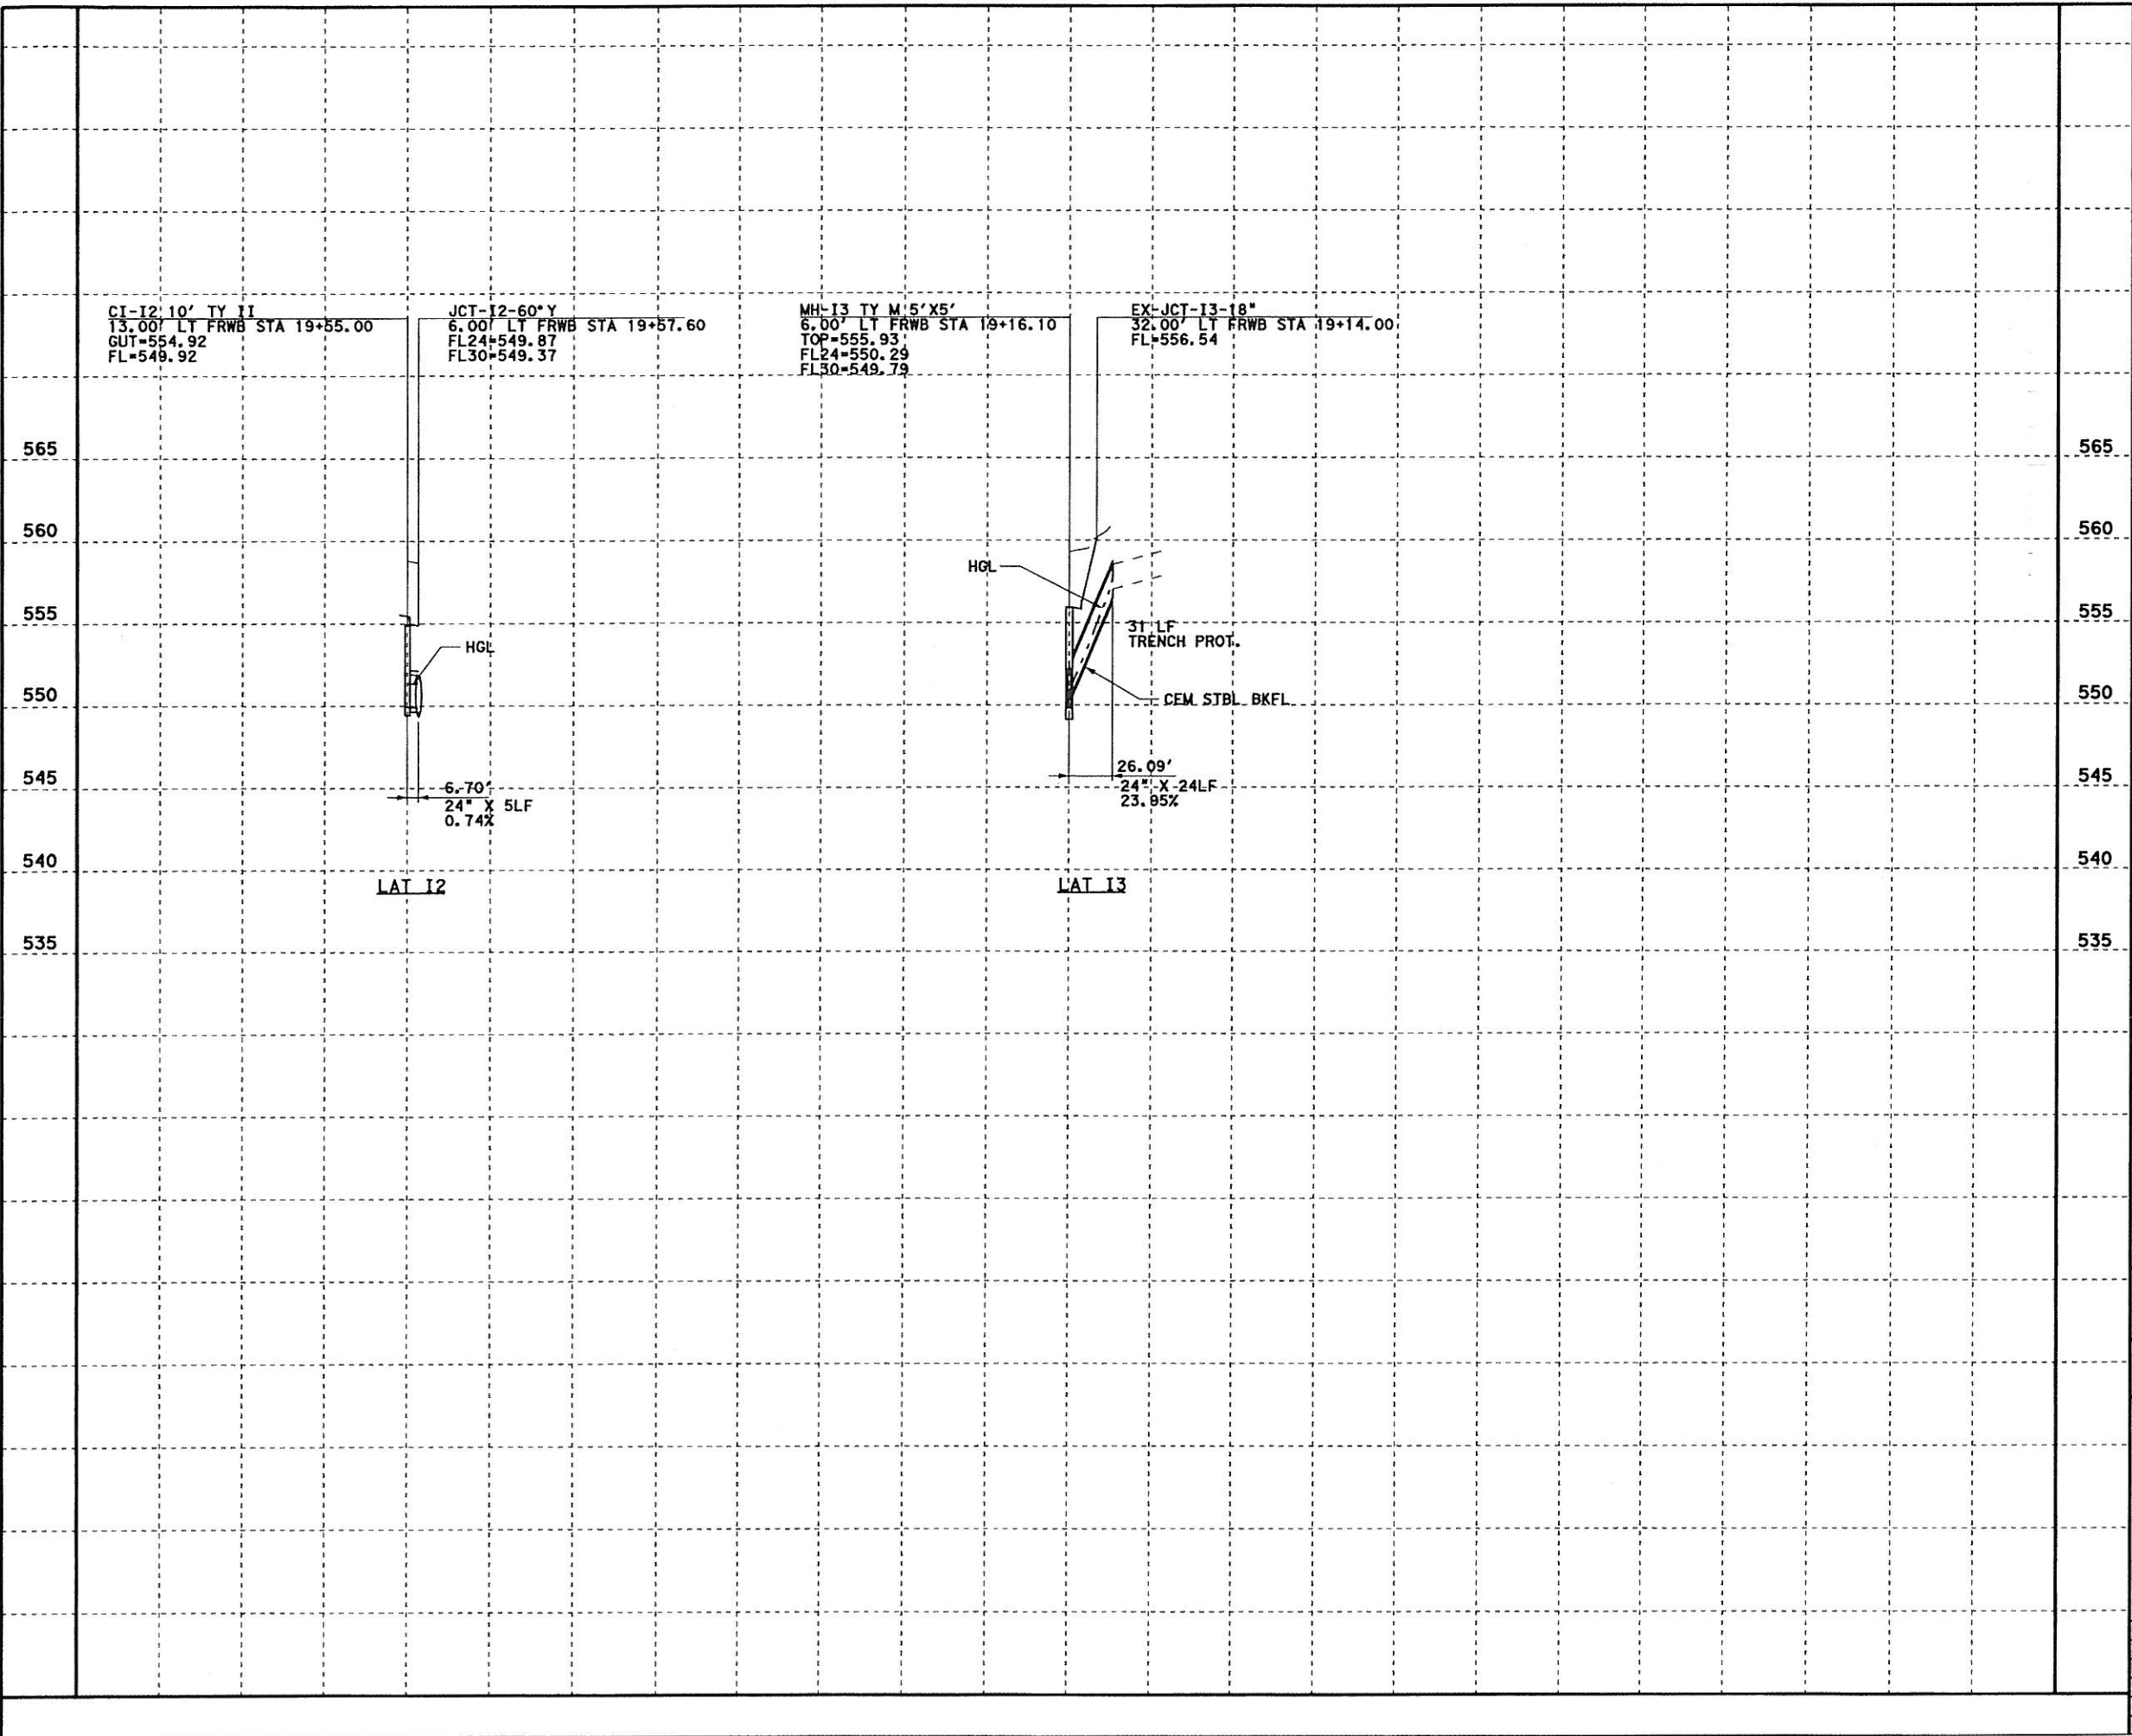

DGN=G:\JOBS\22451C-SH205\Drawings\2451odd101-REV1.dgn, ON=10-623
 3/2/2009 Plotted 02-MAR-2009 11:30

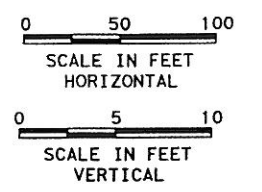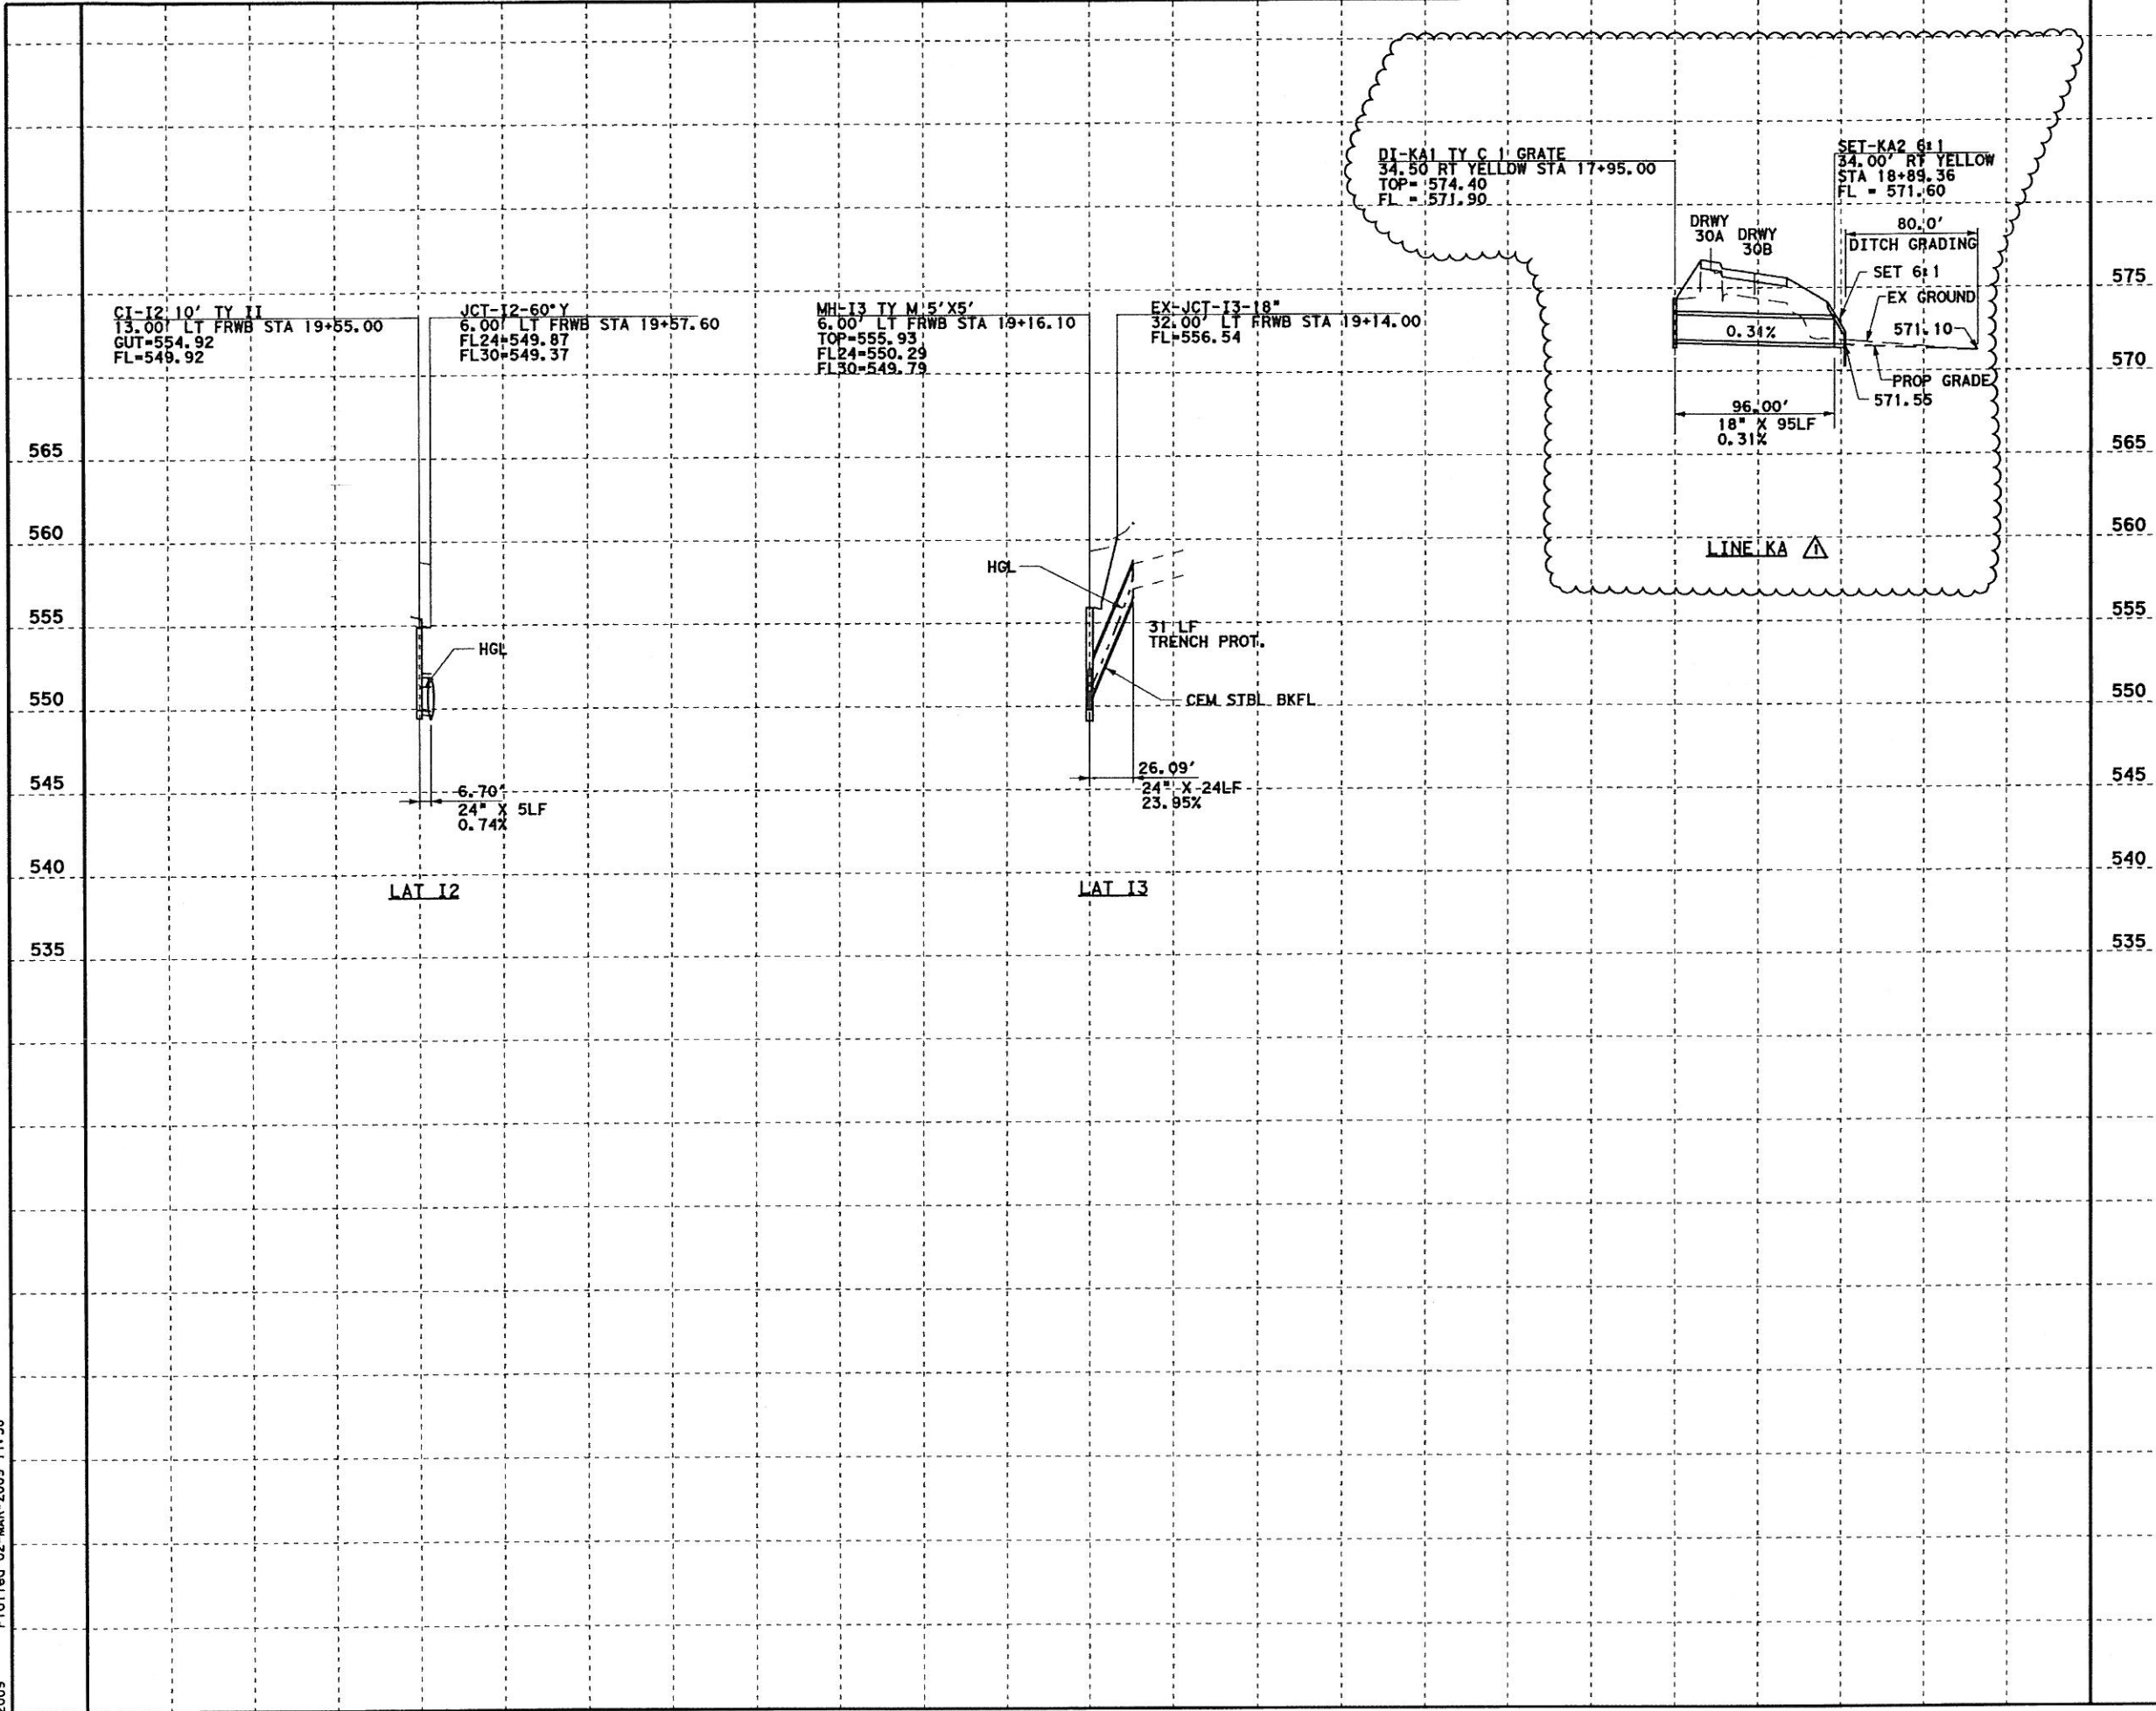

GENERAL NOTES

1. CURB INLETS STATION AND OFFSET ARE MEASURED TO THE MIDPOINT OF THE FACE OF MAIN INLET. GRATE INLETS STATION AND OFFSET ARE MEASURED TO THE CENTER OF THE INLET.
2. JUNCTION BOX STATION AND OFFSET ARE MEASURED TO THE CENTER OF THE JUNCTION BOX.
3. ALL PIPES ARE CLASS III RCP UNLESS OTHERWISE NOTED.



K. David Gan 3/2/2009

△ ADDED LINE KA - KDG - 11/07/2008

PR Parsons Brinckerhoff Quade & Douglas, Inc.
 2777 Stemmons Freeway
 Suite 1333
 Dallas, TX 75207

T Texas Department of Transportation
 © 2008



SH 205

DRAINAGE
 LINE I LATERALS
 STORM SEWER LATERAL PROFILES

SHEET 46 OF 57

| | | |
|-------------------|-------------------------|-------------|
| FED. RD. DIV. NO. | FEDERAL AID PROJECT NO. | HIGHWAY NO. |
| 6 | (SEE TITLE SHEET) | SH 205 |
| STATE | DIST. | COUNTY |
| TEXAS | DALLAS | ROCKWALL |
| CONT. | SECT. | JOB |
| 0451 | 01 | 032, ETC |
| | | SHEET NO. |
| | | 446A |

D:\G1\JOBS\22451\IC-SH205\Drawings\2451\icddk01.dwg, ON=10-627
 5/9/2006 P:\crted 09-MAY-2006 12:59

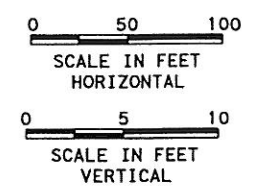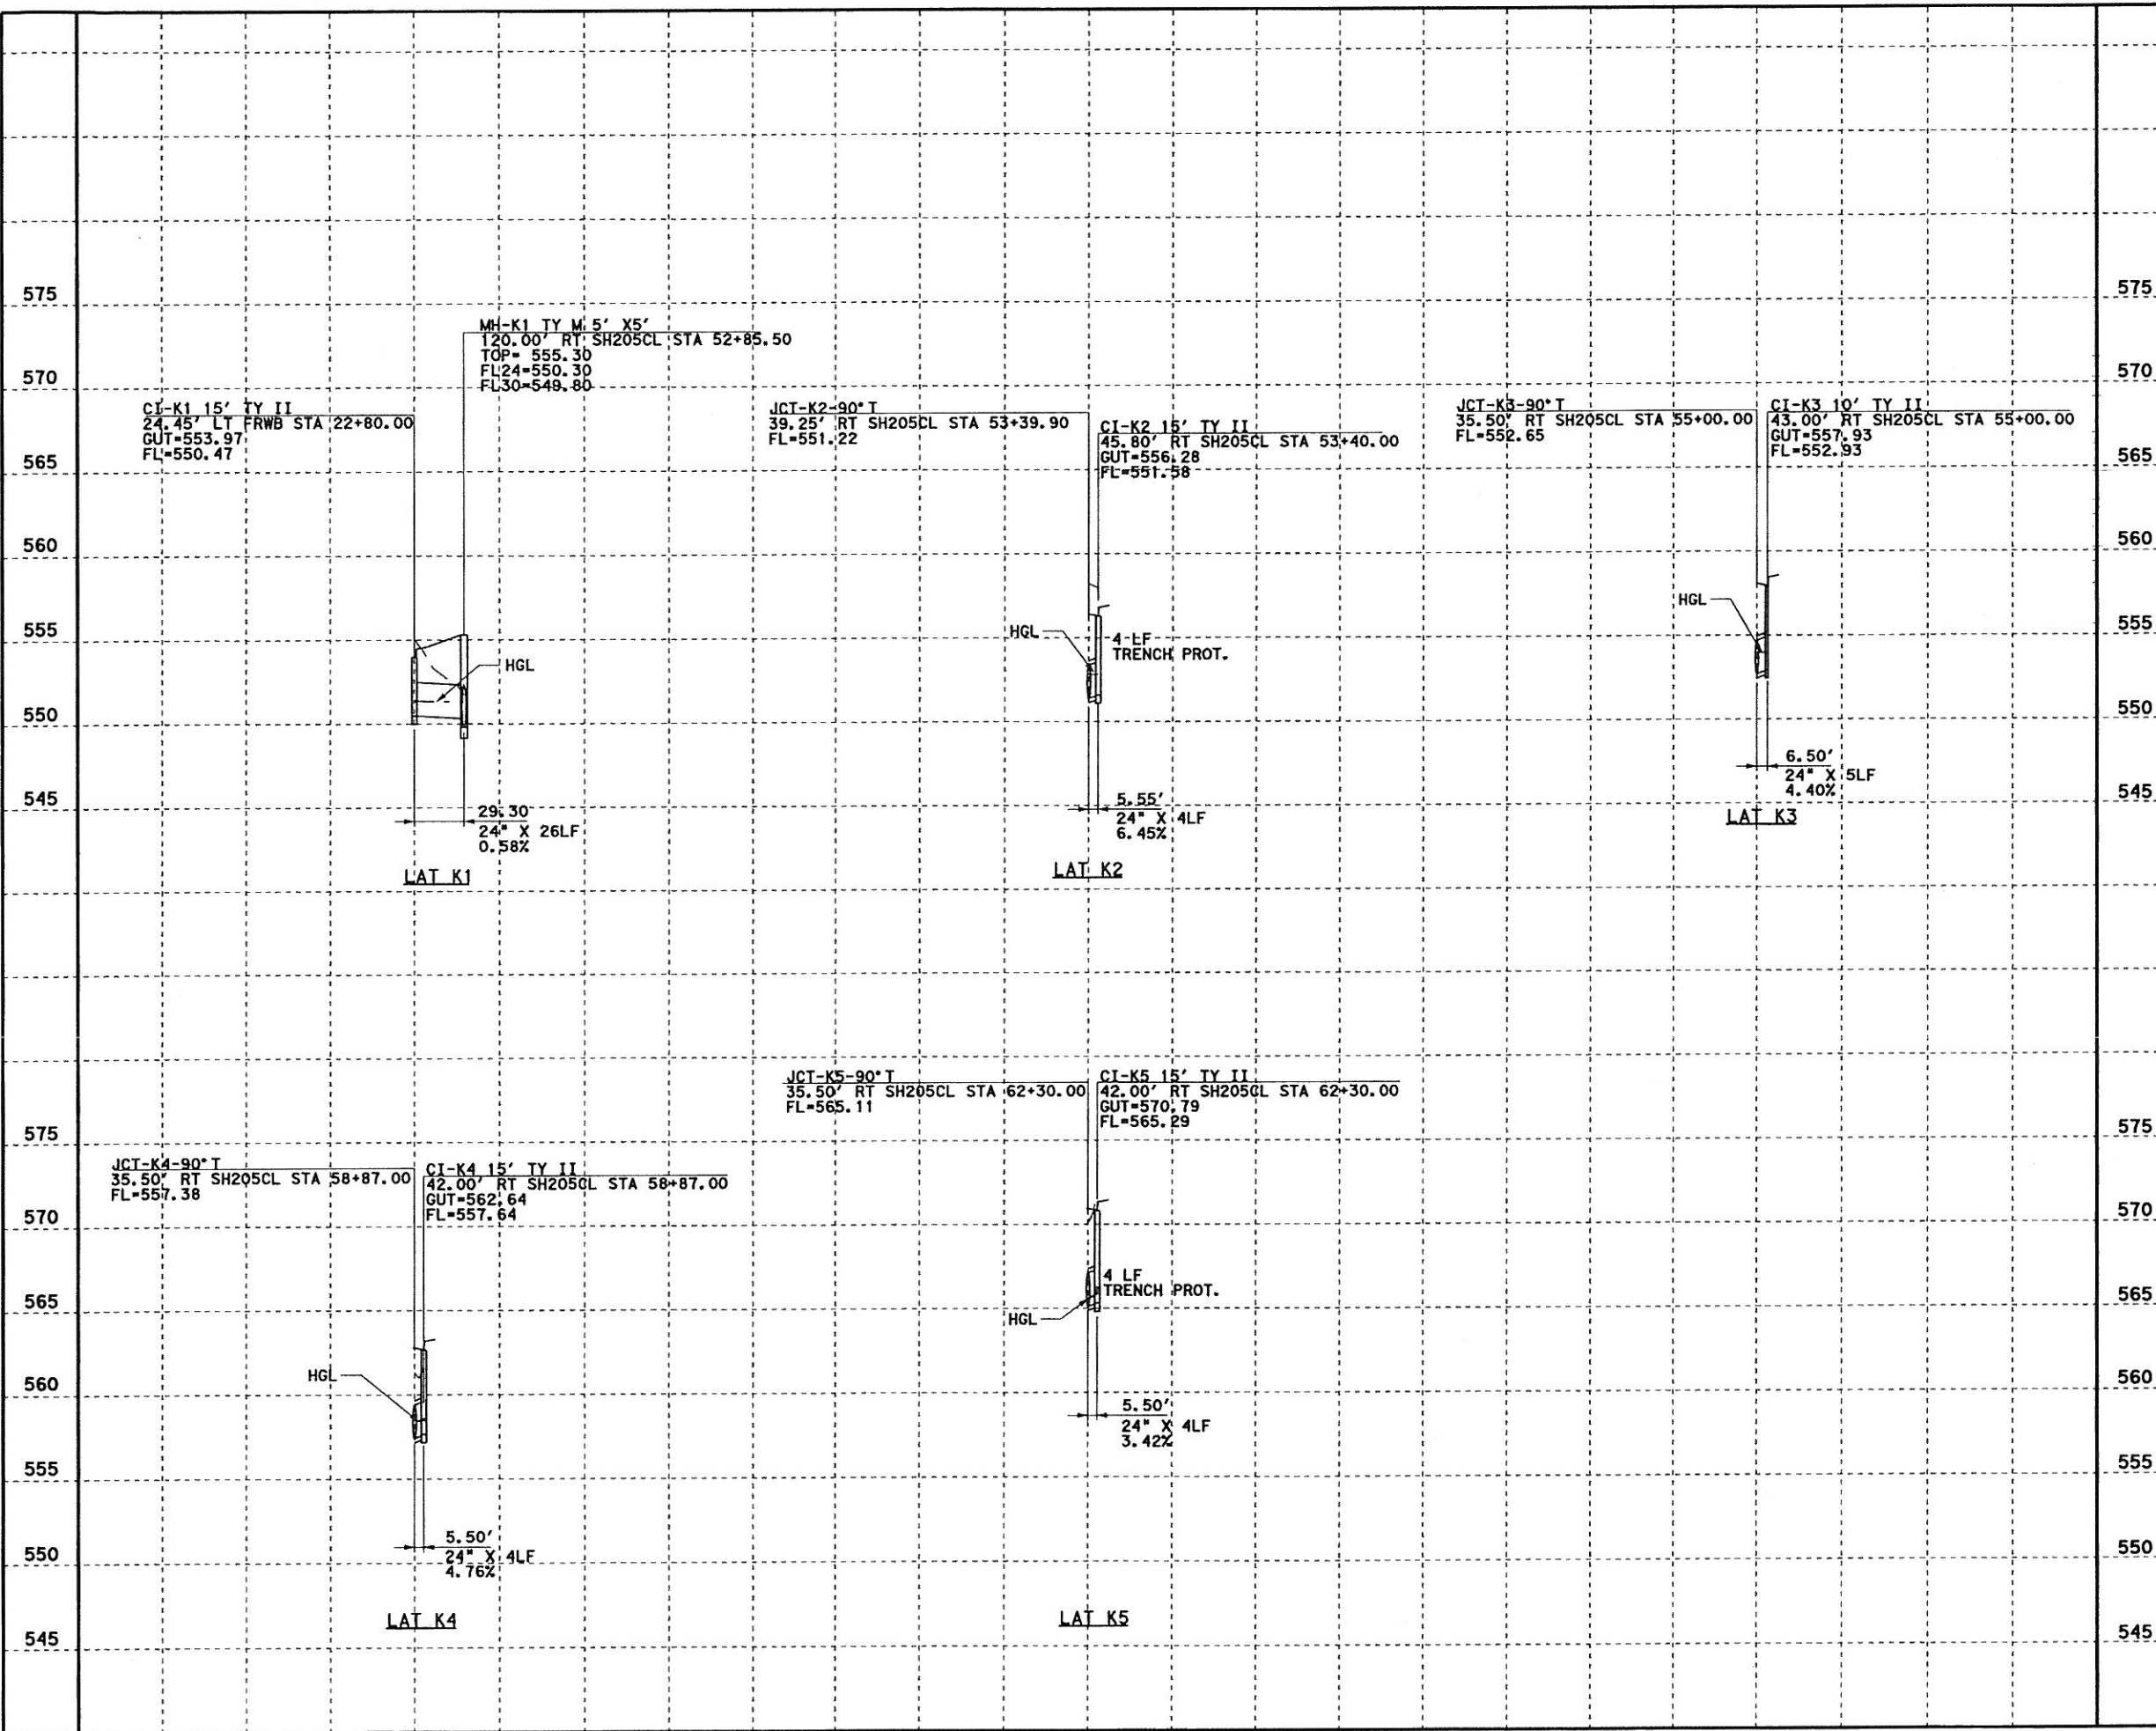

- GENERAL NOTES**
1. CURB INLETS STATION AND OFFSET ARE MEASURED TO THE MIDPOINT OF THE FACE OF MAIN INLET. GRATE INLETS STATION AND OFFSET ARE MEASURED TO THE CENTER OF THE INLET.
 2. JUNCTION BOX STATION AND OFFSET ARE MEASURED TO THE CENTER OF THE JUNCTION BOX.
 3. ALL PIPES ARE CLASS III RCP UNLESS OTHERWISE NOTED.



PB Parsons Brinckerhoff Quade & Douglas, Inc.
 2777 Stemmons Freeway
 Suite 1333
 122 Dallas, TX 75207

Texas Department of Transportation
 © 2006

SH 205



DRAINAGE
LINE K LATERALS

STORM SEWER LATERAL PROFILES

SHEET 47 OF 57

| | | |
|----------|-------------------------|-------------|
| FED. NO. | FEDERAL AID PROJECT NO. | HIGHWAY NO. |
| 6 | (SEE TITLE SHEET) | SH 205 |
| STATE | DIST. | COUNTY |
| TEXAS | DALLAS | ROCKWALL |
| CONT. | SECT. | JOB |
| 0451 | 01 | 032. FTC |

D:\p04\10ba\22451C-SH205\Drawings\2451cddk01a.dwg, ON=1-62, 641
 9/20/2007 Plotted 20-SEP-2007 15:35

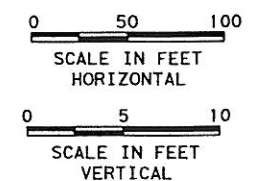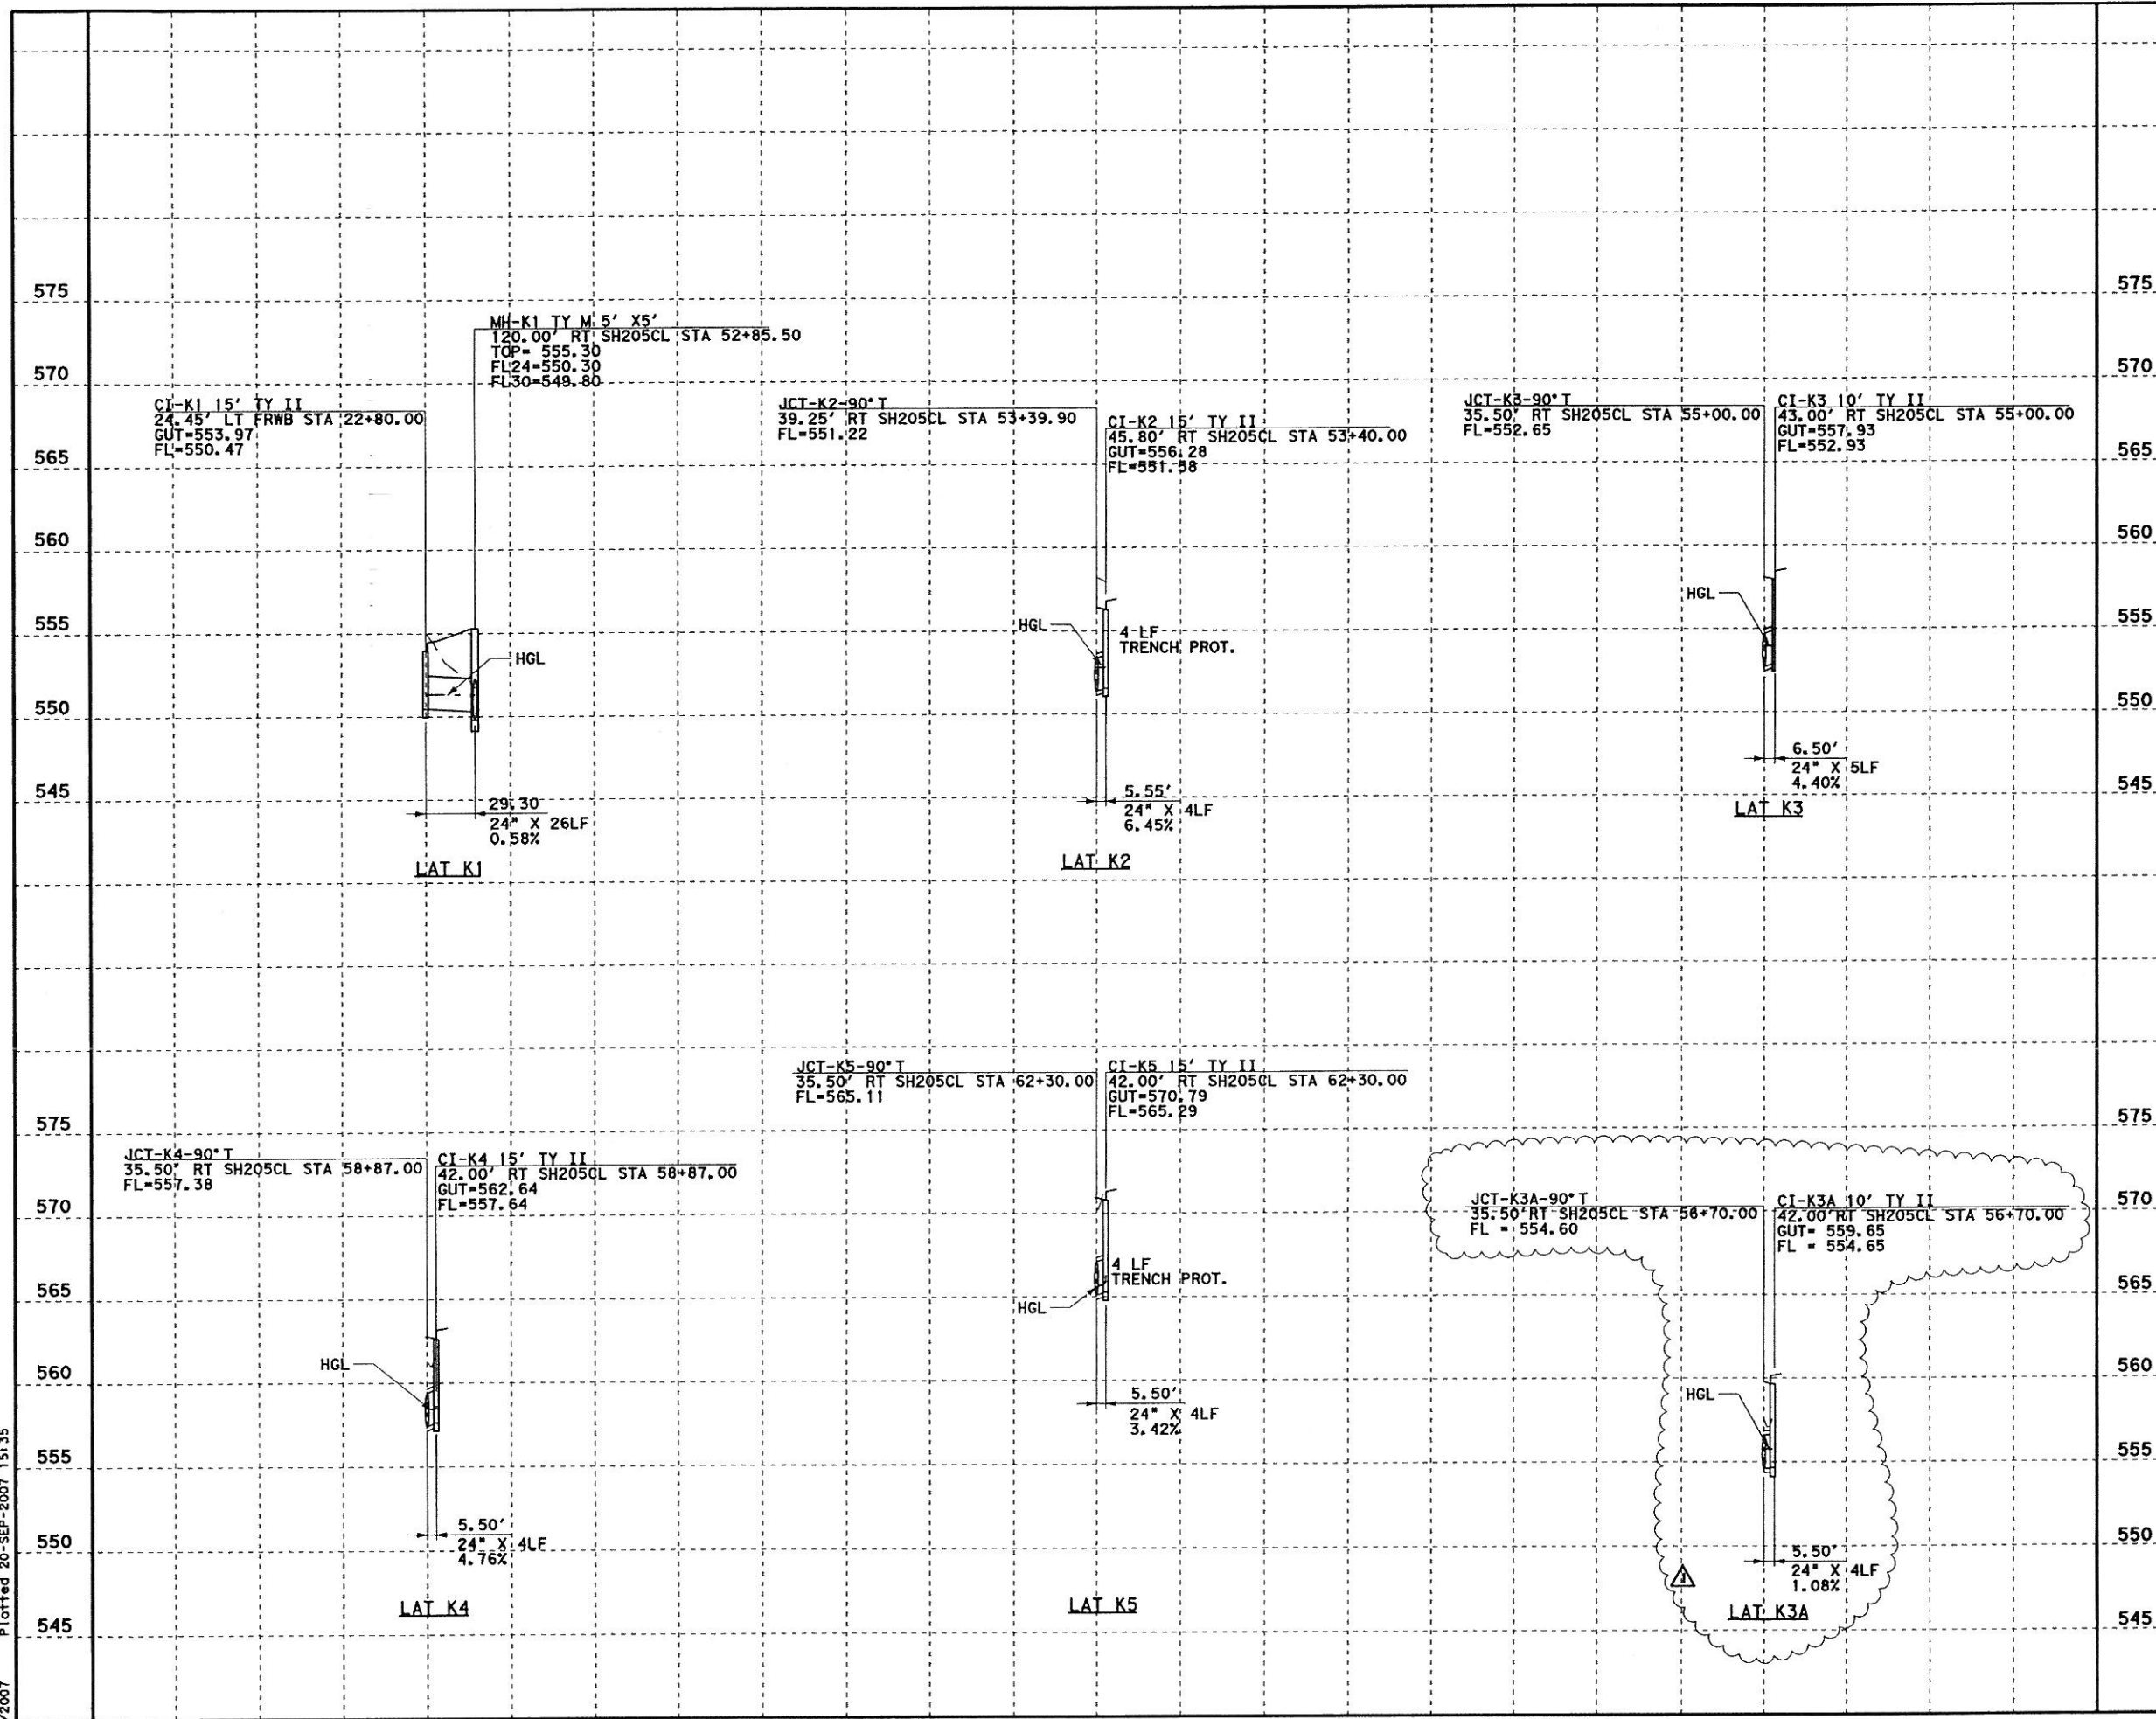

- GENERAL NOTES**
1. CURB INLETS STATION AND OFFSET ARE MEASURED TO THE MIDPOINT OF THE FACE OF MAIN INLET. GRATE INLETS STATION AND OFFSET ARE MEASURED TO THE CENTER OF THE INLET.
 2. JUNCTION BOX STATION AND OFFSET ARE MEASURED TO THE CENTER OF THE JUNCTION BOX.
 3. ALL PIPES ARE CLASS III RCP UNLESS OTHERWISE NOTED.



Added Inlet CI-K3A by KDG -09/20/07

Parsons Brinckerhoff Quade & Douglas, Inc.
 2777 Stemmons Freeway
 Suite 1333
 Dallas, TX 75207



Texas Department of Transportation
 © 2006

SH 205
 DRAINAGE
 LINE K LATERALS
 STORM SEWER LATERAL PROFILES

SHEET 47 OF 57

| | | |
|--------------------|-------------------------|-------------|
| FED. RD. DIST. NO. | FEDERAL AID PROJECT NO. | HIGHWAY NO. |
| 6 | (SEE TITLE SHEET) | SH 205 |
| STATE | DIST. | COUNTY |
| TEXAS | DALLAS | ROCKWALL |
| CONT. | SECT. | JOB |
| 0451 | 01 | 032, ETC |
| SHEET NO. 447A | | |

DGN=GI_085\22451C-SH205\Drawings\2451\addk01b.dgn, ON=10-621
1/10/2008 Plotred 10-JAN-2008 10:19

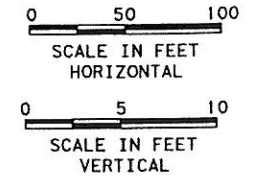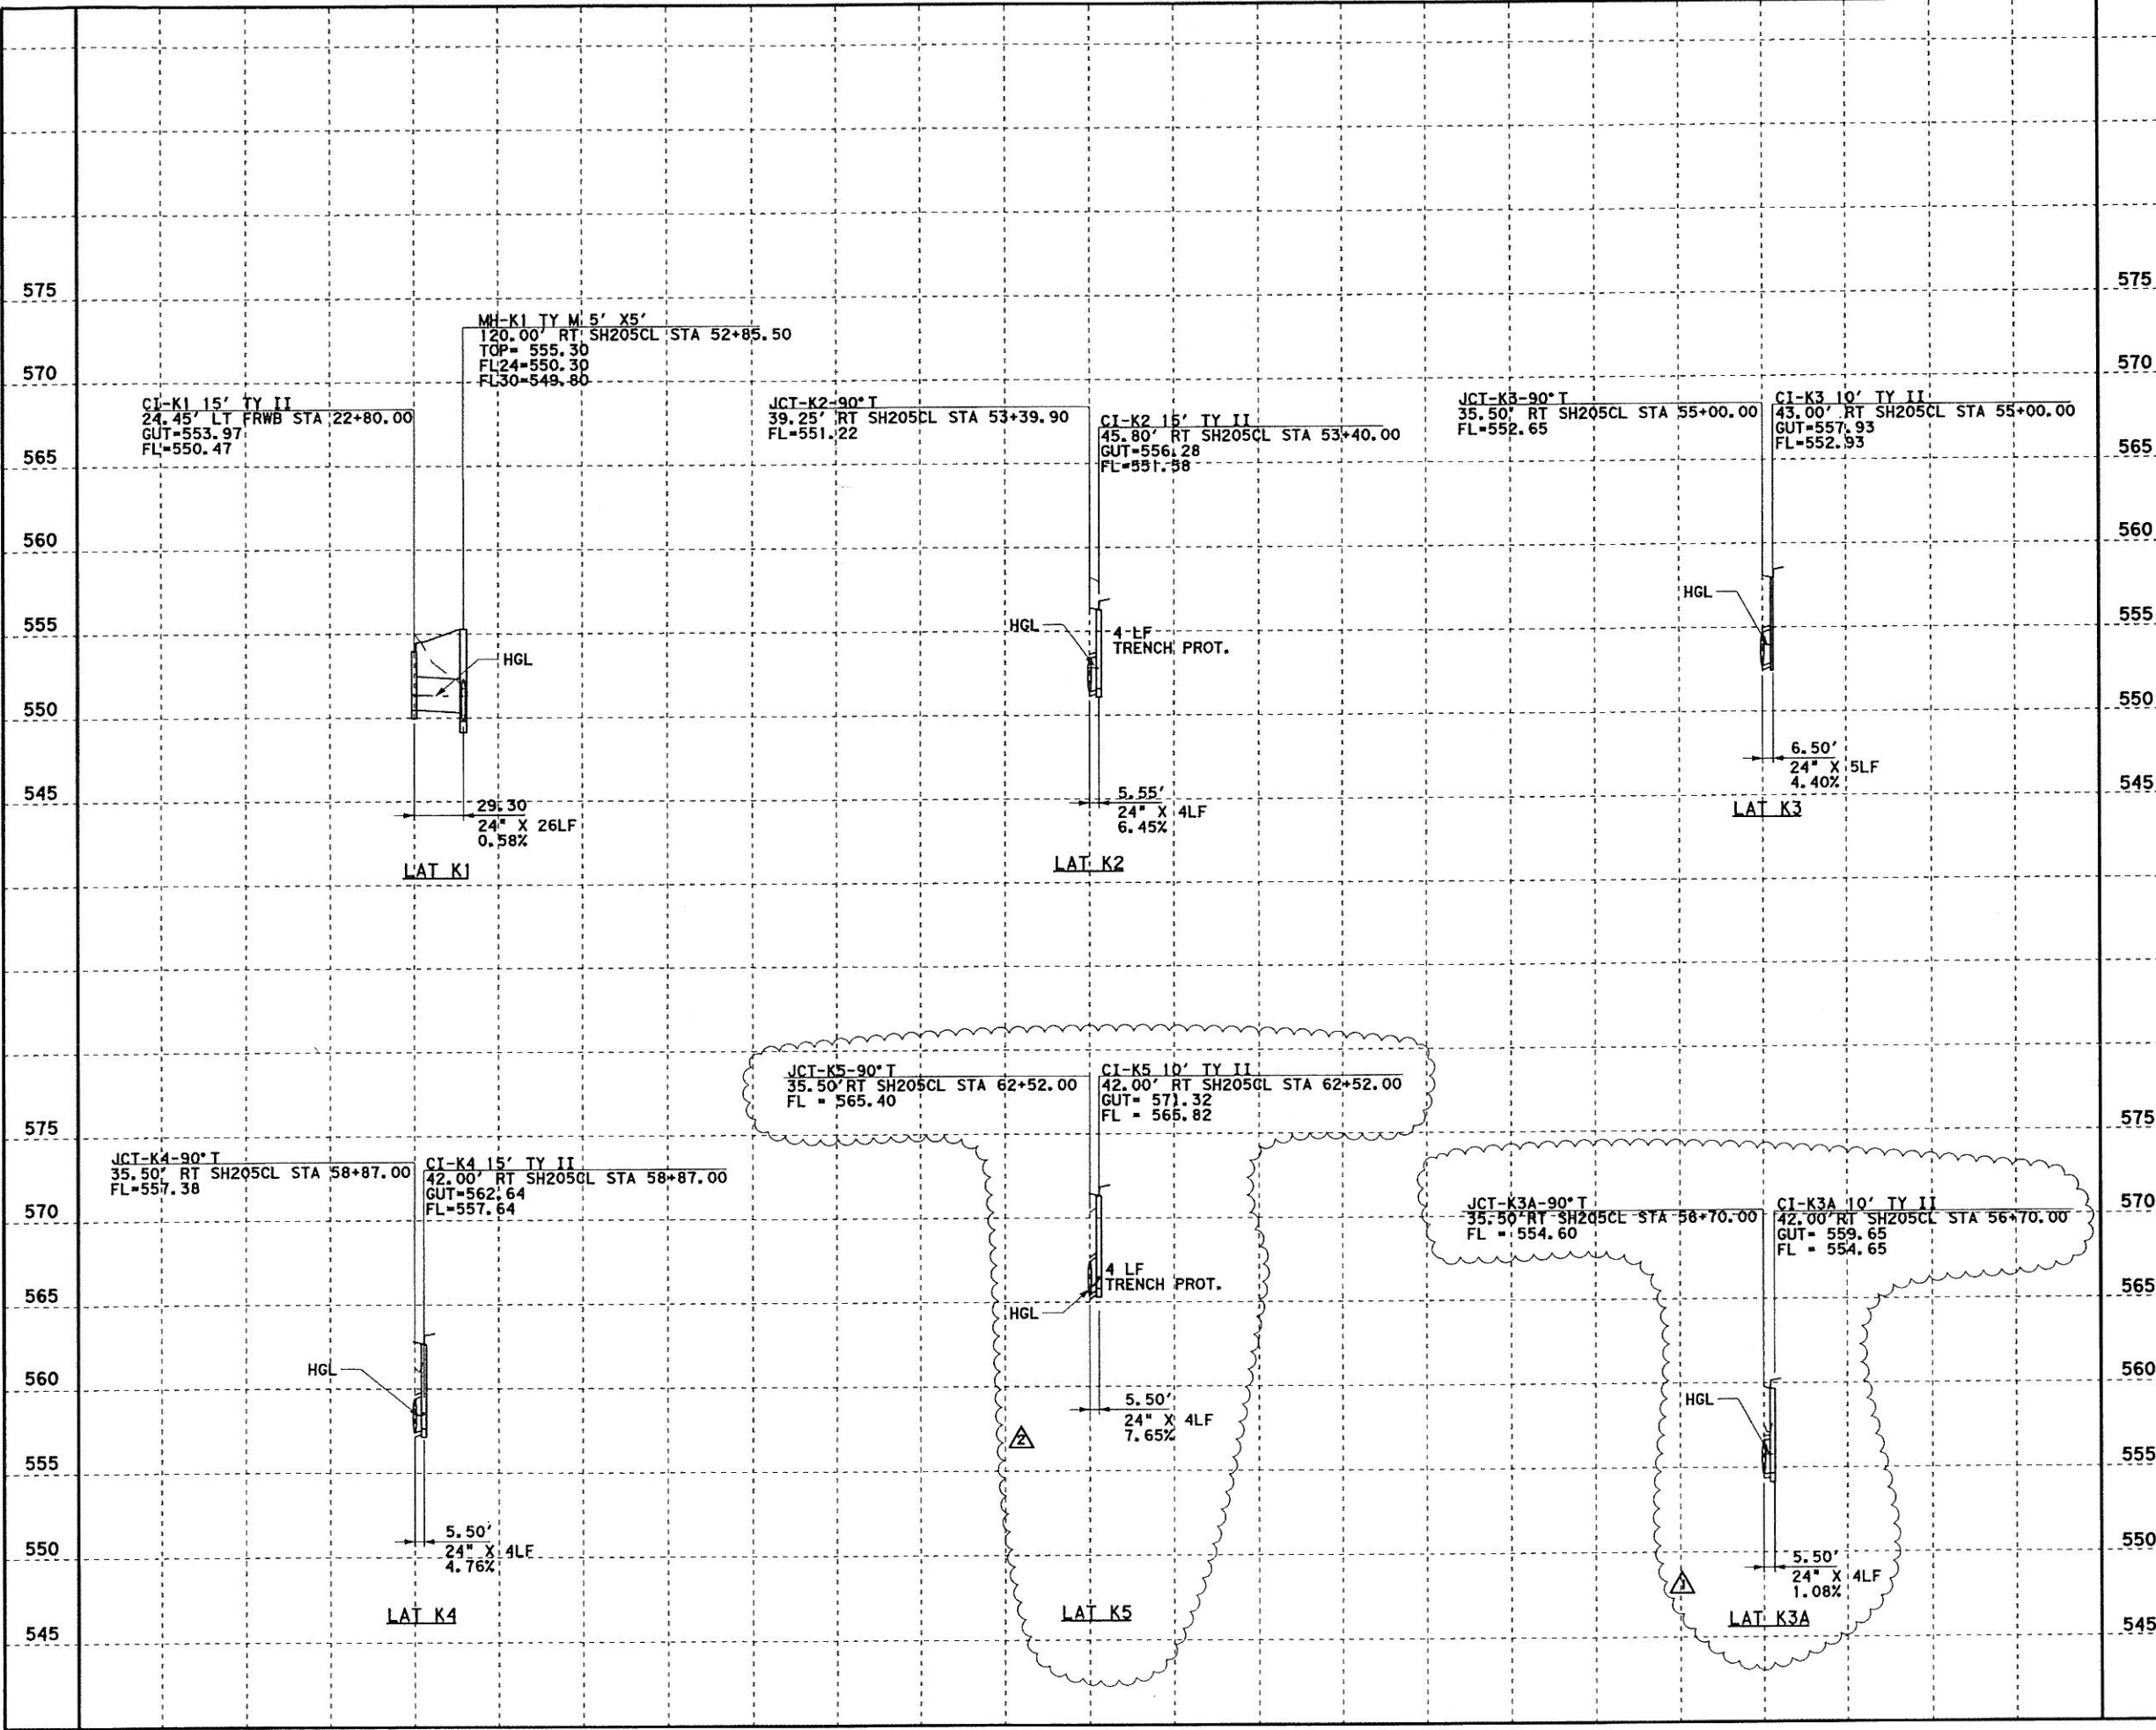

- GENERAL NOTES**
1. CURB INLETS STATION AND OFFSET ARE MEASURED TO THE MIDPOINT OF THE FACE OF MAIN INLET. GRATE INLETS STATION AND OFFSET ARE MEASURED TO THE CENTER OF THE INLET.
 2. JUNCTION BOX STATION AND OFFSET ARE MEASURED TO THE CENTER OF THE JUNCTION BOX.
 3. ALL PIPES ARE CLASS III RCP UNLESS OTHERWISE NOTED.



Added Inlet CI-K3A by KDG -09/20/07
Rev CI-K5 Location by KDG -1/10/08
K. David Gan
1-10-2008

Δ-Change Order #27

PB Parsons Brinckerhoff Quade & Douglas, Inc.
2777 Stemmons Freeway
Suite 1333
Dallas, TX 75207



Texas Department of Transportation
© 2007

SH 205
DRAINAGE
LINE K LATERALS
STORM SEWER LATERAL PROFILES

SHEET 47 OF 57

| | | |
|-------------------|-------------------------|-------------|
| FED. AID DIV. NO. | FEDERAL AID PROJECT NO. | HIGHWAY NO. |
| 6 | (SEE TITLE SHEET) | SH 205 |
| STATE | DIST. | COUNTY |
| TEXAS | DALLAS | ROCKWALL |
| CONT. | SECT. | JOB |
| 0451 | 01 | 032, ETC |
| | | SHEET NO. |
| | | 447B |

D:\NCS\JOBS\22451C-SH205\Drawings\2451cddk01c.dgn, ON=0-621
 3/20/2008 P:\offred 20-MAR-2008 08:32

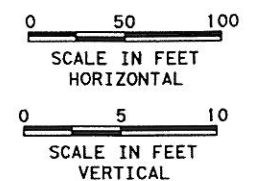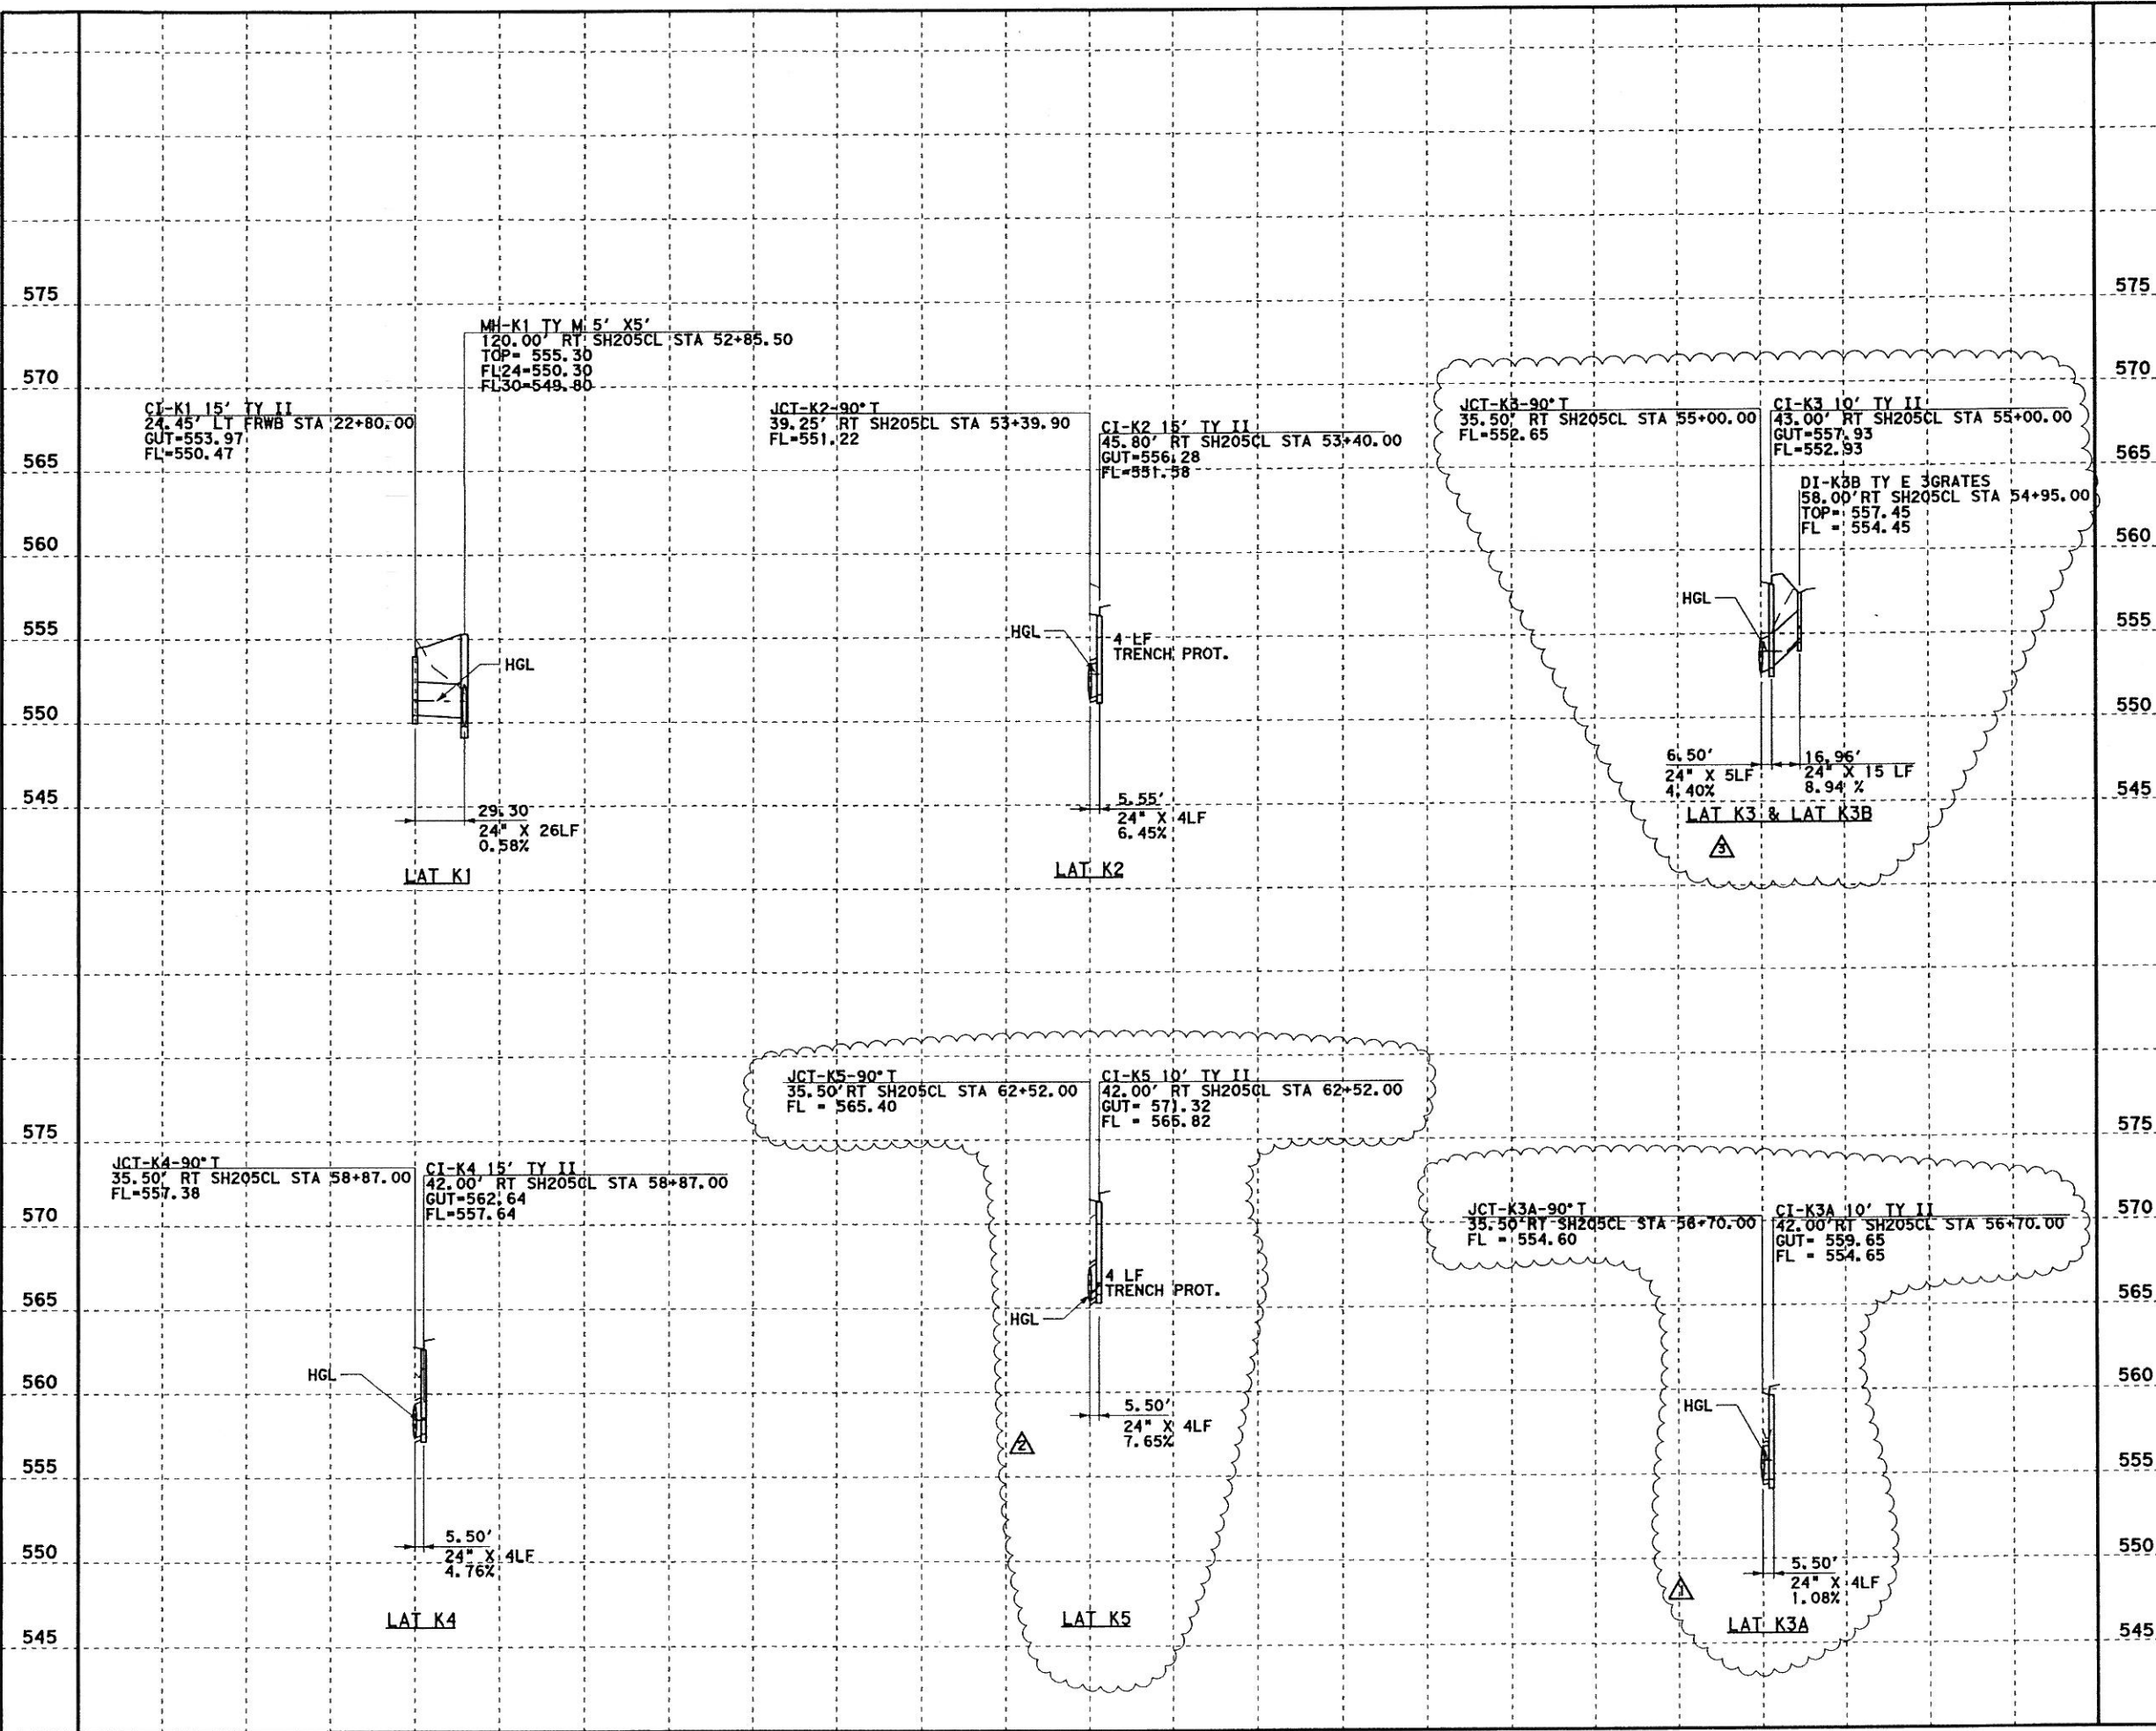

- GENERAL NOTES**
1. CURB INLETS STATION AND OFFSET ARE MEASURED TO THE MIDPOINT OF THE FACE OF MAIN INLET. GRATE INLETS STATION AND OFFSET ARE MEASURED TO THE CENTER OF THE INLET.
 2. JUNCTION BOX STATION AND OFFSET ARE MEASURED TO THE CENTER OF THE JUNCTION BOX.
 3. ALL PIPES ARE CLASS III RCP UNLESS OTHERWISE NOTED.



- ▲ Added Inlet CI-K3A by KDG -09/20/07
- ▲ Rev CI-K5 Location by KDG -1/10/08
- ▲ Added Inlet DI-K3B by KDG -03/19/08



PB Parsons Brinckerhoff Quade & Douglas, Inc.
 2777 Stemmons Freeway
 Suite 1333
 Dallas, TX 75207

Texas Department of Transportation
 © 2008

SH 205
 DRAINAGE
 LINE K LATERALS
 STORM SEWER LATERAL PROFILES


SHEET 47 OF 57

| | | |
|--------------------|-------------------------|-------------|
| FED. AID DIST. NO. | FEDERAL AID PROJECT NO. | HIGHWAY NO. |
| 6 | (SEE TITLE SHEET) | SH 205 |
| STATE | DIST. | COUNTY |
| TEXAS | DALLAS | ROCKWALL |
| CENT. | SECT. | JOB |
| 0451 | 01 | 032, ETC |
| | | SHEET NO. |
| | | 447C |

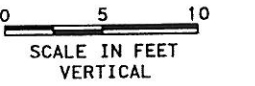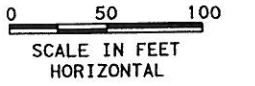

GENERAL NOTES

1. CURB INLETS STATION AND OFFSET ARE MEASURED TO THE MIDPOINT OF THE FACE OF MAIN INLET. GRATE INLETS STATION AND OFFSET ARE MEASURED TO THE CENTER OF THE INLET.
2. JUNCTION BOX STATION AND OFFSET ARE MEASURED TO THE CENTER OF THE JUNCTION BOX.
3. ALL PIPES ARE CLASS III RCP UNLESS OTHERWISE NOTED.

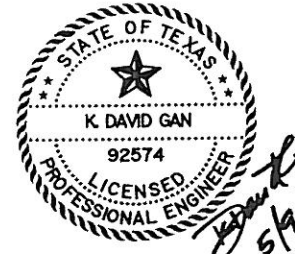

PR Parsons Brinckerhoff Quade & Douglas, Inc.
2777 Stemmons Freeway
Suite 1333
Dallas, TX 75207

Texas Department of Transportation
© 2006

SH 205


**DRAINAGE
LINE L LATERALS
STORM SEWER LATERAL PROFILES**




SHEET 48 OF 57

| | | |
|----------------|-------------------------|-------------|
| FED. DIST. NO. | FEDERAL AID PROJECT NO. | HIGHWAY NO. |
| 6 | (SEE TITLE SHEET) | SH 205 |
| STATE | DIST. | COUNTY |
| TEXAS | DALLAS | ROCKWALL |
| CONT. | SECT. | JOB |
| 0451 | 01 | 032, ETC |

448

DGN=C:\JOBS\22451C-SH205\Drawings\2451\cadd\01.dgn, ON=10-62J
 5/9/2006 Plotted 09-MAY-2006 12:59

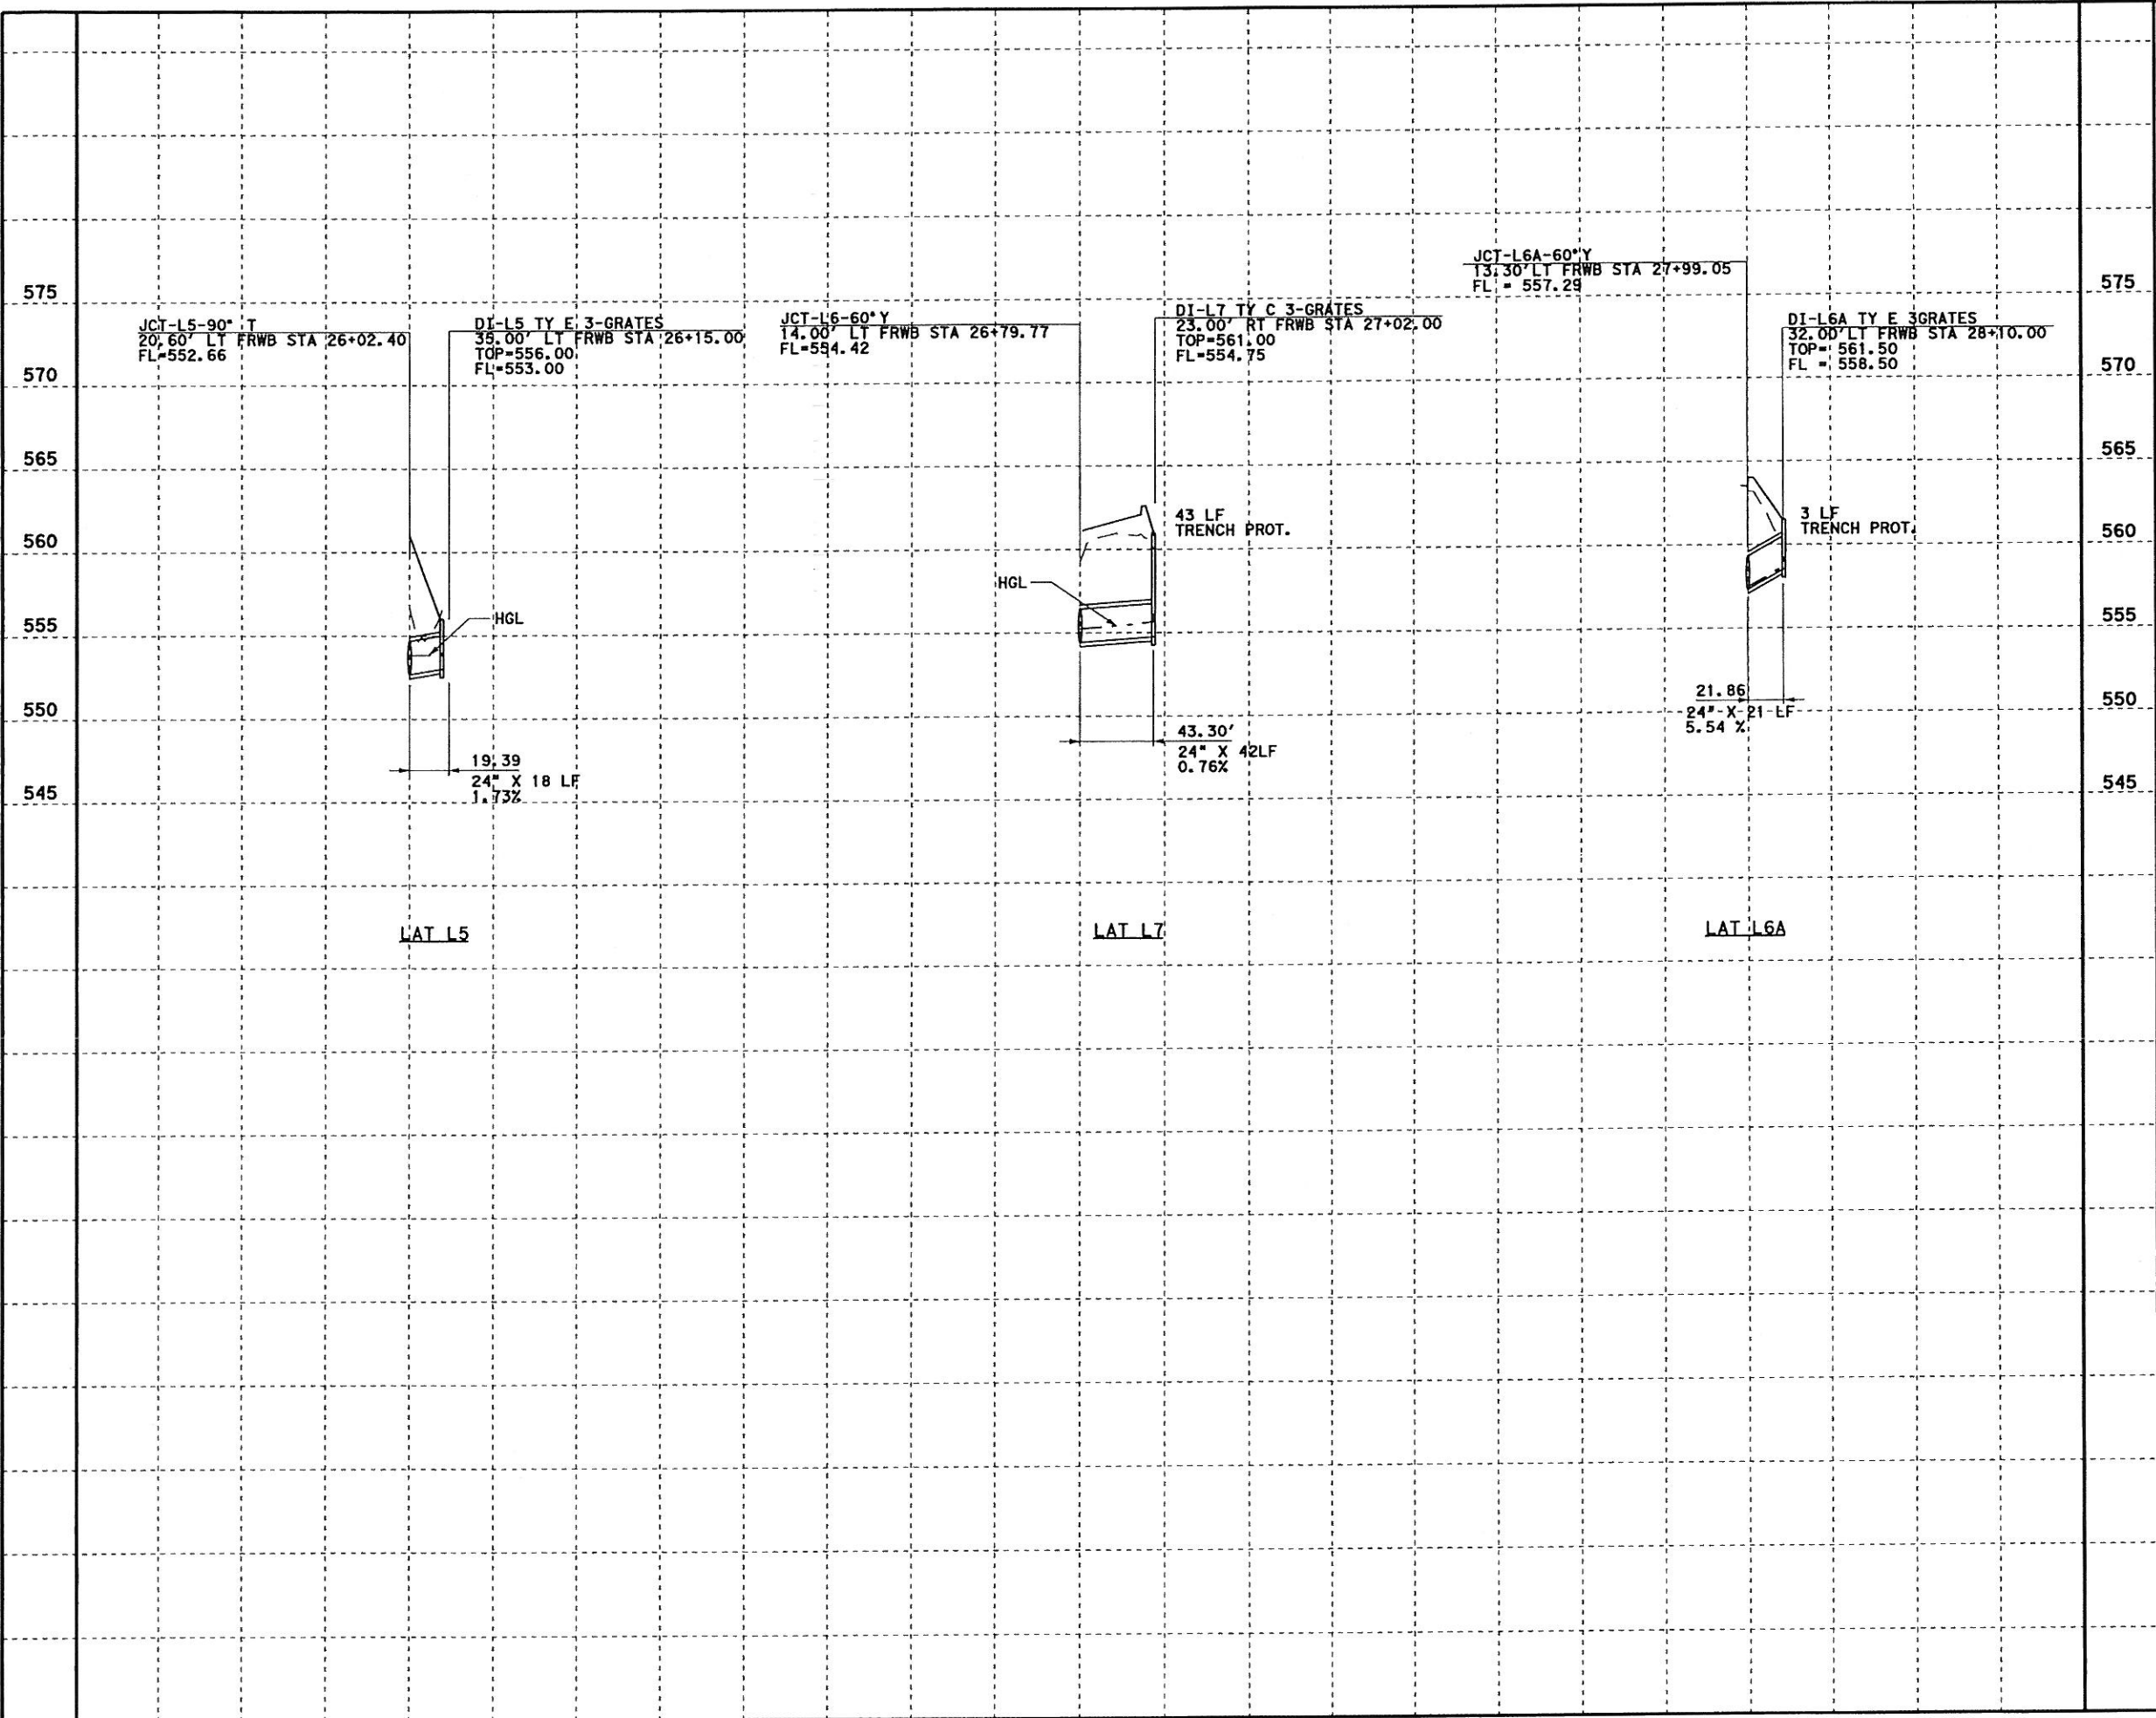

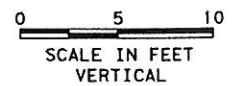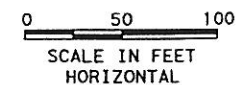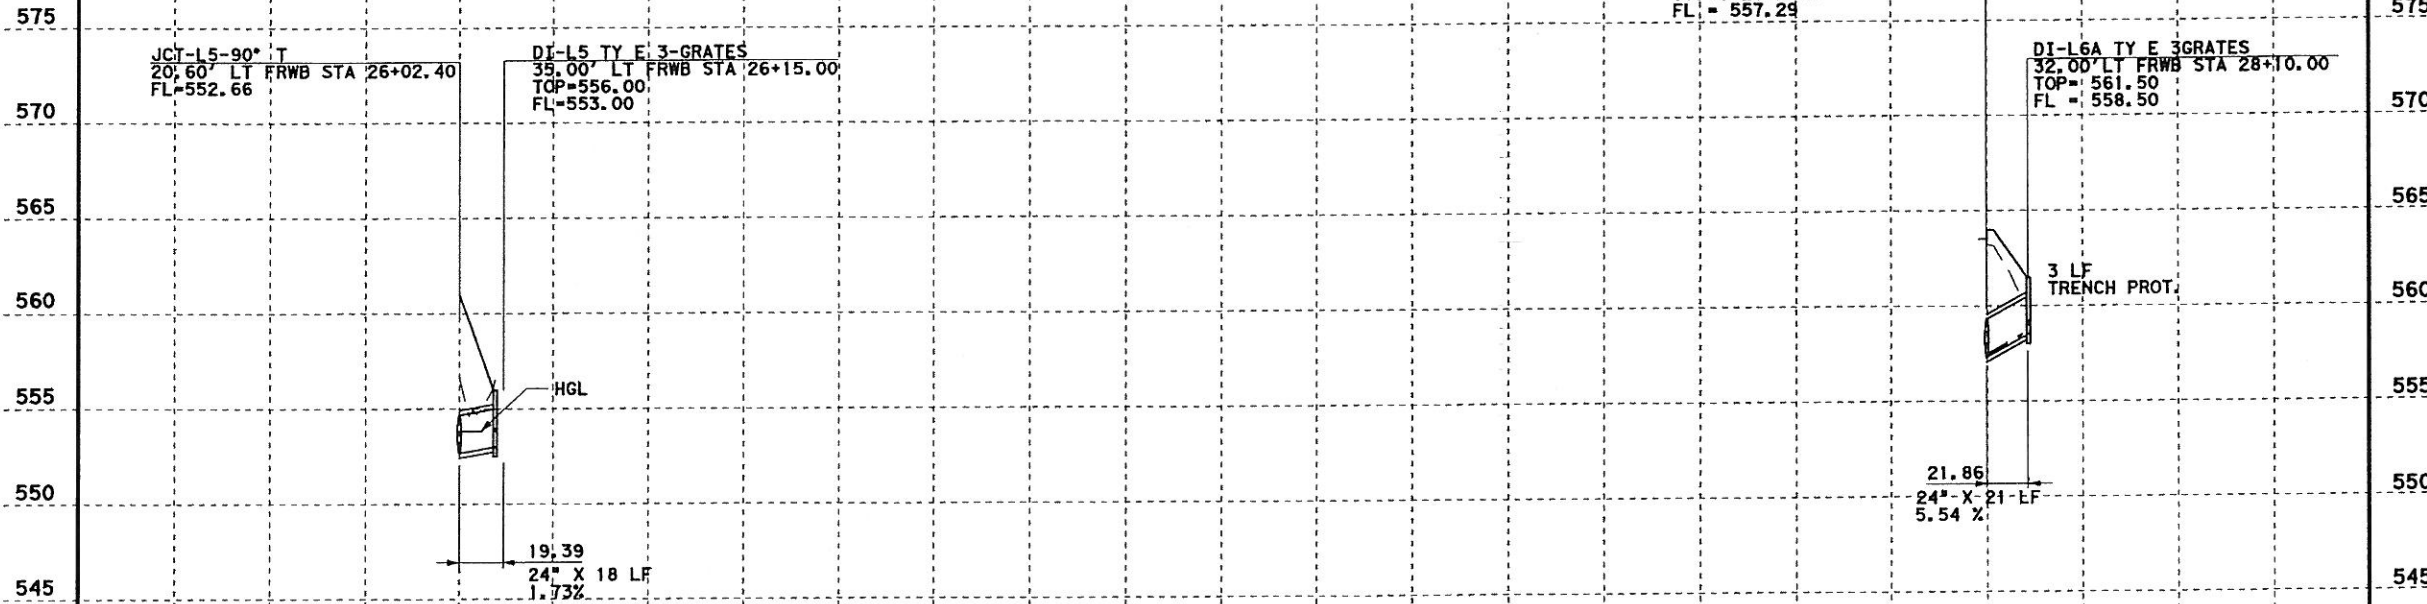

GENERAL NOTES

1. CURB INLETS STATION AND OFFSET ARE MEASURED TO THE MIDPOINT OF THE FACE OF MAIN INLET. GRATE INLETS STATION AND OFFSET ARE MEASURED TO THE CENTER OF THE INLET.
2. JUNCTION BOX STATION AND OFFSET ARE MEASURED TO THE CENTER OF THE JUNCTION BOX.
3. ALL PIPES ARE CLASS III RCP UNLESS OTHERWISE NOTED.



Change Order 55

7/15/08 ADD LAT-L8 & DI-L8 BY KDG

Parsons Brinckerhoff Quade & Douglas, Inc.
2777 Stemmons Freeway
Suite 1333
Dallas, TX 75207

Texas Department of Transportation
© 2008

SH 205

**DRAINAGE
LINE L LATERALS
STORM SEWER LATERAL PROFILES**



SHEET 48 OF 57

| | | |
|-------------------|-------------------------|-------------|
| FED. RD. DIV. NO. | FEDERAL AID PROJECT NO. | HIGHWAY NO. |
| 6 | (SEE TITLE SHEET) | SH 205 |
| STATE | DIST. | COUNTY |
| TEXAS | DALLAS | ROCKWALL |
| CONT. | SECT. | JOB |
| 0451 | 01 | 032, ETC |


DGN:G:\JOBS\22451C-SH205\Drawings\2451cdd1.dgn, ON+[-0-62]
 7/15/2008 Plotted 15-JUL-2008 2:11:28

LAT L7

DGN=C:\JOBS\22451C-SH205\Drawings\2451addm01.dgn, ON=10-823
 5/9/2006 Plotted 09-MAY-2006 13:00

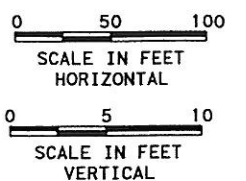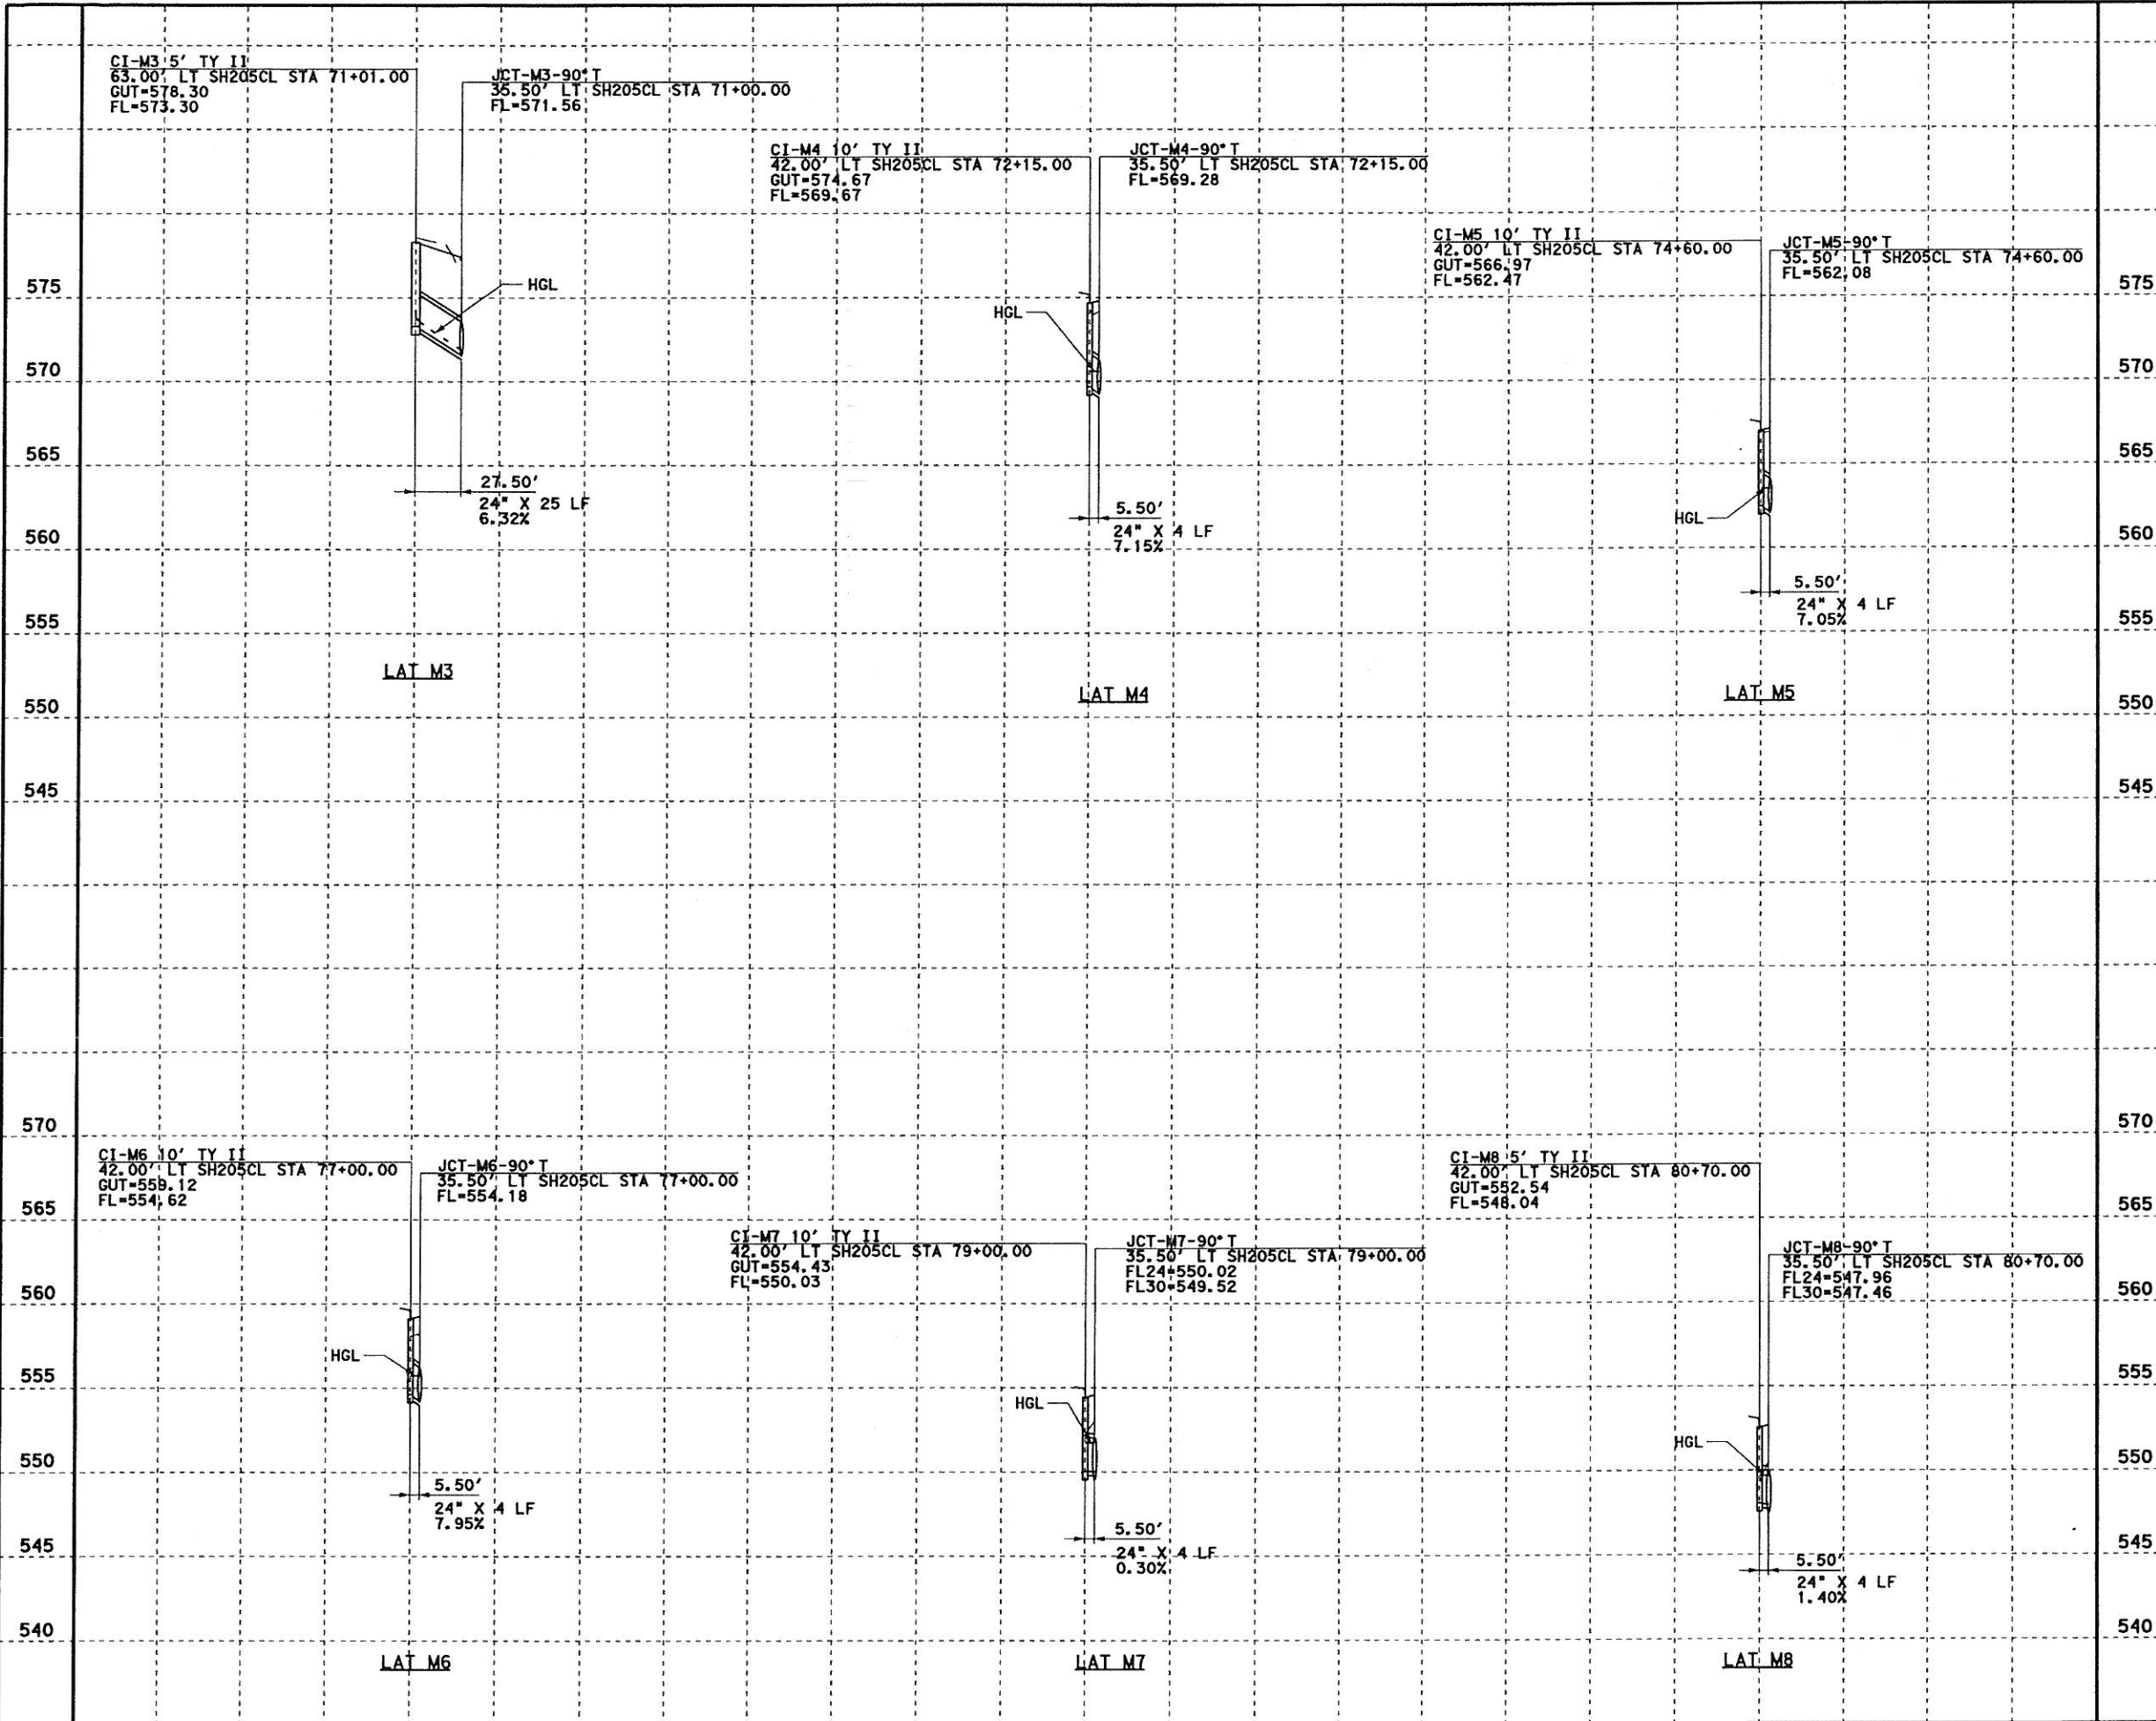

- GENERAL NOTES**
1. CURB INLETS STATION AND OFFSET ARE MEASURED TO THE MIDPOINT OF THE FACE OF MAIN INLET. GRATE INLETS STATION AND OFFSET ARE MEASURED TO THE CENTER OF THE INLET.
 2. JUNCTION BOX STATION AND OFFSET ARE MEASURED TO THE CENTER OF THE JUNCTION BOX.
 3. ALL PIPES ARE CLASS III RCP UNLESS OTHERWISE NOTED.

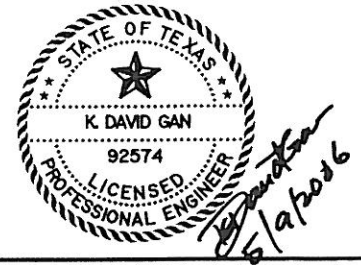

Parsons Brinckerhoff Quade & Douglas, Inc.
 2777 Stemmons Freeway
 Suite 1333
 Dallas, TX 75207

Texas Department of Transportation
 © 2006



SH 205

DRAINAGE
LINE M LATERALS
STORM SEWER LATERAL PROFILES


SHEET 49 OF 57

| | | | |
|----------------|-------------------------|-------------|-----------|
| FED. PROJ. NO. | FEDERAL AID PROJECT NO. | HIGHWAY NO. | SHEET NO. |
| 6 | (SEE TITLE SHEET) | SH 205 | 449 |
| STATE | DIST. | COUNTY | |
| TEXAS | DALLAS | ROCKWALL | |
| CONT. | SECT. | JOB | |
| 0451 | 01 | 032, ETC | |

DGN=GI_1085122451C-SH205\Drawings\2451\add001.dgn, ON=10-623
 5/9/2006 Plotted 09-MAY-2006 13:00

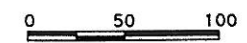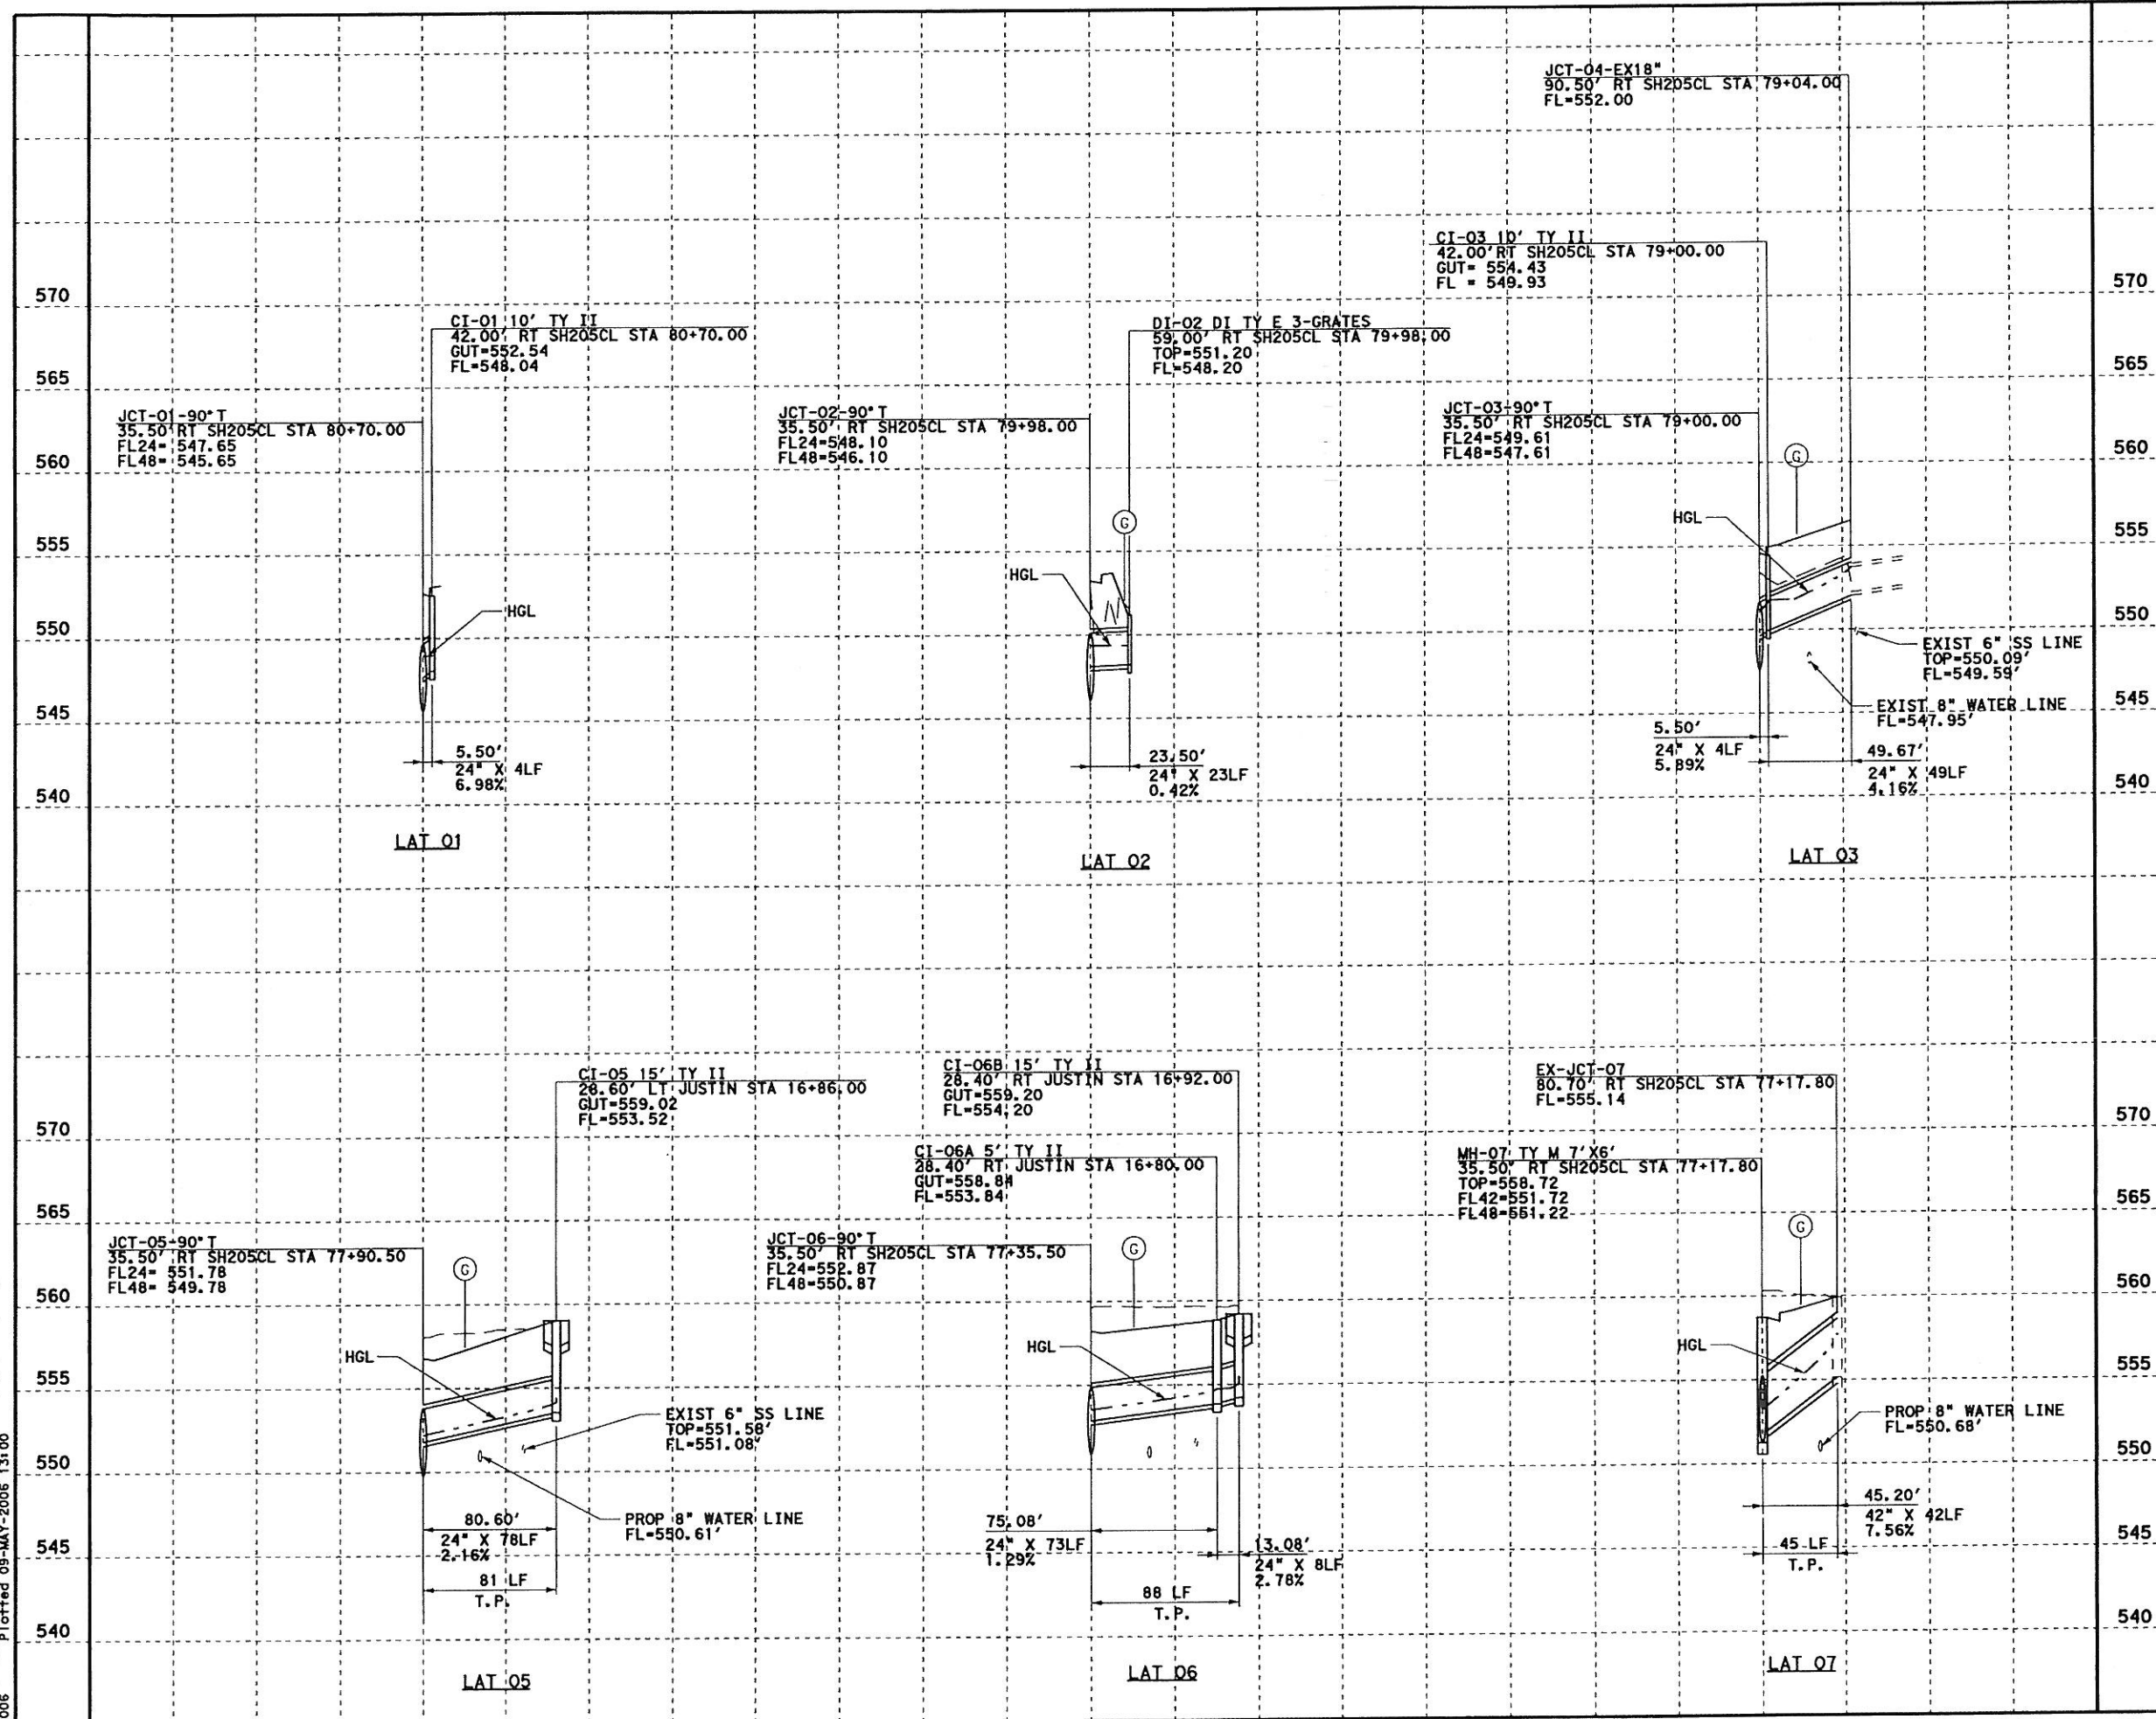

SCALE IN FEET
HORIZONTAL

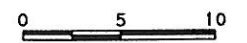

SCALE IN FEET
VERTICAL

GENERAL NOTES

1. CURB INLETS STATION AND OFFSET ARE MEASURED TO THE MIDPOINT OF THE FACE OF MAIN INLET. GRATE INLETS STATION AND OFFSET ARE MEASURED TO THE CENTER OF THE INLET.
2. JUNCTION BOX STATION AND OFFSET ARE MEASURED TO THE CENTER OF THE JUNCTION BOX.
3. ALL PIPES ARE CLASS III RCP UNLESS OTHERWISE NOTED.

LEGENDS

- (G) EX. GAS LINE CROSSING
ELEVATION UNKNOWN
- (T) EX. SW BELL CABLE CROSSING
ELEVATION UNKNOWN



PR Parsons Brinckerhoff Quade & Douglas, Inc.
2777 Stemmons Freeway
Suite 1333
122 Dallas, TX 75207

Texas Department of Transportation
© 2006

SH 205

DRAINAGE
LINE & LATERALS
STORM SEWER LATERAL PROFILES

SHEET 50 OF 57

| | | |
|--------------------|-------------------------|-------------|
| FED. RD. DIST. NO. | FEDERAL AID PROJECT NO. | HIGHWAY NO. |
| 6 | (SEE TITLE SHEET) | SH 205 |
| STATE | DIST. | COUNTY |
| TEXAS | DALLAS | ROCKWALL |
| CONT. | SECT. | JOB |
| 0451 | 01 | 032, ETC |