

GENERAL NOTES

1. CURB INLETS STATION AND OFFSET ARE MEASURED TO THE MIDPOINT OF THE FACE OF MAIN INLET. GRATE INLETS STATION AND OFFSET ARE MEASURED TO THE CENTER OF THE INLET.
2. JUNCTION BOX STATION AND OFFSET ARE MEASURED TO THE CENTER OF THE JUNCTION BOX.
3. ALL PIPES ARE CLASS III RCP UNLESS OTHERWISE NOTED.



5/9/2006

PB Parsons Brinckerhoff Quade & Douglas, Inc.
2777 Stemmons Freeway
Suite 1333
Dallas, TX 75207

T Texas Department of Transportation
© 2006

SH 205

DRAINAGE
LINE 0 LATERALS
STORM SEWER LATERAL PROFILES


SHEET 51 OF 57

FEDERAL AID PROJECT NO.		HIGHWAY NO.	
6 (SEE TITLE SHEET)		SH 205	
STATE	DIST.	COUNTY	SHEET NO.
TEXAS	DALLAS	ROCKWALL	451
CONT.	SECT.	JOB	
0451	01	032, ETC	

535
570
565
560
555
550
545

JCT-08-90° T
35.50' RT SH205CL STA 77+00.00
FL=553.82



CI-08 10' TY III
42.00' RT SH205CL STA 77+00.00
GUT=559.12
FL=554.12

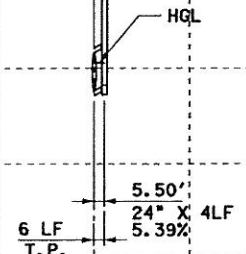

LAT 08

DGN=C:\JOBS\22451C-SH205\Drawings\2451\sd002.dgn, ON=10-62
5/9/2006 P:leffed 09-MAY-2006 13:00

DGN:G:\JOBS\22451C-SH205\Drawings\2451cd\dwg\01.dgn, ON=10-621
 5/9/2006 P1:ptf:ed 09-MAY-2006 13:00

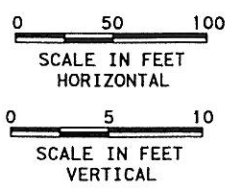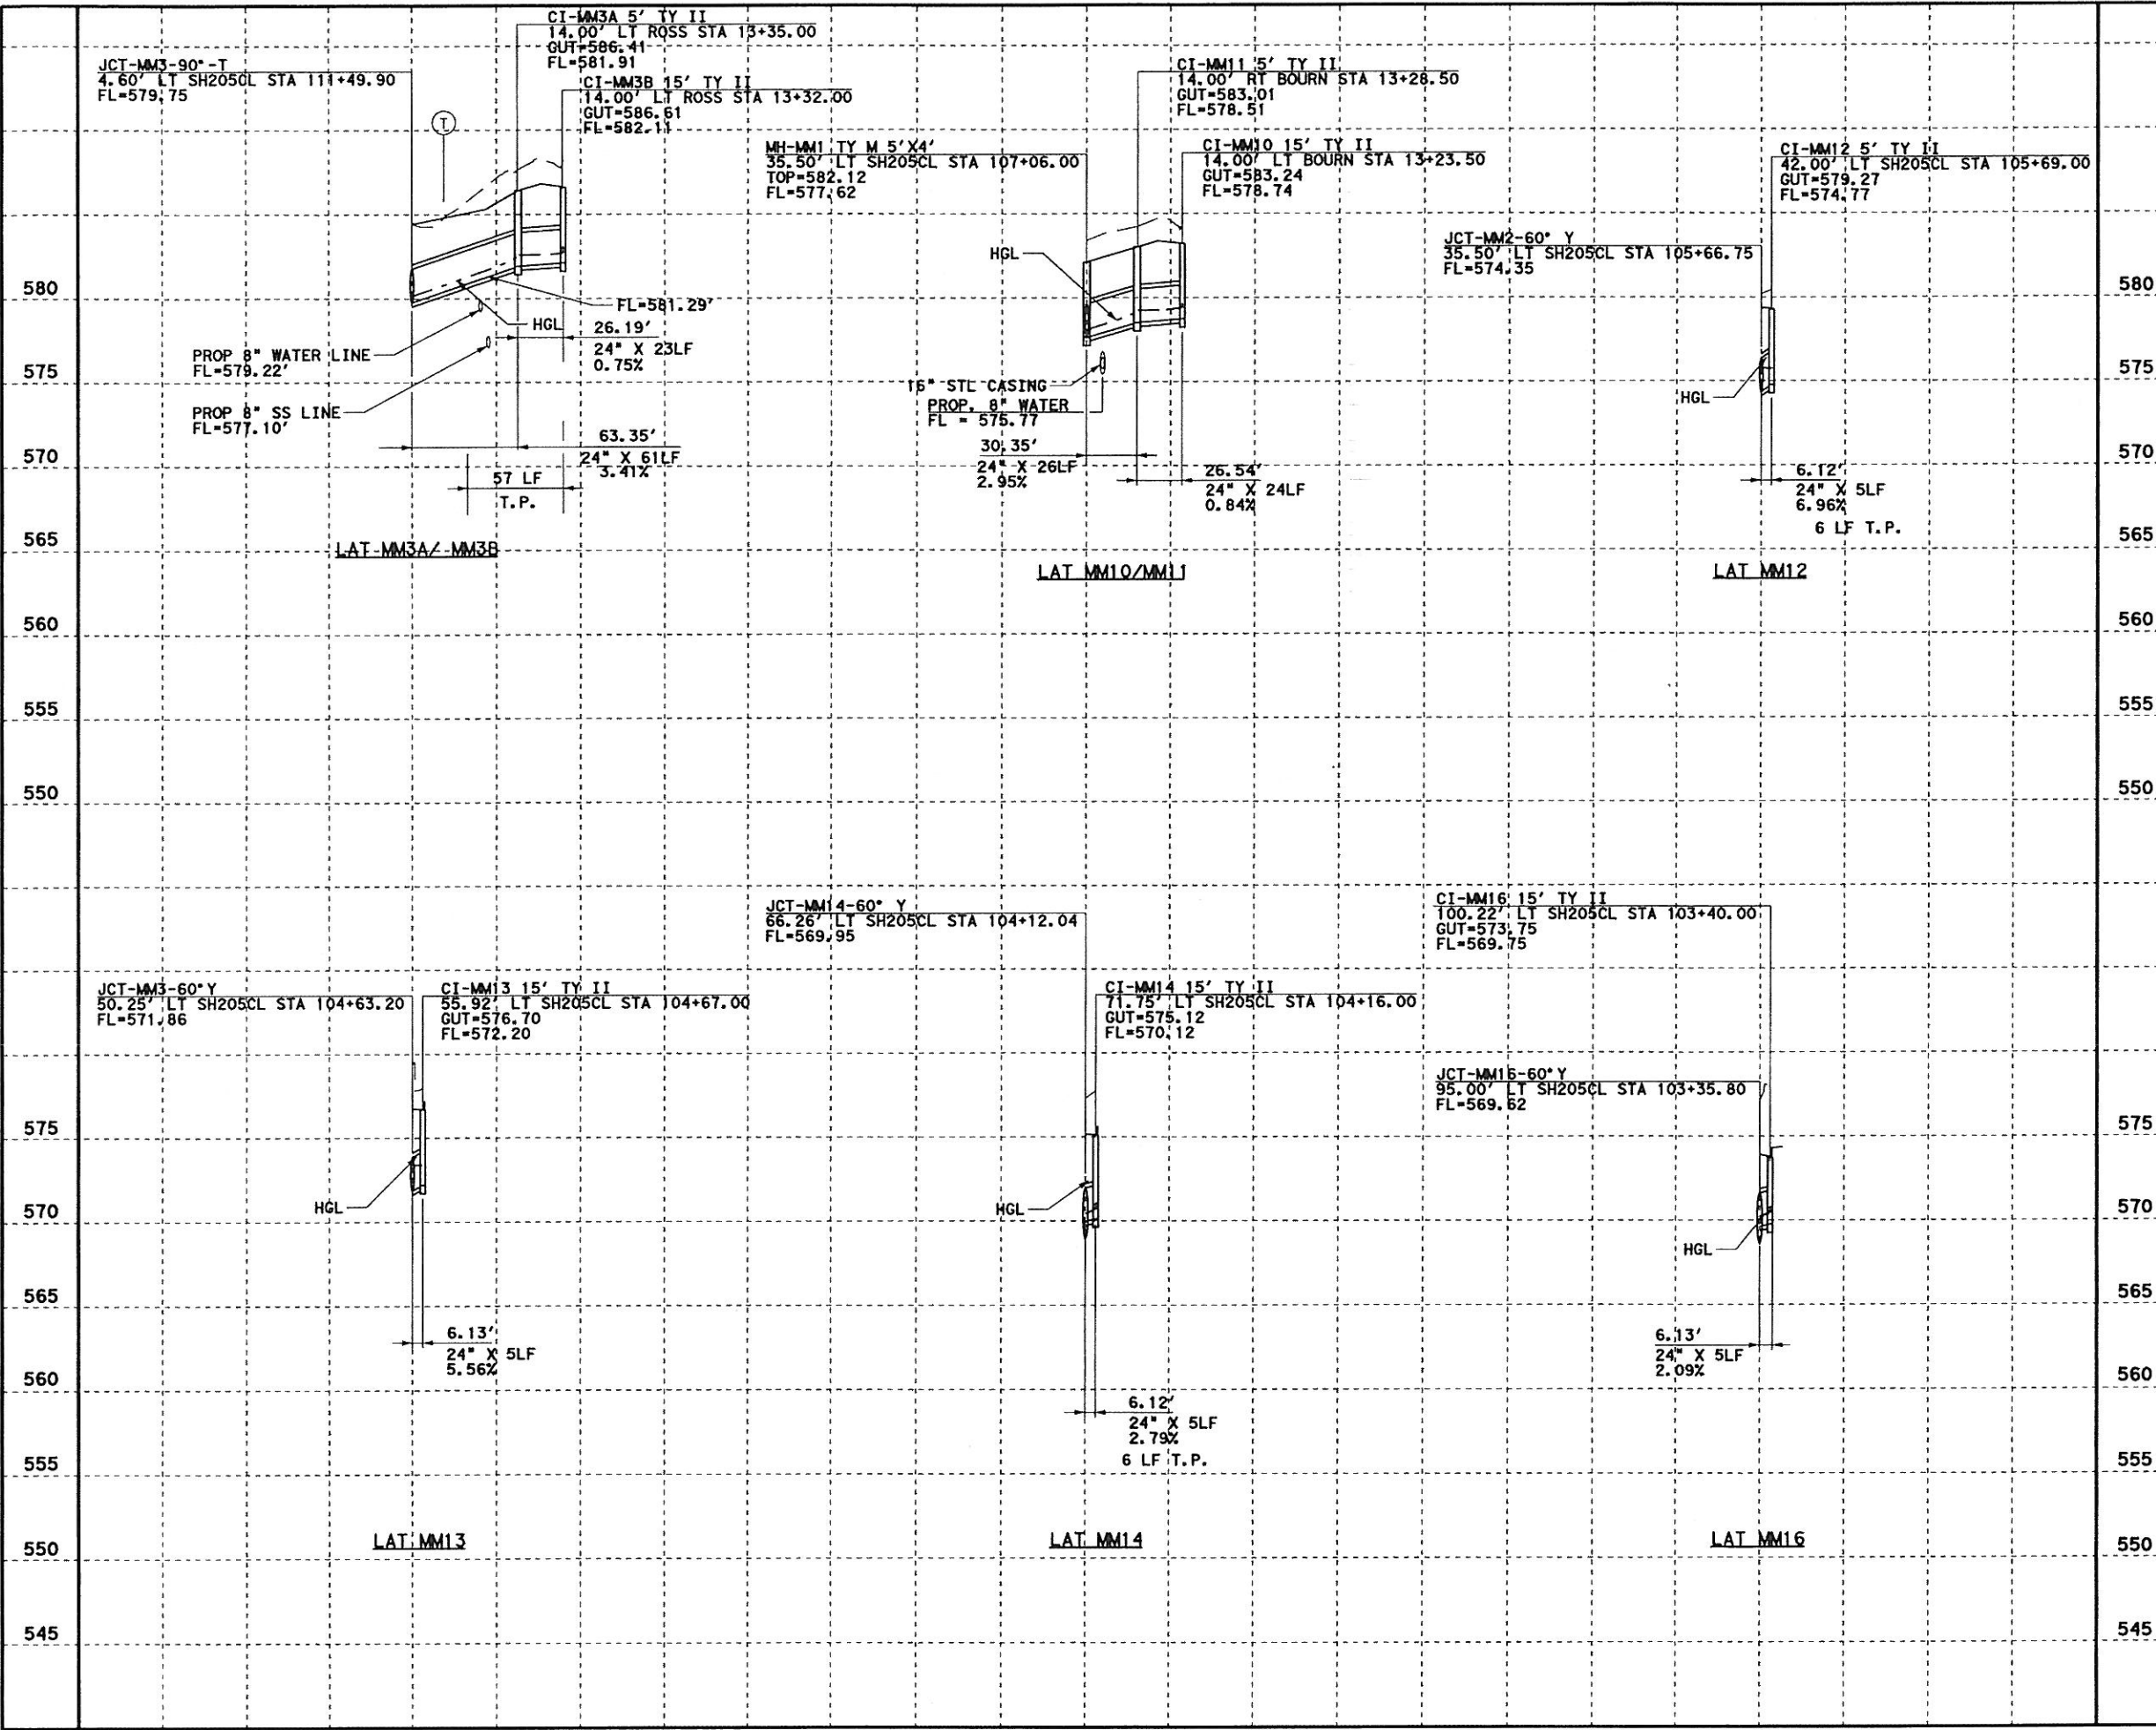

- GENERAL NOTES**
- CURB INLETS STATION AND OFFSET ARE MEASURED TO THE MIDPOINT OF THE FACE OF MAIN INLET. GRATE INLETS STATION AND OFFSET ARE MEASURED TO THE CENTER OF THE INLET.
 - JUNCTION BOX STATION AND OFFSET ARE MEASURED TO THE CENTER OF THE JUNCTION BOX.
 - ALL PIPES ARE CLASS III RCP UNLESS OTHERWISE NOTED.

- LEGENDS**
- (G) EX. GAS LINE CROSSING ELEVATION UNKNOWN
 - (T) EX. SW BELL CABLE CROSSING ELEVATION UNKNOWN



Parsons Brinckerhoff Quade & Douglas, Inc.
 2777 Stemmons Freeway
 Suite 1333
 Dallas, TX 75207


Texas Department of Transportation
 © 2006

SH 205
 DRAINAGE
 LINE MM LATERALS
 STORM SEWER LATERAL PROFILES

SHEET 52 OF 57

FED. PROJ. NO.		FEDERAL AID PROJECT NO.		HIGHWAY NO.	
6		(SEE TITLE SHEET)		SH 205	
STATE	DIST.	COUNTY		SHEET NO.	
TEXAS	DALLAS	ROCKWALL		452	
CONT.	SECT.	JOB			
0451	01	032, ETC			

D:\HGI\JOBS\22451C-SH205\Drawings\2451cddm01--rev.dgn, ON=10-623
 7/15/2008 Plotted 15-JUL-2008 19:40

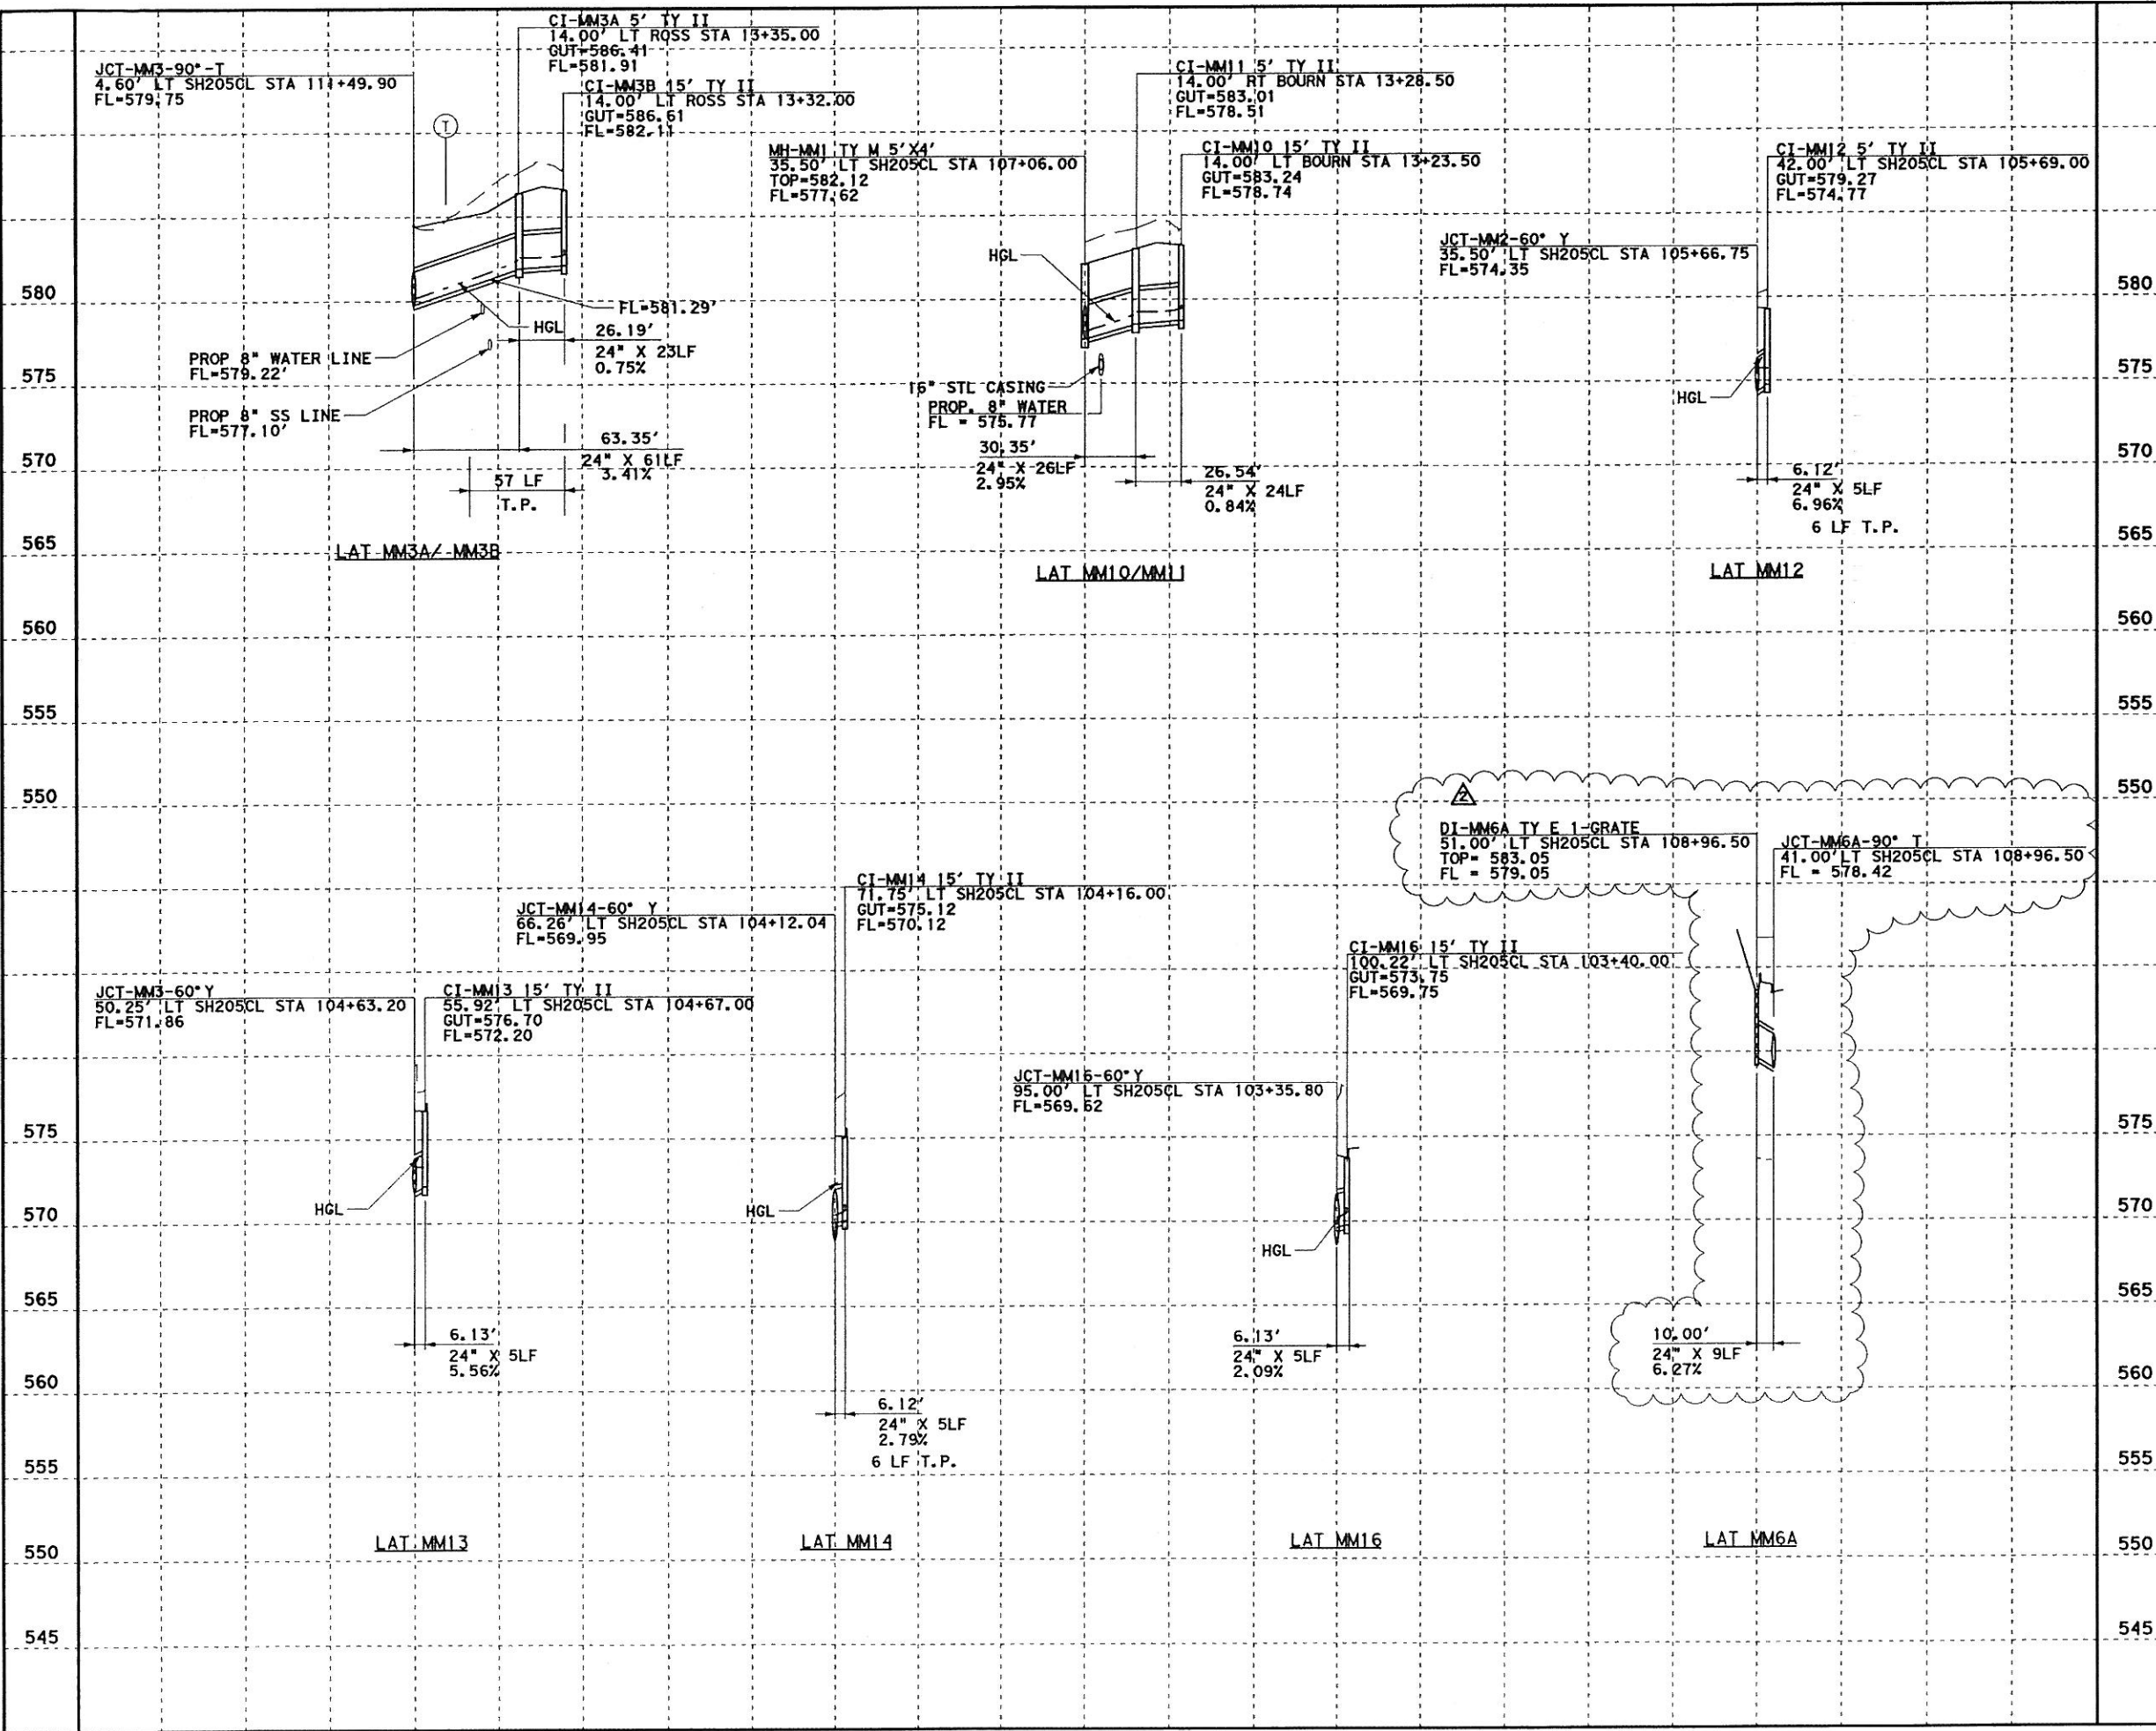

0 50 100
SCALE IN FEET
HORIZONTAL

0 5 10
SCALE IN FEET
VERTICAL

GENERAL NOTES

- CURB INLETS STATION AND OFFSET ARE MEASURED TO THE MIDPOINT OF THE FACE OF MAIN INLET. GRATE INLETS STATION AND OFFSET ARE MEASURED TO THE CENTER OF THE INLET.
- JUNCTION BOX STATION AND OFFSET ARE MEASURED TO THE CENTER OF THE JUNCTION BOX.
- ALL PIPES ARE CLASS III RCP UNLESS OTHERWISE NOTED.

LEGENDS

G
EX. GAS LINE CROSSING
ELEVATION UNKNOWN

T
EX. SW BELL CABLE CROSSING
ELEVATION UNKNOWN

K. David Gan 7/15/08

△ - Change Order #50
 △ ADDED DI-6A - KDG - 04/24/2008

Parsons Brinckerhoff Quade & Douglas, Inc.
 2777 Stemmons Freeway
 Suite 1333
 Dallas, TX 75207

Texas Department of Transportation
 © 2008

SH 205



DRAINAGE
LINE MM LATERALS
STORM SEWER LATERAL PROFILES

SHEET 52 OF 57

FED. RD. DIV. NO.	FEDERAL AID PROJECT NO.	HIGHWAY NO.
6	(SEE TITLE SHEET)	SH 205
STATE	DIST.	COUNTY
TEXAS	DALLAS	ROCKWALL
CONT.	SECT.	JOB
0451	01	032, ETC

SHEET NO. 452A

D:\N\GL\JOBS\224510-SH205\Drawings\2451\cdm\02.dgn, ON=10-621
 5/9/2006 Plotted 09-MAY-2006 13:00

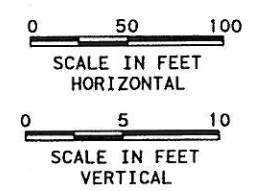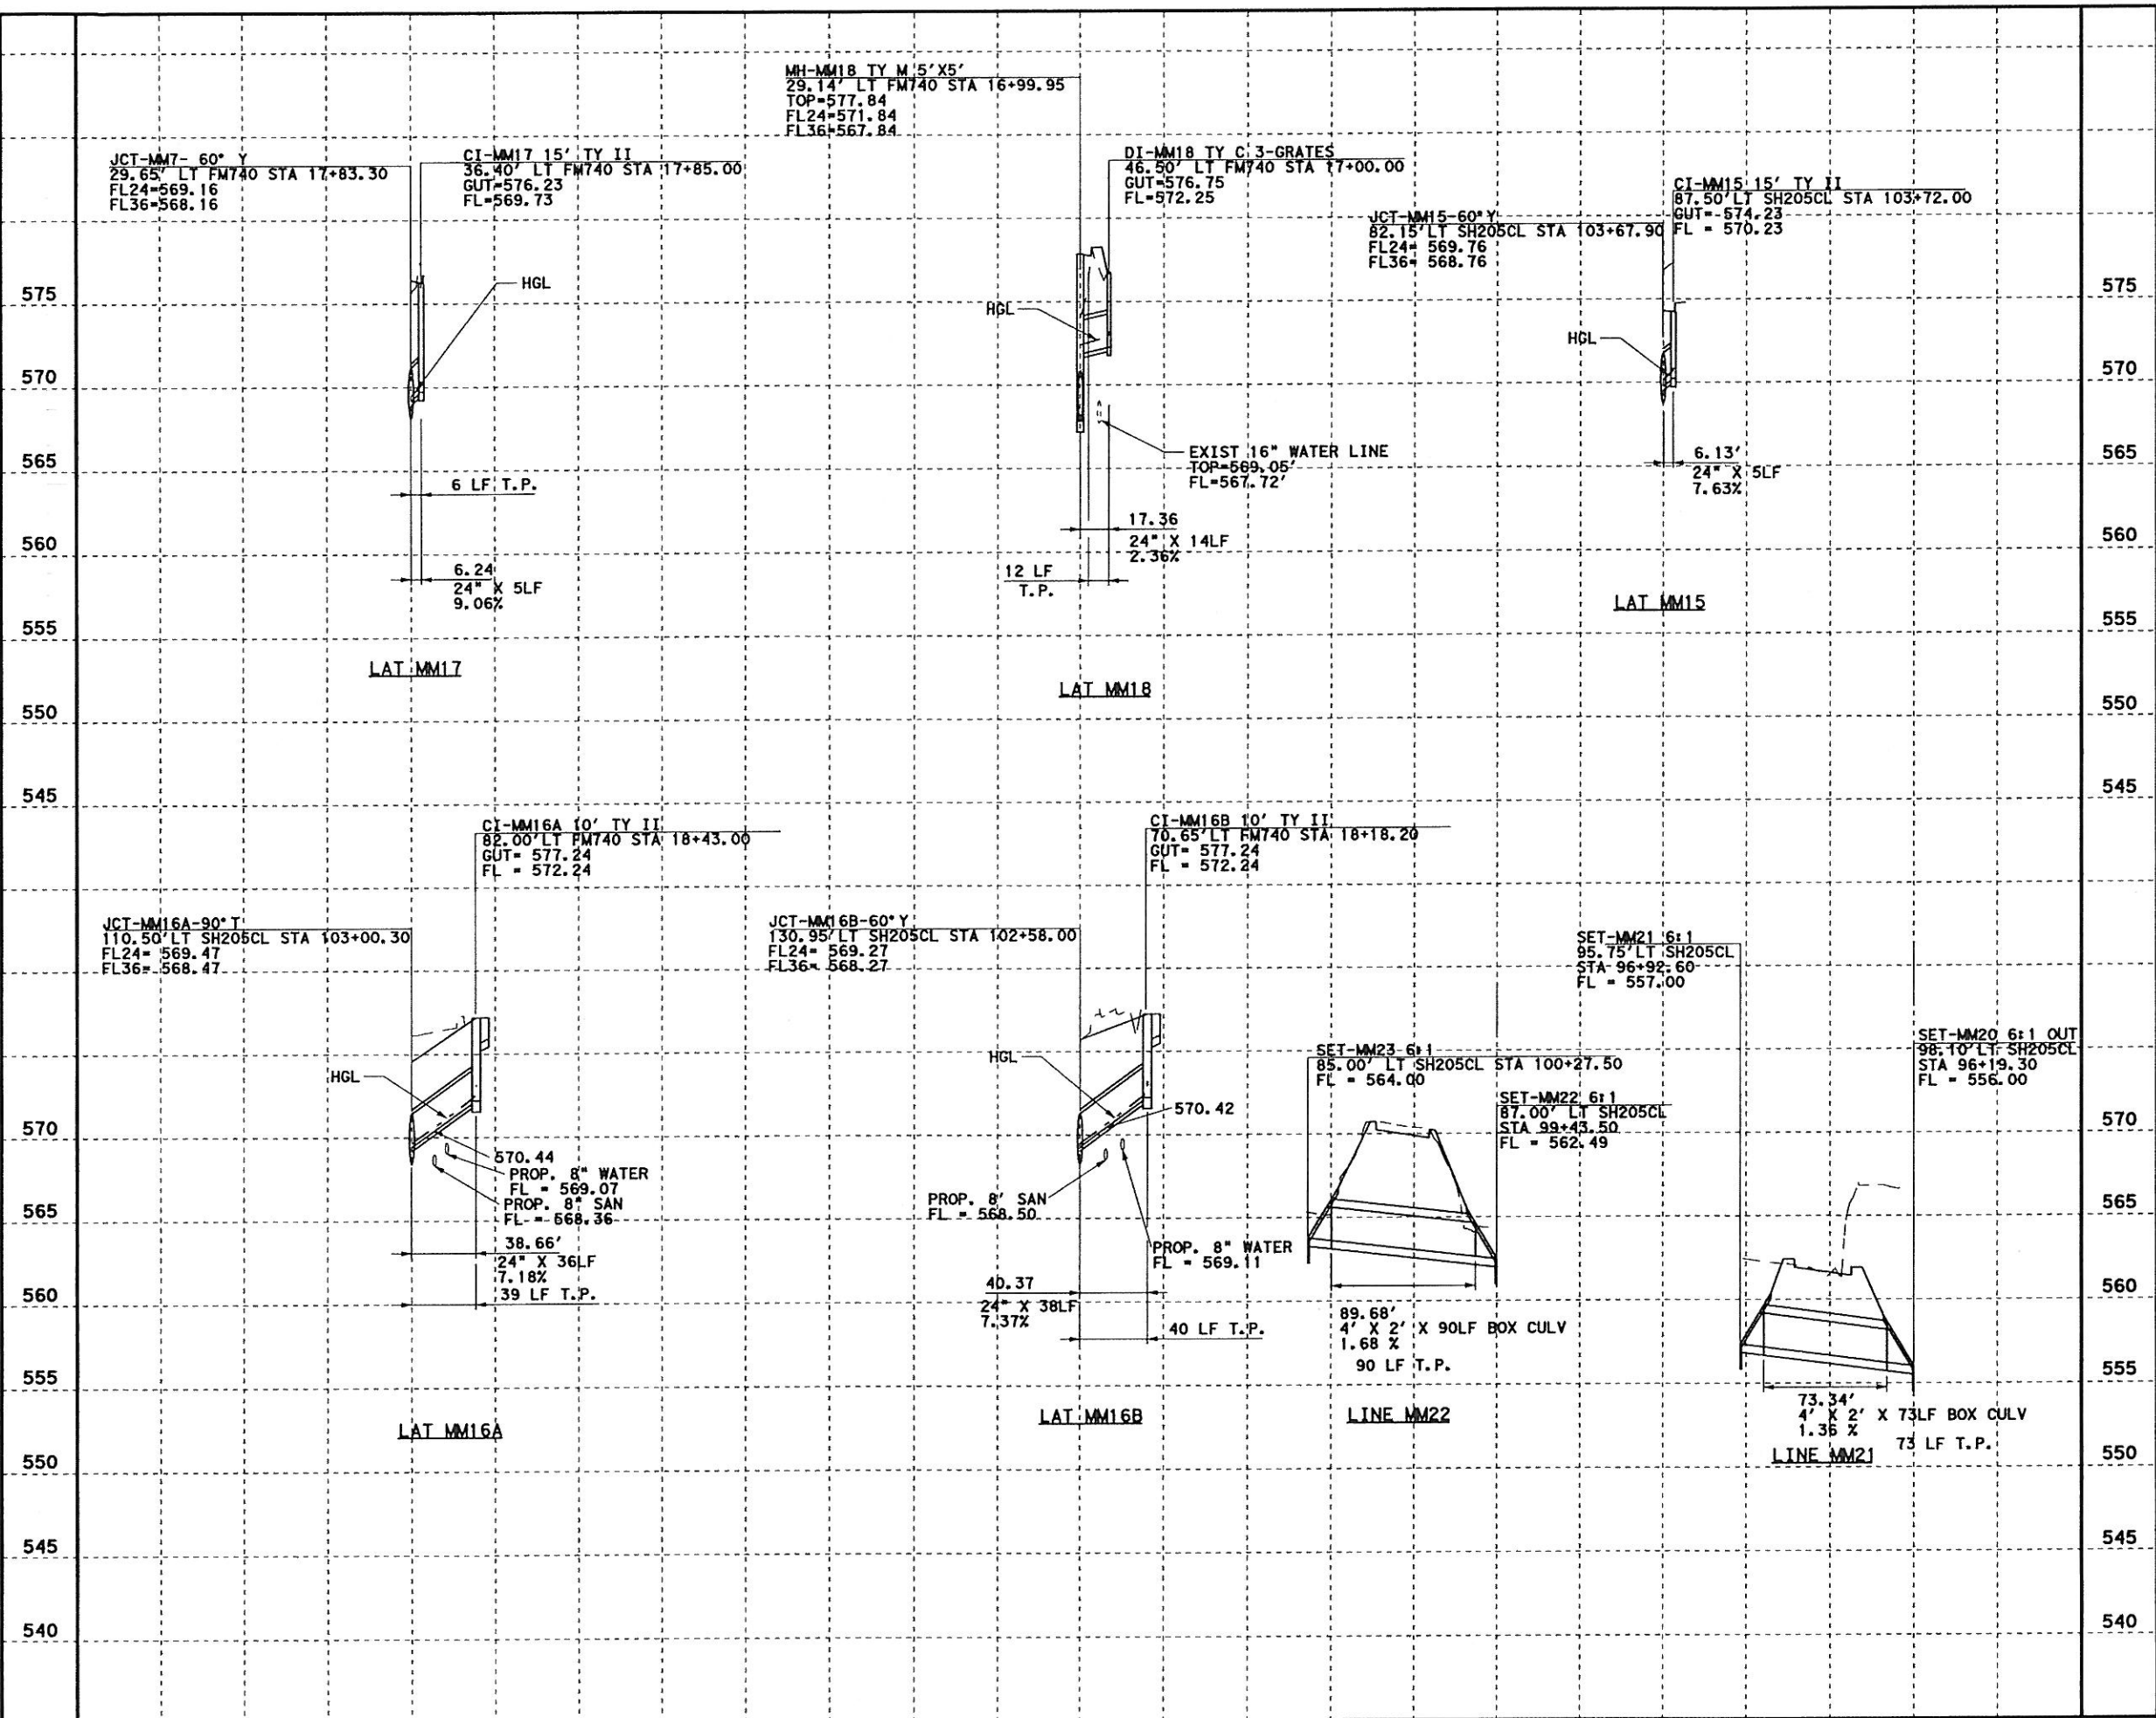

- GENERAL NOTES**
- CURB INLETS STATION AND OFFSET ARE MEASURED TO THE MIDPOINT OF THE FACE OF MAIN INLET. GRATE INLETS STATION AND OFFSET ARE MEASURED TO THE CENTER OF THE INLET.
 - JUNCTION BOX STATION AND OFFSET ARE MEASURED TO THE CENTER OF THE JUNCTION BOX.
 - ALL PIPES ARE CLASS III RCP UNLESS OTHERWISE NOTED.



PB Parsons Brinckerhoff Quade & Douglas, Inc.
 2777 Shimmens Freeway
 Suite 1333
 Dallas, TX 75207



Texas Department of Transportation
 © 2006

SH 205
 DRAINAGE
 LINE MM LATERALS
 STORM SEWER LATERAL PROFILES


SHEET 53 OF 57

FED. PROJ. NO.	FEDERAL AID PROJECT NO.	HIGHWAY NO.
6	(SEE TITLE SHEET)	SH 205
STATE	DIST.	COUNTY
TEXAS	DALLAS	ROCKWALL
CONT.	SECT.	JOB
0451	01	032, ETC
		SHEET NO.
		453

DGN:G:\JOBS\22451C-SH205\Drawings\2451\addn01.dgn, ON=10-621
 5/10/2006 Plotted 10-MAY-2006 09:23

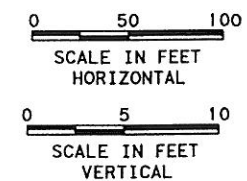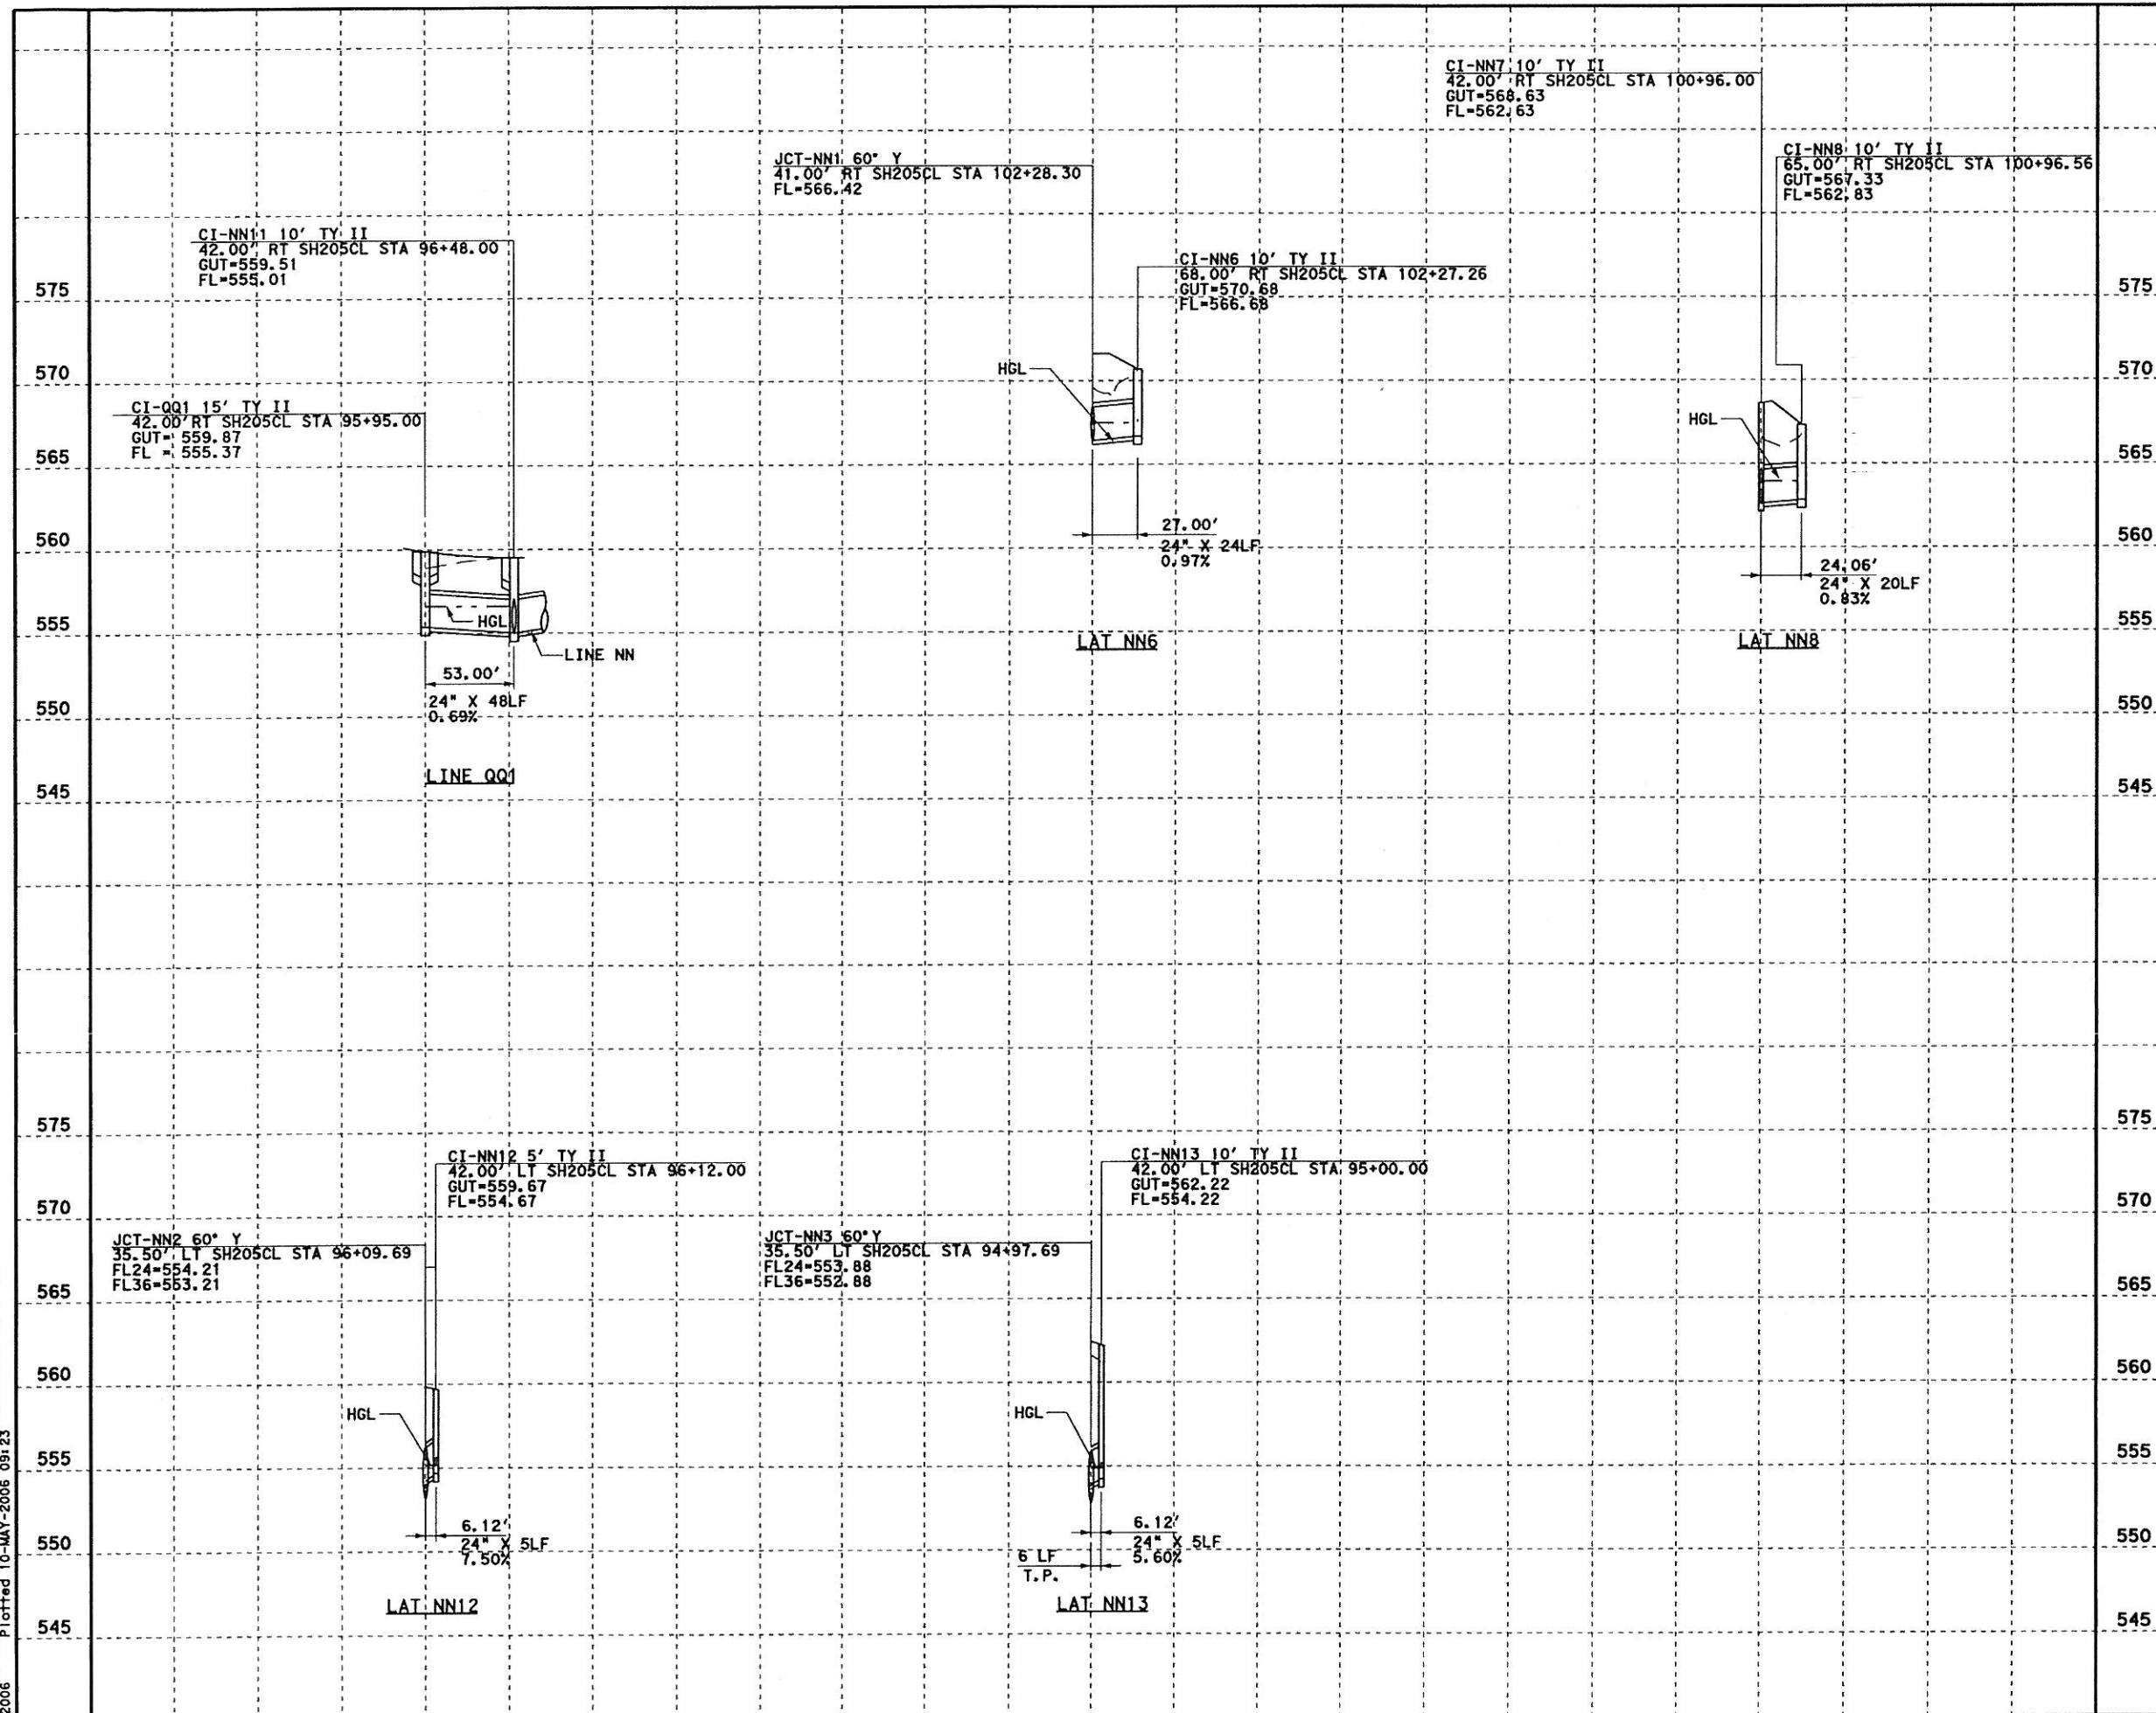

- GENERAL NOTES**
1. CURB INLETS STATION AND OFFSET ARE MEASURED TO THE MIDPOINT OF THE FACE OF MAIN INLET. GRATE INLETS STATION AND OFFSET ARE MEASURED TO THE CENTER OF THE INLET.
 2. JUNCTION BOX STATION AND OFFSET ARE MEASURED TO THE CENTER OF THE JUNCTION BOX.
 3. ALL PIPES ARE CLASS III RCP UNLESS OTHERWISE NOTED.

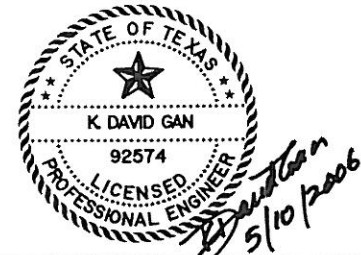

PB Parsons Brinckerhoff Quade & Douglas, Inc.
 2777 Simmons Freeway
 Suite 1333
 122 Dallas, TX 75207

Texas Department of Transportation
 © 2006

SH 205



DRAINAGE
LINE NN LATERALS
STORM SEWER LATERAL PROFILES

SHEET 54 OF 57

FED. RD. DIV. NO.	FEDERAL AID PROJECT NO.	HIGHWAY NO.
6	(SEE TITLE SHEET)	SH 205
STATE	DIST.	COUNTY
TEXAS	DALLAS	ROCKWALL
CONT.	SECT.	JOB
0451	01	032, ETC

SHEET NO.
454

DGN=C:\JOBS\22451C-SH205\Drawings\2451.cdd\NO1.dgn, ON=10-62
 1/13/2009 Plotfile 13-JAN-2009 131.46

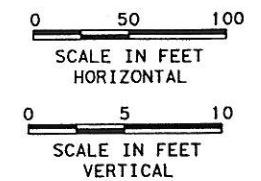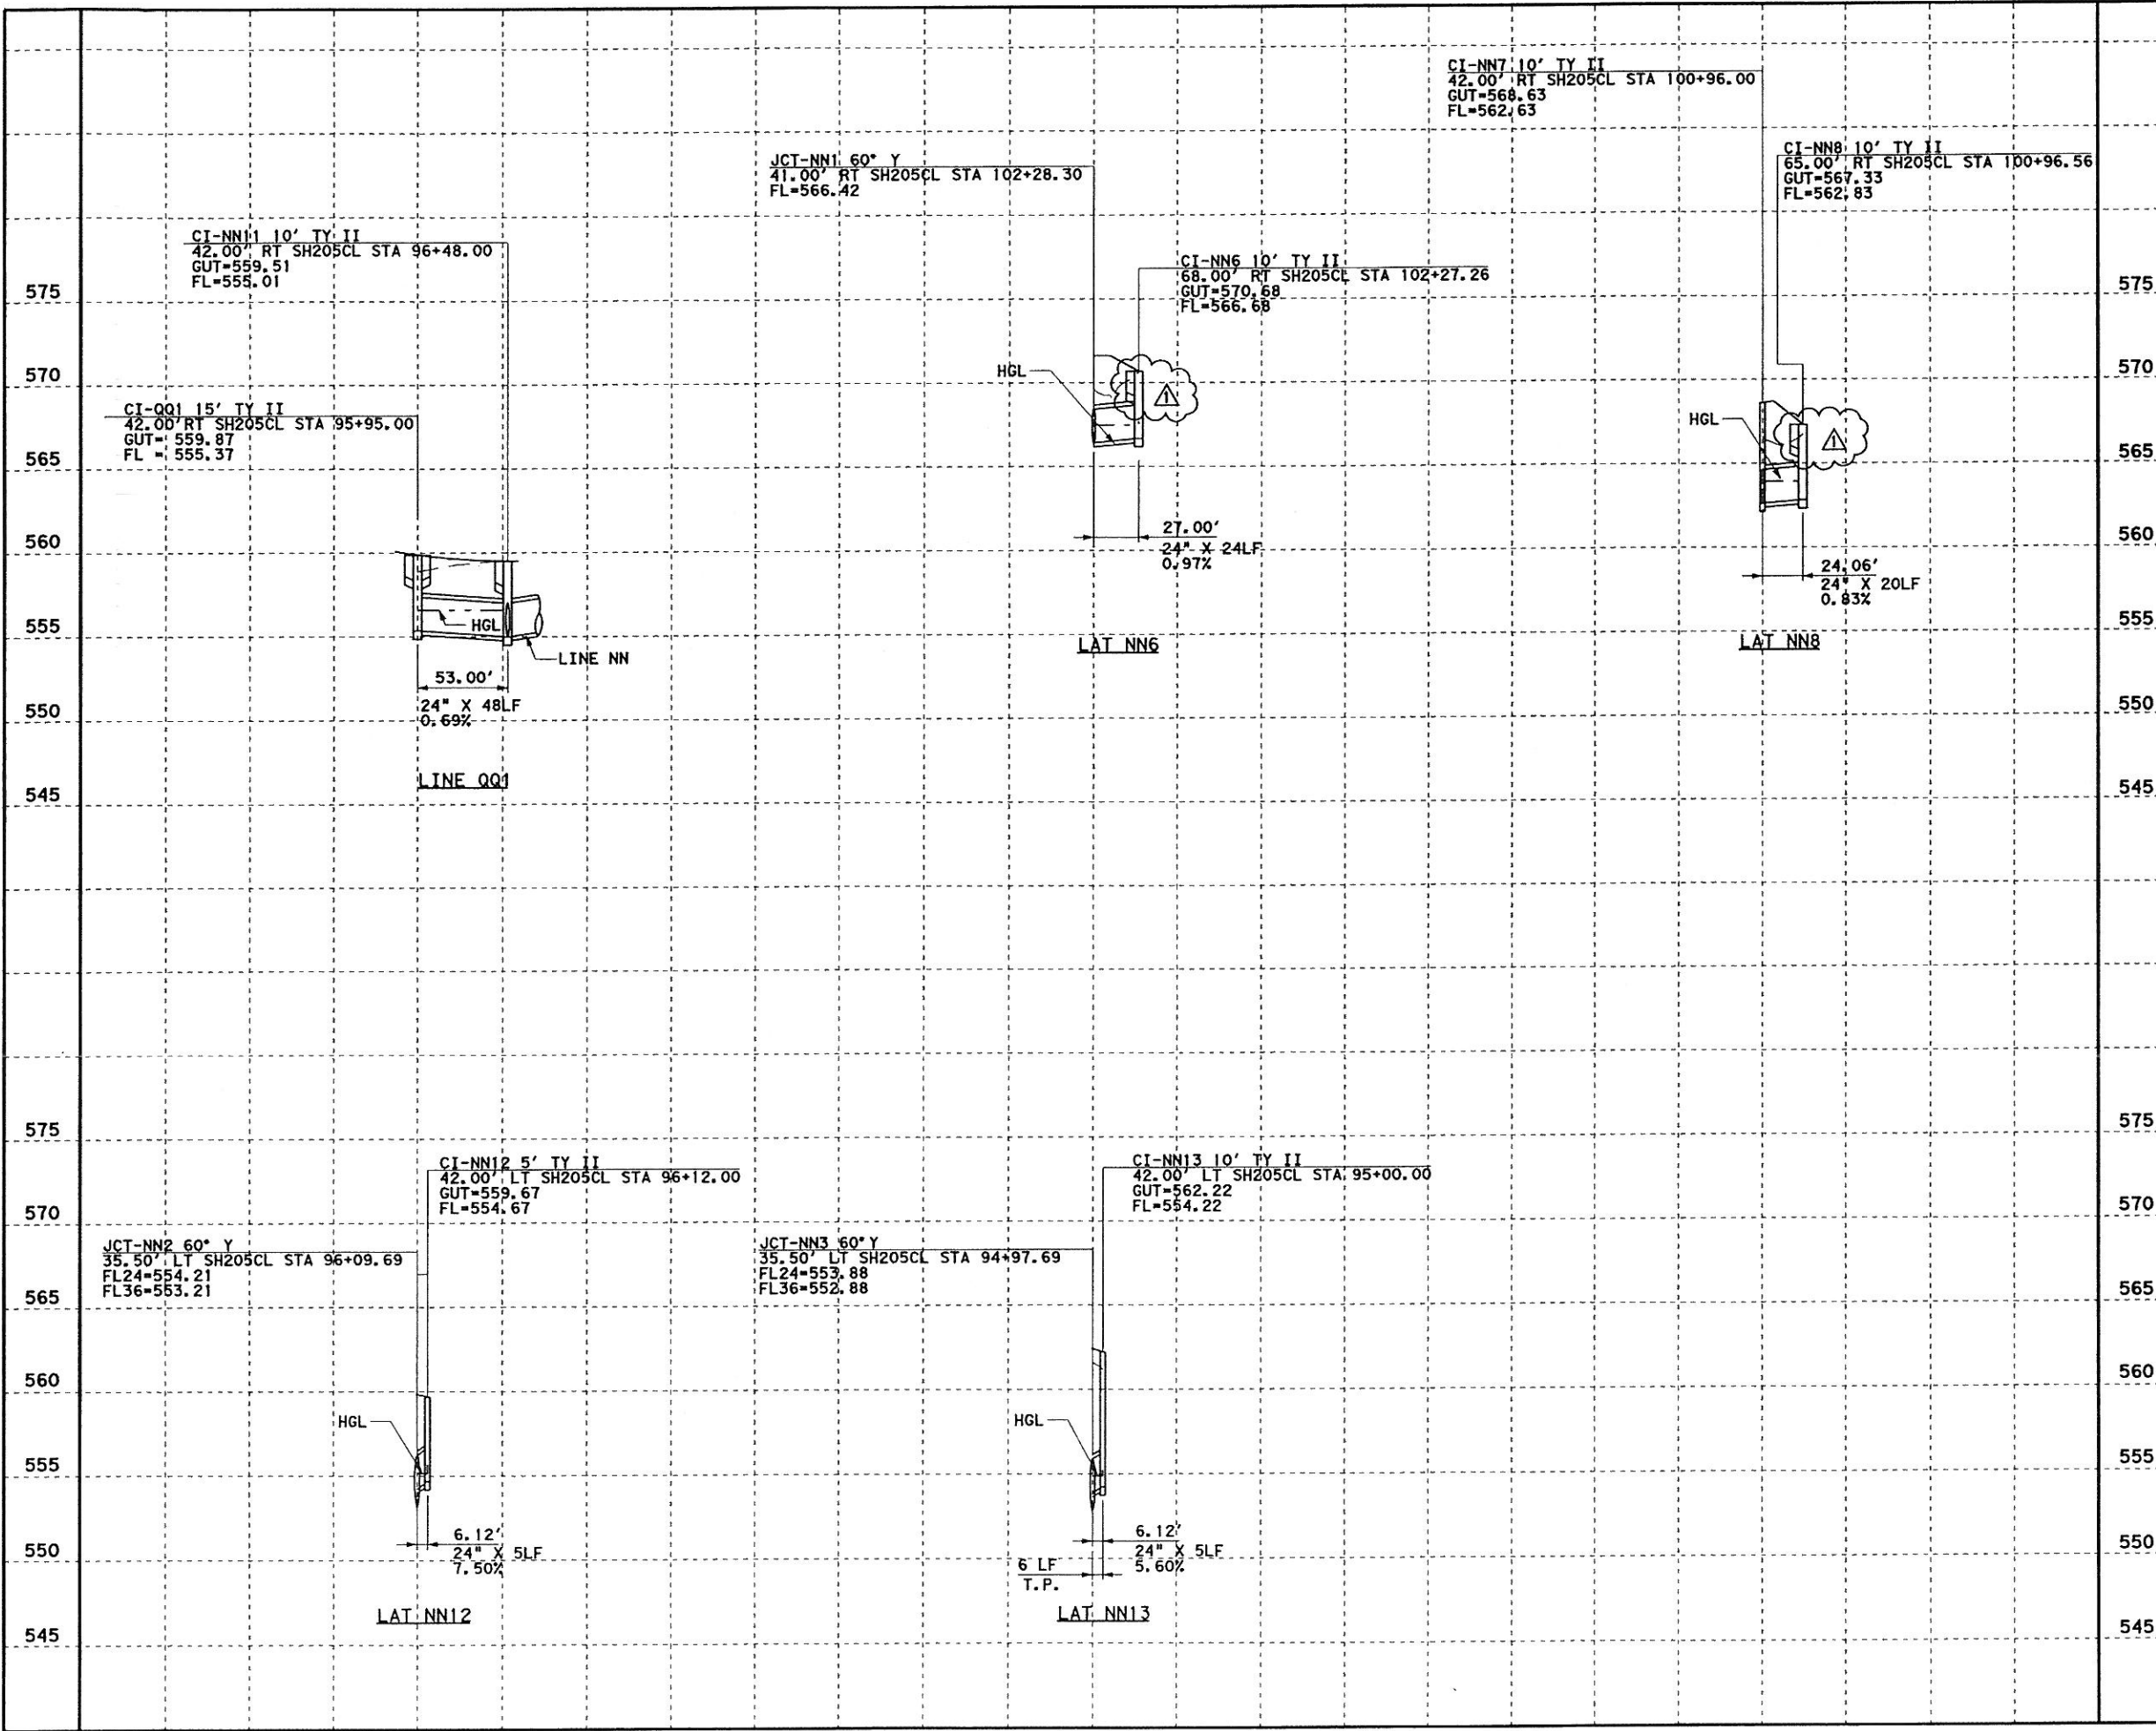

- GENERAL NOTES**
1. CURB INLETS STATION AND OFFSET ARE MEASURED TO THE MIDPOINT OF THE FACE OF MAIN INLET. GRATE INLETS STATION AND OFFSET ARE MEASURED TO THE CENTER OF THE INLET.
 2. JUNCTION BOX STATION AND OFFSET ARE MEASURED TO THE CENTER OF THE JUNCTION BOX.
 3. ALL PIPES ARE CLASS III RCP UNLESS OTHERWISE NOTED.





1 09-05-08 | CI-INLET EXT | AM
Parsons Brinckerhoff Quade & Douglas, Inc.
 2777 Stemmons Freeway
 Suite 1333
 Dallas, TX 75207


Texas Department of Transportation
 © 2008

SH 205			
DRAINAGE LINE NN LATERALS STORM SEWER LATERAL PROFILES			
SHEET 54 OF 57			
FED. RD. DIV. NO.	FEDERAL AID PROJECT NO.	HIGHWAY NO.	
6	(SEE TITLE SHEET)	SH 205	
STATE	DIST.	COUNTY	SHEET NO.
TEXAS	DALLAS	ROCKWALL	454A
CONT.	SECT.	JOB	
0451	01	032, ETC	

DGN=G:\JOBS\22451C-SH205\Drawings\2451ad\PP01.dgn, ON=CO-623
 5/9/2006 Plotted 09-MAY-2006 13:00

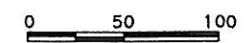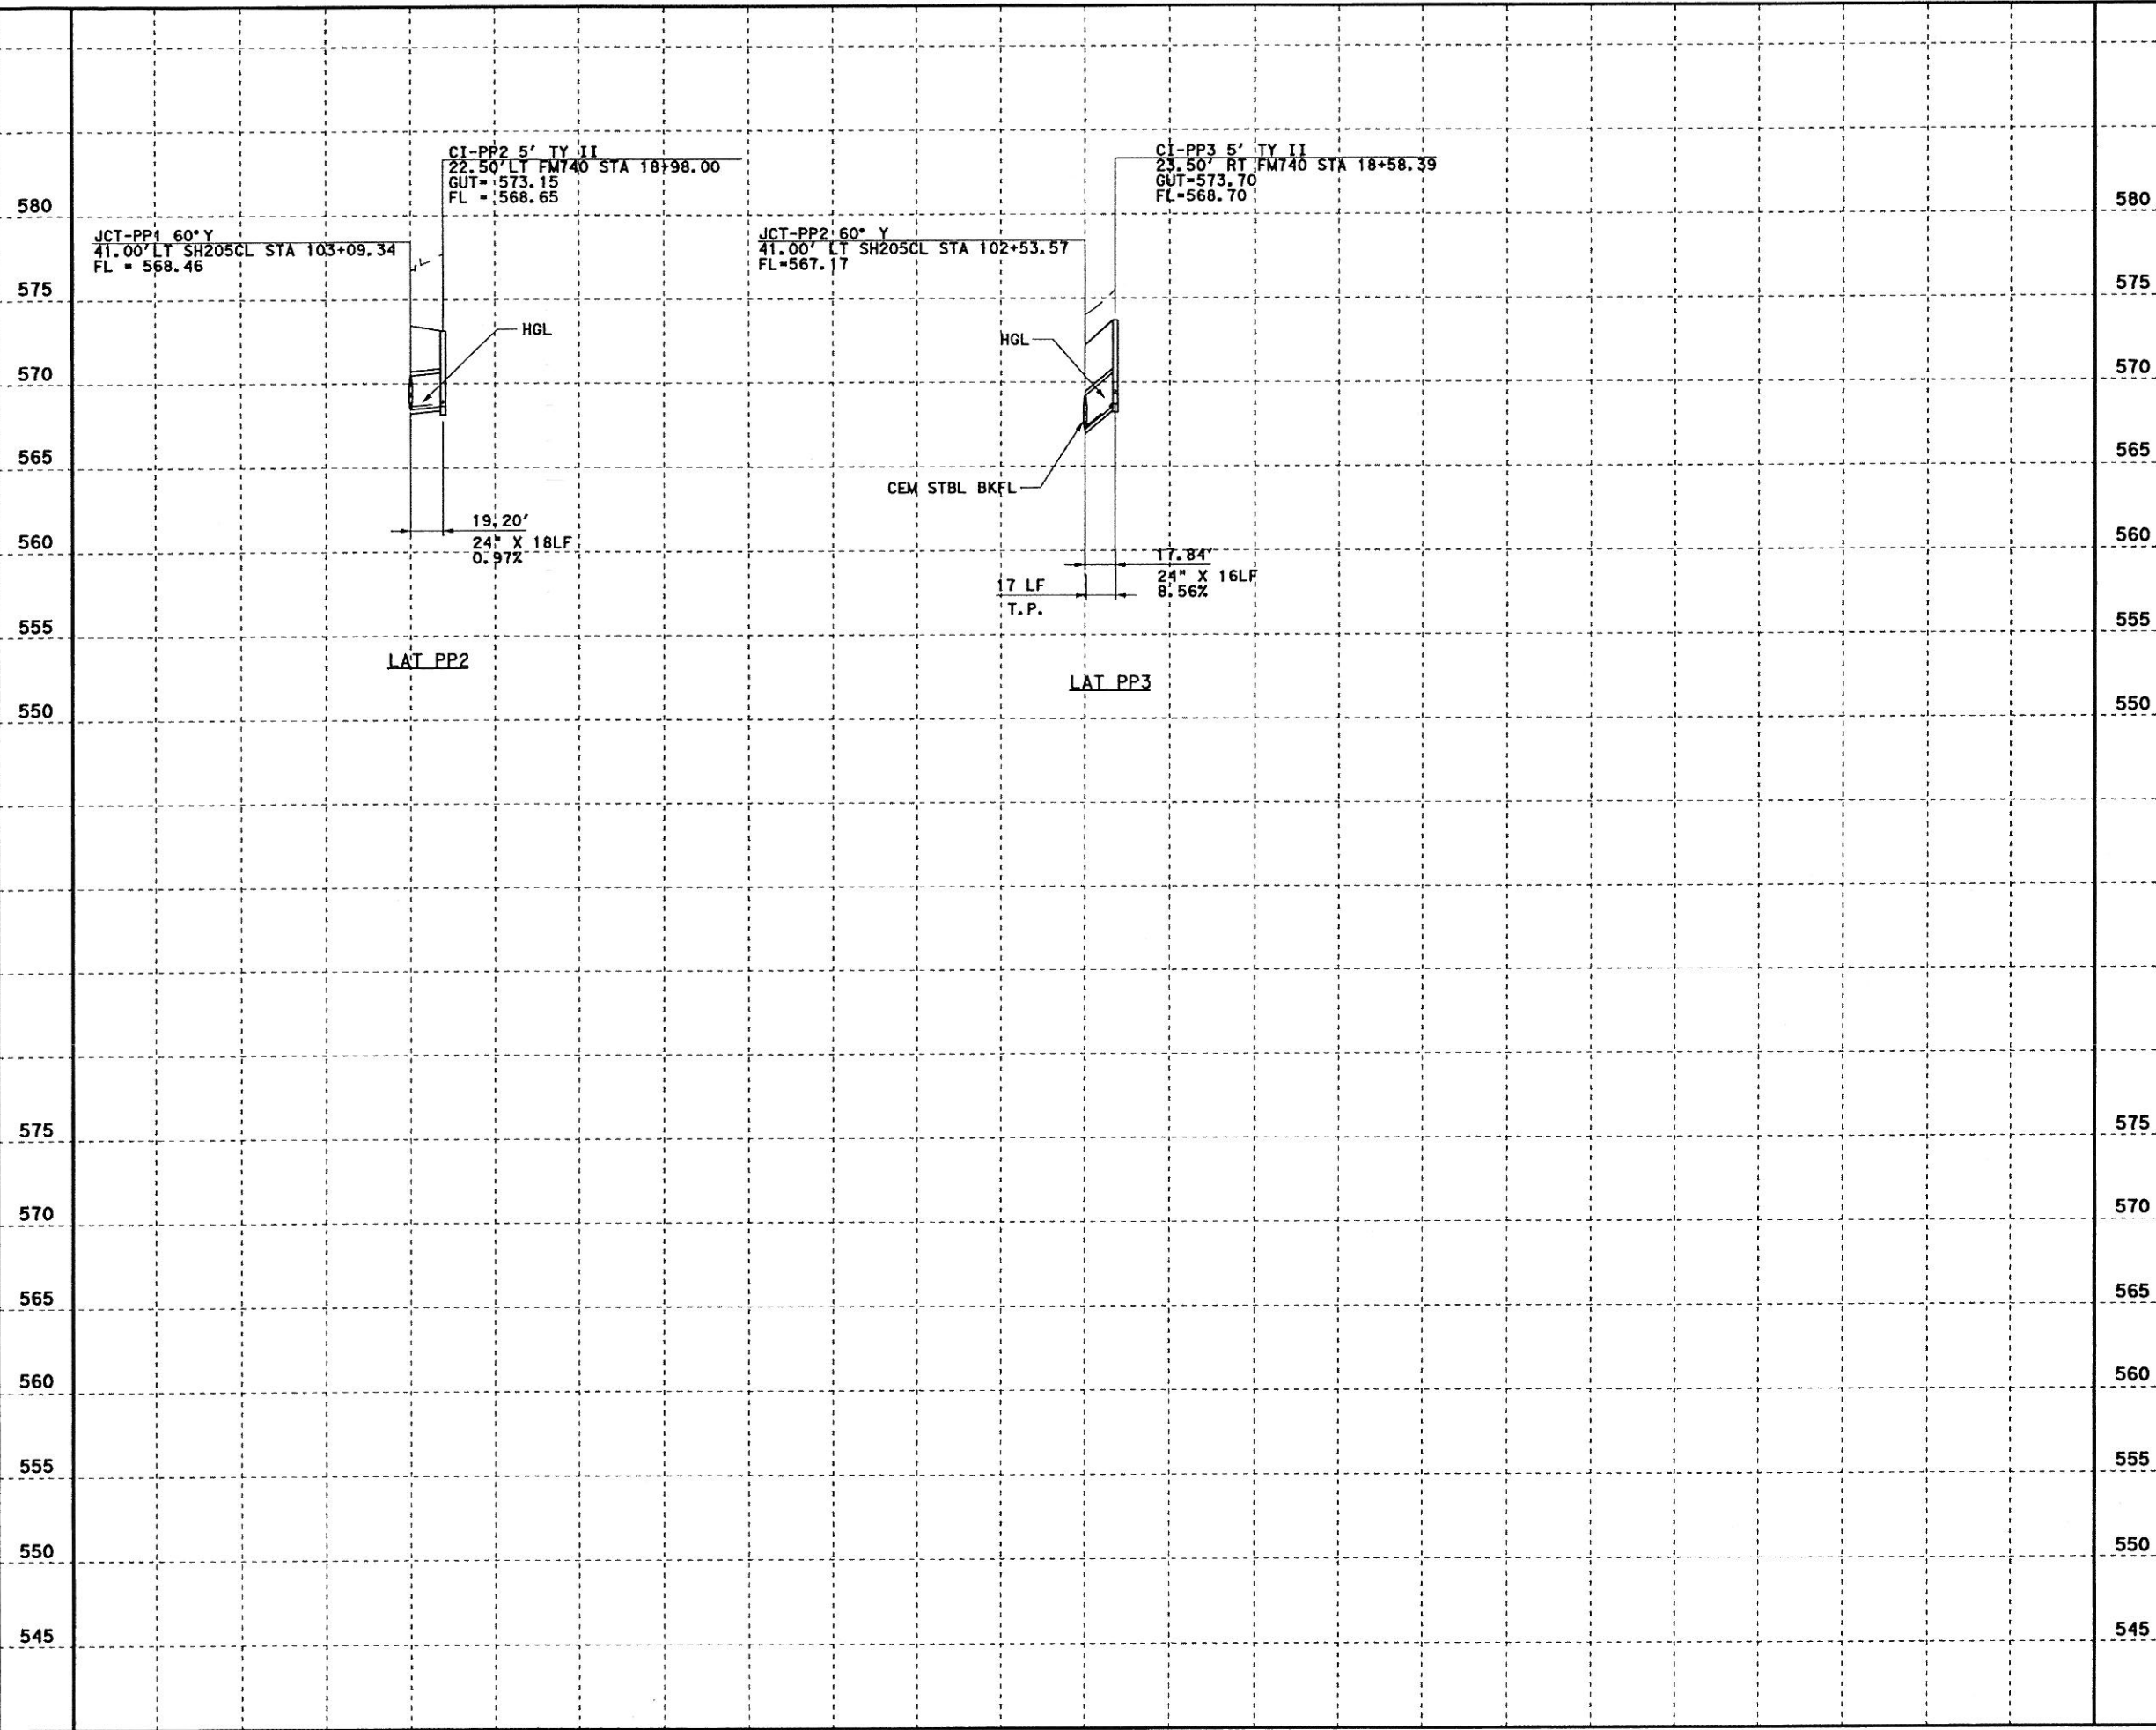

SCALE IN FEET
HORIZONTAL

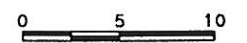

SCALE IN FEET
VERTICAL

GENERAL NOTES

1. CURB INLETS STATION AND OFFSET ARE MEASURED TO THE MIDPOINT OF THE FACE OF MAIN INLET. GRATE INLETS STATION AND OFFSET ARE MEASURED TO THE CENTER OF THE INLET.
2. JUNCTION BOX STATION AND OFFSET ARE MEASURED TO THE CENTER OF THE JUNCTION BOX.
3. ALL PIPES ARE CLASS III RCP UNLESS OTHERWISE NOTED.



PB Parsons Brinckerhoff Quade & Douglas, Inc.
 2777 Stemmons Freeway
 Suite 1333
 Dallas, TX 75207

T Texas Department of Transportation
 © 2006




SH 205

DRAINAGE
 LINE PP LATERALS
 STORM SEWER LATERAL PROFILES

SHEET 55 OF 57


FED. DIST. NO.		FEDERAL AID PROJECT NO.		HIGHWAY NO.	
6		(SEE TITLE SHEET)		SH 205	
STATE	DIST.	COUNTY		SHEET NO.	
TEXAS	DALLAS	ROCKWALL		455	
CONT.	SECT.	JOB			
0451	01	032, ETC			

DGN=GI\JOBS\22451C-SH205\Drainage\2451dxd01.dgn, ON=[0-62]
 5/9/2006 Plotted 09-MAY-2006 13:00

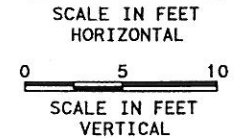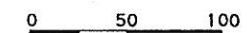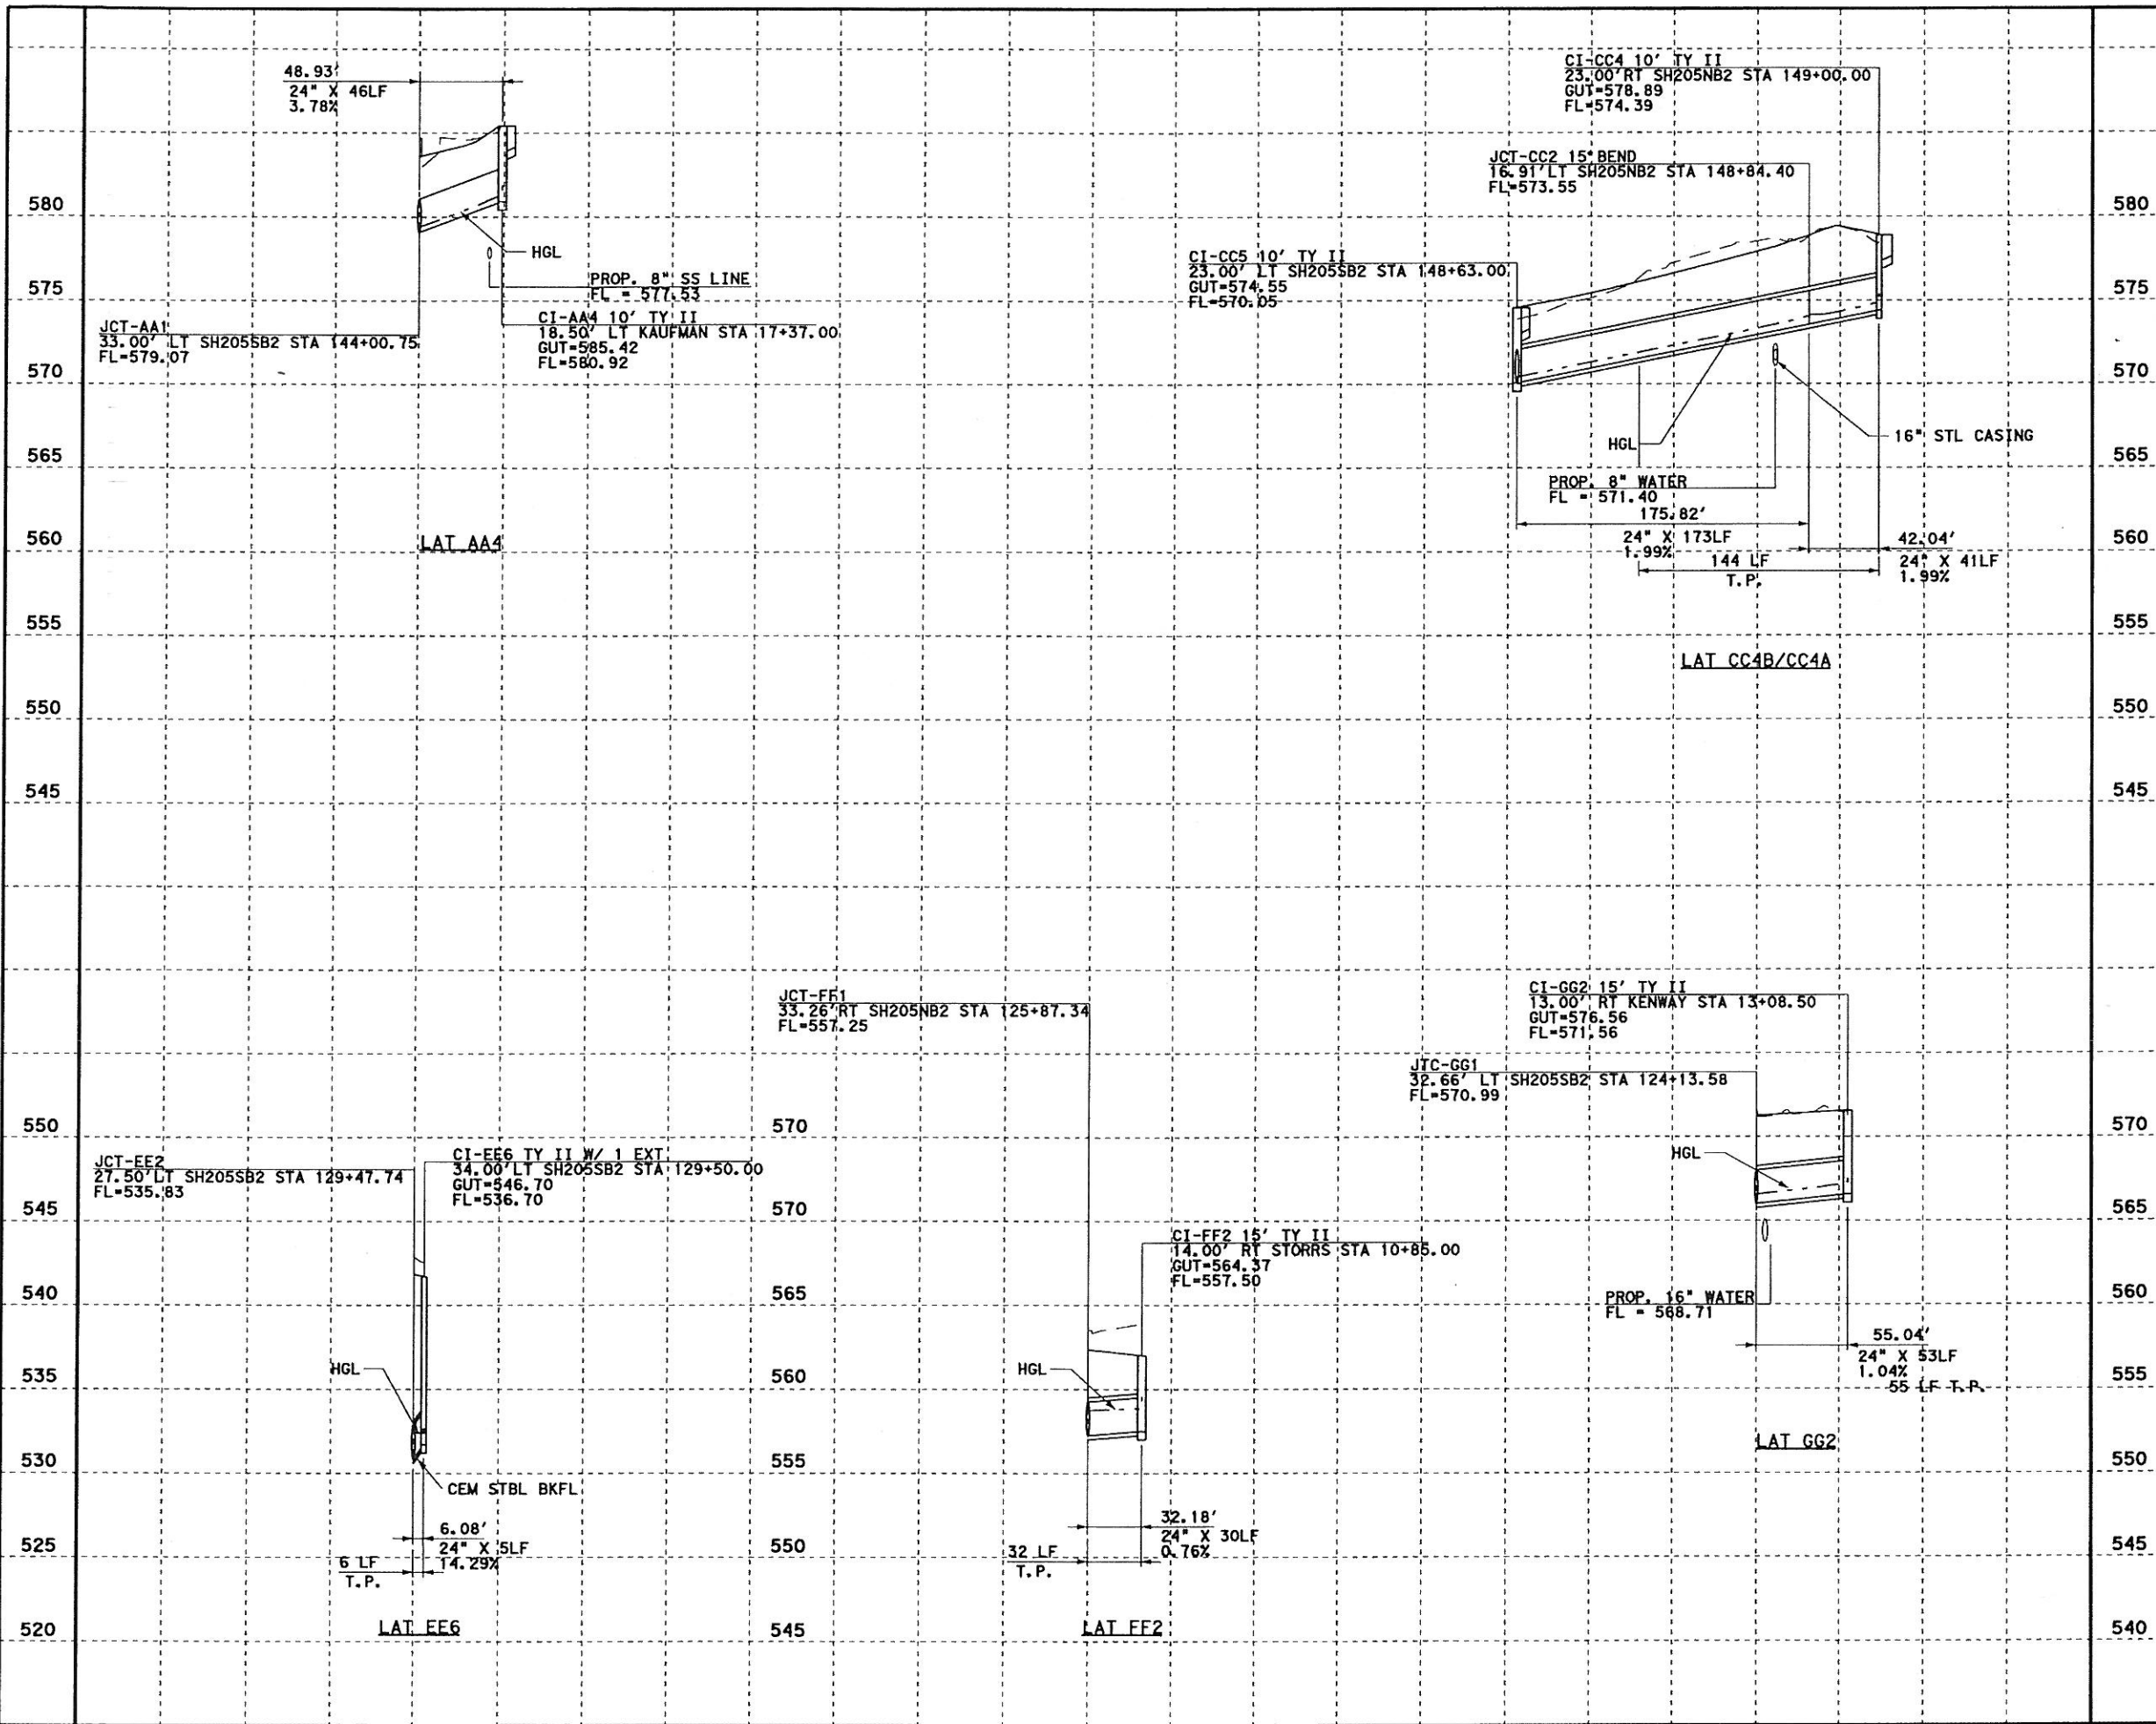


GENERAL NOTES

1. CURB INLETS STATION AND OFFSET ARE MEASURED TO THE MIDPOINT OF THE FACE OF MAIN INLET. GRATE INLETS STATION AND OFFSET ARE MEASURED TO THE CENTER OF THE INLET.
2. JUNCTION BOX STATION AND OFFSET ARE MEASURED TO THE CENTER OF THE JUNCTION BOX.
3. ALL PIPES ARE CLASS III RCP UNLESS OTHERWISE NOTED.

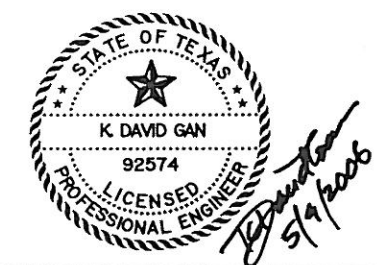

Parsons Brinckerhoff Quade & Douglas, Inc.
 2777 Simmons Freeway
 Suite 1333
 122 Dallas, TX 75207

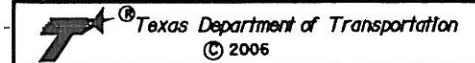



SH 205

DRAINAGE
 MISC LINE LATERALS
 STORM SEWER LATERAL PROFILES

SHEET 56 OF 57

FED. PROJ. NO.	FEDERAL AID PROJECT NO.	HIGHWAY NO.
6	(SEE TITLE SHEET)	SH 205
STATE	DIST.	COUNTY
TEXAS	DALLAS	ROCKWALL
CONT.	SECT.	JOB
0451	01	032, ETC
		SHEET NO.
		456

DGN=G:\JOBS\22451C-SH205\Drainage\2451add\01.dgn, ON=10-621
 1/13/2009 Plotted 13-JAN-2009 19:46

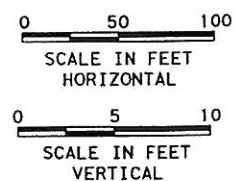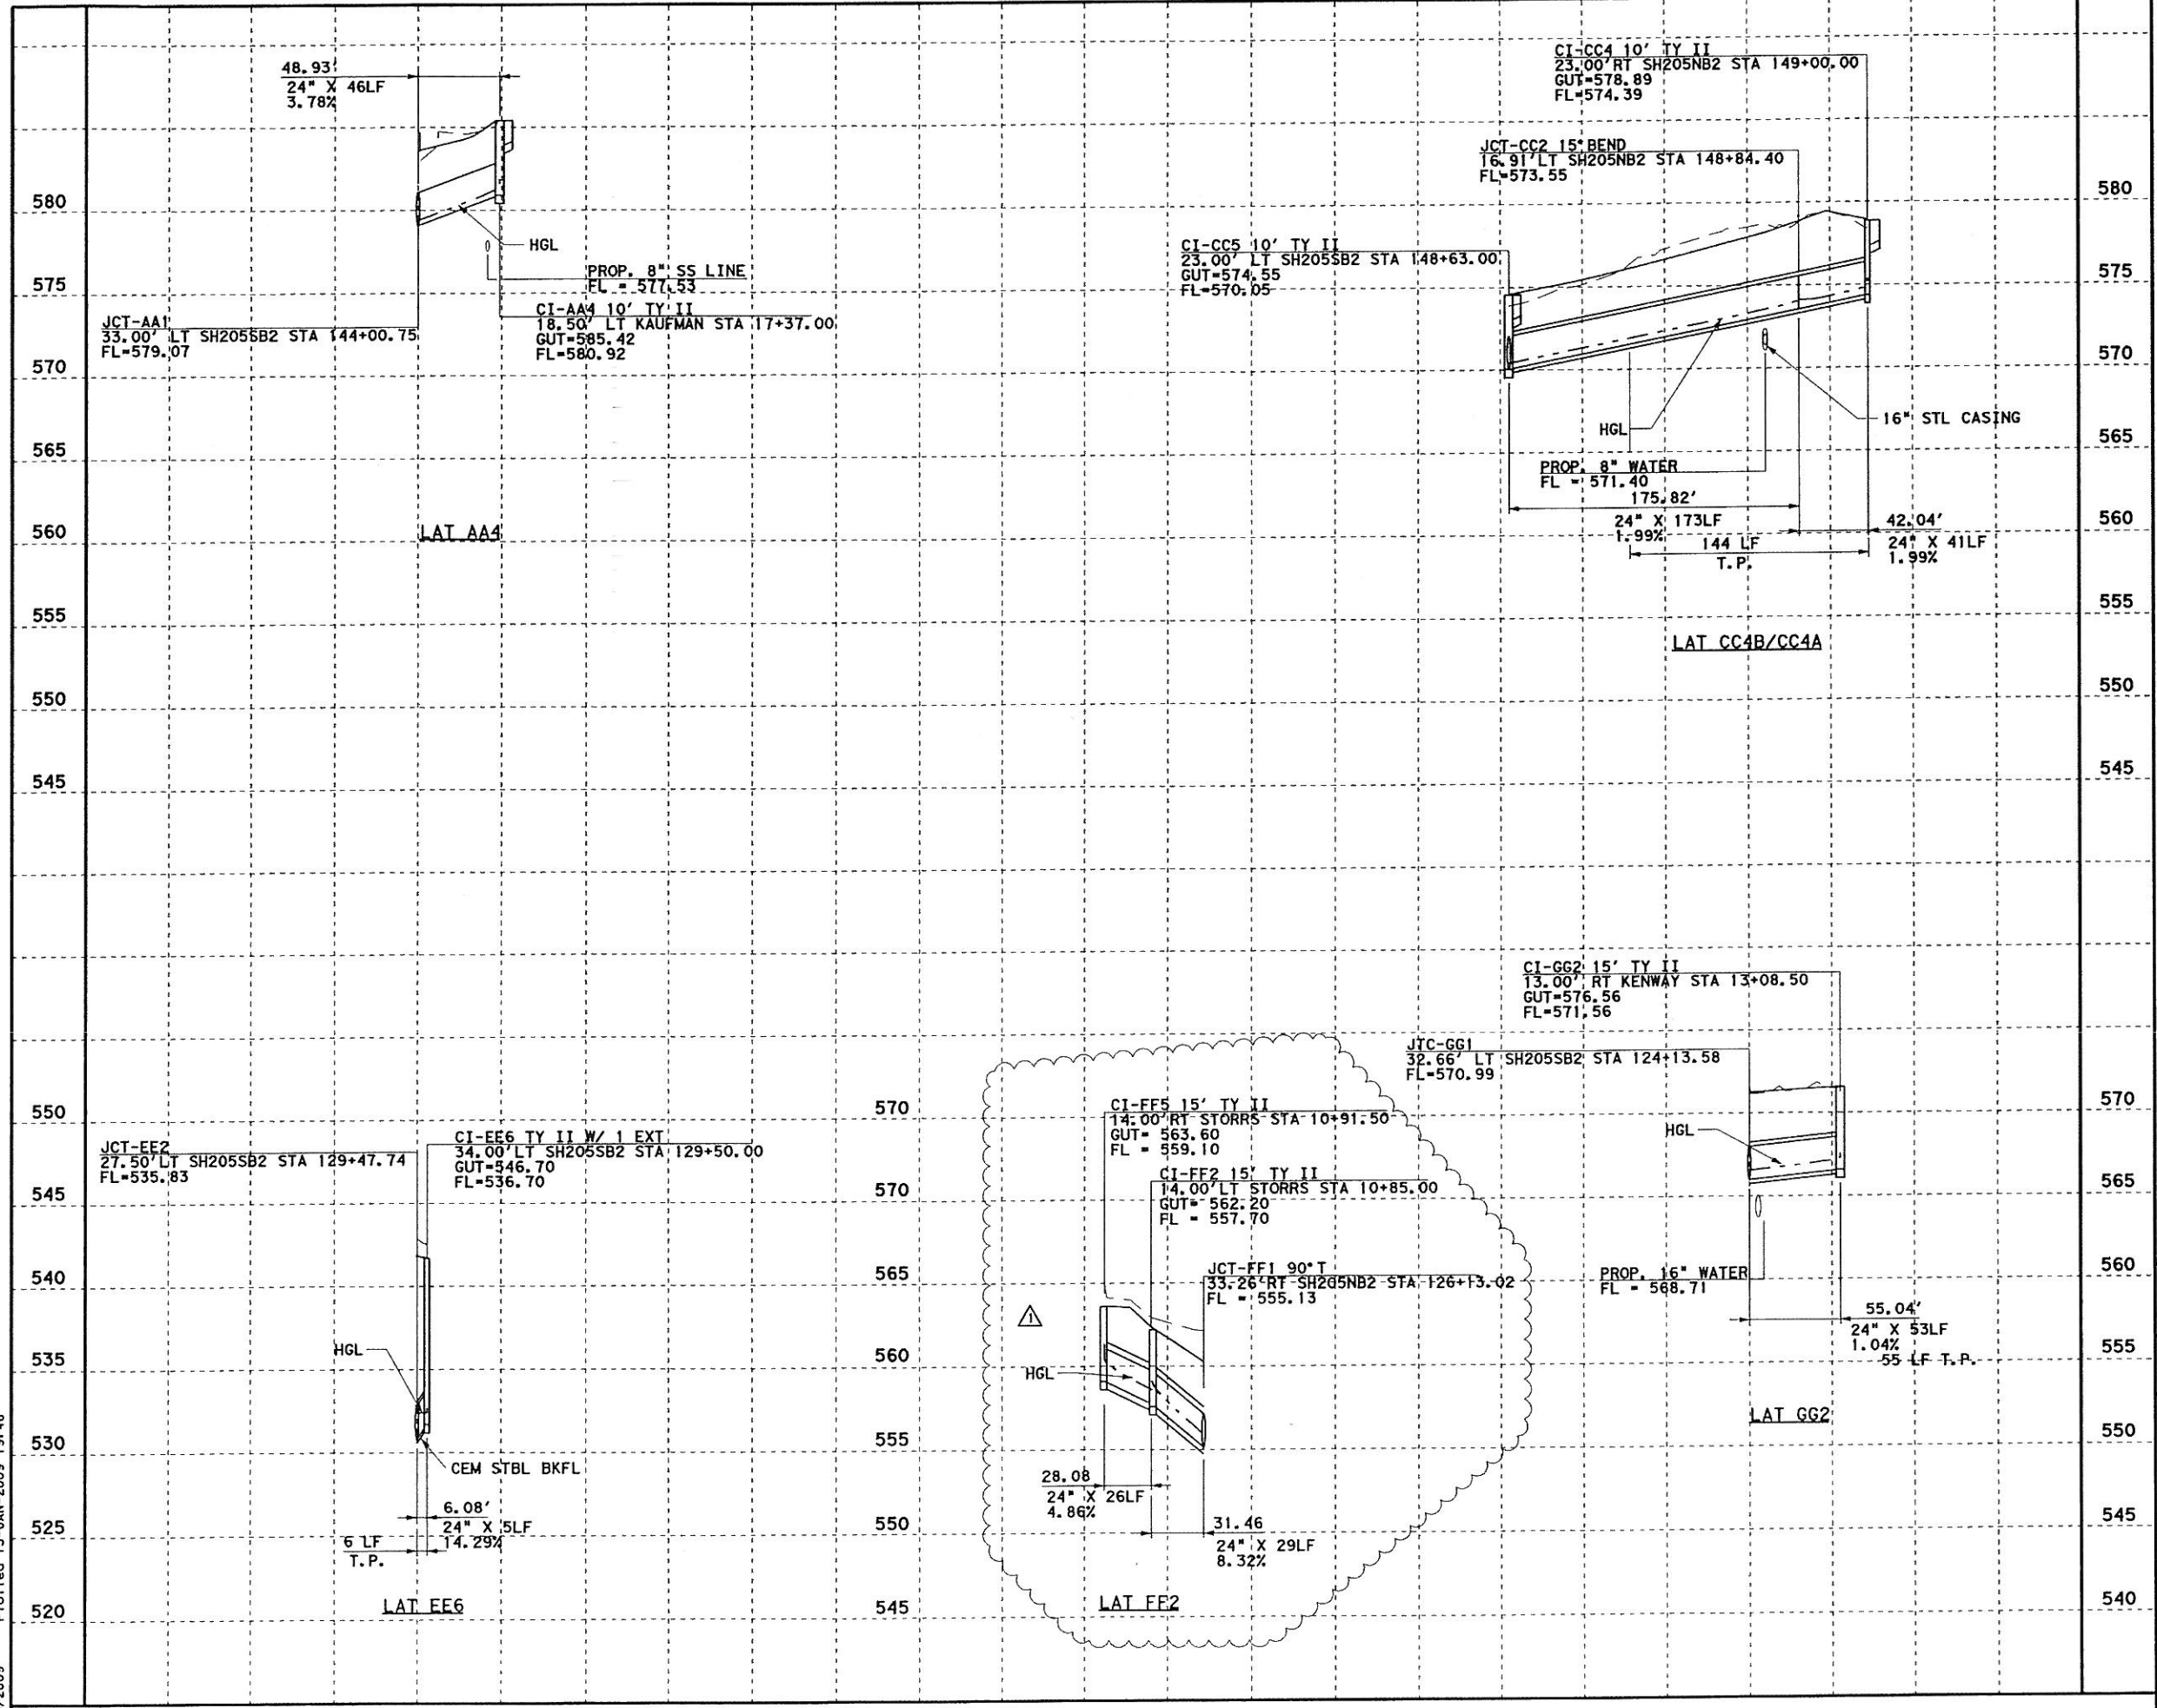

- GENERAL NOTES**
1. CURB INLETS STATION AND OFFSET ARE MEASURED TO THE MIDPOINT OF THE FACE OF MAIN INLET. GRATE INLETS STATION AND OFFSET ARE MEASURED TO THE CENTER OF THE INLET.
 2. JUNCTION BOX STATION AND OFFSET ARE MEASURED TO THE CENTER OF THE JUNCTION BOX.
 3. ALL PIPES ARE CLASS III RCP UNLESS OTHERWISE NOTED.





ORIGINAL PLANS SEALED BY TODD P. CONSTANT, P.E.
 REVISIED LAT FF2 10/20/08 -AM
Parsons Brinckerhoff Quade & Douglas, Inc.
 2777 Stemmons Freeway
 Suite 1333
 Dallas, TX 75207
Texas Department of Transportation
 © 2008

SH 205
DRAINAGE
MISC LINE LATERALS
STORM SEWER LATERAL PROFILES


SHEET 56 OF 57

FED. RD. DIST. NO.	FEDERAL AID PROJECT NO.	HIGHWAY NO.
6	(SEE TITLE SHEET)	SH 205
STATE	DIST.	COUNTY
TEXAS	DALLAS	ROCKWALL
CONTR.	SECT.	JOB
0451	01	032, ETC
		SHEET NO.
		456A

D:\G:\JOBS\22451C-SH205\Drawings\2451\addx02.dwg, ON=LO-622
 5/9/2006 Plotted 09-MAY-2006 14:47

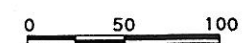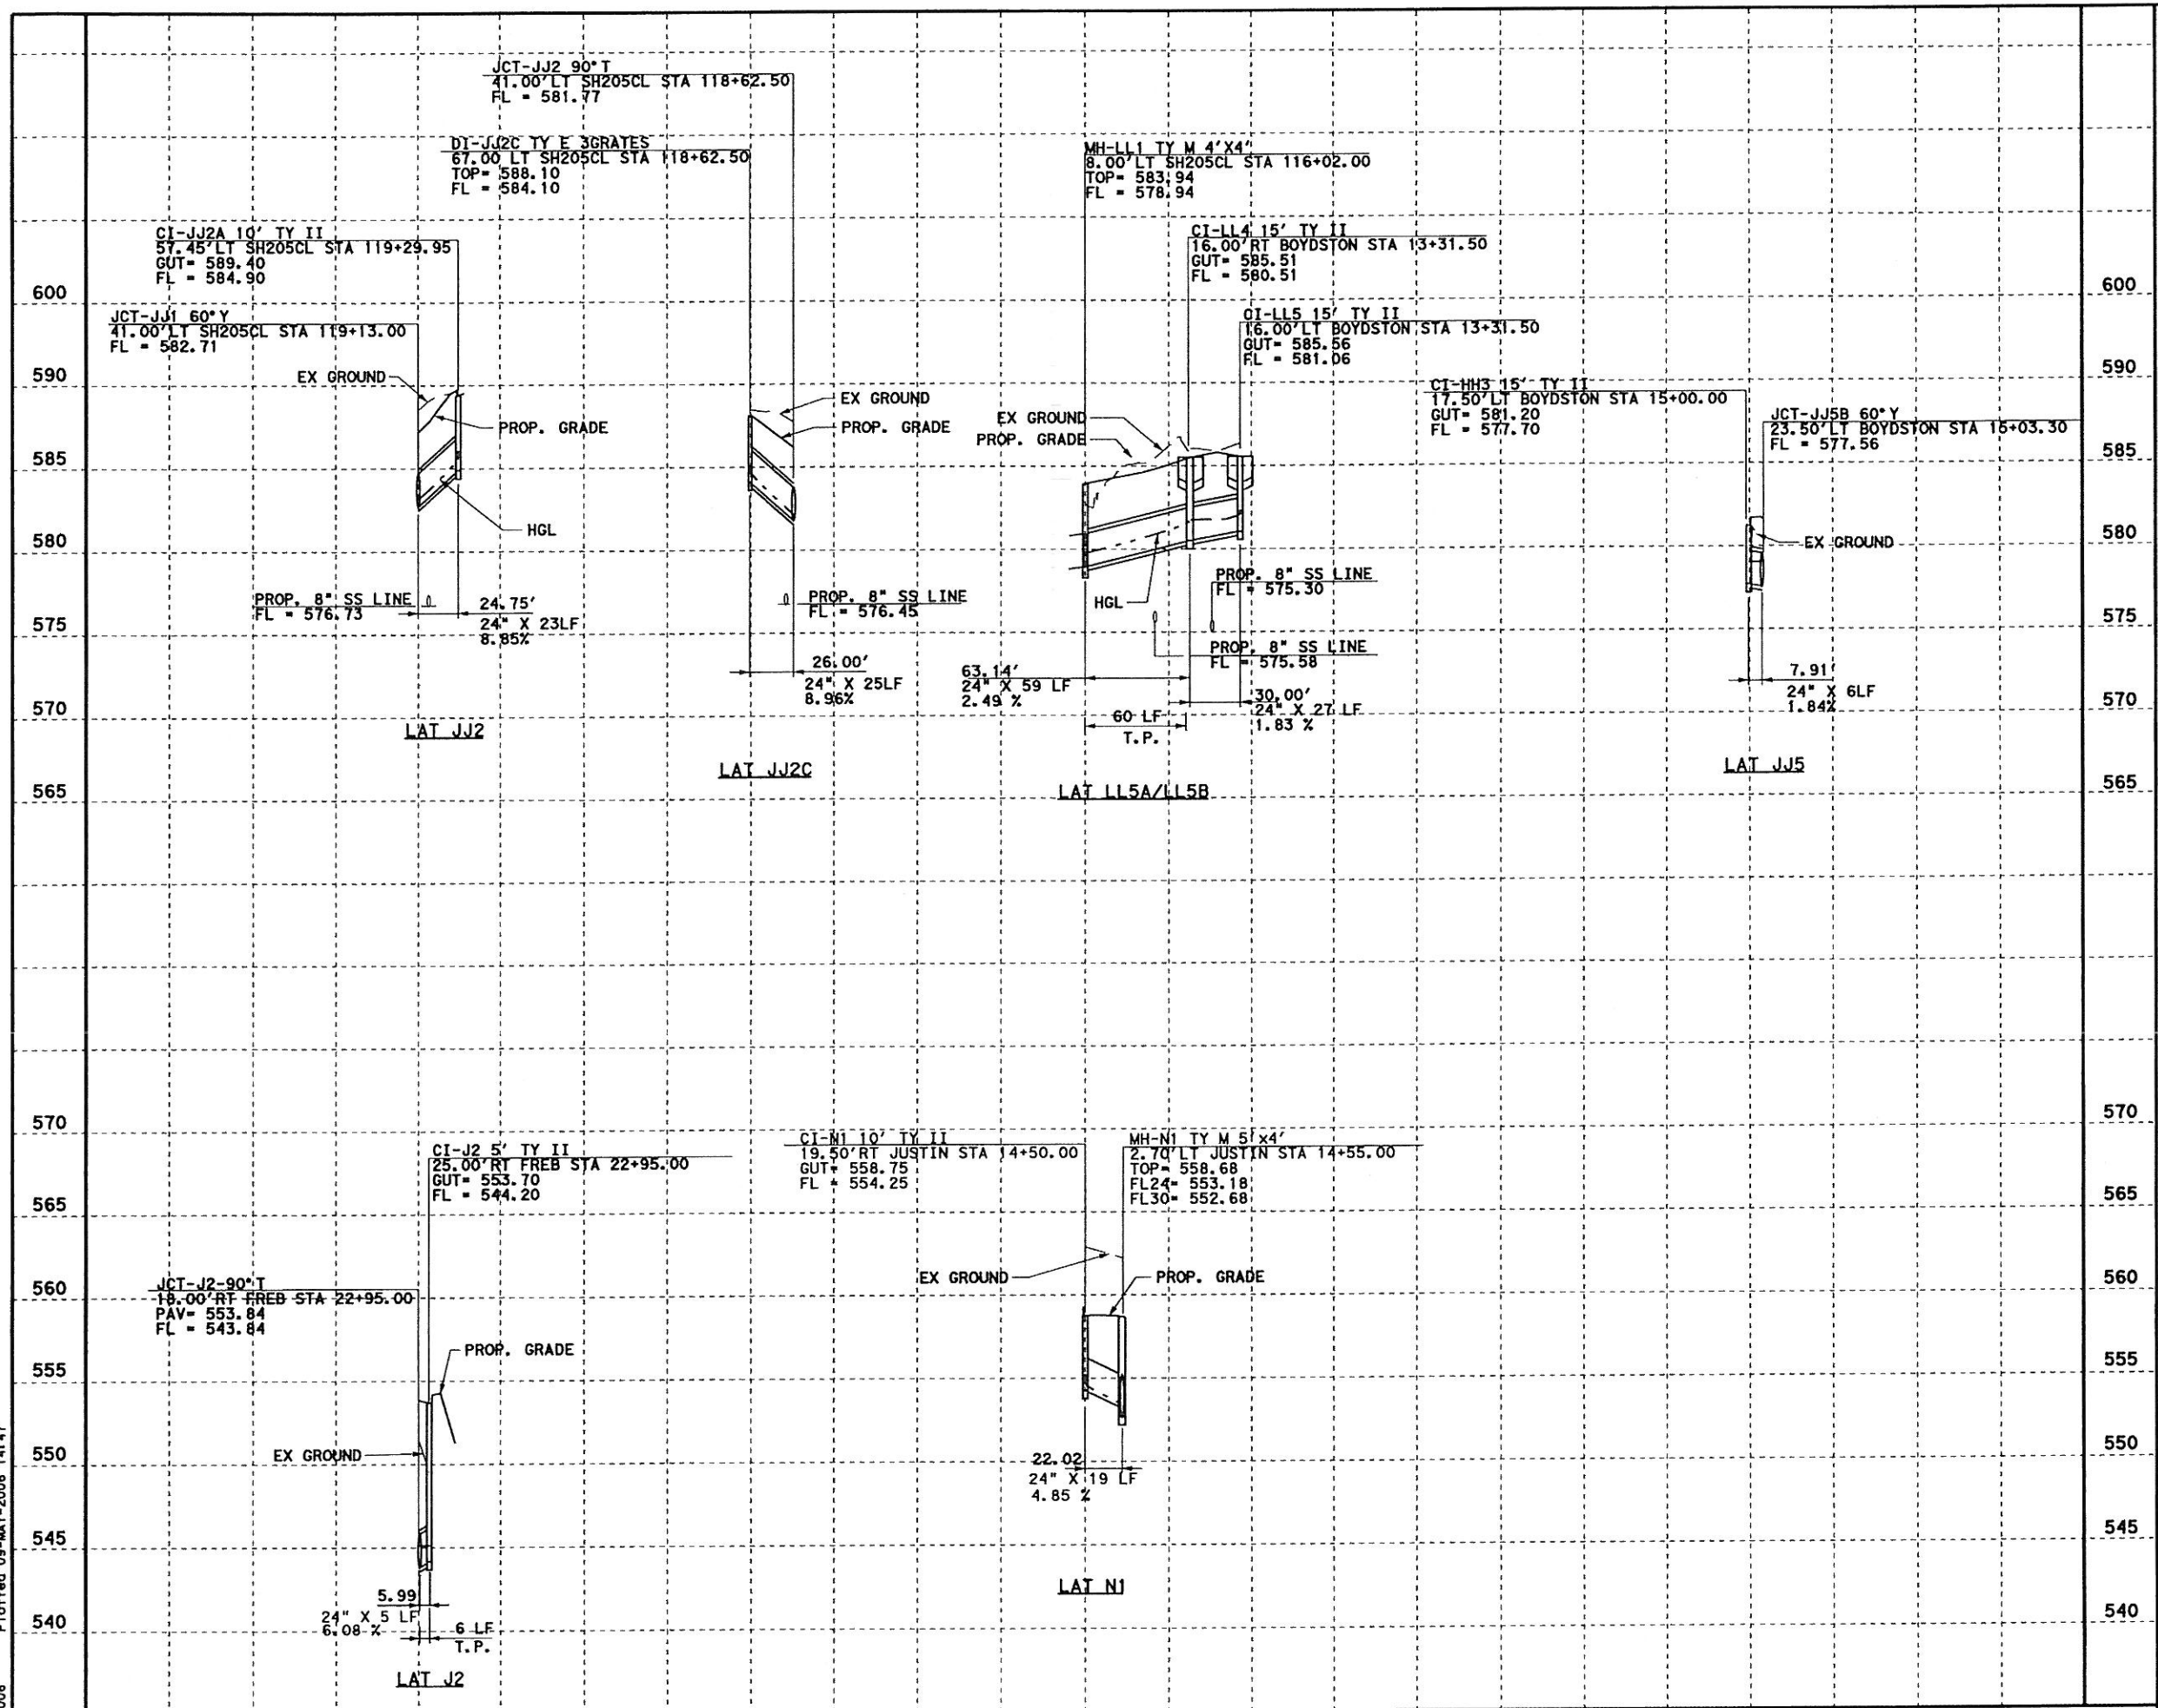

SCALE IN FEET
HORIZONTAL

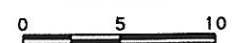

SCALE IN FEET
VERTICAL

GENERAL NOTES

1. CURB INLETS STATION AND OFFSET ARE MEASURED TO THE MIDPOINT OF THE FACE OF MAIN INLET. GRATE INLETS STATION AND OFFSET ARE MEASURED TO THE CENTER OF THE INLET.
2. JUNCTION BOX STATION AND OFFSET ARE MEASURED TO THE CENTER OF THE JUNCTION BOX.
3. ALL PIPES ARE CLASS III RCP UNLESS OTHERWISE NOTED.



Parsons Brinckerhoff Quade & Douglas, Inc.
 2777 Stemmons Freeway
 Suite 1333
 Dallas, TX 75207

Texas Department of Transportation
 © 2006



SH 205

DRAINAGE
 MISC LINE LATERALS
 STORM SEWER LATERAL PROFILES

SHEET 57 OF 57

SHEET NO.		FEDERAL AID PROJECT NO.		HIGHWAY NO.	
6		(SEE TITLE SHEET)		SH 205	
STATE	DIST.	COUNTY		SHEET NO.	
TEXAS	DALLAS	ROCKWALL		457	
CONT.	SECT.	JOB			
0451	01	032, ETC			

DGN=01\JOBS\22451C-SH205\Drainage\2451\addx02-REVA.dgn, ON=10-621
5/14/2008 Plotted 14-MAY-2008 17:55

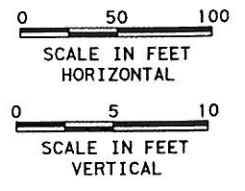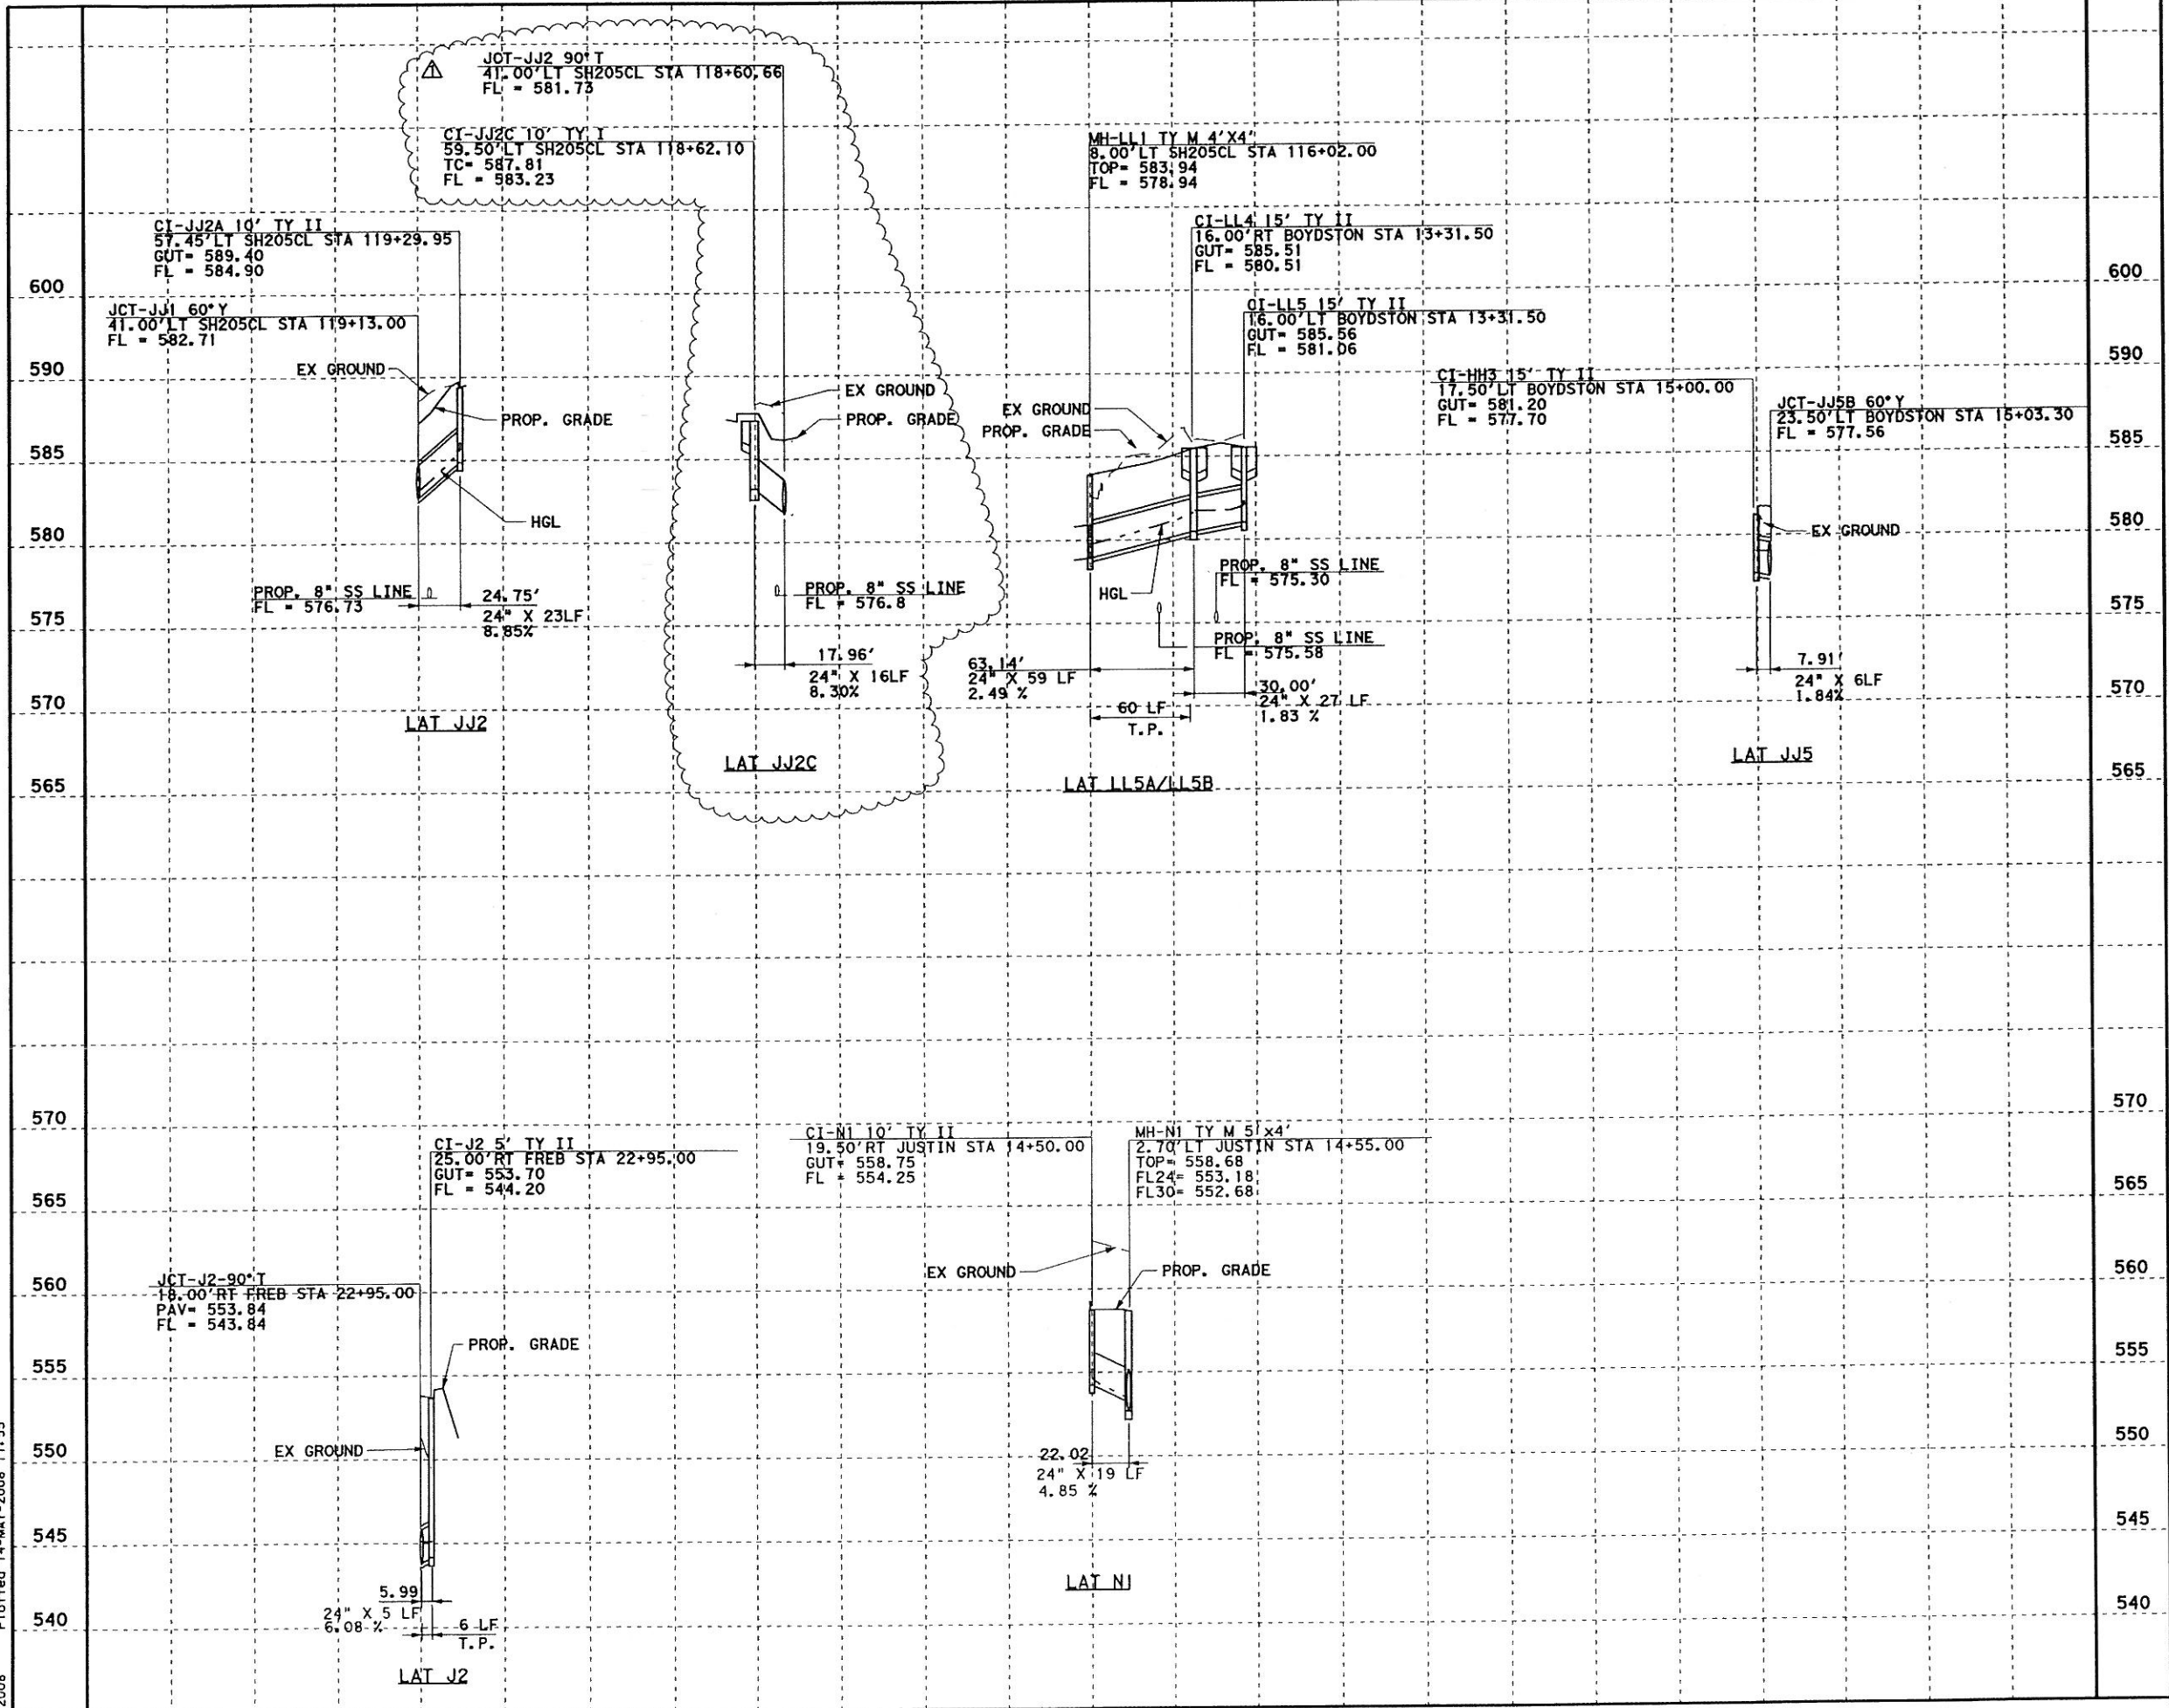

- GENERAL NOTES**
1. CURB INLETS STATION AND OFFSET ARE MEASURED TO THE MIDPOINT OF THE FACE OF MAIN INLET. GRATE INLETS STATION AND OFFSET ARE MEASURED TO THE CENTER OF THE INLET.
 2. JUNCTION BOX STATION AND OFFSET ARE MEASURED TO THE CENTER OF THE JUNCTION BOX.
 3. ALL PIPES ARE CLASS III RCP UNLESS OTHERWISE NOTED.

△ REVISED BY DG 05-12-2008
REPLACED DI-JJ2C TY E TO CI-JJ2C TY I



K. David Gan 5/14/08

PB Parsons Brinckerhoff Quade & Douglas, Inc.
2777 Stemmons Freeway
Suite 1333
Dallas, TX 75207

Texas Department of Transportation
© 2008

SH 205

DRAINAGE
MISC LINE LATERALS
STORM SEWER LATERAL PROFILES

SHEET 57 OF 57

FED. RD. DIST. NO.	FEDERAL AID PROJECT NO.	HIGHWAY NO.
6	(SEE TITLE SHEET)	SH 205
STATE	DIST.	COUNTY
TEXAS	DALLAS	ROCKWALL
CONT.	SECT.	JOB
0451	01	032, ETC