



• SKETCH SHOWING ELEVATION

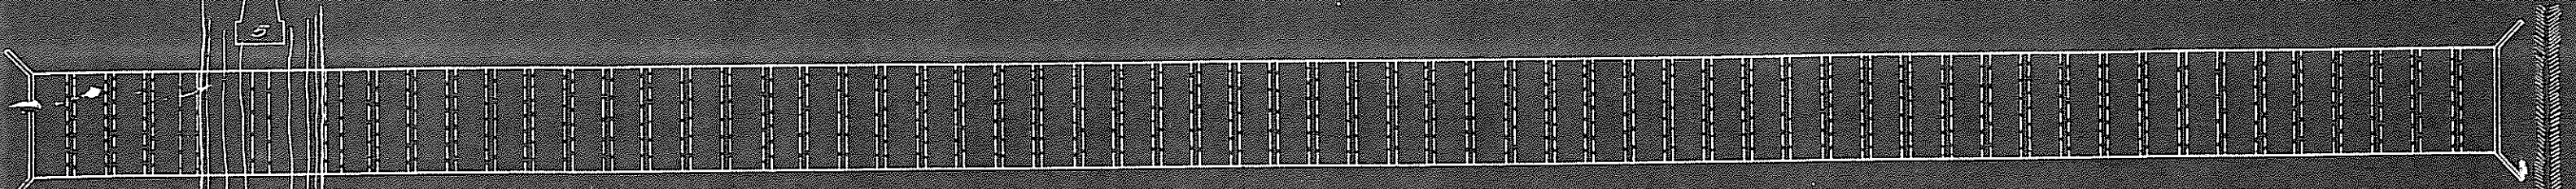

SKETCH SHOWING PLAN

TOTAL LENGTH - FACE TO FACE OF ABUTMENTS 1252'

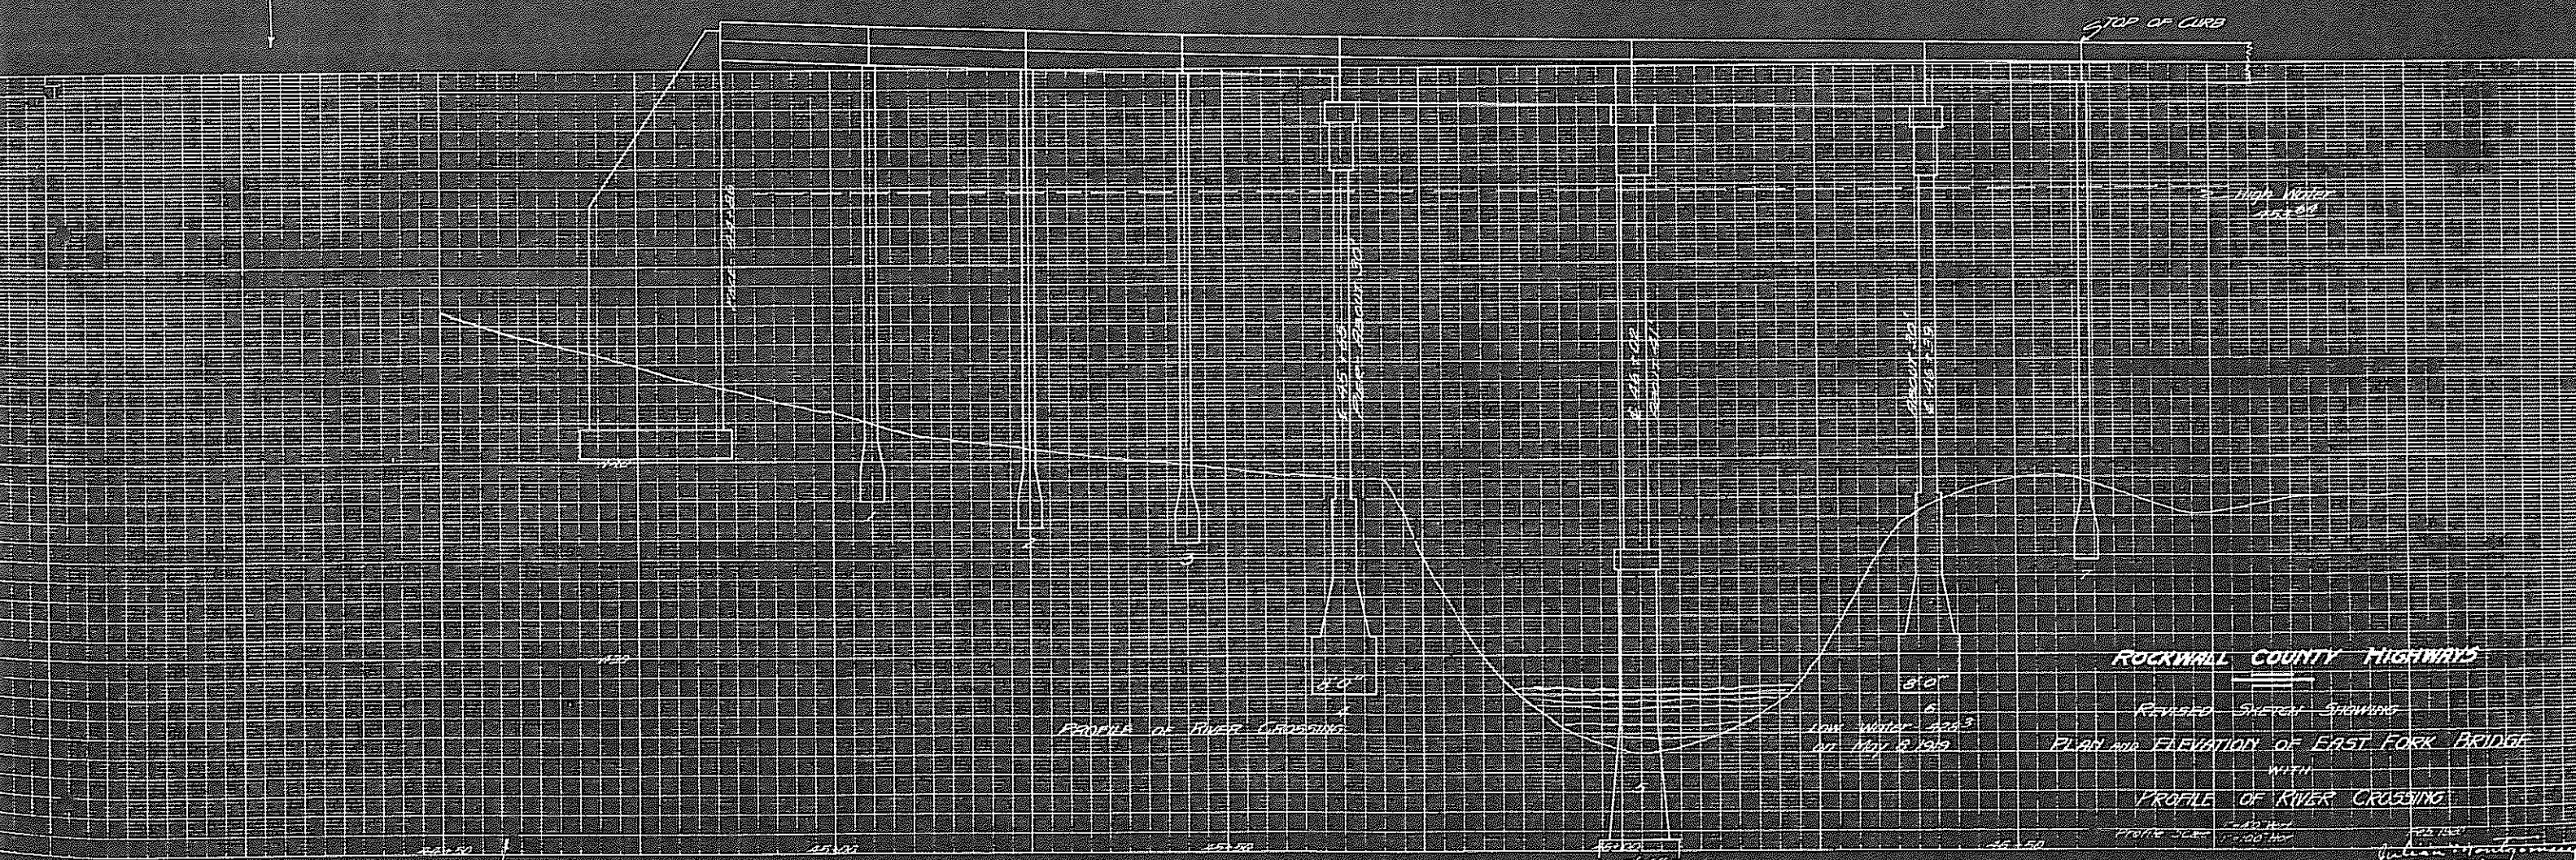

PROFILE OF RIVER CROSSING

LOW WATER 225.3
 ON MAY 8 1959

ROCKWALL COUNTY HIGHWAYS
 REVISION SKETCH SHOWING
 PLAN AND ELEVATION OF EAST FORK BRIDGE
 WITH
 PROFILE OF RIVER CROSSING

PROFILE SCALE
 1" = 100' HOR.
 1" = 10' VER.

J. H. ...
 CIVIL ENGINEER