


1951	1952	1953	1954	1955
6	7	8	9	10

DATE	DESCRIPTION	JOB NO.	BY	CHECKED
2	REVISION	107		

*City Limits Rock Wall
1938 R.O.W. Map (1951)*

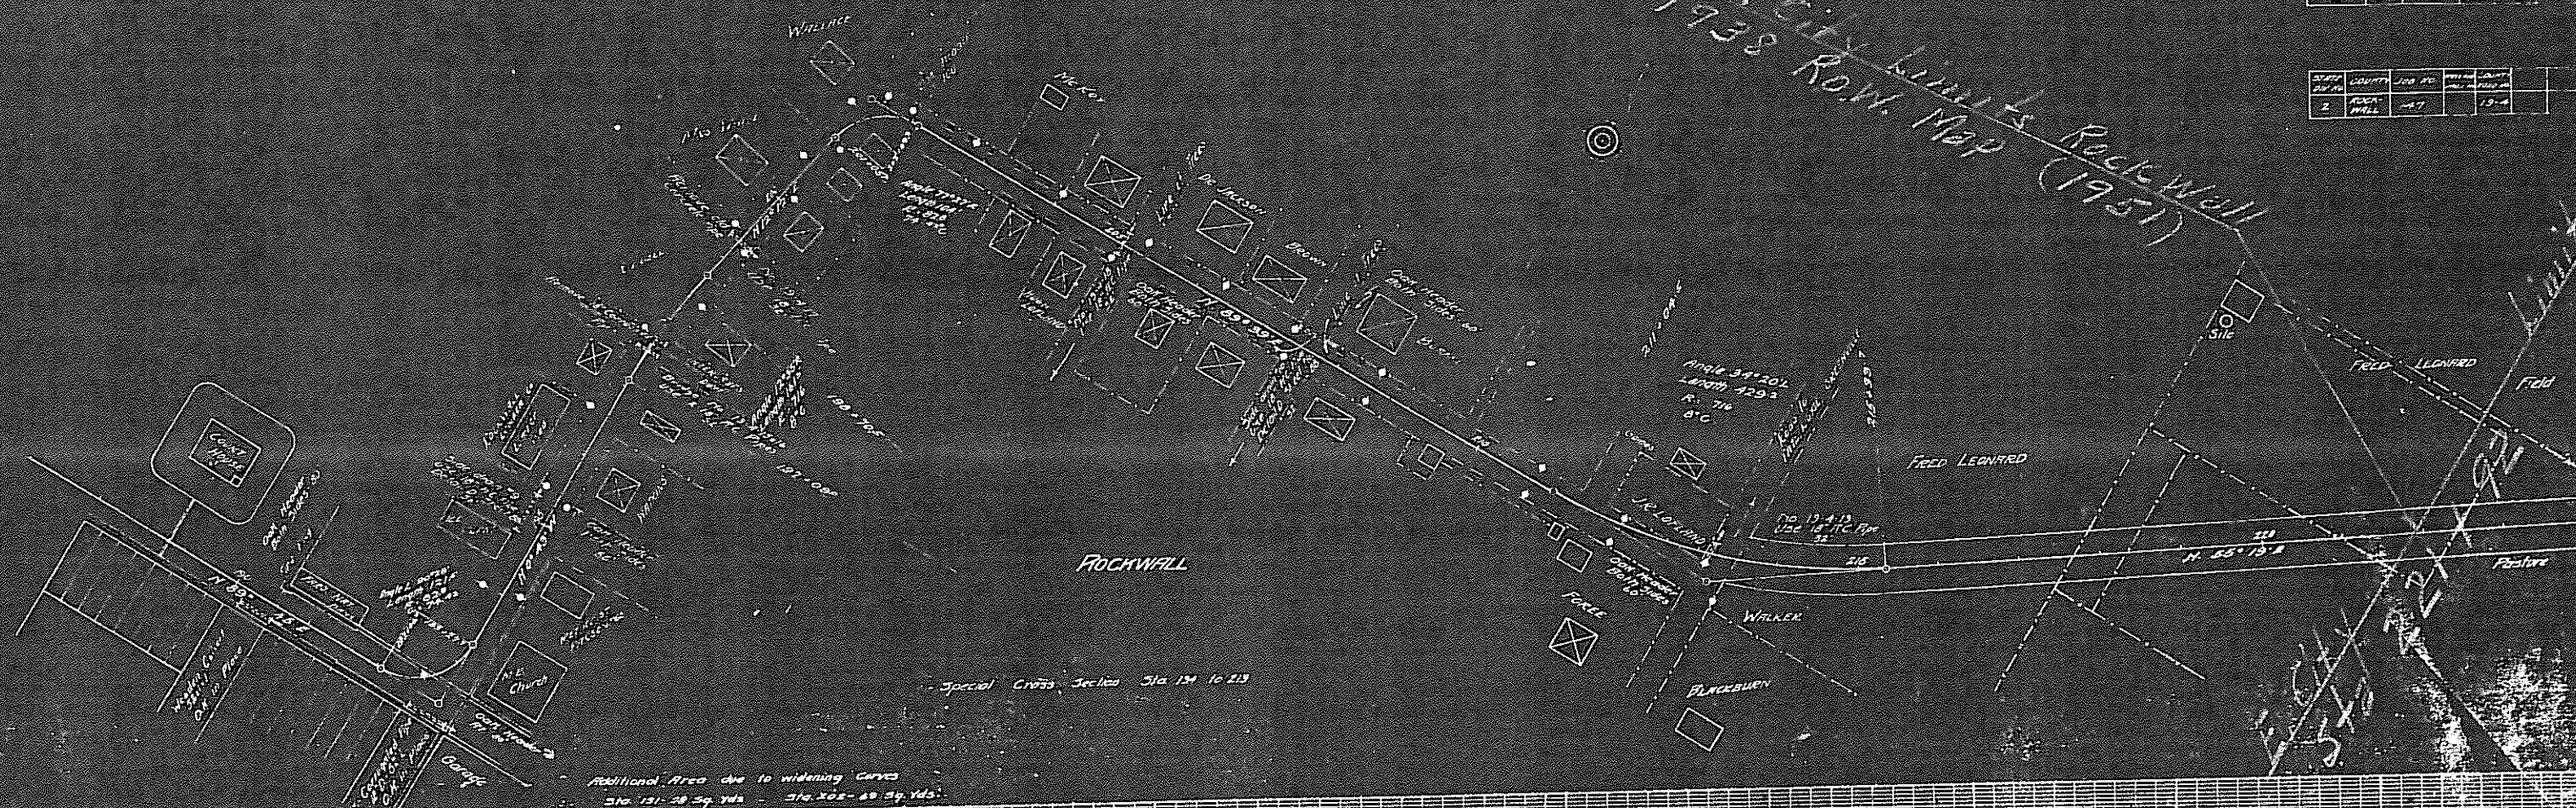

Additional Area due to widening Curves
Sta 121+28 Sp. Yds - Sta 102+69 Sp. Yds.

Special Cross Section Sta 124 to 129

