
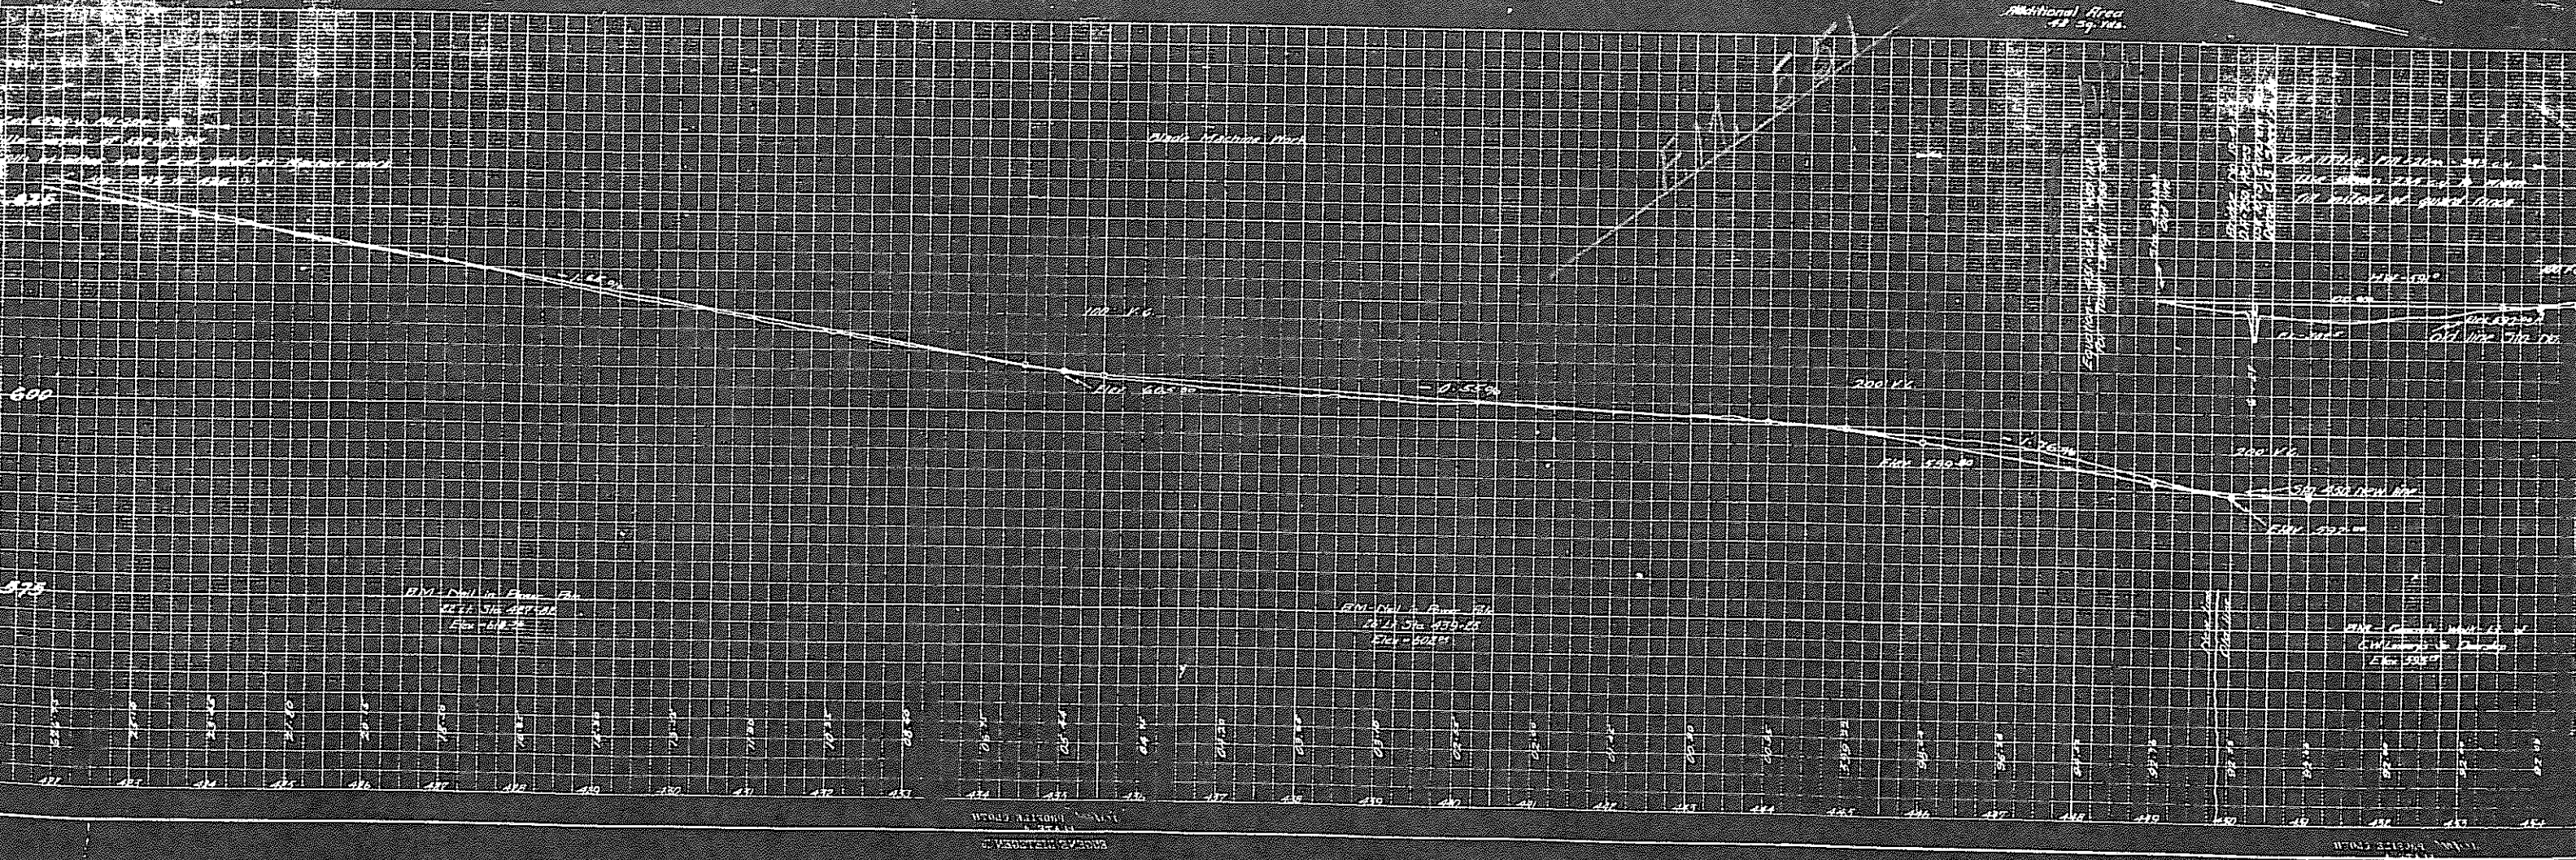


NO. 1	DATE	BY	SCALE	DATE	BY
6	1917	100	1:250	19	85

NO. 2	DATE	BY	SCALE	DATE	BY
2	1917	197	1:250	19	85

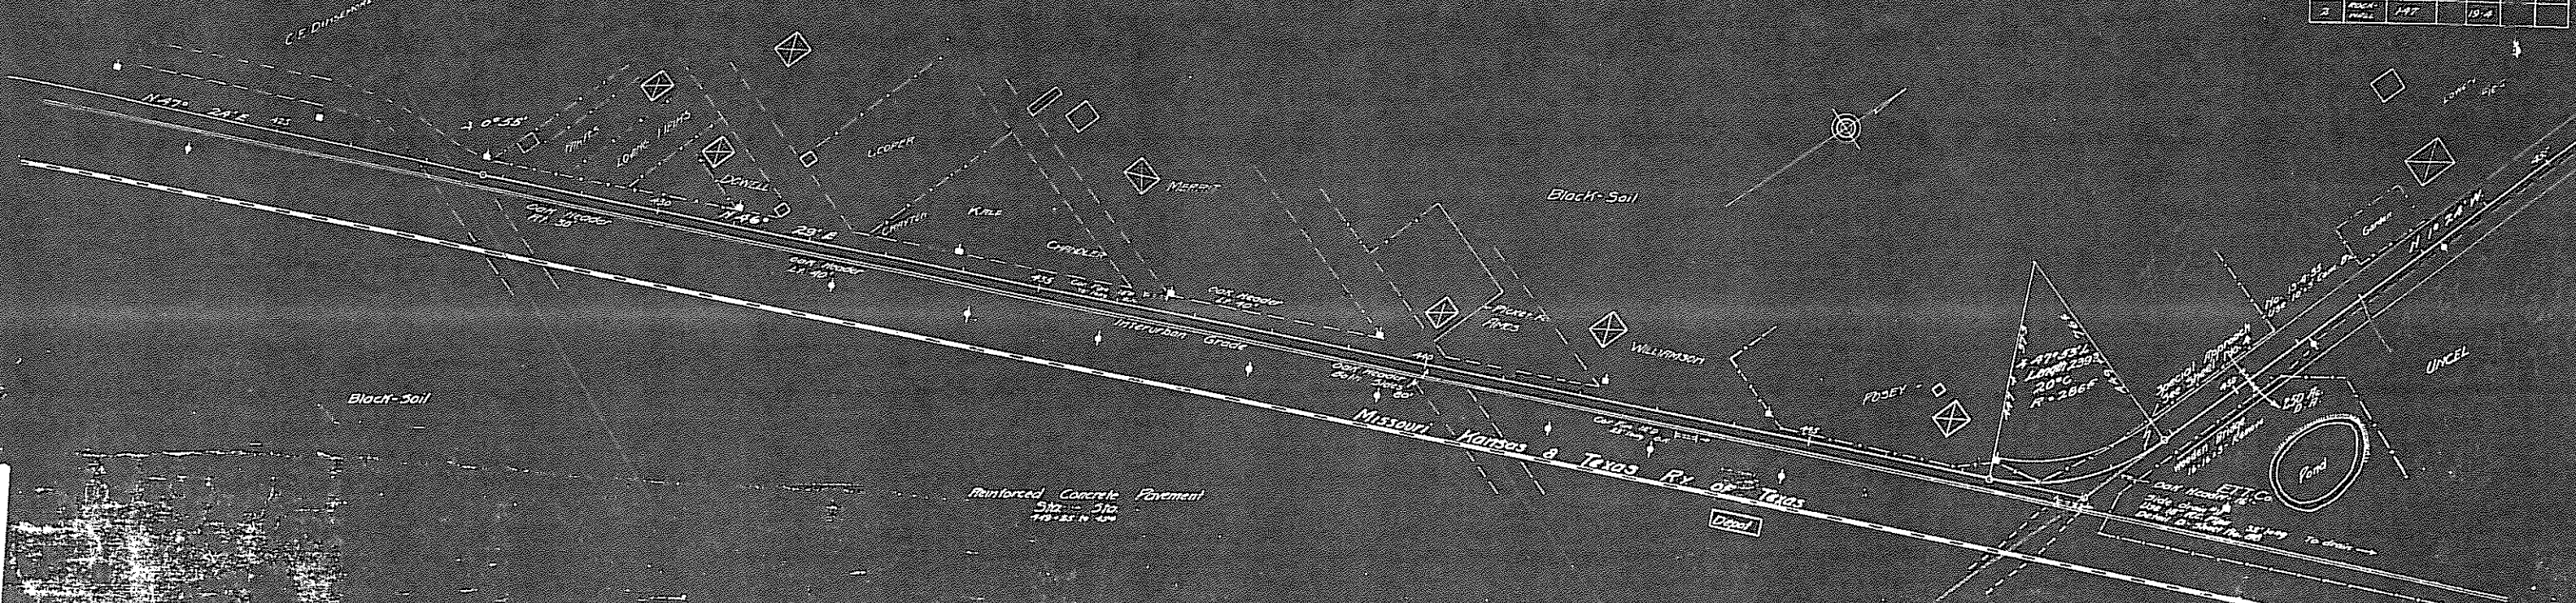

WORLD RAILROAD  
 ENGINEERING

LINEAR DISTANCE  
 IN FEET FROM