



THE SEAL APPEARING ON THIS DRAWING WAS AUTHORIZED BY CHRISTOPHER R. CUNY, P.E. 65642

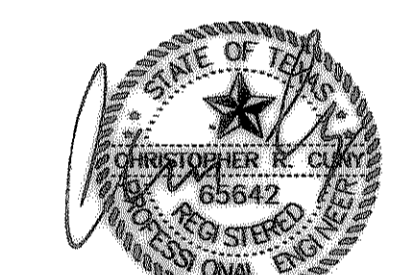

8-22-2007

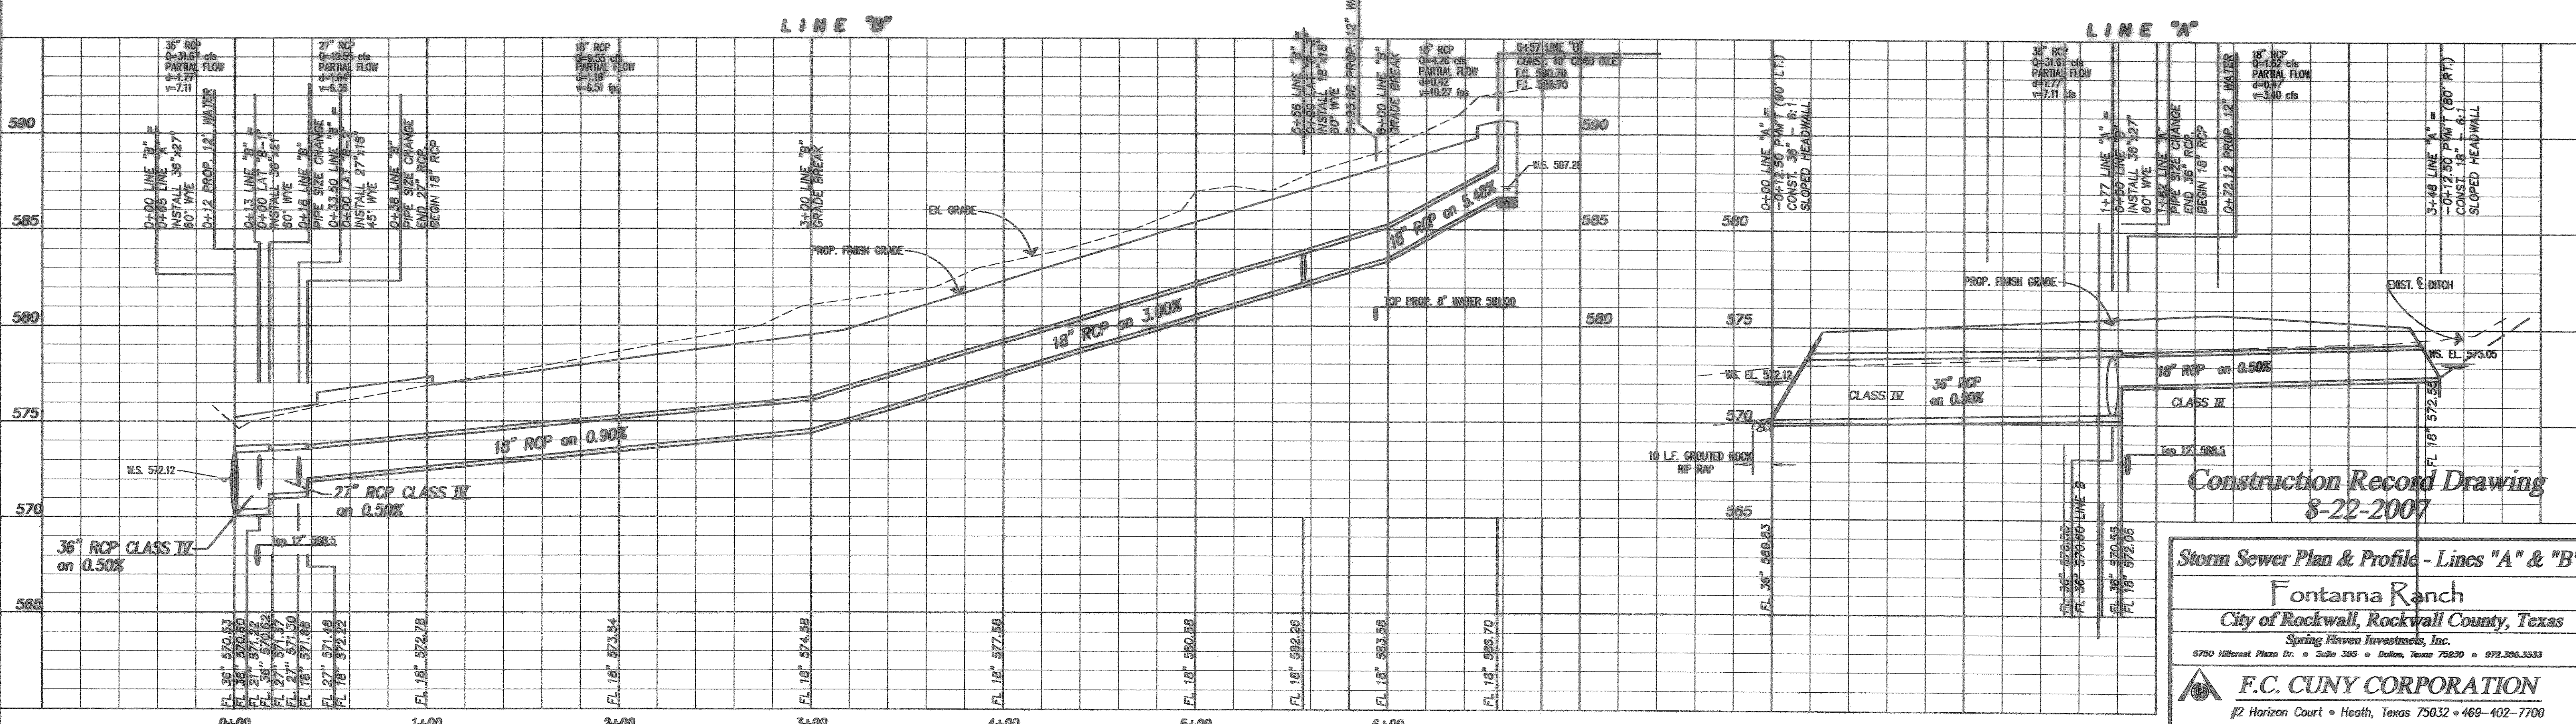

Construction Record Drawing
8-22-2007

Storm Sewer Plan & Profile - Lines "A" & "B"
Fontanna Ranch
 City of Rockwall, Rockwall County, Texas
 Spring Haven Investments, Inc.
 8750 Hillcrest Plaza Dr. • Suite 305 • Dallas, Texas 75230 • 972.386.3333

F.C. CUNY CORPORATION
 #2 Horizon Court • Heath, Texas 75032 • 469-402-7700

Drawn By:	Checked By:	Date:	Scale:	Project No.:	Sheet No.:
MSC	DW	10/16/06	1"=40'	05-013	24 of 45

Z:\Projects\Res-Identical\Fontanna\Record Drawings\Font-Splan_A - B.dwg Tue Sep 18 09:35:16 2007