
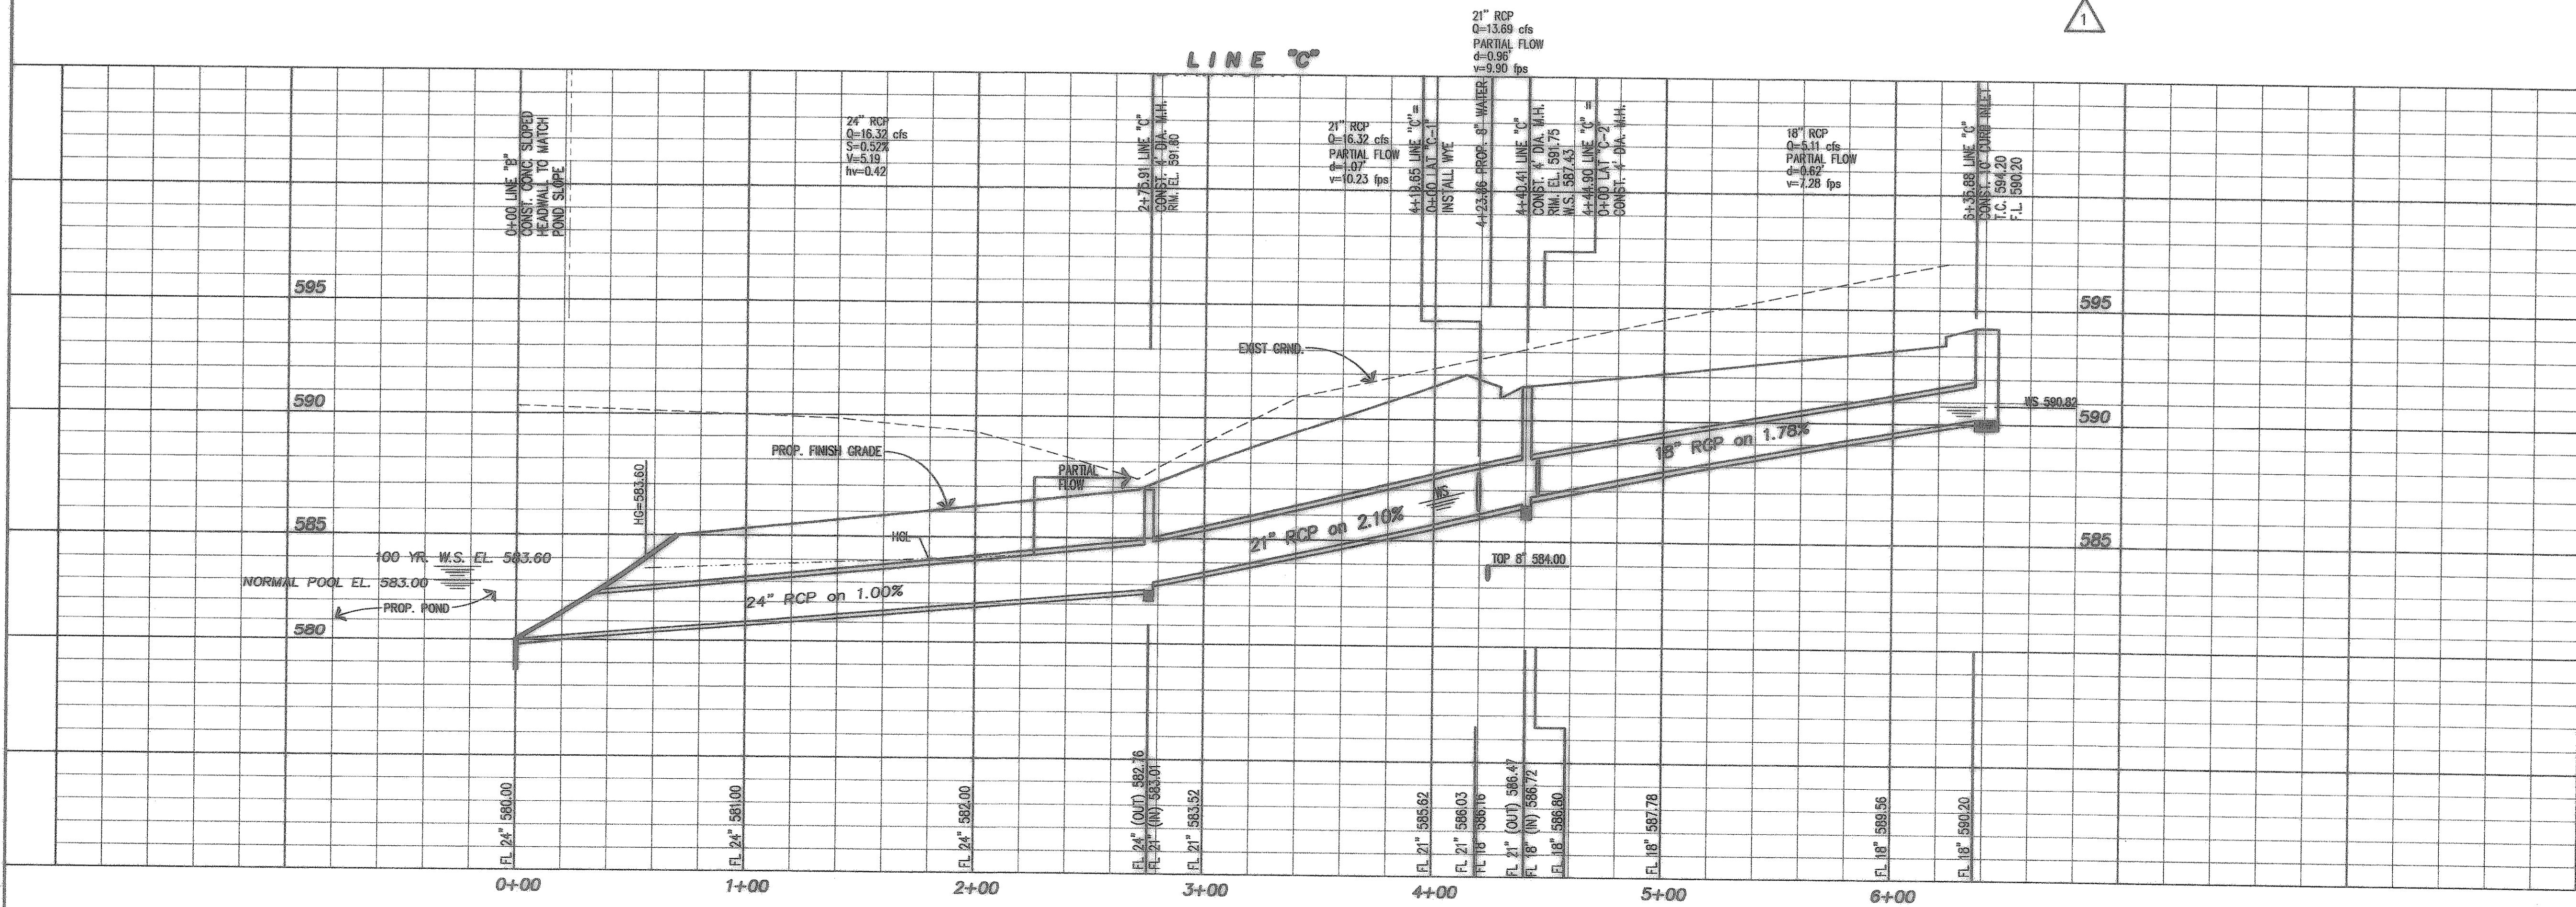


| REVISION | DATE     | DESCRIPTION   |
|----------|----------|---------------|
| 1        | 11/26/06 | Station Revs. |

THE SEAL APPEARING ON THIS DOCUMENT WAS AUTHORIZED BY CHRISTOPHER R. CUNY, P.E. 65642

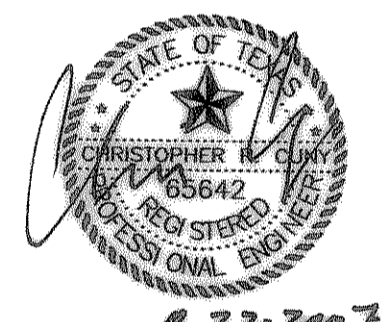

Construction Record Drawing  
8-22-2007

**Storm Sewer Plan & Profile - Line "C"**  
Fontanna Ranch  
City of Rockwall, Rockwall County, Texas  
Spring Haven Investments, Inc.  
6750 Hillcrest Plaza Dr. • Suite 305 • Dallas, Texas 75230 • 972.306.3333

**F.C. CUNY CORPORATION**  
#2 Horizon Court • Heath, Texas 75032 • 469-402-7700

| Drawn By: | Checked By: | Date:    | Scale:       | Project No.: | Sheet No.: |
|-----------|-------------|----------|--------------|--------------|------------|
| MSC       | DW          | 10/18/06 | 1/4" = 1'-0" | 05-013       | 25 of 45   |

Z:\Projects\5-Residential\Fontanna\Record Drawings\Fort-Stalin\_Crevised.dwg Thu Aug 23 10:00:05 2007