



Z:\Projects\5-Residential\Fontanna Record Drawings\font-laterals.dwg Fri Aug 24 13:22:22 2007

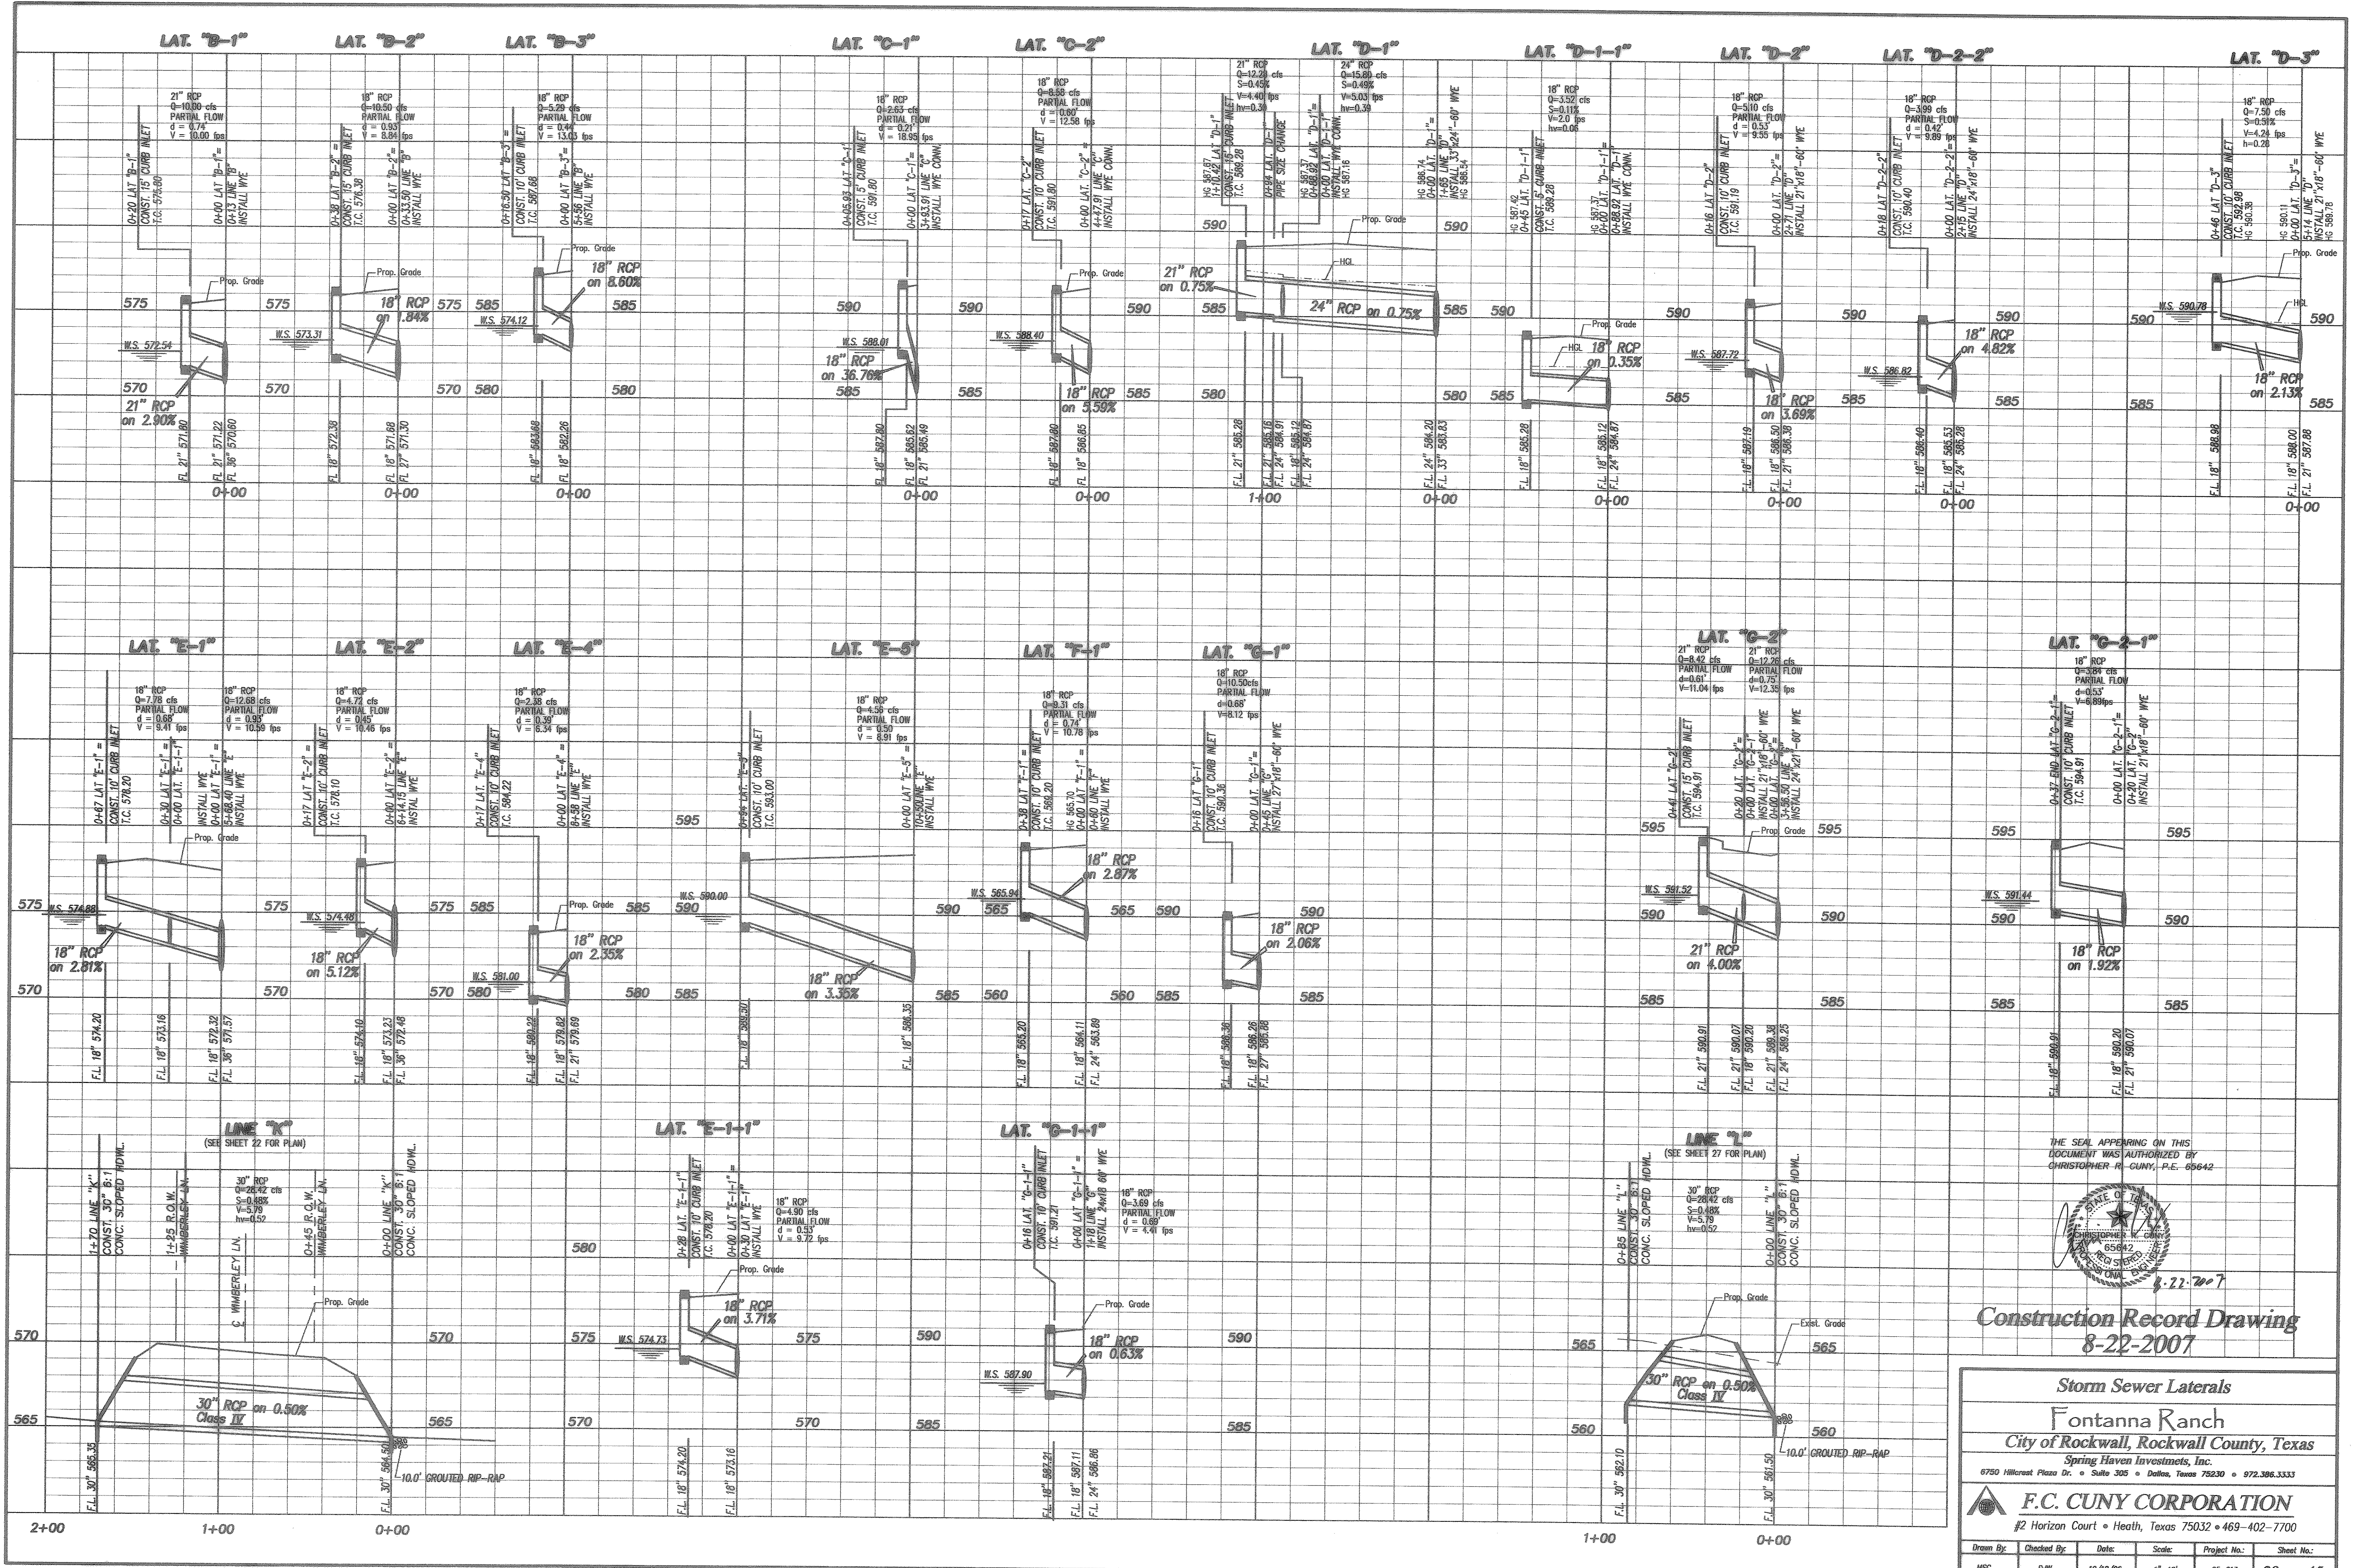

THE SEAL APPEARING ON THIS DOCUMENT WAS AUTHORIZED BY CHRISTOPHER R. CUNY, P.E. 05642

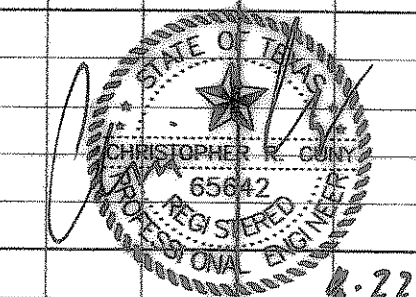

8-22-2007
Construction Record Drawing
8-22-2007

Storm Sewer Laterals
Fontanna Ranch
 City of Rockwall, Rockwall County, Texas
 Spring Haven Investments, Inc.
 6750 Hillcrest Plaza Dr. • Suite 305 • Dallas, Texas 75230 • 972.398.3333

F.C. CUNY CORPORATION
 #2 Horizon Court • Heath, Texas 75032 • 469-402-7700

Drawn By:	Checked By:	Date:	Scale:	Project No.:	Sheet No.:
MSC	DJW	10/18/06	1"=40'	05-013	29 of 45