



Z:\Projects\15-Residential\Fontanna\Record Drawings\font-smb.dwg Fri Aug 24 13:06:32 2007

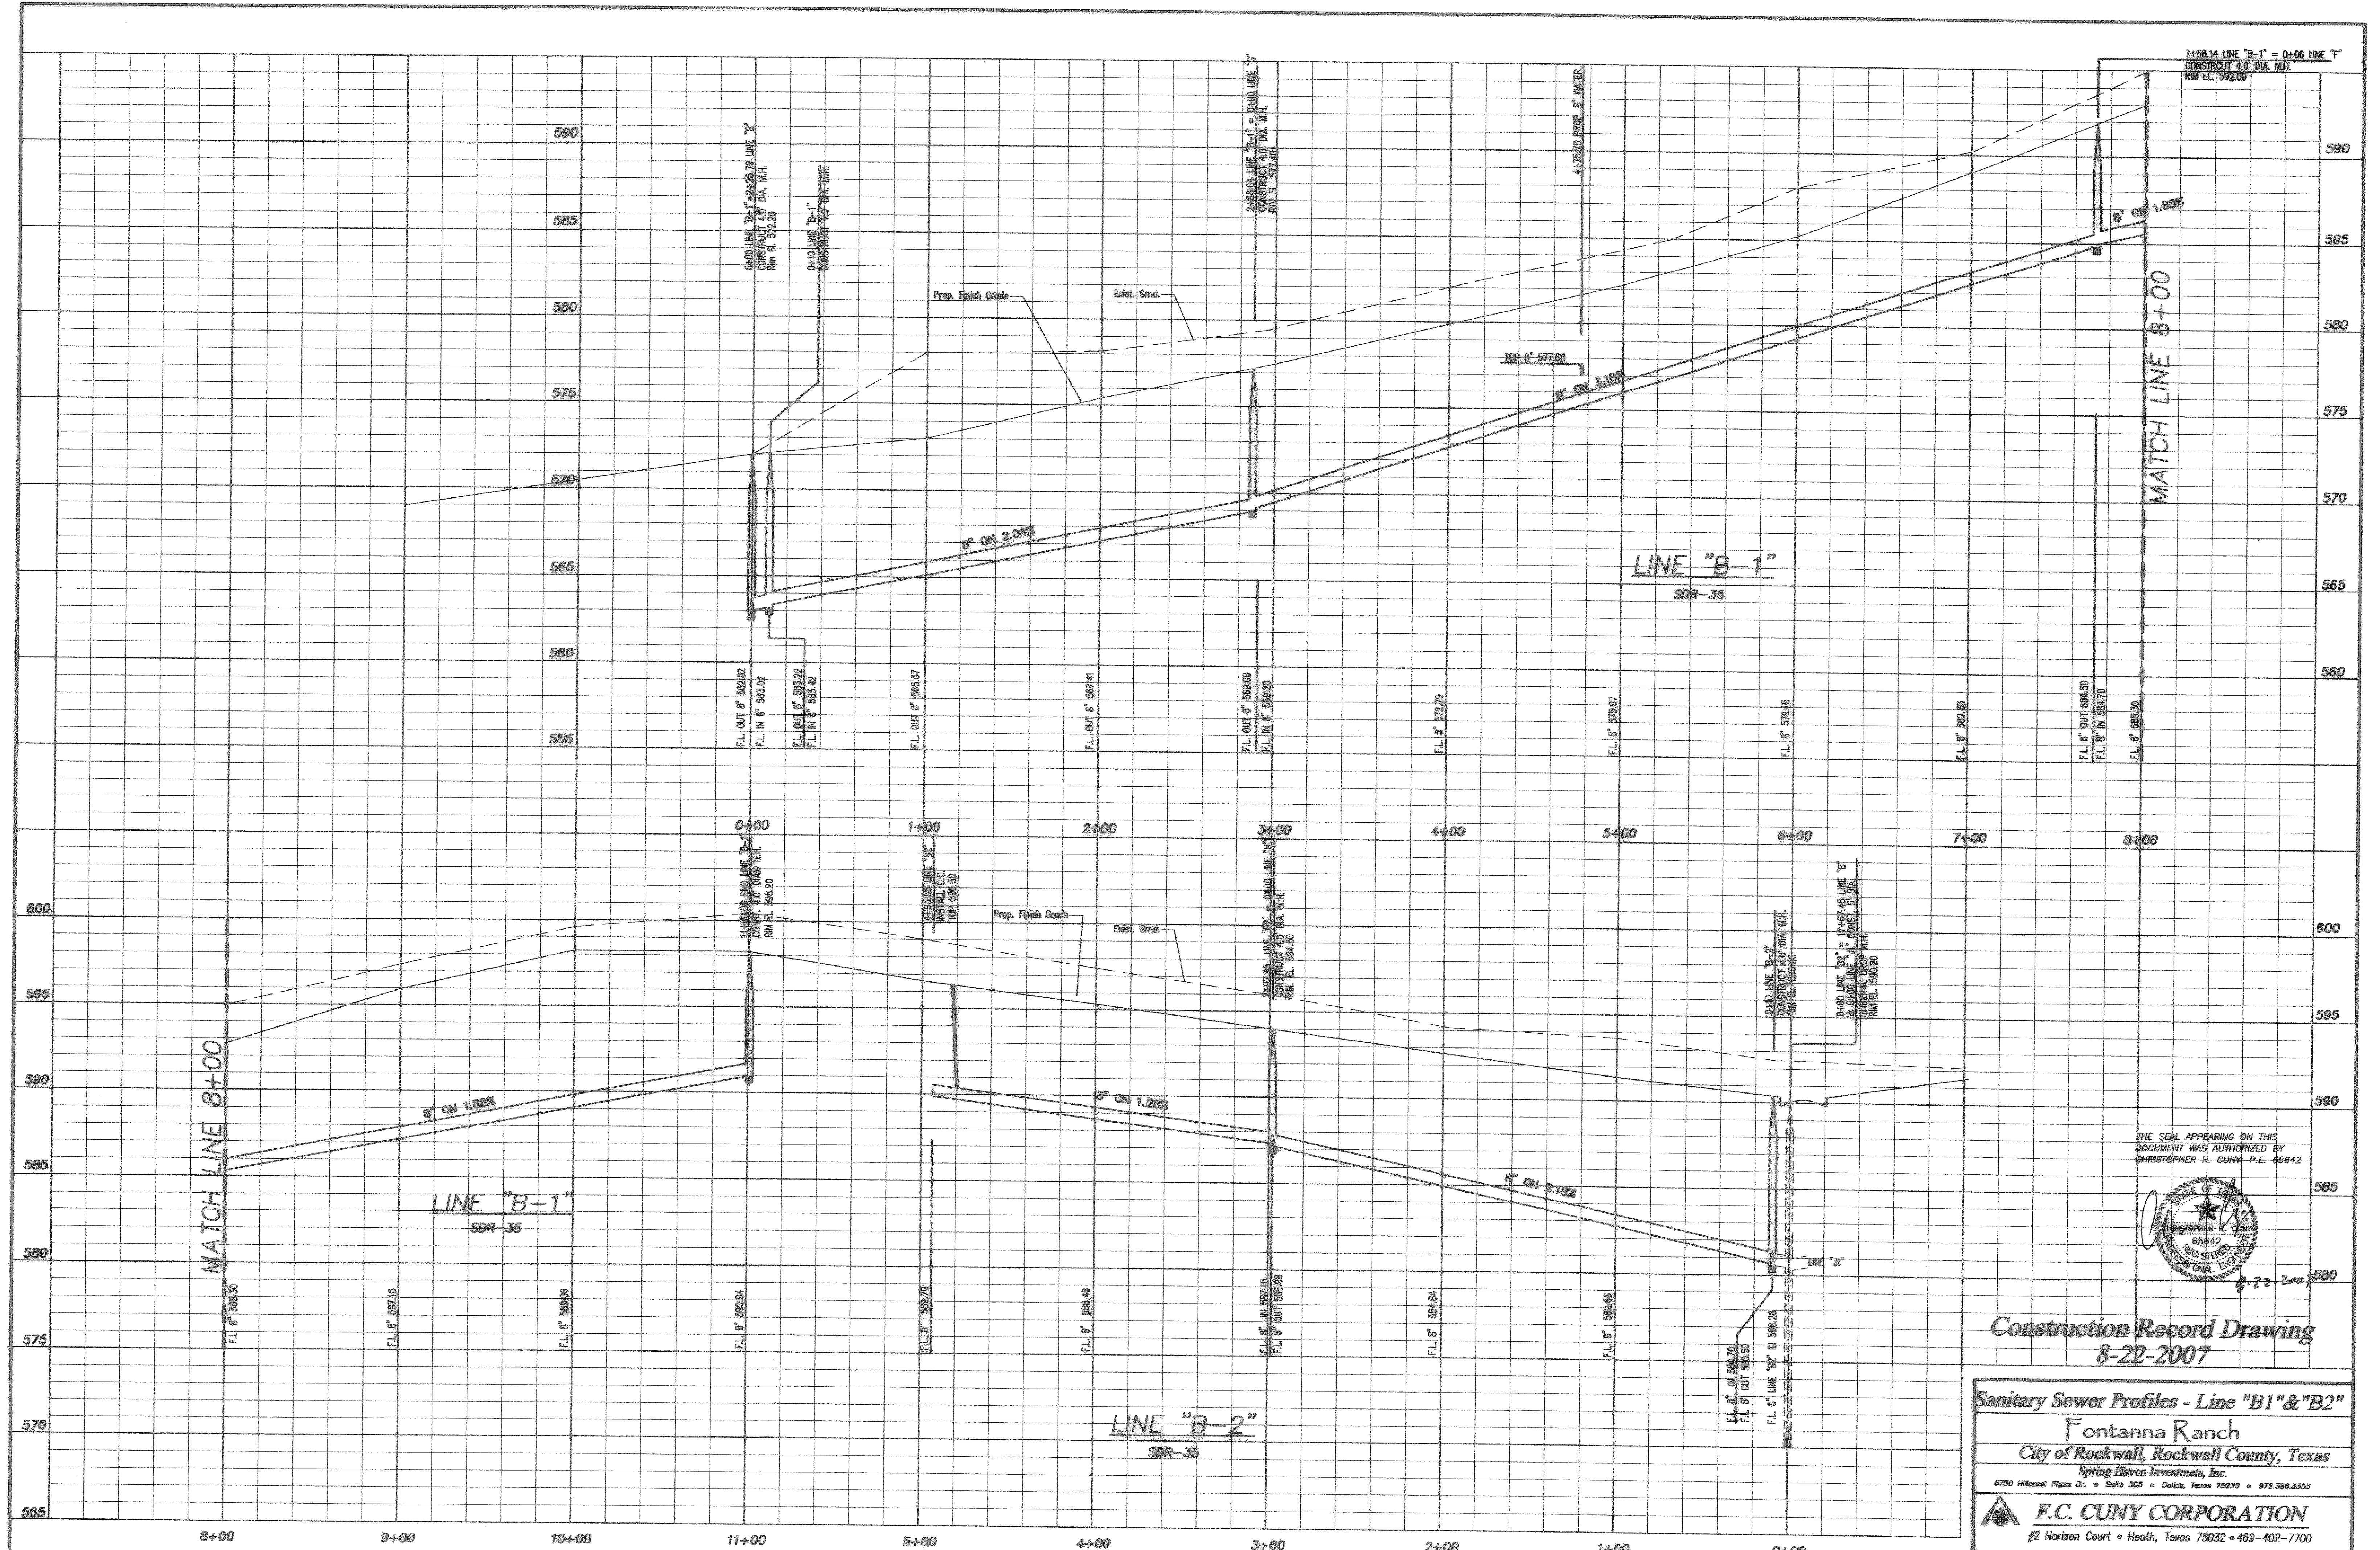

THE SEAL APPEARING ON THIS DOCUMENT WAS AUTHORIZED BY CHRISTOPHER R. CUNY, P.E. 65642

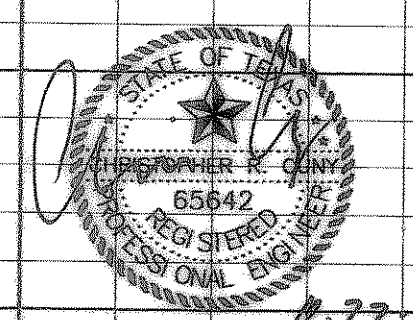

Construction Record Drawing
8-22-2007

Sanitary Sewer Profiles - Line "B1" & "B2"
Fontanna Ranch
 City of Rockwall, Rockwall County, Texas
 Spring Haven Investments, Inc.
 6750 Hillcrest Plaza Dr. • Suite 309 • Dallas, Texas 75230 • 972.386.3333

F.C. CUNY CORPORATION
 #2 Horizon Court • Heath, Texas 75032 • 469-402-7700

Drawn By:	Checked By:	Date:	Scale:	Project No.:	Sheet No.:
MSC	DJM	10/18/06	H: 1" = 40' V: 1" = 4'	05-013	40 of 45