


* Street Light (Typ.)

- Street Light Notes:**
1. Street Light Luminaire Standard 23' Round Tapered Galvanized Steel Pole - Cobra Head - Embedded Base. Refer to TXU Electric Specs.
 2. Street Lights To be Installed in Accordance With the National Electrical Code & the City of Heath's Standard Details.
 3. All Street Lights Shall be Installed by TXU Electric.

— Traffic Sign

- Signing Notes:**
1. All signs and their installations shall conform to the Texas Manual on Uniform Traffic Control Devices.

THE SEAL APPEARING ON THIS DOCUMENT WAS AUTHORIZED BY CHRISTOPHER R. CUNY, P.E. 65642

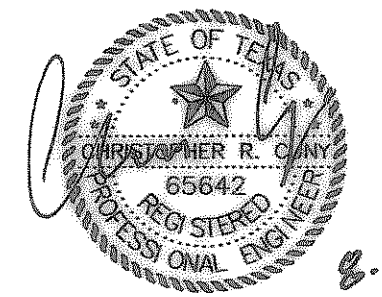

8-22-2007

**Construction Record Drawing
8-22-2007**

Lighting and Signage Plan				
Fontanna Ranch				
City of Rockwall, Rockwall County, Texas				
<i>Spring Haven Investments, Inc.</i>				
<small>6750 Hillcrest Plaza Dr. • Suite 305 • Dallas, Texas 75230 • 972.366.3333</small>				
F.C. CUNY CORPORATION				
<small>#2 Horizon Court • Heath, Texas 75032 • 469-402-7700</small>				
Drawn By:	Checked By:	Date:	Scale:	Project No.:
MSC	DW	10/16/06	1" = 100'	05-013
				Sheet No.:
				45 of 45

Z:\Projects\15-Residential\Fontanna\Record Drawings\Font-1-light.dwg Tue Aug 21 06:16:05 2007