



CASE COVER SHEET

City of Rockwall
Planning and Zoning Department
385 S. Goliad Street
Rockwall, Texas 75087

PLANNING & ZONING CASE NO.

PLANNING & ZONING FEE

PLATTING APPLICATION

- MASTER PLAT
- PRELIMINARY PLAT
- FINAL PLAT
- REPLAT
- AMENDING OR MINOR PLAT
- PLAT REINSTATEMENT REQUEST

SITE PLAN APPLICATION

- SITE PLAN
- AMENDED SITE PLAN/ELEVATIONS/LANDSCAPING

ZONING APPLICATION

- ZONING CHANGE
- SPECIFIC USE PERMIT
- PD DEVELOPMENT PLAN

OTHER APPLICATION

- TREE REMOVAL
- VARIANCE REQUEST/SPECIAL EXCEPTIONS

RECORD OF RECOMMENDATIONS, VOTING RECORDS, AND CONDITIONS OF APPROVAL

ARCHITECTURE REVIEW BOARD

PLANNING AND ZONING COMMISSION

CITY COUNCIL READING #1

CITY COUNCIL READING #2

CONDITIONS OF APPROVAL

NOTES



DEVELOPMENT APPLICATION

City of Rockwall
Planning and Zoning Department
385 S. Goliad Street
Rockwall, Texas 75087

STAFF USE ONLY

PLANNING & ZONING CASE NO. _____

NOTE: THE APPLICATION IS NOT CONSIDERED ACCEPTED BY THE CITY UNTIL THE PLANNING DIRECTOR AND CITY ENGINEER HAVE SIGNED BELOW.

DIRECTOR OF PLANNING: _____

CITY ENGINEER: _____

PLEASE CHECK THE APPROPRIATE BOX BELOW TO INDICATE THE TYPE OF DEVELOPMENT REQUEST [SELECT ONLY ONE BOX]:

<p>PLATTING APPLICATION FEES:</p> <p><input type="checkbox"/> MASTER PLAT (\$100.00 + \$15.00 ACRE)¹</p> <p><input type="checkbox"/> PRELIMINARY PLAT (\$200.00 + \$15.00 ACRE)¹</p> <p><input type="checkbox"/> FINAL PLAT (\$300.00 + \$20.00 ACRE)¹</p> <p><input type="checkbox"/> REPLAT (\$300.00 + \$20.00 ACRE)¹</p> <p><input type="checkbox"/> AMENDING OR MINOR PLAT (\$150.00)</p> <p><input type="checkbox"/> PLAT REINSTATEMENT REQUEST (\$100.00)</p> <p>SITE PLAN APPLICATION FEES:</p> <p><input checked="" type="checkbox"/> SITE PLAN (\$250.00 + \$20.00 ACRE)¹</p> <p><input checked="" type="checkbox"/> AMENDED SITE PLAN/ELEVATIONS/LANDSCAPING PLAN (\$100.00)</p>	<p>ZONING APPLICATION FEES:</p> <p><input type="checkbox"/> ZONING CHANGE (\$200.00 + \$15.00 ACRE)¹</p> <p><input type="checkbox"/> SPECIFIC USE PERMIT (\$200.00 + \$15.00 ACRE)^{1&2}</p> <p><input type="checkbox"/> PD DEVELOPMENT PLANS (\$200.00 + \$15.00 ACRE)¹</p> <p>OTHER APPLICATION FEES:</p> <p><input type="checkbox"/> TREE REMOVAL (\$75.00)</p> <p><input type="checkbox"/> VARIANCE REQUEST/SPECIAL EXCEPTIONS (\$100.00)²</p> <p>NOTES:</p> <p>¹: IN DETERMINING THE FEE, PLEASE USE THE EXACT ACREAGE WHEN MULTIPLYING BY THE PER ACRE AMOUNT. FOR REQUESTS ON LESS THAN ONE ACRE, ROUND UP TO ONE (1) ACRE.</p> <p>²: A \$1,000.00 FEE WILL BE ADDED TO THE APPLICATION FEE FOR ANY REQUEST THAT INVOLVES CONSTRUCTION WITHOUT OR NOT IN COMPLIANCE TO AN APPROVED BUILDING PERMIT.</p>
--	--

PROPERTY INFORMATION [PLEASE PRINT]

ADDRESS: Amenity Center within Homestead

SUBDIVISION: Homestead LOT: 9 BLOCK: F

GENERAL LOCATION: Corner of Fisher Road and Hardin Boulevard

ZONING, SITE PLAN AND PLATTING INFORMATION [PLEASE PRINT]

CURRENT ZONING	Single Family Residential	CURRENT USE	Private Recreation Center
PROPOSED ZONING	Single Family Residential	PROPOSED USE	Private Recreation Center
ACREAGE	1.60	LOTS [CURRENT]	1
		LOTS [PROPOSED]	1

SITE PLANS AND PLATS: BY CHECKING THIS BOX YOU ACKNOWLEDGE THAT DUE TO THE PASSAGE OF HB3167 THE CITY NO LONGER HAS FLEXIBILITY WITH REGARD TO ITS APPROVAL PROCESS, AND FAILURE TO ADDRESS ANY OF STAFF'S COMMENTS BY THE DATE PROVIDED ON THE DEVELOPMENT CALENDAR WILL RESULT IN THE DENIAL OF YOUR CASE.

OWNER/APPLICANT/AGENT INFORMATION [PLEASE PRINT/CHECK THE PRIMARY CONTACT/ORIGINAL SIGNATURES ARE REQUIRED]

<input type="checkbox"/> OWNER	SH DEV KLUTTS ROCKWALL LLC	<input checked="" type="checkbox"/> APPLICANT	Johnson Volk Consulting
CONTACT PERSON	Stephen Pepper	CONTACT PERSON	Cody Johnson
ADDRESS	2400 Dallas Parkway Suite 460	ADDRESS	704 Central Parkway East Suite 1200
CITY, STATE & ZIP	Plano, Texas 75093	CITY, STATE & ZIP	Plano, Texas 75074
PHONE	972-526-7700	PHONE	972-201-3100
E-MAIL	stephen.pepper@shaddockhomes.com	E-MAIL	cody.johnson@johnsonvolk.com

NOTARY VERIFICATION [REQUIRED]

BEFORE ME, THE UNDERSIGNED AUTHORITY, ON THIS DAY PERSONALLY APPEARED Stephen Pepper [OWNER] THE UNDERSIGNED, WHO STATED THE INFORMATION ON THIS APPLICATION TO BE TRUE AND CERTIFIED THE FOLLOWING:

"I HEREBY CERTIFY THAT I AM THE OWNER FOR THE PURPOSE OF THIS APPLICATION; ALL INFORMATION SUBMITTED HEREIN IS TRUE AND CORRECT; AND THE APPLICATION FEE OF \$ 382.00 TO COVER THE COST OF THIS APPLICATION, HAS BEEN PAID TO THE CITY OF ROCKWALL ON THIS THE 13th DAY OF November, 2023 BY SIGNING THIS APPLICATION. I AGREE THAT THE CITY OF ROCKWALL (I.E. "CITY") IS AUTHORIZED AND PERMITTED TO PROVIDE INFORMATION CONTAINED WITHIN THIS APPLICATION TO THE PUBLIC. THE CITY IS ALSO AUTHORIZED AND PERMITTED TO REPRODUCE ANY COPYRIGHTED INFORMATION SUBMITTED IN CONJUNCTION WITH THIS APPLICATION, IF SUCH REPRODUCTION IS ASSOCIATED OR IN RESPONSE TO A REQUEST FOR PUBLIC INFORMATION."


GIVEN UNDER MY HAND AND SEAL OF OFFICE ON THIS THE 13th DAY OF November, 2023

OWNER'S SIGNATURE


Stephen Pepper

NOTARY PUBLIC IN AND FOR THE STATE OF TEXAS

Deanna Walker

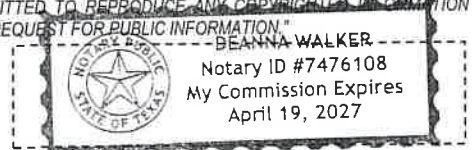

MY COMMISSION EXPIRES

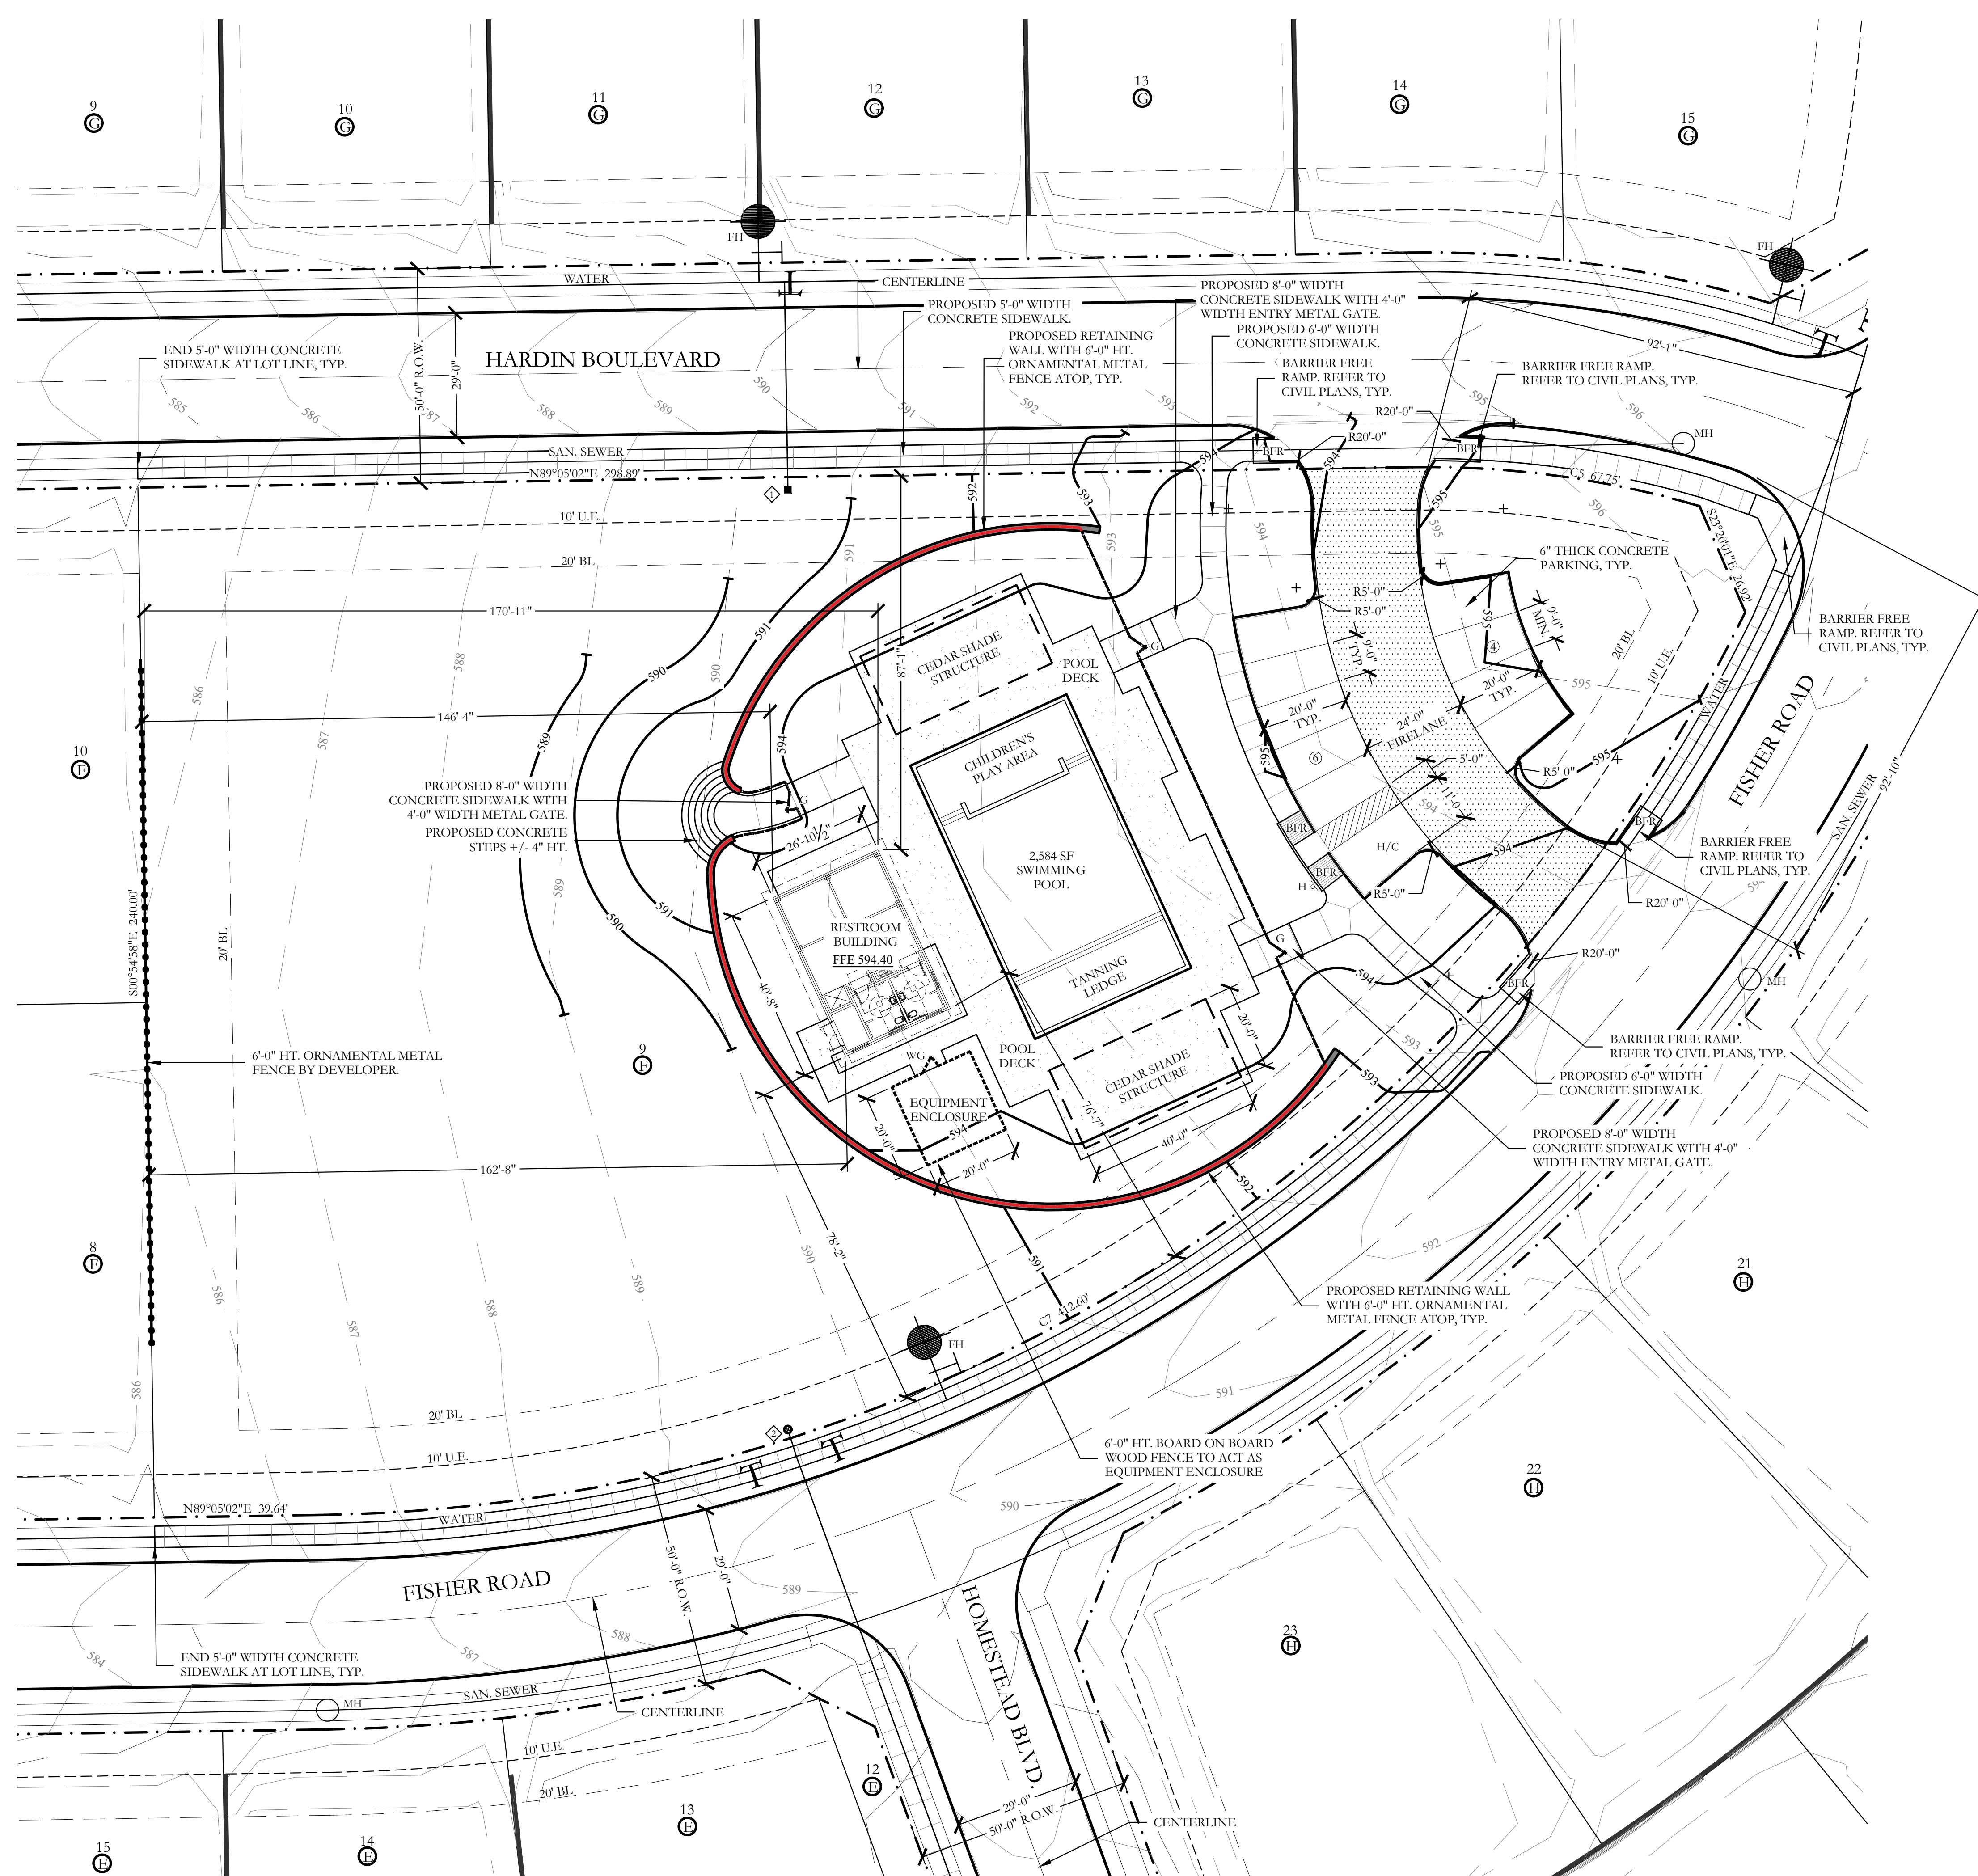

LEGEND

- ④ PROPOSED PARKING COUNT
- H/C PROPOSED HANDICAP PARKING SPACE
- BFR PROPOSED BARRIER FREE RAMP
- FH EXISTING FIRE HYDRANT
- MH EXISTING SANITARY SEWER MANHOLE
- EXISTING WATER MAIN W/ VALVE
- EXISTING SANITARY SEWER
- - - RIGHT-OF-WAY
- 593 - EXISTING CONTOUR INTERVAL
- 592 - PROPOSED CONTOUR INTERVAL
- FFE 594.40 FINISHED FLOOR ELEVATION
- ◊ PROPOSED 1.5" DOMESTIC WATER METER
- ◊ PROPOSED 1.5" IRRIGATION WATER METER
- H HANDICAP PARKING SIGN
- PROPOSED RETAINING WALL
- ORNAMENTAL METAL FENCE (6'-0" HT. AROUND SWIMMING POOL AREA)
- ORNAMENTAL METAL FENCE ATOP RETAINING WALL (6'-0" HT. AROUND SWIMMING POOL AREA)
- ▲ 1 - 4'-0" WIDTH SELF LATCHING, SELF CLOSING METAL GATE
- ▲ 1 - 4'-0" WIDTH SELF LATCHING, SELF CLOSING WOODEN GATE
- 6'-0" HT. WOOD FENCE TO ACT AS POOL EQUIPMENT AND TRASH TOTE ENCLOSURE
- ORNAMENTAL METAL FENCE ALONG PROPERTY LINE
- ▨ FIRELANE PAVING PER CITY STANDARD DETAILS

WATER METER SCHEDULE

METER ID NUMBER	WATER SERVICE SIZE	WATER METER SIZE	METER DOM	METER IRR	SAN. SERVICE SIZE
◊	1.5"	1.5"	X		6"
◊	1.5"	1.5"		X	6"

SITE PLAN NOTES:

- NO 100 YEAR FLOOD PLAIN EXISTS ON PROPERTY.
- FOR ALL BARRIER FREE RAMP NOTED ON PLAN, REFERENCE THE CITY OF ROCKWALL STANDARD CONSTRUCTION DETAILS.
- ALL HANDICAP PARKING SPACES SHALL BE A MINIMUM OF 11'-0" WIDTH x 20'-0" LENGTH WITH A 5'-0" LOADING AISLE.
- STANDARD PARKING SPACES SHALL BE A MINIMUM OF 9'-0" WIDTH x 20'-0" LENGTH.
- THE PERIMETER FENCING SHALL BE 6'-0" HT. ORNAMENTAL METAL FENCE.
- ALL VEHICULAR AND SIDEWALK PAVING SHOWN ON THESE PLANS SHALL BE MAINTAINED BY THE HOA.

SITE INFORMATION

SINGLE FAMILY RESIDENTIAL
 PROPOSED USE: PRIVATE RECREATION CENTER
 LAND AREA: 1.60 ACRES
 69,696.00 SQ. FT.

BUILDING AREA: 1,092.73 SQUARE FEET
 BUILDING HEIGHT: 22'-7" (1 STORY)

FLOOR TO AREA: 0.0156:1 (1,092.73/69,696.00)
 LOT COVERAGE: 1.56%

PARKING REQUIRED: 1 PER 250 SF. OF ASSEMBLY SPACE
 1,092.73/250=4.37
 5 REQUIRED SPACES
 PARKING PROVIDED: 10 TOTAL, (WITH 1 HANDICAP)

HANDICAP PARKING IS PROVIDED IN ACCORDANCE WITH ADA STANDARDS

TOTAL IMPERVIOUS SURFACE: 16,759.40 SF
 PROPOSED IMPERVIOUS RATIO: 0.2404 OR 24.04%
 INTERIOR LANDSCAPE PROVIDED: 52,936.60 SF


POOL DECK SURFACE: 5,524.59 SF

APPROVED:



I hereby certify that the above and foregoing site plan for a development in the City of Rockwall, Texas, was approved by the Planning & Zoning Commission of the City of Rockwall on the [DAY] day of [MONTH], [YEAR].

WITNESS OUR HANDS, this [DAY] day of [MONTH], [YEAR].

 Planning & Zoning Commission, Chairman Director of Planning and Zoning

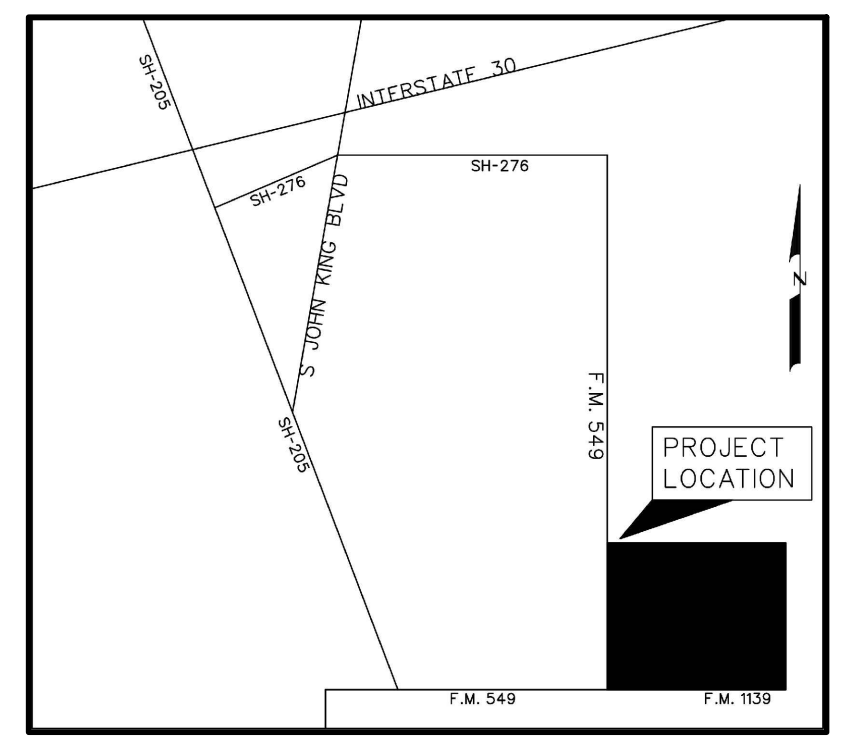

LOCATION MAP
NOT TO SCALE

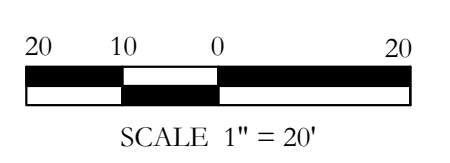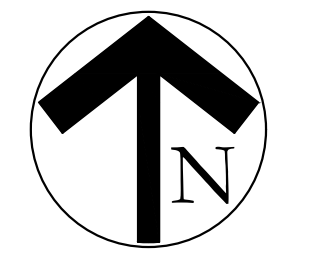

SITE PLAN
HOMESTEAD, PHASE 1
LOT 9, BLOCK F
~AMENITY CENTER~

BEING 1.600 ACRES OUT OF THE
 J.A. RAMSEY SURVEY
 ABSTRACT NO. 186 IN THE
 CITY OF ROCKWALL, ROCKWALL COUNTY, TEXAS

OWNER / DEVELOPER:
 SHADDOCK HOMES, INC
 2400 DALLAS PARKWAY, SUITE 460
 MCKINNEY, TEXAS 75093
 CONTACT: LORA ERDMAN

LANDSCAPE ARCHITECT/CIVIL ENGINEER:
 JOHNSON VOLK CONSULTING
 704 CENTRAL PARKWAY EAST, SUITE 1200
 PLANO, TEXAS 75074
 PH. 972-201-3100
 CONTACT: CODY JOHNSON, RLA, ASLA, LI



November 13, 2023

CITY CASE NO. T8D

BUILDING MATERIAL CALCULATIONS


Material	North	Percent	South	Percent	East	Percent	West	Percent
TOTAL SQ FT.	413 S.F.	-	448 S.F.	-	186 S.F.	-	186 S.F.	-
PRIMARY MATERIAL TOTALS	338 S.F.	81.84%	222 S.F.	49.56%	134 S.F.	72.04%	157 S.F.	84.41%
BRICK VENEER (TO BE SELECTED BY OWNER)	94 S.F.	22.76%	36 S.F.	8.04%	41 S.F.	22.04%	63 S.F.	33.87%
BOARD AND BATTEN FIBER CEMENT SIDING (TO BE SELECTED BY OWNER)	244 S.F.	59.08%	186 S.F.	41.52%	93 S.F.	50.00%	94 S.F.	50.54%
SECONDARY MATERIALS	3 S.F.	0.73%	178 S.F.	39.73%	7 S.F.	3.76%	7 S.F.	3.76%
DOUGLAS FIR BEAMS/COLUMNS (STAIN TO BE SELECTED BY OWNER)	3 S.F.	0.73%	81 S.F.	18.08%	7 S.F.	3.76%	7 S.F.	3.76%
TILE AT SHOWER/DRINKING FOUNTAINS (TO BE SELECTED BY OWNER)	-	-	97 S.F.	21.65%	-	-	-	-
DOORS/WINDOWS/TRIM (COLOR TO MATCH ADJACENT MATERIALS)	72 S.F.	17.43%	48 S.F.	10.71%	45 S.F.	24.20%	22 S.F.	11.83%
ROOF (STANDING SEAM METAL, COLOR TO BE SELECTED BY OWNER)	-	-	-	-	-	-	-	-



ACME BRICK
WHITE BLUFF



MUELLER, INC.
DARK CHARCOAL

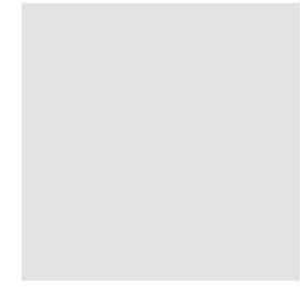

SHERWIN WILLIAMS
ICE CUBE
SW 6252



SHERWIN WILLIAMS
WEB GRAY
SW 7075






SHERWIN WILLIAMS
KINGS CANYON (WOOD STAIN)
SW 3026



DALTLIE
DARK GREY (TILE)
12 X 24



GLASS WINDOW
WITH
FROSTED GLAZING

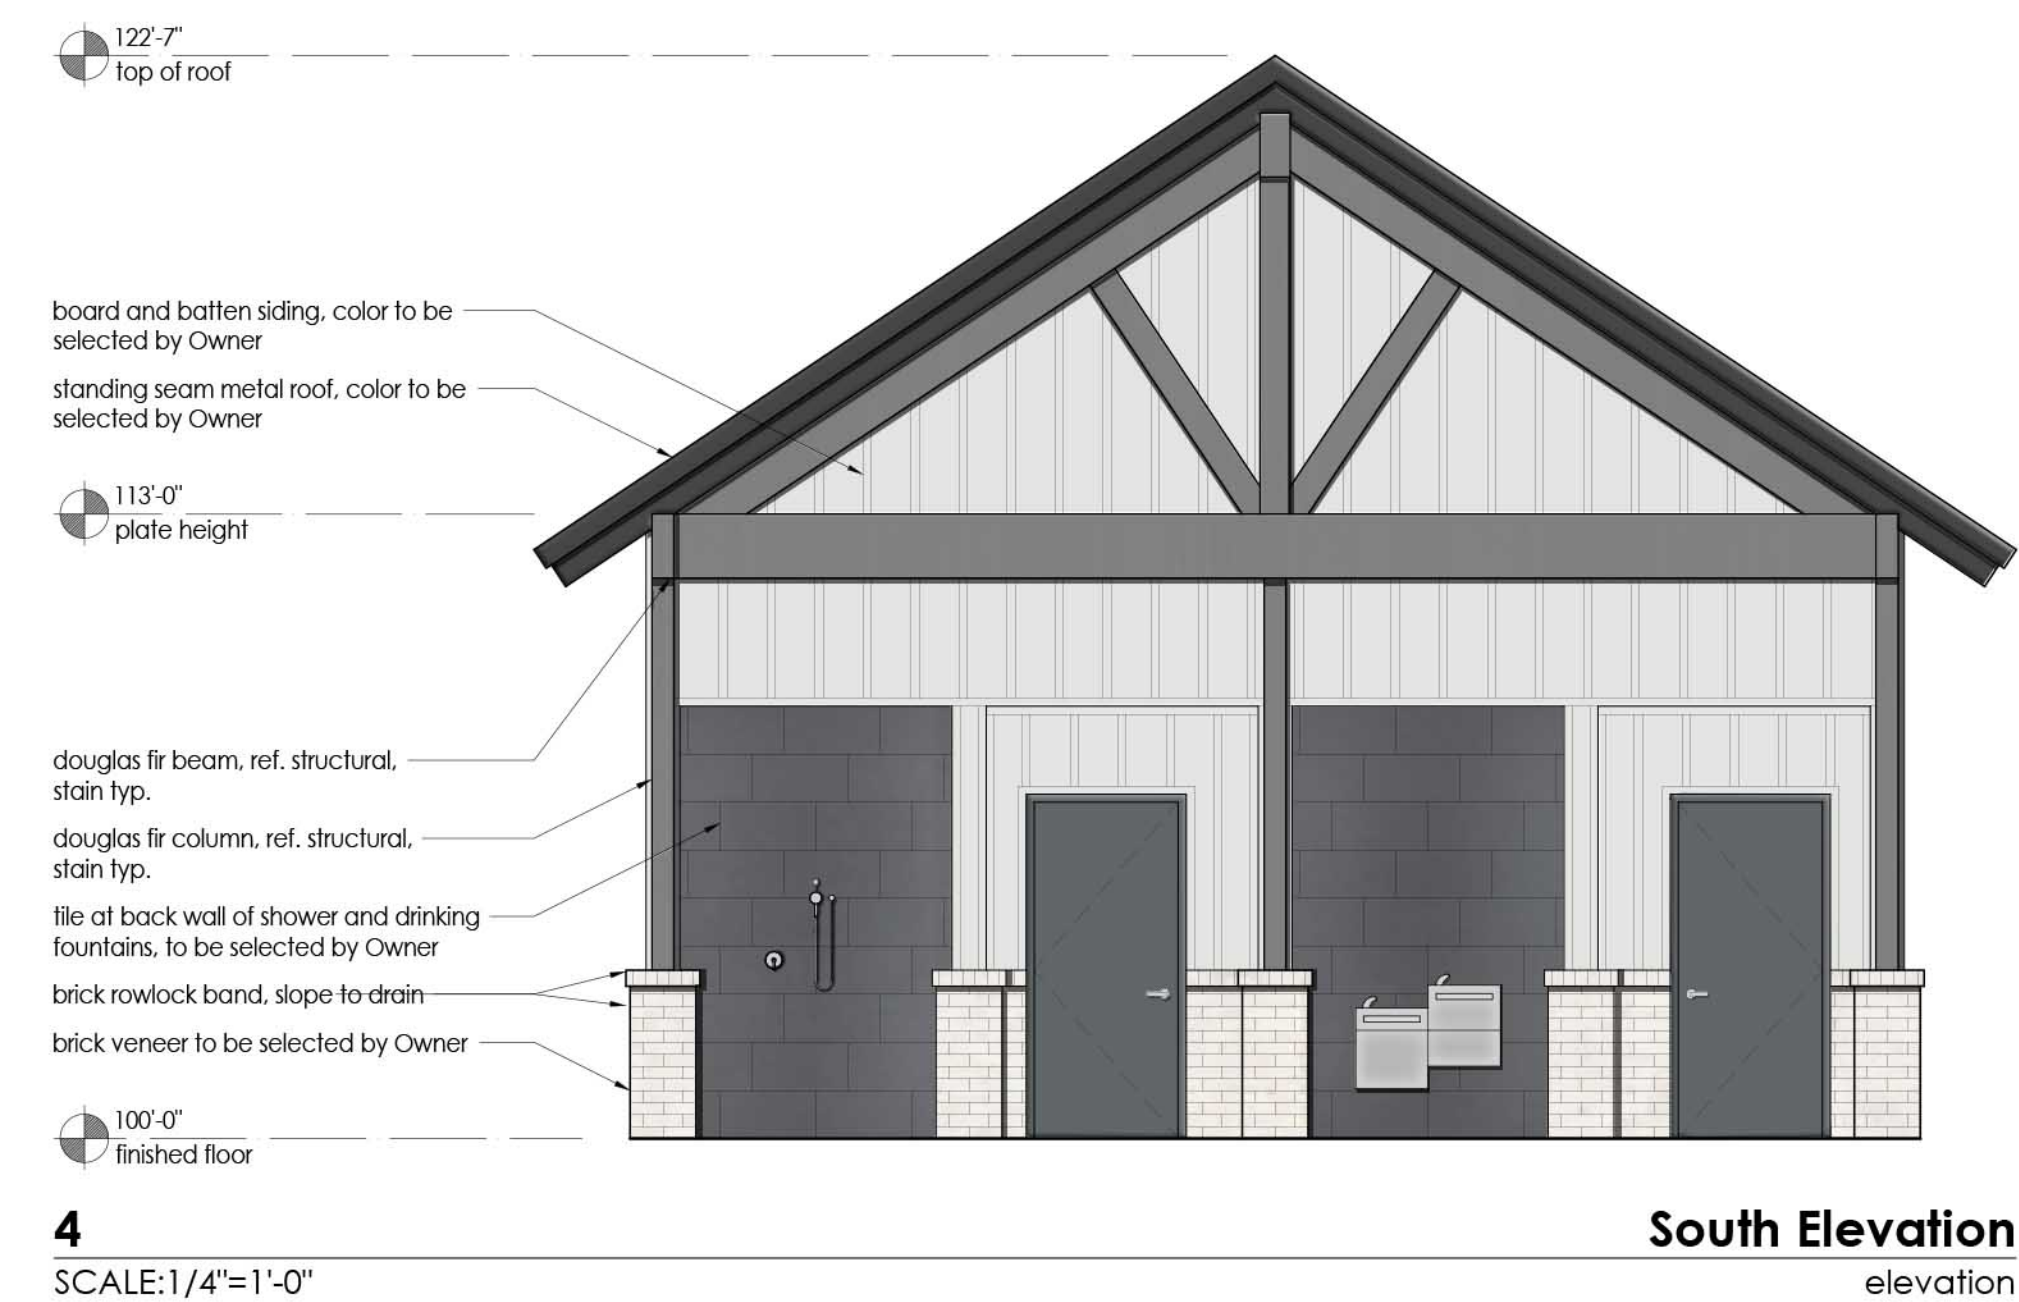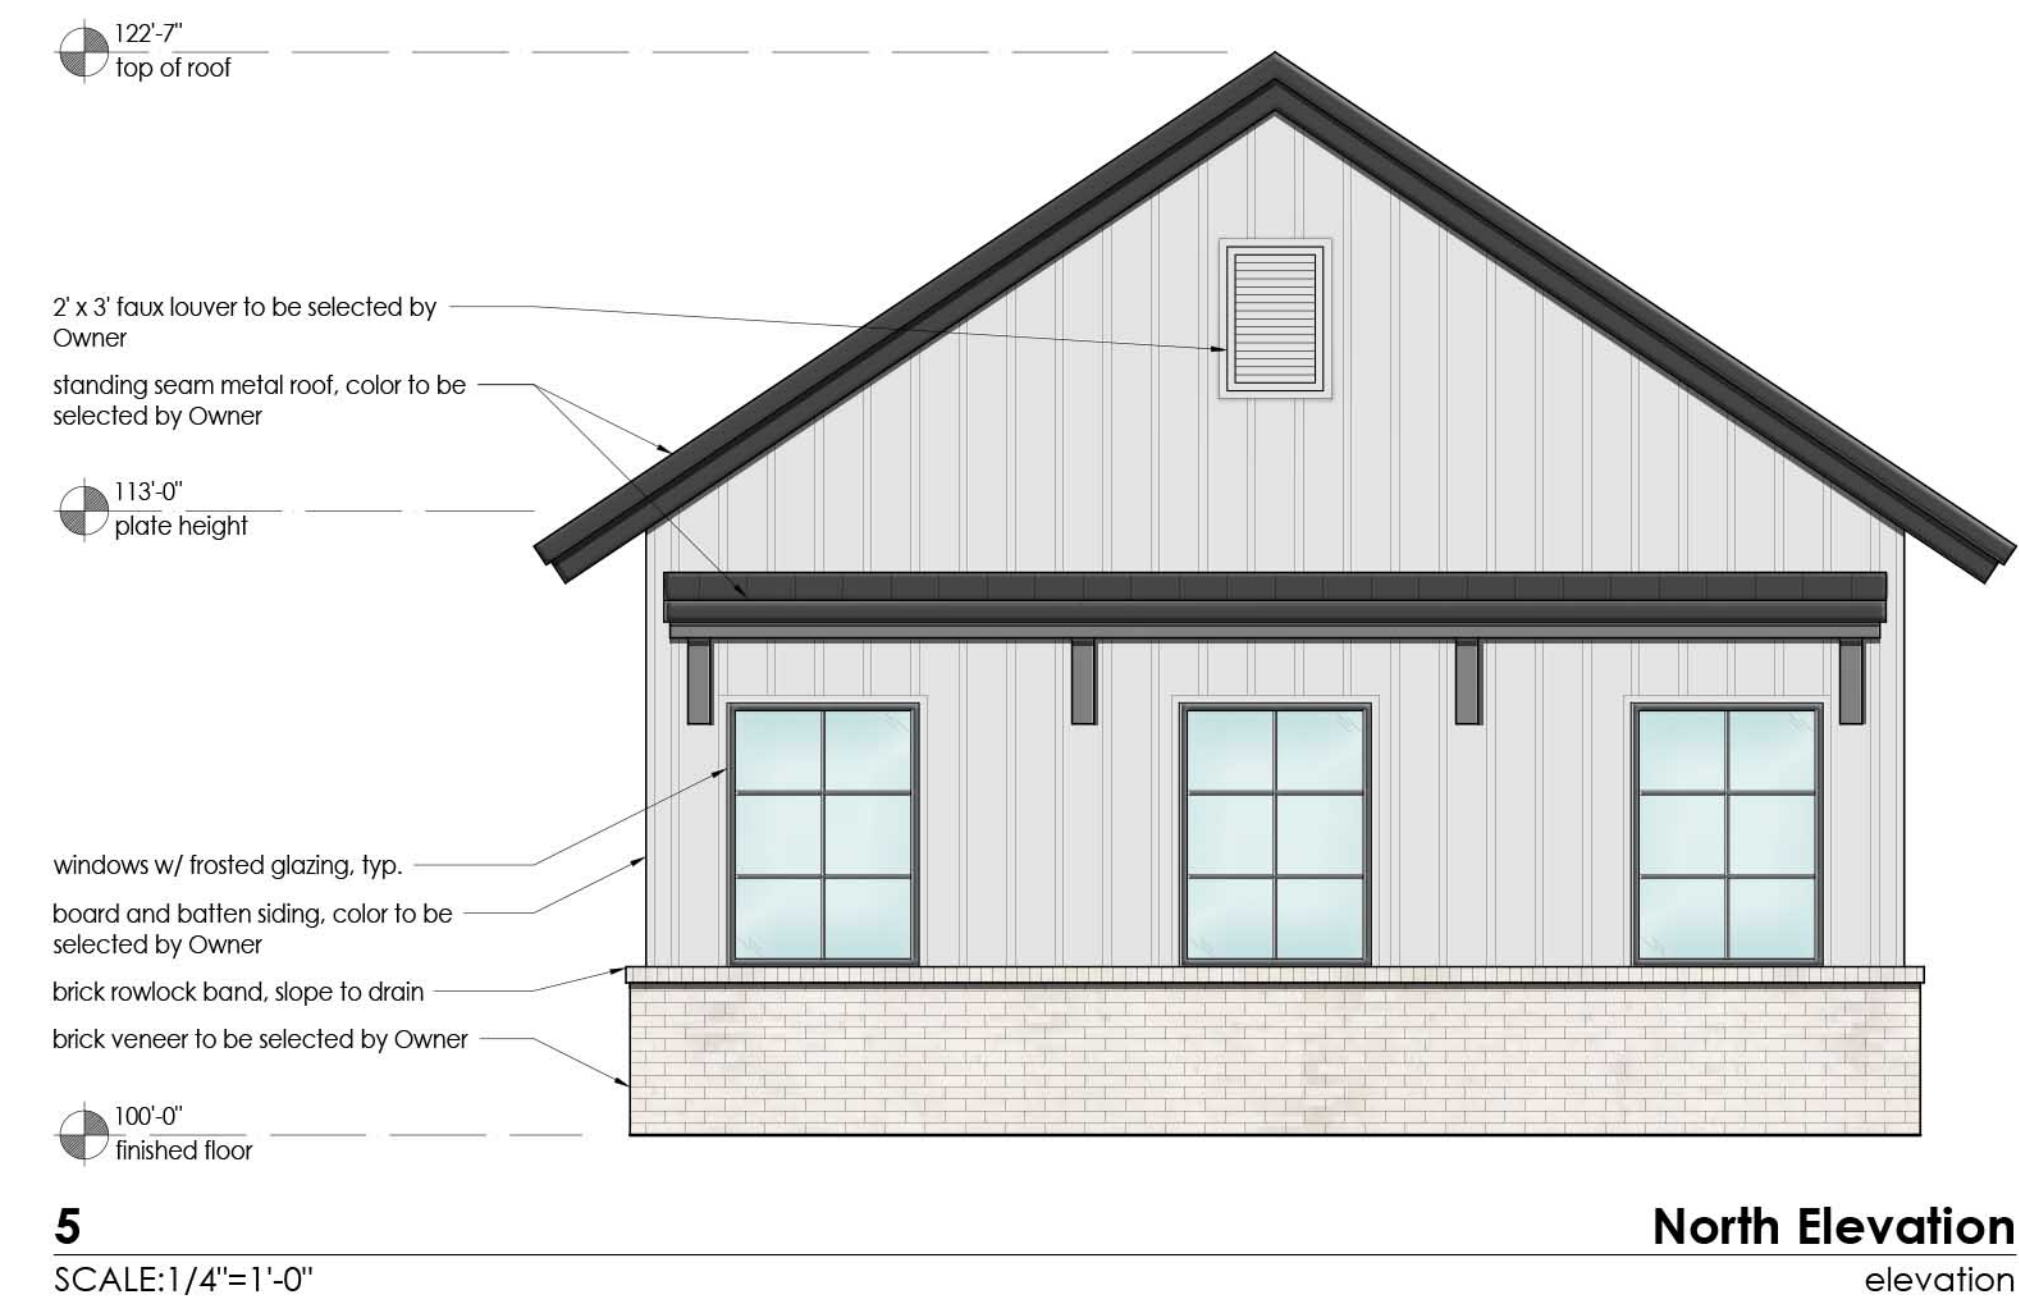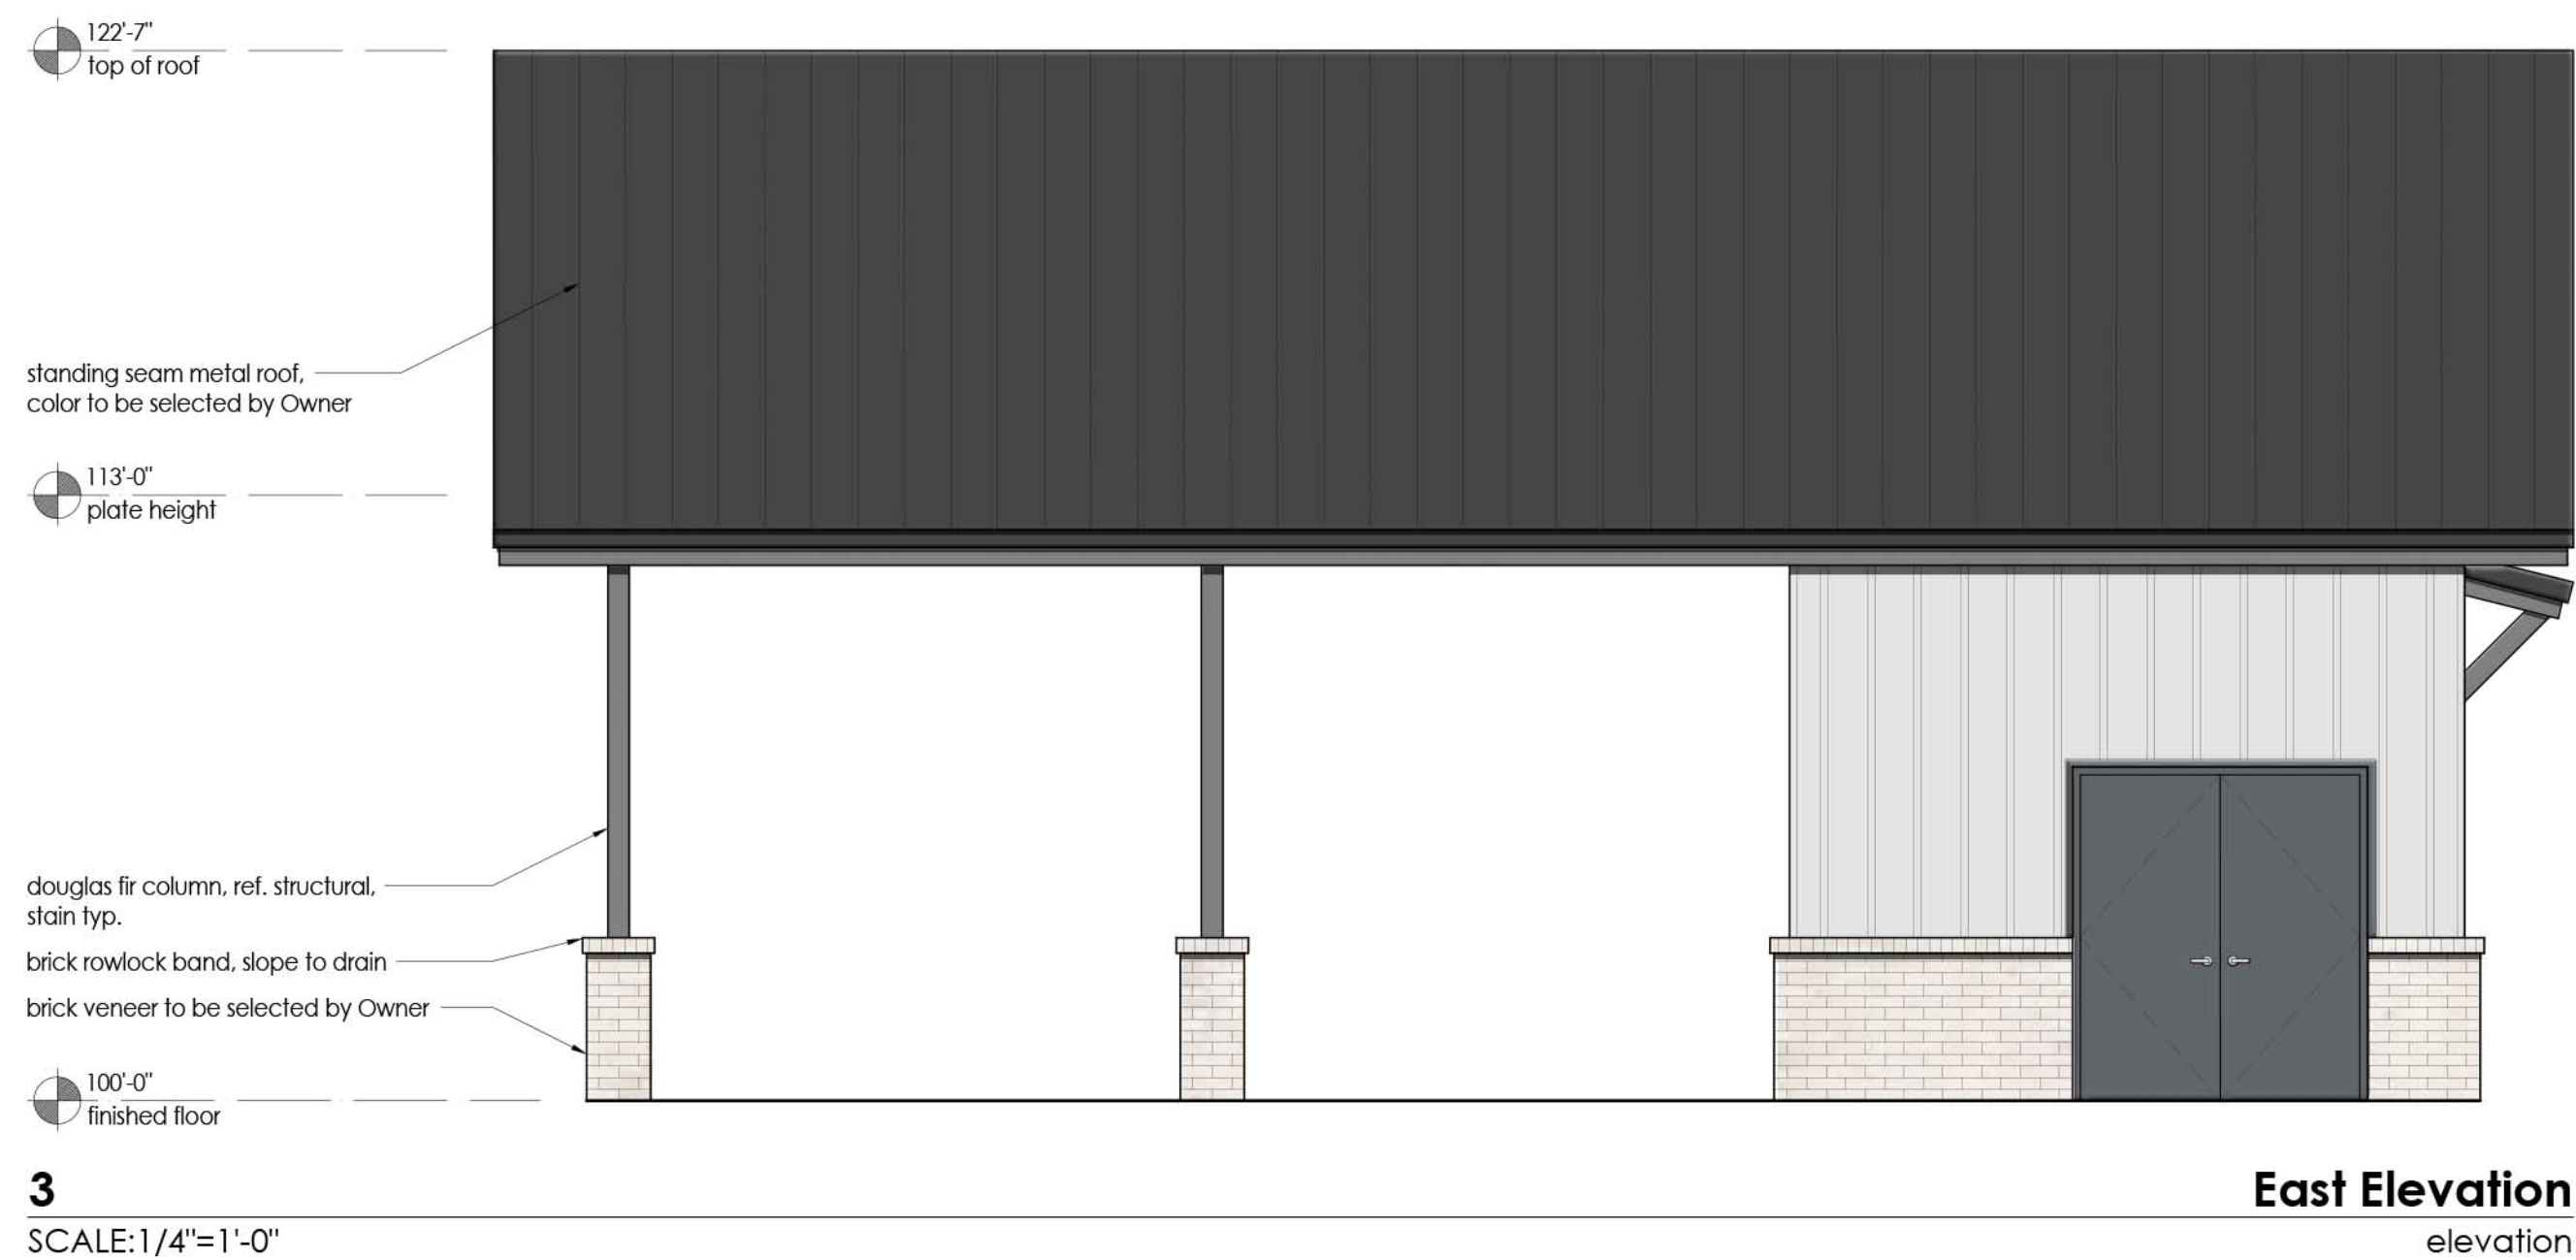

SEAL

Copyright © 2023
DATE: 10.24.2023
SCALE:
JOB NO. MA23027
DRAWN: JV
APPD: KM
ACAD #
EXTERIOR ELEVATIONS

DRAWING NO. REV. NO.

A4.00




SHERWIN WILLIAMS
WEB GRAY
SW 7075




ACME BRICK
ASHWOOD




SHERWIN WILLIAMS
KINGS CANYON (WOOD STAIN)
SW 3026

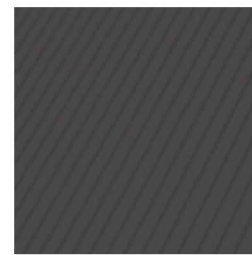

MUELLER, INC.
DARK CHARCOAL

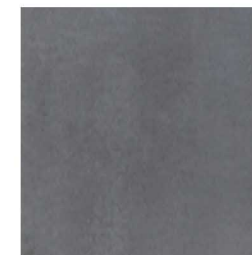

DALTILE
DARK GREY (TILE)
12 X 24

 

SHERWIN WILLIAMS
ICE CUBE
SW 6252



GLASS WINDOW
WITH
FROSTED GLAZING

OWNER/DEVELOPER:

SHADDOCK HOMES, INC
2400 DALLAS PARKWAY, SUITE 460
MCKINNEY, TEXAS 75093
CONTACT: LORA ERDMAN
PHONE: 972-526-7645
EMAIL: LORAERDMAN@SHADDOCKHOMES.COM

LANDSCAPE ARCHITECT:

JOHNSON VOLK CONSULTING
704 CENTRAL PARKWAY EAST, SUITE 1200
PLANO, TEXAS 75074
CONTACT: CODY JOHNSON, RLA, ASLA, LI
PHONE: 972-201-3100
EMAIL: CODYJOHNSON@JOHNSONVOLK.COM


SUBMITTAL DATE: November 13, 2023

SEAL

Copyright © 2023

DATE: _____
SCALE: _____
JOB NO. _____
DRAWN: _____
APPD: _____
ACAD # _____

DRAWING NO. _____ REV. NO. _____

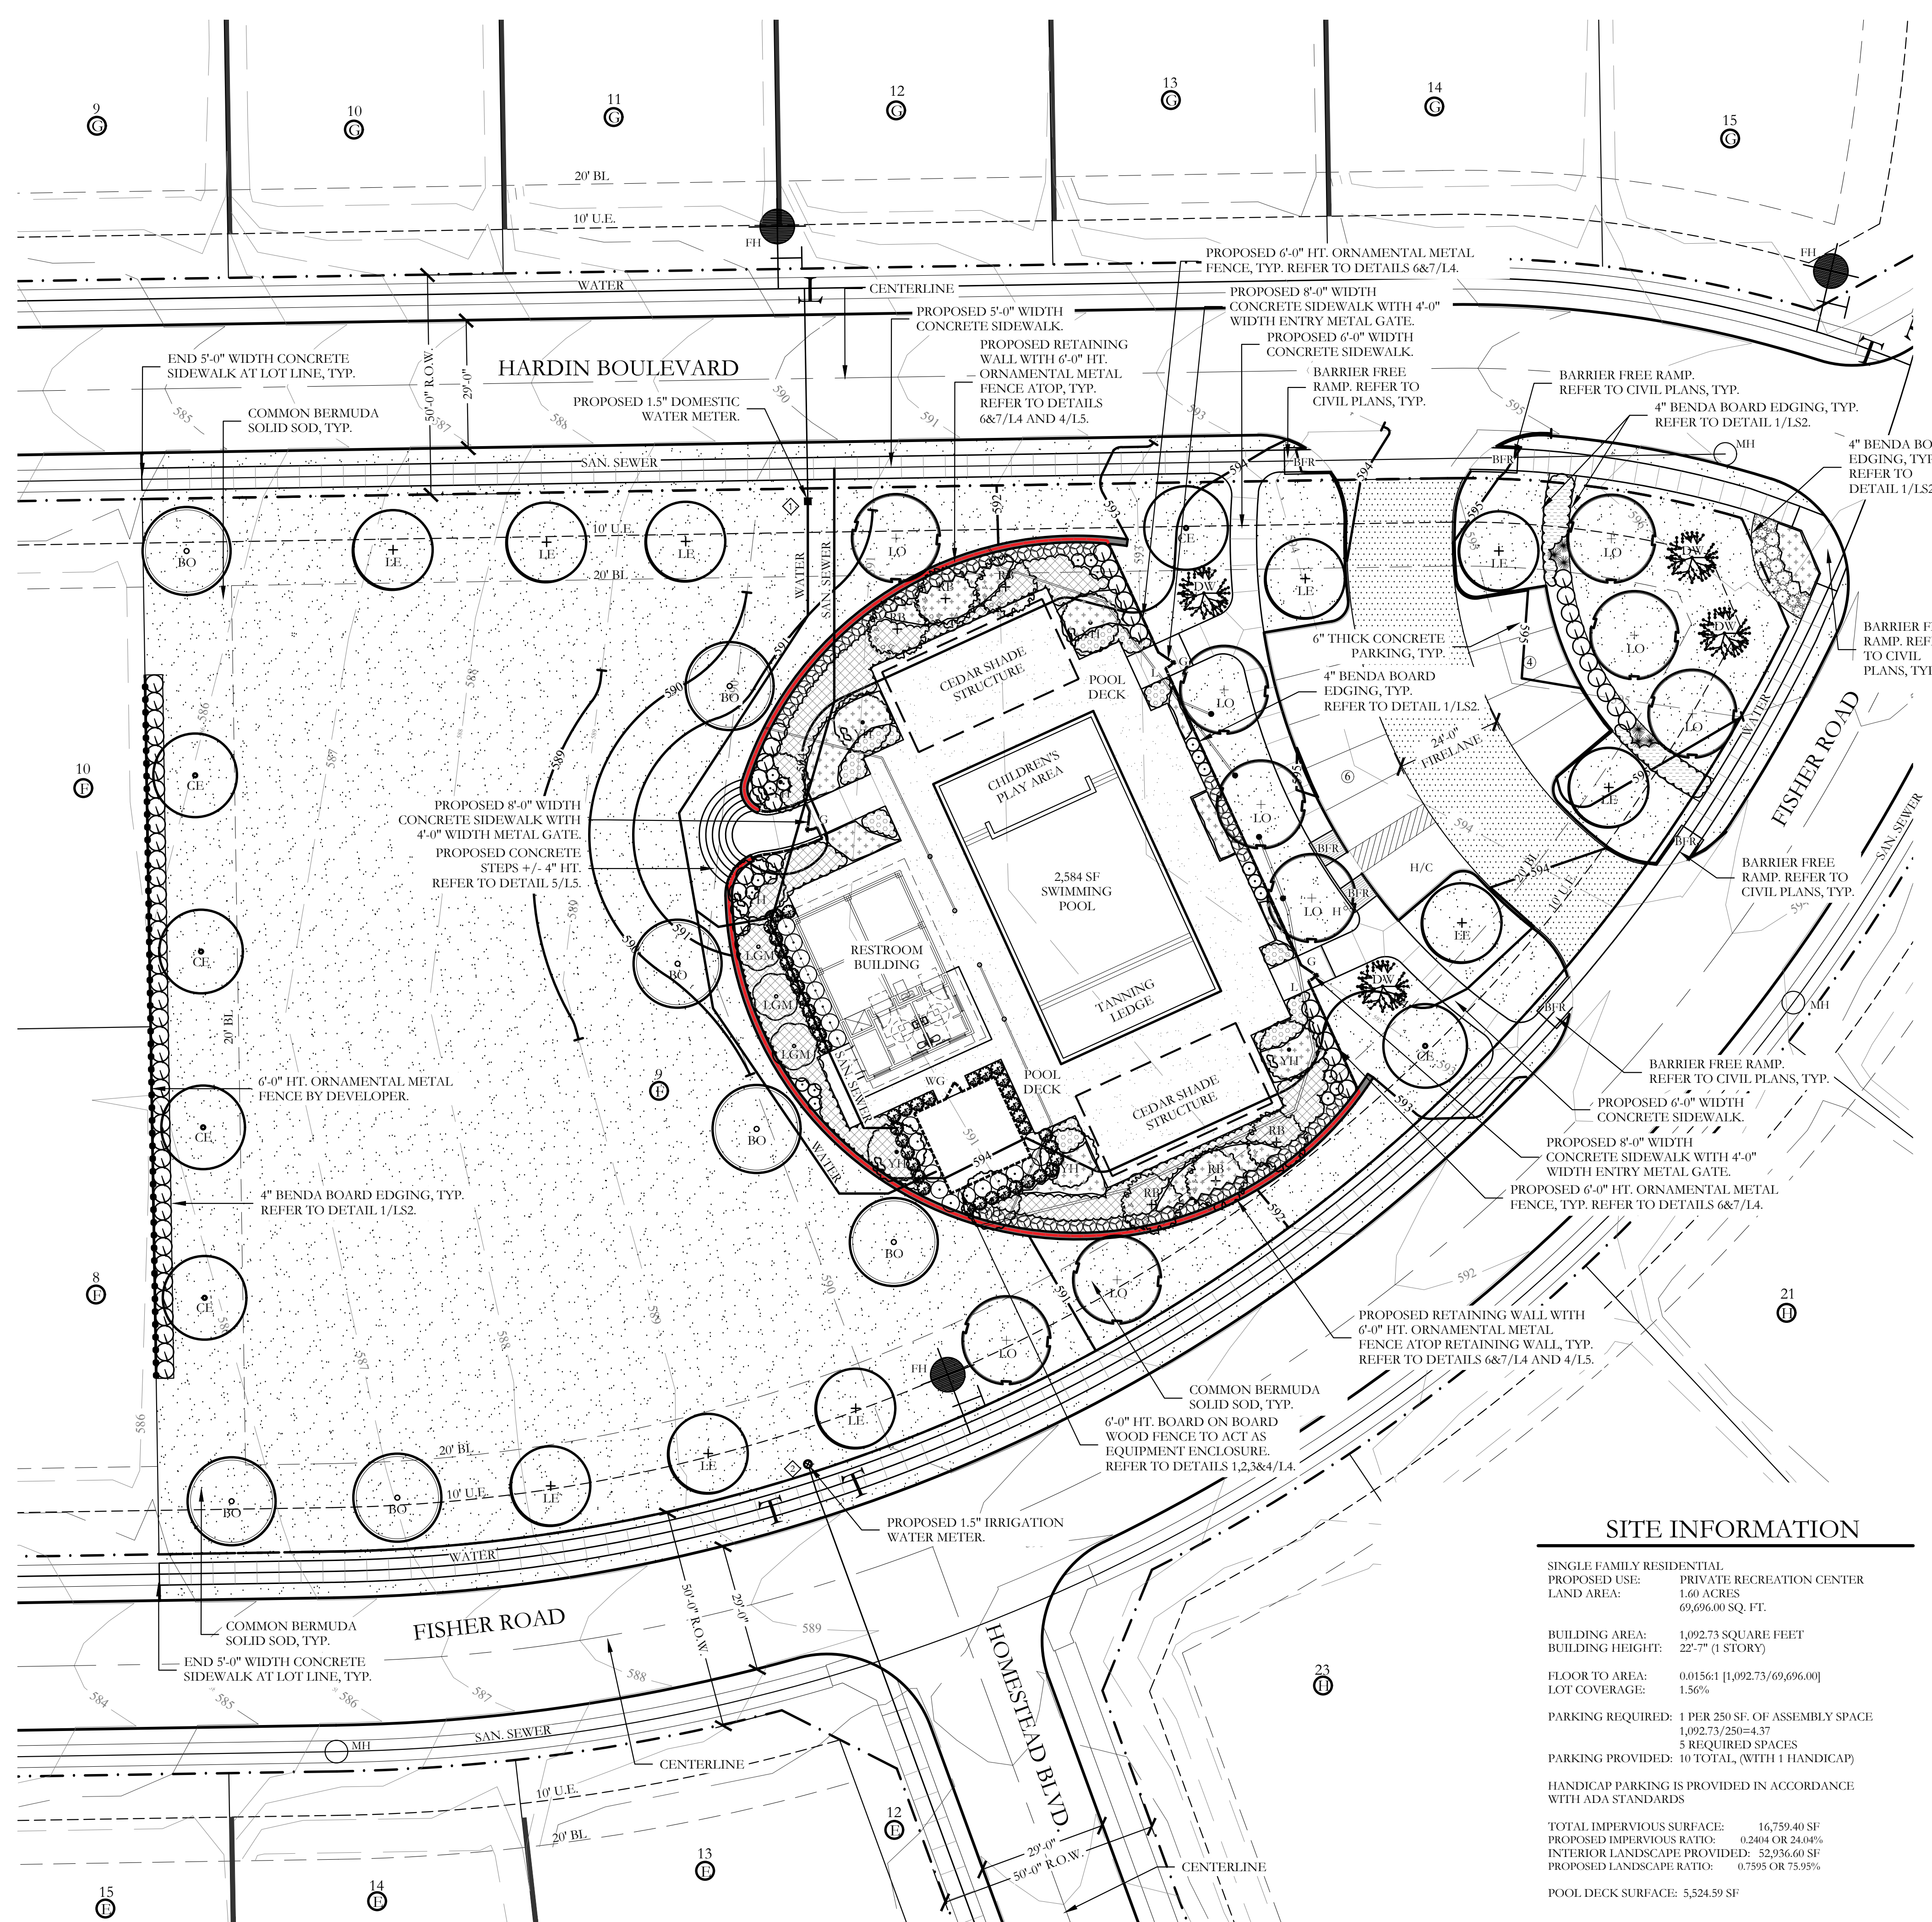

PLANT LEGEND					
SYMBOL	KEY	COMMON NAME	SCIENTIFIC NAME	SIZE	SPACING
	LO	LIVE OAK	QUERCUS VIRGINIANA	4" CALIPER	AS SHOWN
	BO	BUR OAK	QUERCUS MACROCARPA	4" CALIPER	AS SHOWN
	LE	LACEBARK ELM	ULMUS PARVIFOLIA	4" CALIPER	AS SHOWN
	CE	CEDAR ELM	ULMUS CRASSIFOLIA	4" CALIPER	AS SHOWN
	LGM	LITTLE GEM MAGNOLIA	MAGNOLIA GRANDIFLORA 'LITTLE GEM'	2" CALIPER	AS SHOWN
	DW	DESERT WILLOW	CHLOPSIS LINEARIS	2" CALIPER	AS SHOWN
	YH	YAUPON HOLLY	ILEX VOMITORIA	2" CALIPER	AS SHOWN
	RB	TEXAS REDBUD	CERCIS CANADENSIS VAR. TEXENSIS	2" CALIPER	AS SHOWN
		PURPLE DIAMOND LOROPETALUM	LOROPETALUM CHINENSIS 'PURPLE DIAMOND'	7 GALLON	48" O.C.
		TEXAS SAGE	LEUCOPHYLLUM FRUTESCENS	7 GALLON	48" O.C.
		GLOSSY ABELIA	LINNAEA X GRANDIFLORA	7 GALLON	36" O.C.
		DWARF BURFORD HOLLY	ILEX CORNUTA 'DWARF BURFORD'	7 GALLON	36" O.C.
		UPRIGHT ROSEMARY	ROSMARINUS OFFICINALIS 'UPRIGHT'	3 GALLON	36" O.C.
		DWARF MAIDEN GRASS	MISCANTHUS SINENSIS ADAGIO'	3 GALLON	36" O.C.
		MORNING LIGHT MISCANTHUS	MISCANTHUS SINENSIS 'MORNING LIGHT'	3 GALLON	36" O.C.
		RED YUCCA	HESPERALOE PARVIFLORA	3 GALLON	36" O.C.
		PLUM YEW PROSTRATA	CEPHALOTAXUS HARRINGTONIA 'PROSTRATA'	3 GALLON	48" O.C.
		LIRIOPE GRASS	LIRIOPE MUSCARI	1 GALLON	18" O.C.
		MEXICAN FEATHER GRASS	NASSELLA TENUISSIMA	1 GALLON	18" O.C.
		ANNUAL COLOR	TO BE SELECTED BY OWNER	4" POT	8" O.C.
		COMMON BERMUDA GRASS	CYNODON DACTYLON	SQUARE FEET	SOLID SOD

NOTE: IRRIGATION WILL MEET REQUIREMENTS OF UDC.

ALL RESPONSIBILITY FOR ADEQUACY OF DESIGN REMAINS WITH THE DESIGN ENGINEER. THE CITY OF ROCKWALL, IN REVIEWING AND RELEASING PLANS FOR CONSTRUCTION, ASSUMES NO RESPONSIBILITY FOR ADEQUACY OR ACCURACY OF DESIGN.



SITE INFORMATION


SINGLE FAMILY RESIDENTIAL
 PROPOSED USE: PRIVATE RECREATION CENTER
 LAND AREA: 1.60 ACRES
 69,696.00 SQ. FT.
 BUILDING AREA: 1,092.73 SQUARE FEET
 BUILDING HEIGHT: 22'-7" (1 STORY)
 FLOOR TO AREA: 0.0156:1 (1,092.73/69,696.00)
 LOT COVERAGE: 1.56%
 PARKING REQUIRED: 1 PER 250 SF. OF ASSEMBLY SPACE
 1,092.73/250=4.37
 5 REQUIRED SPACES
 PARKING PROVIDED: 10 TOTAL, (WITH 1 HANDICAP)
 HANDICAP PARKING IS PROVIDED IN ACCORDANCE WITH ADA STANDARDS
 TOTAL IMPERVIOUS SURFACE: 16,759.40 SF
 PROPOSED IMPERVIOUS RATIO: 0.2404 OR 24.04%
 INTERIOR LANDSCAPE PROVIDED: 52,936.60 SF
 PROPOSED LANDSCAPE RATIO: 0.7595 OR 75.95%
 POOL DECK SURFACE: 5,524.59 SF

APPROVED:
 I hereby certify that the above and foregoing site plan for a development in the City of Rockwall, Texas, was approved by the Planning & Zoning Commission of the City of Rockwall on the [DAY] day of [MONTH], [YEAR].


WITNESS OUR HANDS, this [DAY] day of [MONTH], [YEAR].

 Planning & Zoning Commission, Chairman Director of Planning and Zoning

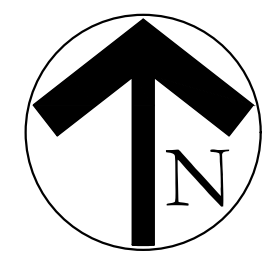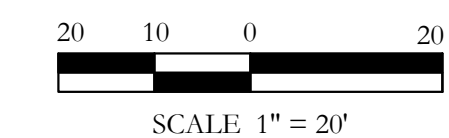


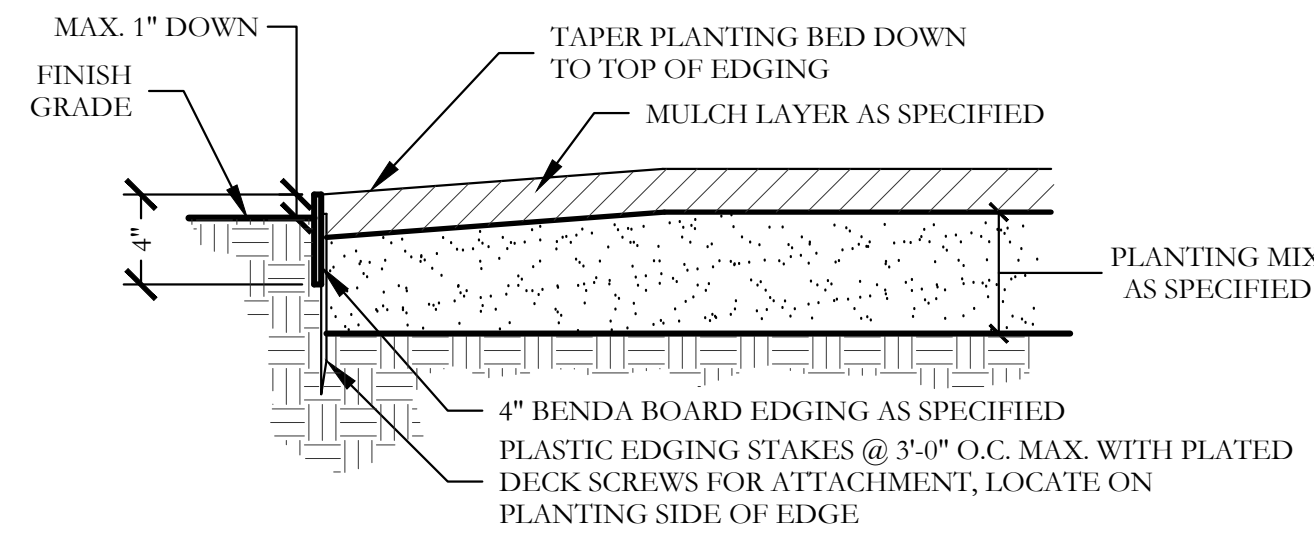

1 TYPICAL BED EDGING DETAIL SECTION NOT TO SCALE

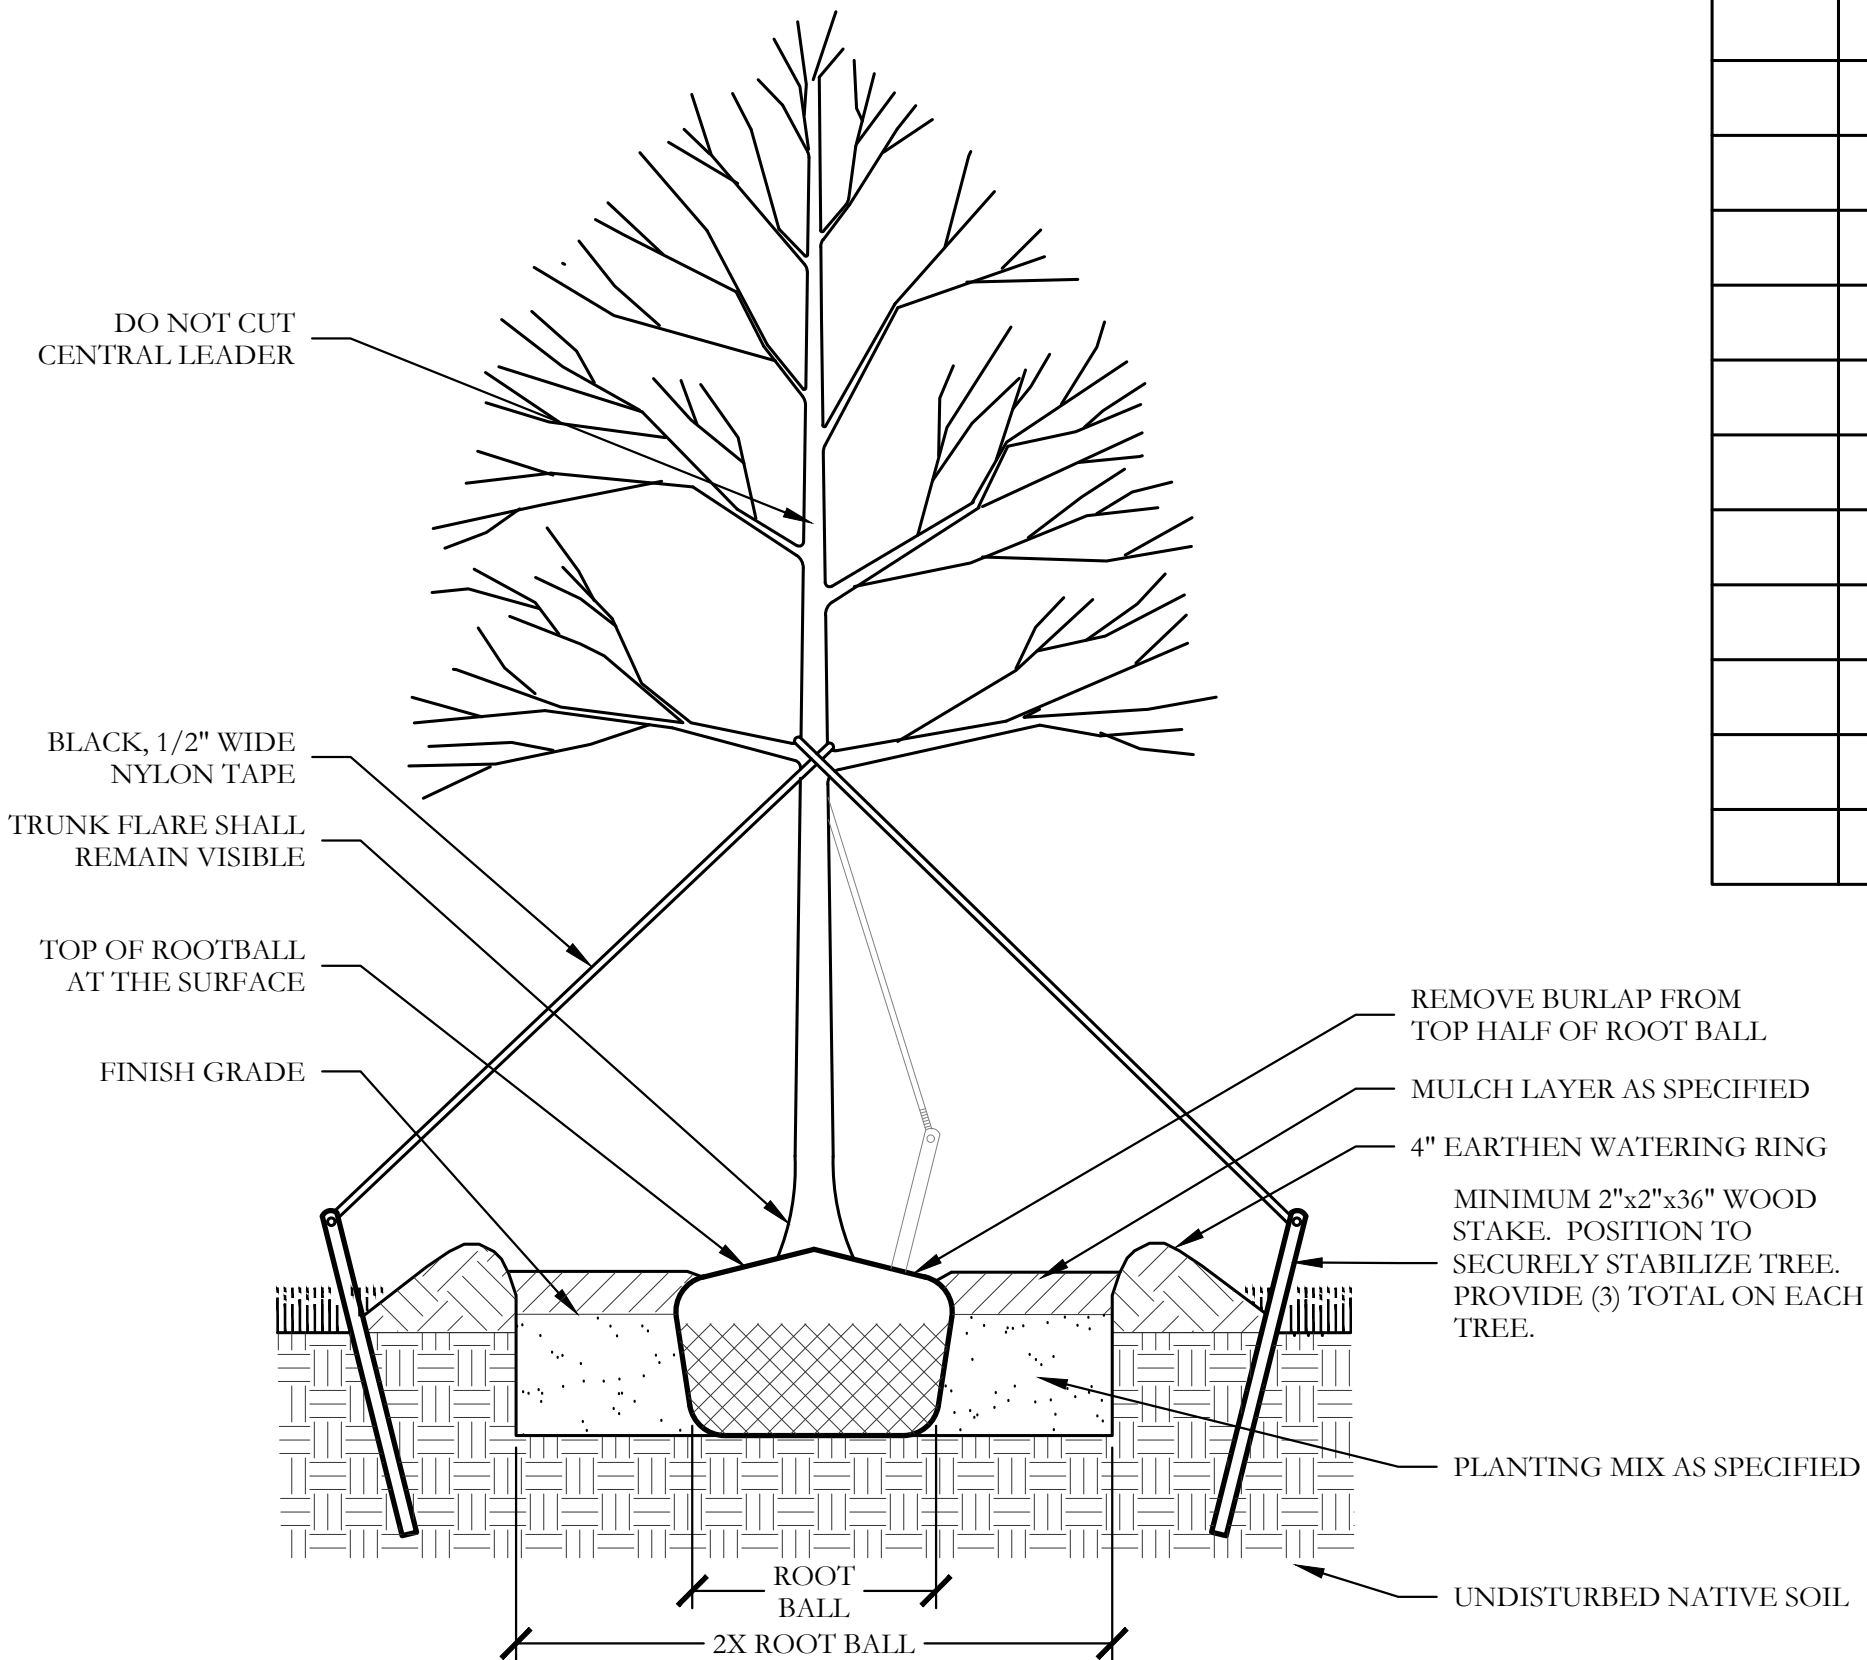

2 TYPICAL TREE PLANTING SECTION NOT TO SCALE

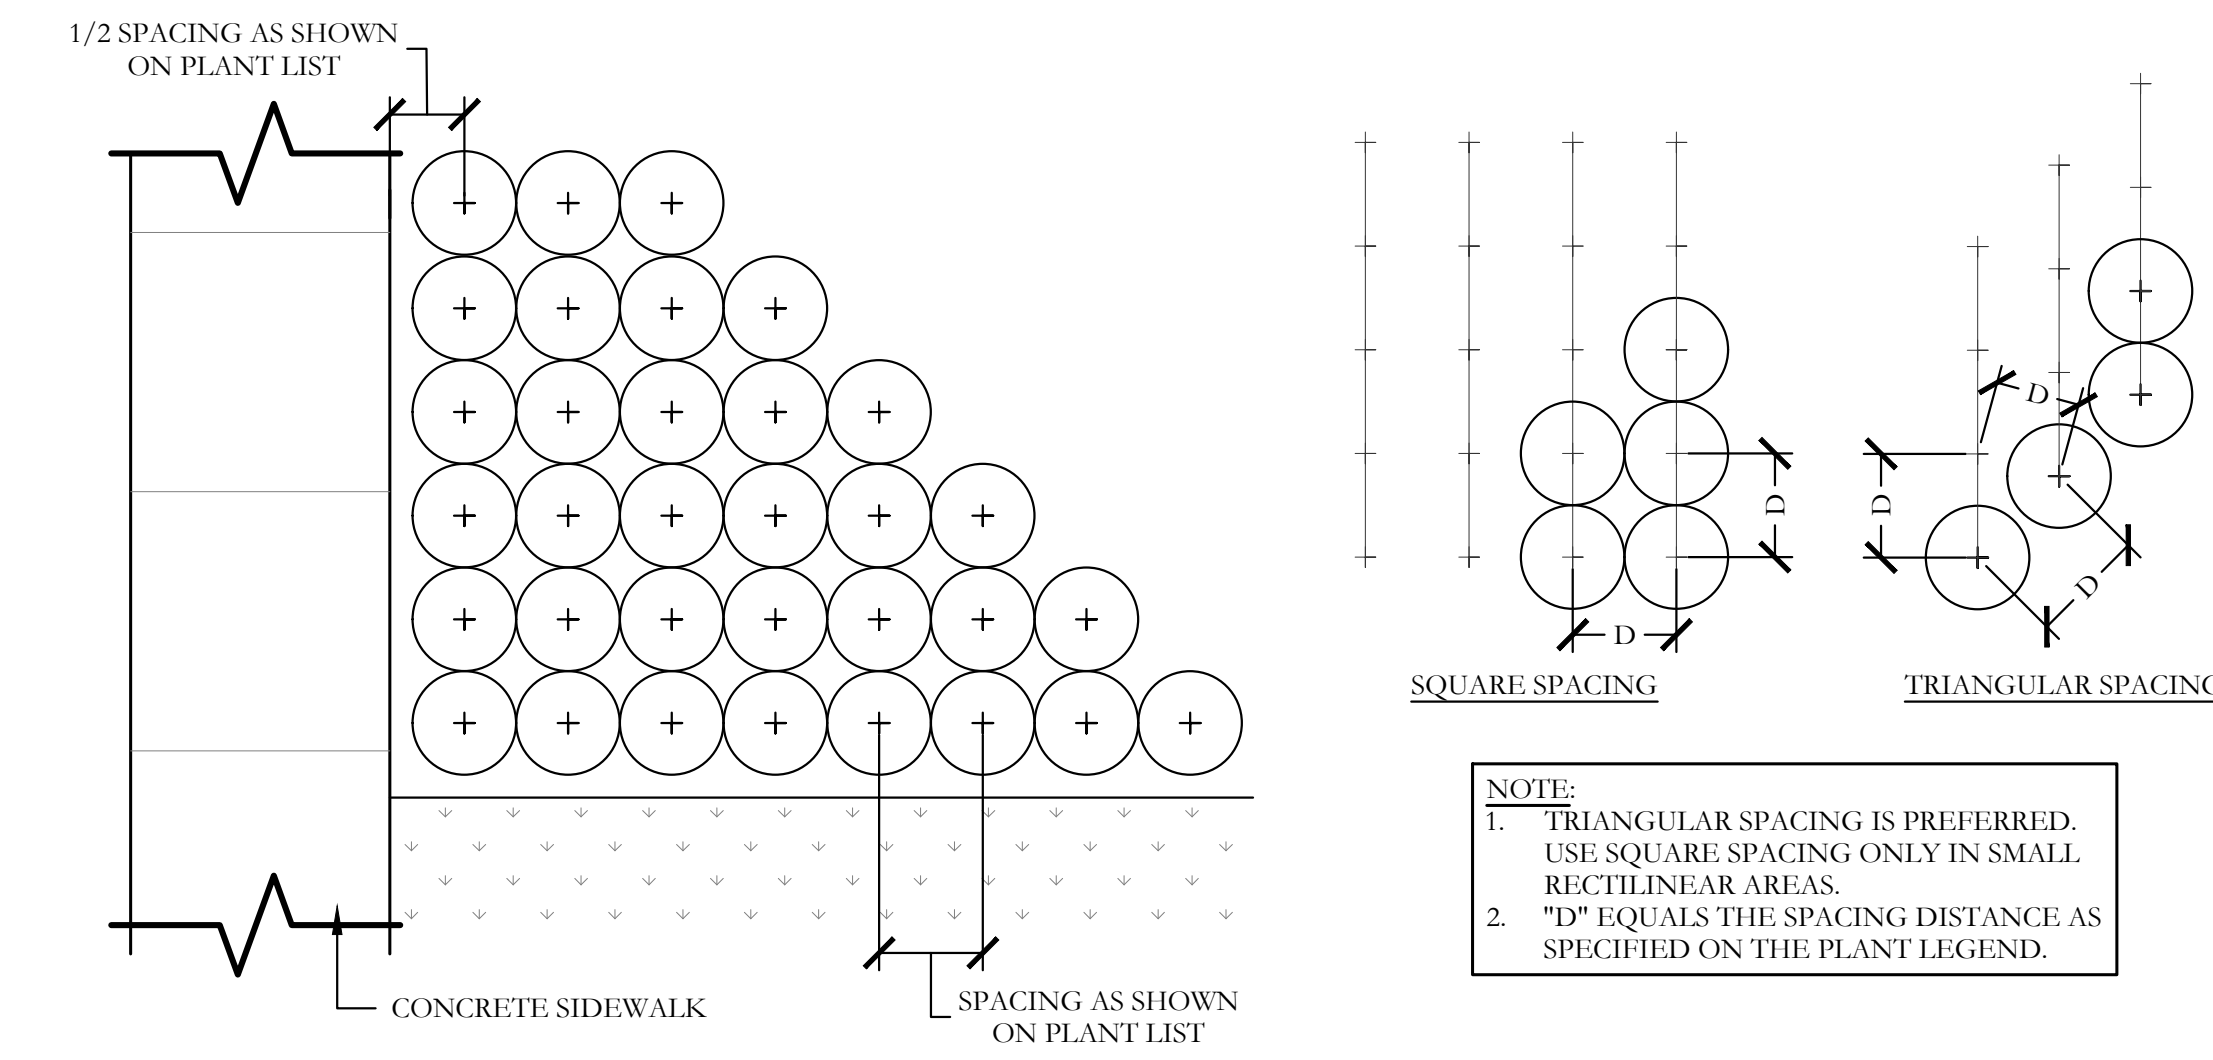

3 TYPICAL SHRUB AND GROUNDCOVER PLANTING PLAN/SECTION NOT TO SCALE

PLANT LIST						
KEY	ESTIMATED QUANTITY	COMMON NAME	SCIENTIFIC NAME	SIZE	SPACING	REMARKS
LO	9	LIVE OAK	QUERCUS VIRGINIANA	4" CALIPER	AS SHOWN	NURSERY GROWN; FULL HEAD; MINIMUM BRANCHING HEIGHT AT 6'-0"; MINIMUM 10'-0" OVERALL HEIGHT.
BO	7	BUR OAK	QUERCUS MACROCARPA	4" CALIPER	AS SHOWN	NURSERY GROWN; FULL HEAD; MINIMUM BRANCHING HEIGHT AT 6'-0"; MINIMUM 10'-0" OVERALL HEIGHT.
LE	10	LACEBARK ELM	ULMUS PARVIFOLIA	4" CALIPER	AS SHOWN	NURSERY GROWN; FULL HEAD; MINIMUM BRANCHING HEIGHT AT 6'-0"; MINIMUM 10'-0" OVERALL HEIGHT.
CE	6	CEDAR ELM	ULMUS CRASSIFOLIA	4" CALIPER	AS SHOWN	NURSERY GROWN; FULL HEAD; MINIMUM BRANCHING HEIGHT AT 6'-0"; MINIMUM 10'-0" OVERALL HEIGHT.
LGM	3	LITTLE GEM MAGNOLIA	MAGNOLIA GRANDIFLORA 'LITTLE GEM'	2" CALIPER	AS SHOWN	NURSERY GROWN; FULL HEAD; MINIMUM 8'-0" OVERALL HEIGHT.
DW	4	DESERT WILLOW	CHILOPSIS LINEARIS	2" CALIPER	AS SHOWN	NURSERY GROWN; FULL HEAD; MINIMUM 8'-0" OVERALL HEIGHT.
YH	8	YAUPON HOLLY	ILEX VOMITORIA	2" CALIPER	AS SHOWN	NURSERY GROWN; FULL HEAD; MINIMUM 8'-0" OVERALL HEIGHT.
RB	6	TEXAS REDBUD	CERCIS CANADENSIS VAR. TEXENSIS	2" CALIPER	AS SHOWN	NURSERY GROWN; FULL HEAD; MINIMUM 8'-0" OVERALL HEIGHT.
	21	PURPLE DIAMOND LOROPETALUM	LOROPETALUM CHINENSIS 'PURPLE DIAMOND'	7 GALLON	48" O.C.	CONTAINER GROWN; FULL PLANT.
	74	TEXAS SAGE	LEUCOPHYLLUM FRUTESCENS	7 GALLON	48" O.C.	CONTAINER GROWN; FULL PLANT.
	67	GLOSSY ABELIA	LINNAEA X GRANDIFLORA	7 GALLON	36" O.C.	CONTAINER GROWN; FULL PLANT.
	42	DWARF BURFORD HOLLY	ILEX CORNUTA 'DWARF BURFORD'	7 GALLON	36" O.C.	CONTAINER GROWN; FULL PLANT.
	6	UPRIGHT ROSEMARY	ROSMARINUS OFFICINALIS 'UPRIGHT'	3 GALLON	36" O.C.	CONTAINER GROWN; FULL PLANT.
	6	DWARF MAIDEN GRASS	MISCANTHUS SINENSIS ADAGIO'	3 GALLON	36" O.C.	CONTAINER GROWN; FULL PLANT.
	10	MORNING LIGHT MISCANTHUS	MISCANTHUS SINENSIS 'MORNING LIGHT'	3 GALLON	36" O.C.	CONTAINER GROWN; FULL PLANT.
	21	RED YUCCA	HESPERALOE PARVIFLORA	3 GALLON	36" O.C.	CONTAINER GROWN; FULL PLANT.
	70	PLUM YEW PROSTRATA	CEPHALOTAXUS HARRINGTONIA 'PROSTRATA'	3 GALLON	48" O.C.	CONTAINER GROWN; FULL PLANT.
	825	LIRIOPE GRASS	LIRIOPE MUSCARI	1 GALLON	18" O.C.	CONTAINER GROWN; FULL PLANT.
	85	MEXICAN FEATHER GRASS	NASSELLA TENUISSIMA	1 GALLON	18" O.C.	CONTAINER GROWN; FULL PLANT.
	825	ANNUAL COLOR	TO BE SELECTED BY OWNER	4" POT	8" O.C.	CONTAINER GROWN; FULL PLANT.
	50,135	COMMON BERMUDA GRASS	CYNODON DACTYLON	SQUARE FEET	SOLID SOD	MINIMUM 100% COVERAGE ALL AREAS SHOWN

GENERAL LANDSCAPE NOTES

- INSPECTIONS:**
- NO EXCAVATION SHALL OCCUR IN CITY R.O.W. WITHOUT A R.O.W. PERMIT--CONTACT THE PUBLIC WORKS DEPARTMENT.
 - THE CONTRACTOR SHALL MARK ALL WATER LINES, SEWER LINES, AND TREE LOCATIONS PRIOR TO CALLING FOR ROW INSPECTION AND PERMIT.
 - THE LANDSCAPE INSTALLATION SHALL COMPLY WITH APPROVED LANDSCAPE DRAWINGS PRIOR TO FINAL ACCEPTANCE BY THE CITY AND ISSUANCE OF A CERTIFICATE OF OCCUPANCY.
 - WATER METERS, CLEANOUTS AND OTHER APPURTENANCES, SHALL BE ACCESSIBLE, ADJUSTED TO GRADE, CLEARLY MARKED WITH FLAGGING AND COMPLIANT WITH PUBLIC WORKS DEPARTMENT STANDARDS PRIOR TO CALLING FOR FINAL LANDSCAPE AND ROW INSPECTIONS.

- LANDSCAPE STANDARDS:**
- PLANTINGS AND LANDSCAPE ELEMENTS SHALL COMPLY WITH THE CITY'S ENGINEERING DESIGN STANDARDS, PUBLIC R.O.W. VISIBILITY REQUIREMENTS.
 - UNLESS OTHERWISE SPECIFIED, TREES SHALL BE PLANTED NO LESS THAN 4' FROM CURBS, SIDEWALKS, UTILITY LINES, SCREENING WALLS AND OTHER STRUCTURES. THE CITY HAS FINAL APPROVAL FOR ALL TREE PLACEMENTS.
 - A MINIMUM THREE FEET (3') RADIUS AROUND A FIRE HYDRANT MUST REMAIN CLEAR OF LANDSCAPE PURSUANT TO THE FIRE CODE.
 - STREET TREES, WHERE REQUIRED, SHALL BE (10') MINIMUM FROM THE EDGE OF A STORM SEWER CURB INLET BOX AND THE EDGE OF THE ROOT BALL SHALL BE (4') MINIMUM FROM THE WATER METER.
 - THE AMERICAN STANDARD FOR NURSERY STOCK (ANSI Z60.1-2004) SPECIFICATIONS SHALL GOVERN PLANT QUALIFICATIONS, GRADES, AND STANDARDS.
 - TREE PLANTING SHALL COMPLY WITH DETAILS HEREIN AND THE INTERNATIONAL SOCIETY OF ARBORICULTURE (ISA) STANDARDS.
 - A 2-3" LAYER OF MULCH SHALL BE PROVIDED AROUND THE BASE OF THE PLANTED TREE. THE MULCH SHALL BE PULLED BACK 4" FROM THE TRUNK OF THE TREE.
 - TREE PITS SHALL BE TESTED FOR WATER PERCOLATION. IF WATER DOES NOT DRAIN OUT OF TREE PIT WITHIN 24-HOURS, THE TREE SHALL BE MOVED OR DRAINAGE SHALL BE PROVIDED.
 - ALL BEDS TO HAVE 3" OF COMPOSTED SOIL, LIVING EARTH TECHNOLOGY, OR APPROVED EQUAL TILLED AND TURNED TO A DEPTH OF 8" MINIMUM.
 - ALL PLANT BEDS SHALL BE TOP-DRESSED WITH A MINIMUM OF 3 INCHES OF HARDWOOD MULCH.
 - NATIVE SITE TOPSOILS TO BE PROTECTED FROM EROSION OR STOCKPILED. NATIVE SITE TOPSOIL SHALL BE LABORATORY TESTED BY AN ACCREDITED LABORATORY AND AMENDED PER SAID LABORATORY'S RECOMMENDATIONS.

- IRRIGATION STANDARDS:**
- ANY CHANGES TO THESE APPROVED IRRIGATION DRAWINGS SHALL BE AUTHORIZED BY THE CITY.
 - CONTACT DEVELOPMENT SERVICES FOR AN IRRIGATION PERMIT PRIOR TO INSTALLING THE IRRIGATION SYSTEM.
 - IRRIGATION OVER-SPRAY ON STREETS AND WALKS IS PROHIBITED.
 - MAINLINES, VALVES, OR CONTROL WIRES SHALL NOT BE LOCATED IN THE CITY'S ROW.
 - ET IRRIGATION CONTROLLERS SHALL BE PROGRAMMED AND ADJUSTED TO NOT EXCEED THE LANDSCAPE WATER ALLOWANCE (LWA) PRIOR TO APPROVAL OF LANDSCAPE INSTALLATION.
 - VALVES SHALL BE LOCATED A MINIMUM OF (5') AWAY FROM STORM SEWERS, AND SANITARY SEWER LINES AND 5 FEET FROM CITY FIRE HYDRANTS AND WATER VALVES.
 - THE BORE DEPTH UNDER STREETS, DRIVE AISLES, AND FIRE LANES SHALL PROVIDE (2') OF CLEARANCE (MINIMUM).
 - IRRIGATION HEADS THAT RUN PARALLEL AND NEAR PUBLIC WATER AND SANITARY SEWER LINES; SHALL BE FED FROM STUBBED LATERALS OR BULL-BEADS. A MINIMUM FIVE FOOT (5') SEPARATION IS REQUIRED BETWEEN IRRIGATION MAIN LINES AND LATERALS THAT RUN PARALLEL TO PUBLIC WATER AND SANITARY SEWER LINES.
 - NO VALVES, BACKFLOW PREVENTION ASSEMBLIES, QUICK COUPLERS ETC. SHALL BE LOCATED CLOSER THAN 10' FROM THE CURB AT STREET OR DRIVE INTERSECTION.

- MAINTENANCE STANDARDS:**
- THE OWNER SHALL BE RESPONSIBLE FOR THE ESTABLISHMENT, MAINTENANCE, AND VIGOR OF PLANT MATERIAL IN ACCORDANCE WITH THE DESIGN INTENT AND AS APPROPRIATE FOR THE SEASON OF THE YEAR.
 - LANDSCAPE AND OPEN AREAS SHALL BE FREE OF TRASH, LITTER AND WEEDS.
 - NO PLANT MATERIAL SHALL BE ALLOWED TO ENCRUSH ON R.O.W., SIDEWALKS OR EASEMENTS TO THE EXTENT THAT VISION OR ROUTE OF TRAVEL FOR VEHICULAR, PEDESTRIAN, OR BICYCLE TRAFFIC IS IMPEDED.
 - TREE MAINTENANCE SHALL BE IN ACCORDANCE WITH THE STANDARDS OF THE INTERNATIONAL SOCIETY OF ARBORICULTURE.
 - TREE STAKING MATERIALS, IF USED, SHALL BE REMOVED AFTER (1) GROWING SEASON, NO MORE THAN (1) YEAR AFTER INSTALLATION (STEEL TREE STAKES, WIRES, AND HOSES ARE PROHIBITED).

- TREE PROTECTION NOTES:**
- CONTACT DEVELOPMENT SERVICES FOR A TREE REMOVAL PERMIT PRIOR TO REMOVAL OR TRANSPLANTING OF ANY TREES.
 - ALL TREES WHICH ARE TO REMAIN ON SITE SHALL BE PROTECTED WITH A (4') TALL BRIGHTLY COLORED PLASTIC FENCE, OR SILT FENCE, PLACED AT THE DRIP LINE OF THE TREES.
 - PRIOR TO THE PRE-CONSTRUCTION MEETING OR OBTAINING A GRADING PERMIT, ALL TREE MARKINGS AND PROTECTIVE FENCING SHALL BE INSTALLED BY THE OWNER AND BE INSPECTED BY DEVELOPMENT SERVICES.
 - NO EQUIPMENT SHALL BE CLEANED, OR HARMFUL LIQUIDS DEPOSITED WITHIN THE LIMITS OF THE ROOT ZONE OF TREES WHICH REMAIN ON SITE.
 - NO SIGNS, WIRES, OR OTHER ATTACHMENTS SHALL BE ATTACHED TO ANY TREE TO REMAIN ON SITE.
 - VEHICULAR AND CONSTRUCTION EQUIPMENT SHALL NOT PARK OR DRIVE WITHIN THE LIMITS OF THE DRIP LINE.
 - GRADE CHANGES IN EXCESS OF 3 INCHES (CUT OR FILL) SHALL NOT BE ALLOWED WITHIN A ROOT ZONE, UNLESS ADEQUATE TREE PRESERVATION METHODS ARE APPROVED BY THE CITY.
 - NO TRENCHING SHALL BE ALLOWED WITHIN THE DRIP-LINE OF A TREE, UNLESS APPROVED BY THE CITY.
 - ALL REMOVED TREES SHALL BE CHIPPED AND USED FOR MULCH ON SITE OR HAULED OFF-SITE.
 - ALL TREE MAINTENANCE TECHNIQUES SHALL BE IN CONFORMANCE WITH INDUSTRY IDENTIFIED STANDARDS. IMPROPER OR MALICIOUS PRUNING TECHNIQUES ARE STRICTLY PROHIBITED.

ALL RESPONSIBILITY FOR ADEQUACY OF DESIGN REMAINS WITH THE DESIGN ENGINEER. THE CITY OF ROCKWALL, IN REVIEWING AND RELEASING PLANS FOR CONSTRUCTION, ASSUMES NO RESPONSIBILITY FOR ADEQUACY OR ACCURACY OF DESIGN.

APPROVED:
I hereby certify that the above and foregoing site plan for a development in the City of Rockwall, Texas, was approved by the Planning & Zoning Commission of the City of Rockwall on the [DAY] day of [MONTH], [YEAR].

WITNESS OUR HANDS, this [DAY] day of [MONTH], [YEAR].

Planning & Zoning Commission, Chairman

Director of Planning and Zoning



JOHNSON VOLK CONSULTING

704 Central Parkway East | Suite 1200 | Plano, Texas 75074 | 972.201.3100

Planning and Zoning Department
City of Rockwall – Planning and Zoning Department
385 S. Goliad Street
Rockwall, Texas 75087

November 13, 2023

Tree Survey Affidavit

Nelson Lake Estates, Phase 1, Amenity Center
City of Rockwall, Rockwall County, Texas

To Whom it May Concern,

After an extensive field investigation and tree inventory, we have determined that no protected trees exist on site for this development. Because of this, we have not prepared tree survey plans, checklists, and applicable plans for tree survey, mitigation, and/or tree preservation per the City of Rockwall Ordinance.

If you have any questions or concerns, please let me know.

Sincerely,

Cody Johnson, RLA, ASLA, LI
Johnson Volk Consulting
407 Central Parkway East
Suite 1200
Plano, Texas 75074



DEVELOPMENT APPLICATION

City of Rockwall
Planning and Zoning Department
385 S. Goliad Street
Rockwall, Texas 75087

STAFF USE ONLY

PLANNING & ZONING CASE NO. _____

NOTE: THE APPLICATION IS NOT CONSIDERED ACCEPTED BY THE CITY UNTIL THE PLANNING DIRECTOR AND CITY ENGINEER HAVE SIGNED BELOW.

DIRECTOR OF PLANNING: _____

CITY ENGINEER: _____

PLEASE CHECK THE APPROPRIATE BOX BELOW TO INDICATE THE TYPE OF DEVELOPMENT REQUEST [SELECT ONLY ONE BOX]:

<p>PLATTING APPLICATION FEES:</p> <p><input type="checkbox"/> MASTER PLAT (\$100.00 + \$15.00 ACRE)¹</p> <p><input type="checkbox"/> PRELIMINARY PLAT (\$200.00 + \$15.00 ACRE)¹</p> <p><input type="checkbox"/> FINAL PLAT (\$300.00 + \$20.00 ACRE)¹</p> <p><input type="checkbox"/> REPLAT (\$300.00 + \$20.00 ACRE)¹</p> <p><input type="checkbox"/> AMENDING OR MINOR PLAT (\$150.00)</p> <p><input type="checkbox"/> PLAT REINSTATEMENT REQUEST (\$100.00)</p> <p>SITE PLAN APPLICATION FEES:</p> <p><input checked="" type="checkbox"/> SITE PLAN (\$250.00 + \$20.00 ACRE)¹</p> <p><input checked="" type="checkbox"/> AMENDED SITE PLAN/ELEVATIONS/LANDSCAPING PLAN (\$100.00)</p>	<p>ZONING APPLICATION FEES:</p> <p><input type="checkbox"/> ZONING CHANGE (\$200.00 + \$15.00 ACRE)¹</p> <p><input type="checkbox"/> SPECIFIC USE PERMIT (\$200.00 + \$15.00 ACRE)^{1&2}</p> <p><input type="checkbox"/> PD DEVELOPMENT PLANS (\$200.00 + \$15.00 ACRE)¹</p> <p>OTHER APPLICATION FEES:</p> <p><input type="checkbox"/> TREE REMOVAL (\$75.00)</p> <p><input type="checkbox"/> VARIANCE REQUEST/SPECIAL EXCEPTIONS (\$100.00)²</p> <p>NOTES:</p> <p>¹: IN DETERMINING THE FEE, PLEASE USE THE EXACT ACREAGE WHEN MULTIPLYING BY THE PER ACRE AMOUNT. FOR REQUESTS ON LESS THAN ONE ACRE, ROUND UP TO ONE (1) ACRE.</p> <p>²: A \$1,000.00 FEE WILL BE ADDED TO THE APPLICATION FEE FOR ANY REQUEST THAT INVOLVES CONSTRUCTION WITHOUT OR NOT IN COMPLIANCE TO AN APPROVED BUILDING PERMIT.</p>
--	--

PROPERTY INFORMATION [PLEASE PRINT]

ADDRESS: Amenity Center within Homestead

SUBDIVISION: Homestead LOT: 9 BLOCK: F

GENERAL LOCATION: Corner of Fisher Road and Hardin Boulevard

ZONING, SITE PLAN AND PLATTING INFORMATION [PLEASE PRINT]

CURRENT ZONING	Single Family Residential	CURRENT USE	Private Recreation Center
PROPOSED ZONING	Single Family Residential	PROPOSED USE	Private Recreation Center
ACREAGE	1.60	LOTS [CURRENT]	1
		LOTS [PROPOSED]	1

SITE PLANS AND PLATS: BY CHECKING THIS BOX YOU ACKNOWLEDGE THAT DUE TO THE PASSAGE OF HB3167 THE CITY NO LONGER HAS FLEXIBILITY WITH REGARD TO ITS APPROVAL PROCESS, AND FAILURE TO ADDRESS ANY OF STAFF'S COMMENTS BY THE DATE PROVIDED ON THE DEVELOPMENT CALENDAR WILL RESULT IN THE DENIAL OF YOUR CASE.

OWNER/APPLICANT/AGENT INFORMATION [PLEASE PRINT/CHECK THE PRIMARY CONTACT/ORIGINAL SIGNATURES ARE REQUIRED]

<input type="checkbox"/> OWNER	SH DEV KLUTTS ROCKWALL LLC	<input checked="" type="checkbox"/> APPLICANT	Johnson Volk Consulting
CONTACT PERSON	Stephen Pepper	CONTACT PERSON	Cody Johnson
ADDRESS	2400 Dallas Parkway Suite 460	ADDRESS	704 Central Parkway East Suite 1200
CITY, STATE & ZIP	Plano, Texas 75093	CITY, STATE & ZIP	Plano, Texas 75074
PHONE	972-526-7700	PHONE	972-201-3100
E-MAIL	stephen.pepper@shaddockhomes.com	E-MAIL	cody.johnson@johnsonvolk.com

NOTARY VERIFICATION [REQUIRED]

BEFORE ME, THE UNDERSIGNED AUTHORITY, ON THIS DAY PERSONALLY APPEARED Stephen Pepper [OWNER] THE UNDERSIGNED, WHO STATED THE INFORMATION ON THIS APPLICATION TO BE TRUE AND CERTIFIED THE FOLLOWING:

"I HEREBY CERTIFY THAT I AM THE OWNER FOR THE PURPOSE OF THIS APPLICATION; ALL INFORMATION SUBMITTED HEREIN IS TRUE AND CORRECT; AND THE APPLICATION FEE OF \$ 382.00 TO COVER THE COST OF THIS APPLICATION, HAS BEEN PAID TO THE CITY OF ROCKWALL ON THIS THE 13th DAY OF November, 2023 BY SIGNING THIS APPLICATION. I AGREE THAT THE CITY OF ROCKWALL (I.E. "CITY") IS AUTHORIZED AND PERMITTED TO PROVIDE INFORMATION CONTAINED WITHIN THIS APPLICATION TO THE PUBLIC. THE CITY IS ALSO AUTHORIZED AND PERMITTED TO REPRODUCE ANY COPYRIGHTED INFORMATION SUBMITTED IN CONJUNCTION WITH THIS APPLICATION, IF SUCH REPRODUCTION IS ASSOCIATED OR IN RESPONSE TO A REQUEST FOR PUBLIC INFORMATION."


GIVEN UNDER MY HAND AND SEAL OF OFFICE ON THIS THE 13th DAY OF November, 2023

OWNER'S SIGNATURE

Stephen Pepper

NOTARY PUBLIC IN AND FOR THE STATE OF TEXAS

Deanna Walker

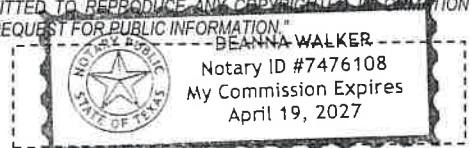

MY COMMISSION EXPIRES

PD-67

Feet

0 230 460

920

1,380

1,840

SP2023-046: Site Plan for Amenity Center within Homestead

AG

549

SFE-4

STEM 549

PD-92

PD-63

SFE-2

AG

1139

BM 1139

C

Case Location Map = 




City of Rockwall

Planning & Zoning Department
385 S. Goliad Street
Rockwall, Texas 75087
(P): (972) 771-7745
(W): www.rockwall.com

The City of Rockwall GIS maps are continually under development and therefore subject to change without notice. While we endeavor to provide timely and accurate information, we make no guarantees. The City of Rockwall makes no warranty, express or implied, including warranties of merchantability and fitness for a particular purpose. Use of the information is the sole responsibility of the user.



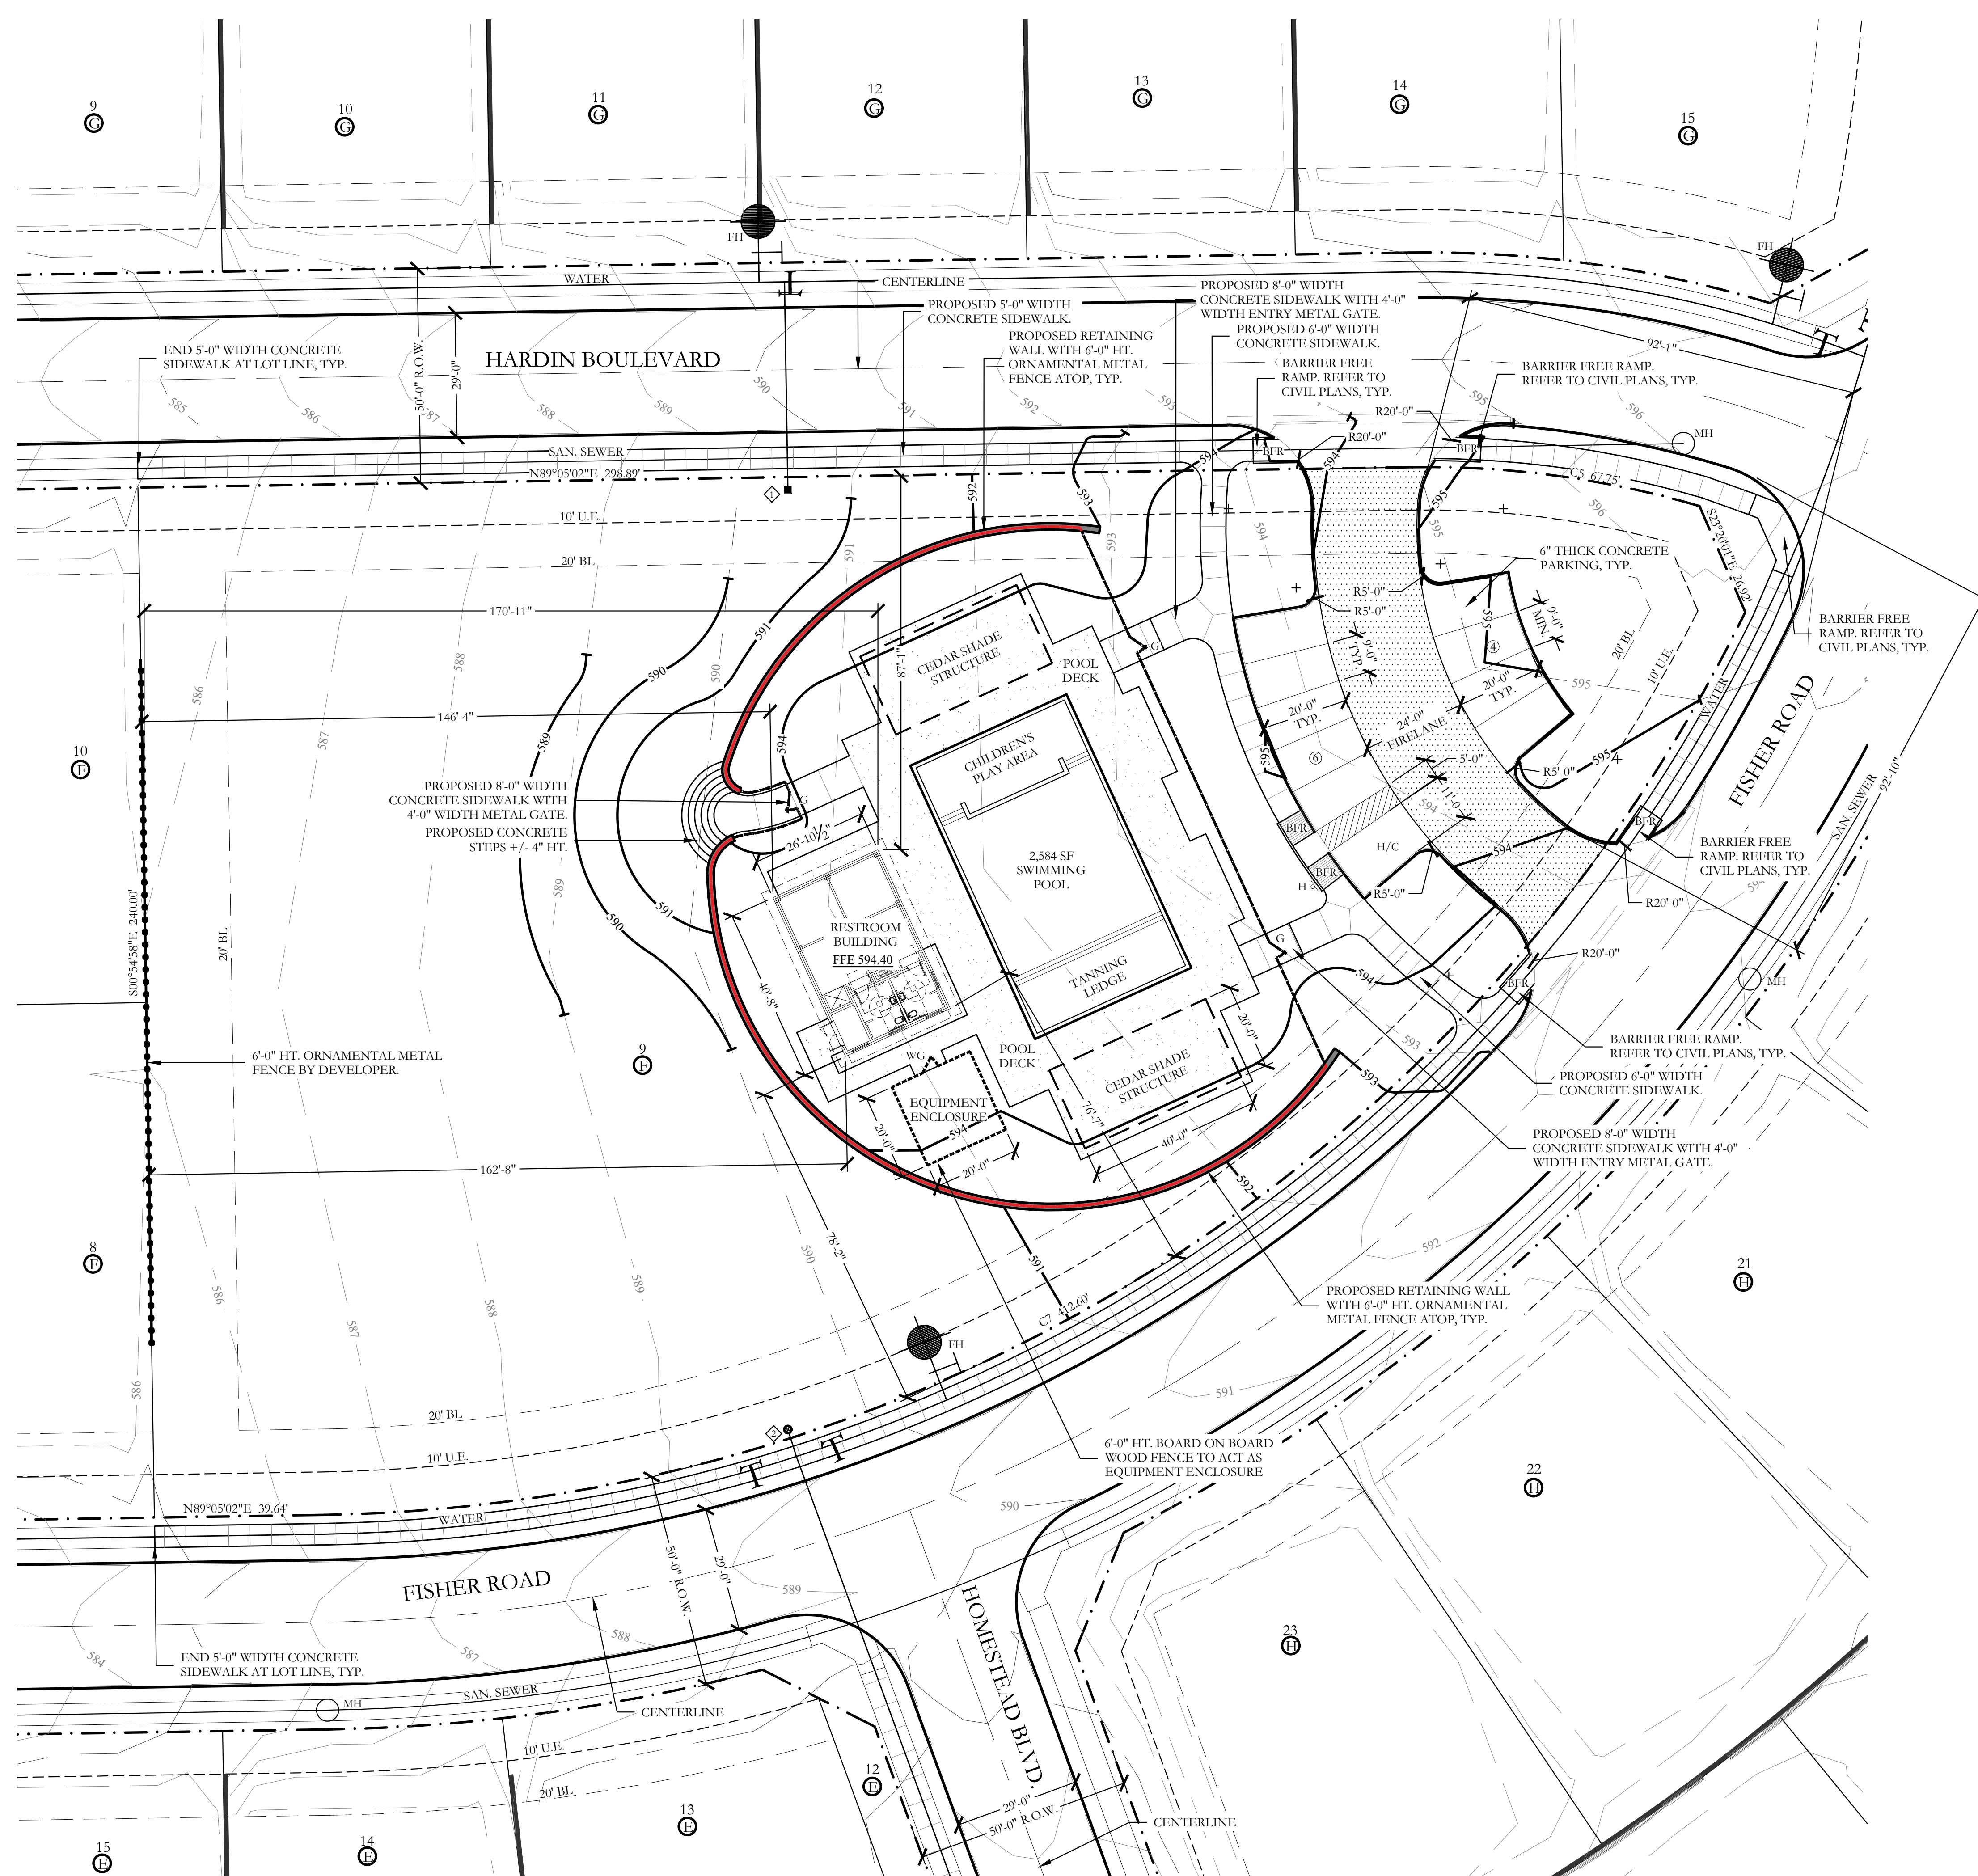

LEGEND

- ④ PROPOSED PARKING COUNT
- H/C PROPOSED HANDICAP PARKING SPACE
- BFR PROPOSED BARRIER FREE RAMP
- FH EXISTING FIRE HYDRANT
- MH EXISTING SANITARY SEWER MANHOLE
- EXISTING WATER MAIN W/ VALVE
- EXISTING SANITARY SEWER
- - - RIGHT-OF-WAY
- 593 - EXISTING CONTOUR INTERVAL
- 592 - PROPOSED CONTOUR INTERVAL
- FFE 594.40 FINISHED FLOOR ELEVATION
- ◊ PROPOSED 1.5" DOMESTIC WATER METER
- ◊ PROPOSED 1.5" IRRIGATION WATER METER
- H HANDICAP PARKING SIGN
- PROPOSED RETAINING WALL
- ORNAMENTAL METAL FENCE (6'-0" HT. AROUND SWIMMING POOL AREA)
- ORNAMENTAL METAL FENCE ATOP RETAINING WALL (6'-0" HT. AROUND SWIMMING POOL AREA)
- ▲ 1 - 4'-0" WIDTH SELF LATCHING, SELF CLOSING METAL GATE
- ▲ 1 - 4'-0" WIDTH SELF LATCHING, SELF CLOSING WOODEN GATE
- 6'-0" HT. WOOD FENCE TO ACT AS POOL EQUIPMENT AND TRASH TOTE ENCLOSURE
- ORNAMENTAL METAL FENCE ALONG PROPERTY LINE
- ▨ FIRELANE PAVING PER CITY STANDARD DETAILS

WATER METER SCHEDULE

METER ID NUMBER	WATER SERVICE SIZE	WATER METER SIZE	METER DOM	METER IRR	SAN. SERVICE SIZE
◊	1.5"	1.5"	X		6"
◊	1.5"	1.5"		X	6"

SITE PLAN NOTES:

- NO 100 YEAR FLOOD PLAIN EXISTS ON PROPERTY.
- FOR ALL BARRIER FREE RAMP NOTED ON PLAN, REFERENCE THE CITY OF ROCKWALL STANDARD CONSTRUCTION DETAILS.
- ALL HANDICAP PARKING SPACES SHALL BE A MINIMUM OF 11'-0" WIDTH x 20'-0" LENGTH WITH A 5'-0" LOADING AISLE.
- STANDARD PARKING SPACES SHALL BE A MINIMUM OF 9'-0" WIDTH x 20'-0" LENGTH.
- THE PERIMETER FENCING SHALL BE 6'-0" HT. ORNAMENTAL METAL FENCE.
- ALL VEHICULAR AND SIDEWALK PAVING SHOWN ON THESE PLANS SHALL BE MAINTAINED BY THE HOA.

SITE INFORMATION

SINGLE FAMILY RESIDENTIAL
 PROPOSED USE: PRIVATE RECREATION CENTER
 LAND AREA: 1.60 ACRES
 69,696.00 SQ. FT.

BUILDING AREA: 1,092.73 SQUARE FEET
 BUILDING HEIGHT: 22'-7" (1 STORY)

FLOOR TO AREA: 0.0156:1 (1,092.73/69,696.00)
 LOT COVERAGE: 1.56%

PARKING REQUIRED: 1 PER 250 SF. OF ASSEMBLY SPACE
 1,092.73/250=4.37
 5 REQUIRED SPACES
 PARKING PROVIDED: 10 TOTAL, (WITH 1 HANDICAP)

HANDICAP PARKING IS PROVIDED IN ACCORDANCE WITH ADA STANDARDS


TOTAL IMPERVIOUS SURFACE: 16,759.40 SF
 PROPOSED IMPERVIOUS RATIO: 0.2404 OR 24.04%
 INTERIOR LANDSCAPE PROVIDED: 52,936.60 SF

POOL DECK SURFACE: 5,524.59 SF



APPROVED:
 I hereby certify that the above and foregoing site plan for a development in the City of Rockwall, Texas, was approved by the Planning & Zoning Commission of the City of Rockwall on the [DAY] day of [MONTH], [YEAR].

WITNESS OUR HANDS, this [DAY] day of [MONTH], [YEAR].

 Planning & Zoning Commission, Chairman Director of Planning and Zoning

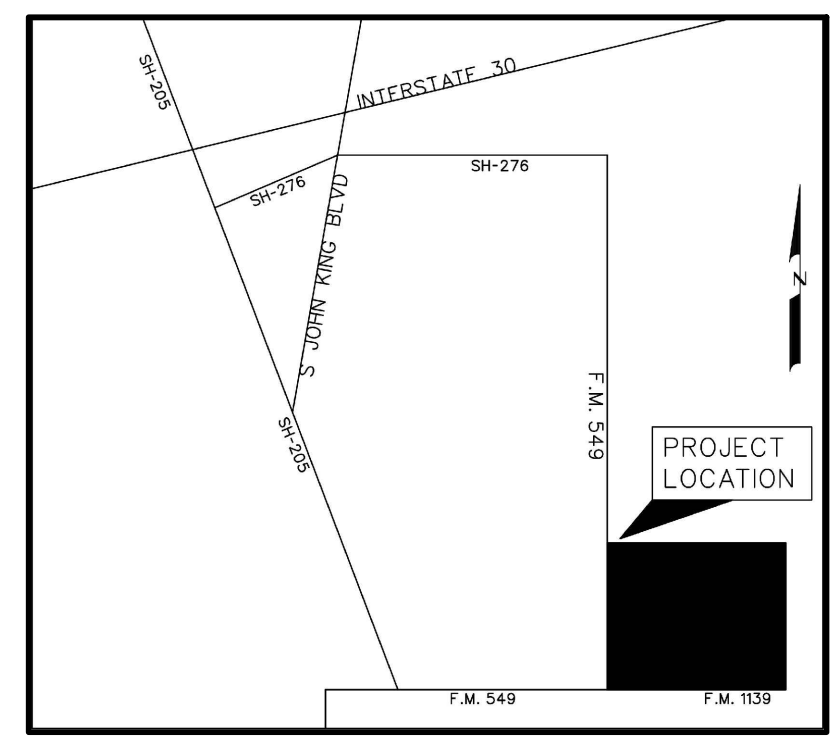

LOCATION MAP
 NOT TO SCALE

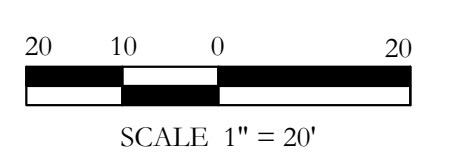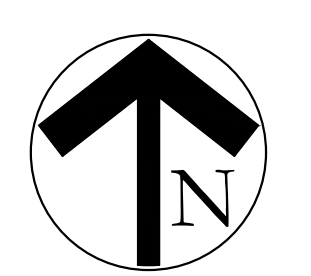

SITE PLAN
HOMESTEAD, PHASE 1
LOT 9, BLOCK F
~AMENITY CENTER~

BEING 1.600 ACRES OUT OF THE
 J.A. RAMSEY SURVEY
 ABSTRACT NO. 186 IN THE
 CITY OF ROCKWALL, ROCKWALL COUNTY, TEXAS

OWNER / DEVELOPER:
 SHADDOCK HOMES, INC
 2400 DALLAS PARKWAY, SUITE 460
 MCKINNEY, TEXAS 75093
 CONTACT: LORA ERDMAN

LANDSCAPE ARCHITECT/CIVIL ENGINEER:
 JOHNSON VOLK CONSULTING
 704 CENTRAL PARKWAY EAST, SUITE 1200
 PLANO, TEXAS 75074
 PH. 972-201-3100
 CONTACT: CODY JOHNSON, RLA, ASLA, LI



November 13, 2023

CITY CASE NO. T8D

BUILDING MATERIAL CALCULATIONS


Material	North	Percent	South	Percent	East	Percent	West	Percent
TOTAL SQ FT.	413 S.F.	-	448 S.F.	-	186 S.F.	-	186 S.F.	-
PRIMARY MATERIAL TOTALS	338 S.F.	81.84%	222 S.F.	49.56%	134 S.F.	72.04%	157 S.F.	84.41%
BRICK VENEER (TO BE SELECTED BY OWNER)	94 S.F.	22.76%	36 S.F.	8.04%	41 S.F.	22.04%	63 S.F.	33.87%
BOARD AND BATTEN FIBER CEMENT SIDING (TO BE SELECTED BY OWNER)	244 S.F.	59.08%	186 S.F.	41.52%	93 S.F.	50.00%	94 S.F.	50.54%
SECONDARY MATERIALS	3 S.F.	0.73%	178 S.F.	39.73%	7 S.F.	3.76%	7 S.F.	3.76%
DOUGLAS FIR BEAMS/COLUMNS (STAIN TO BE SELECTED BY OWNER)	3 S.F.	0.73%	81 S.F.	18.08%	7 S.F.	3.76%	7 S.F.	3.76%
TILE AT SHOWER/DRINKING FOUNTAINS (TO BE SELECTED BY OWNER)	-	-	97 S.F.	21.65%	-	-	-	-
DOORS/WINDOWS/TRIM (COLOR TO MATCH ADJACENT MATERIALS)	72 S.F.	17.43%	48 S.F.	10.71%	45 S.F.	24.20%	22 S.F.	11.83%
ROOF (STANDING SEAM METAL, COLOR TO BE SELECTED BY OWNER)	-	-	-	-	-	-	-	-



ACME BRICK
WHITE BLUFF



MUELLER, INC.
DARK CHARCOAL

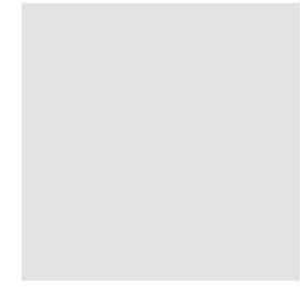

SHERWIN WILLIAMS
ICE CUBE
SW 6252



SHERWIN WILLIAMS
WEB GRAY
SW 7075







SHERWIN WILLIAMS
KINGS CANYON (WOOD STAIN)
SW 3026



DALTLIE
DARK GREY (TILE)
12 X 24



GLASS WINDOW
WITH
FROSTED GLAZING

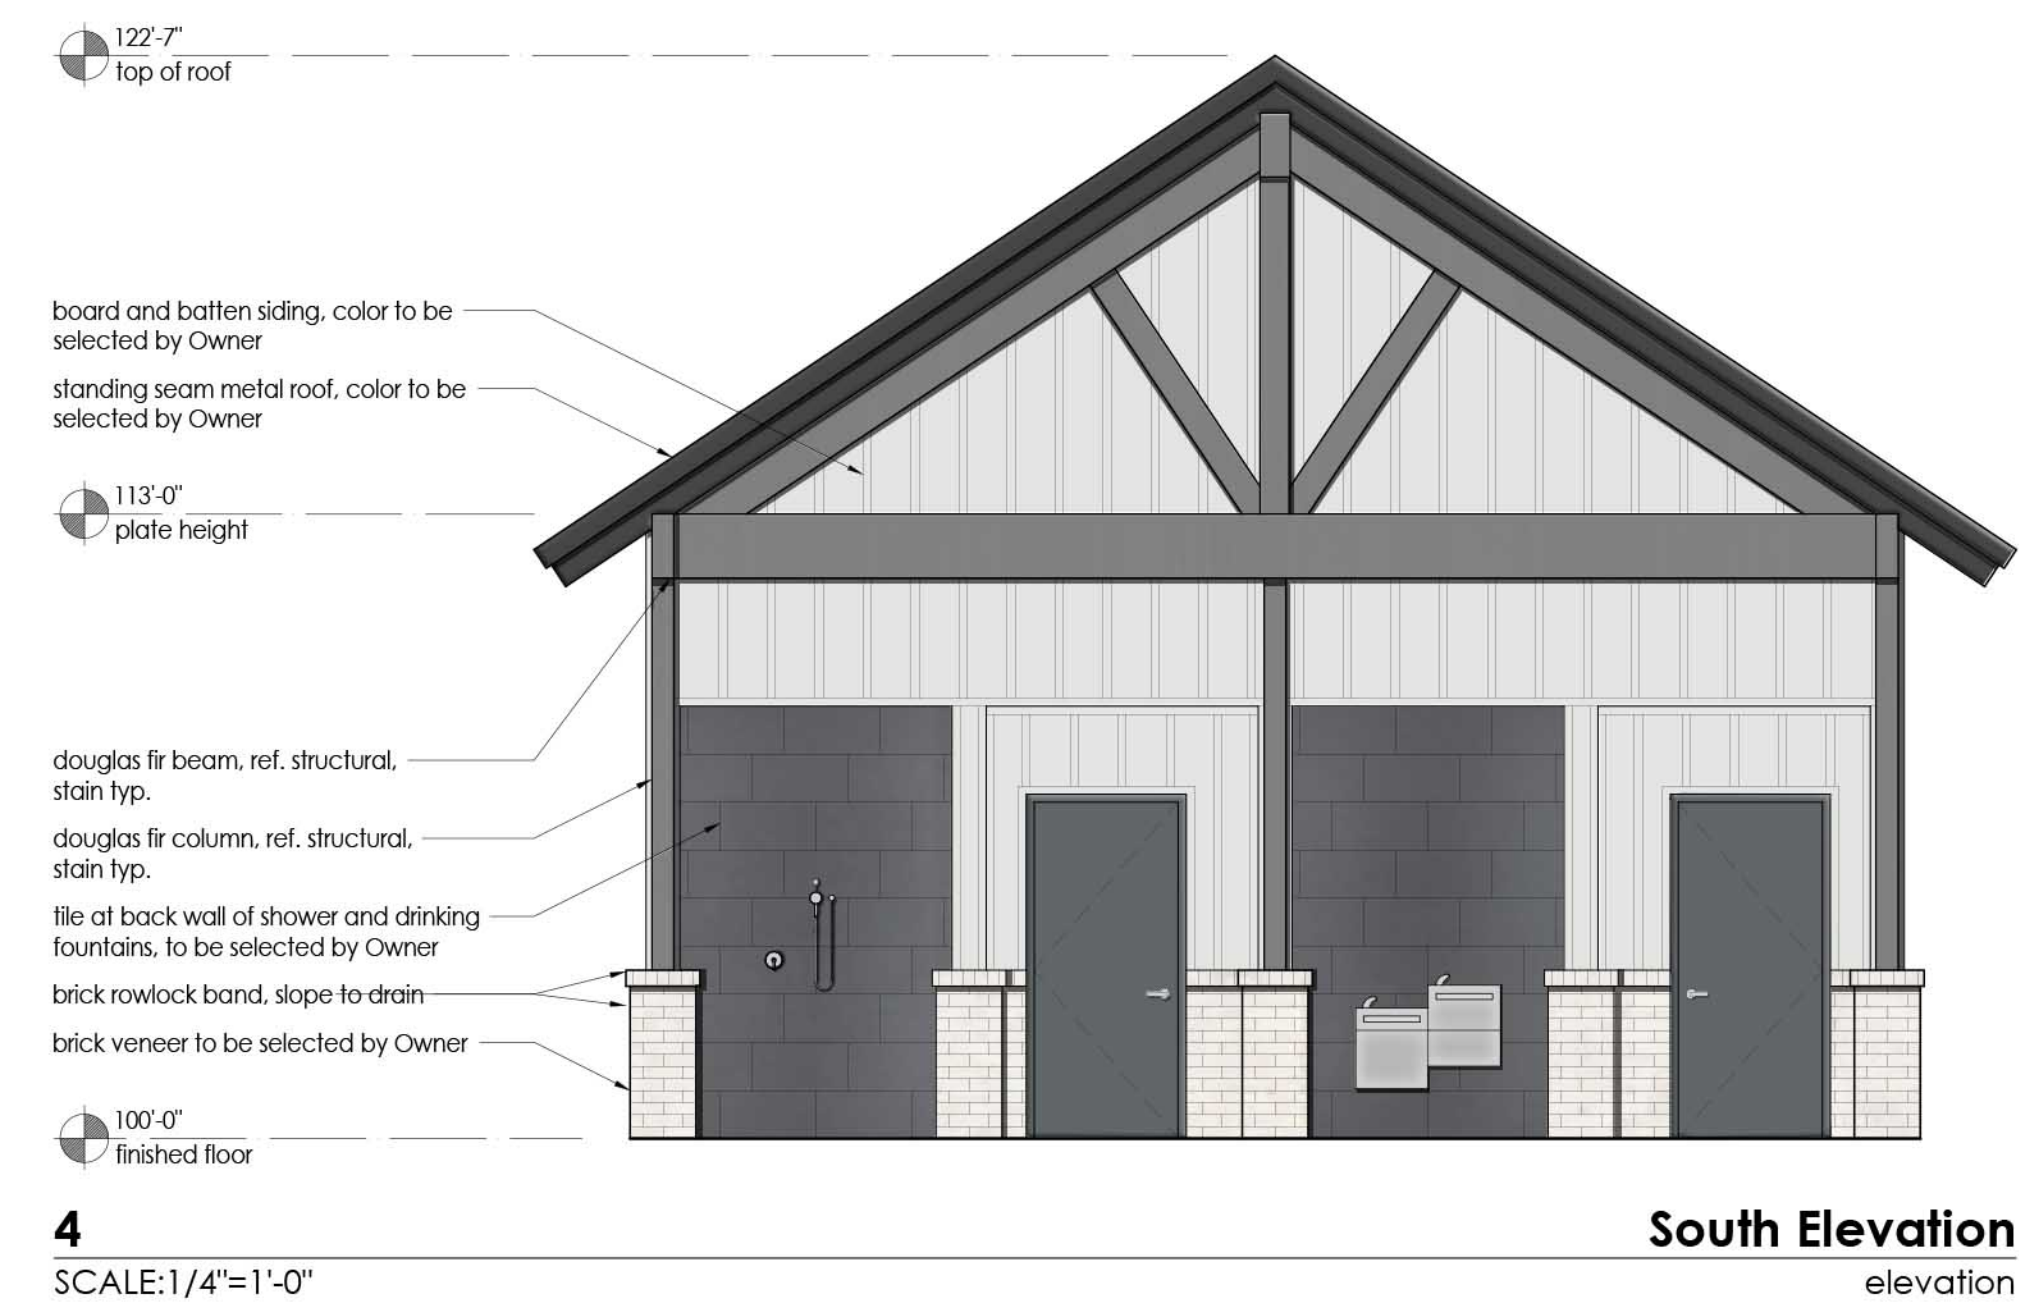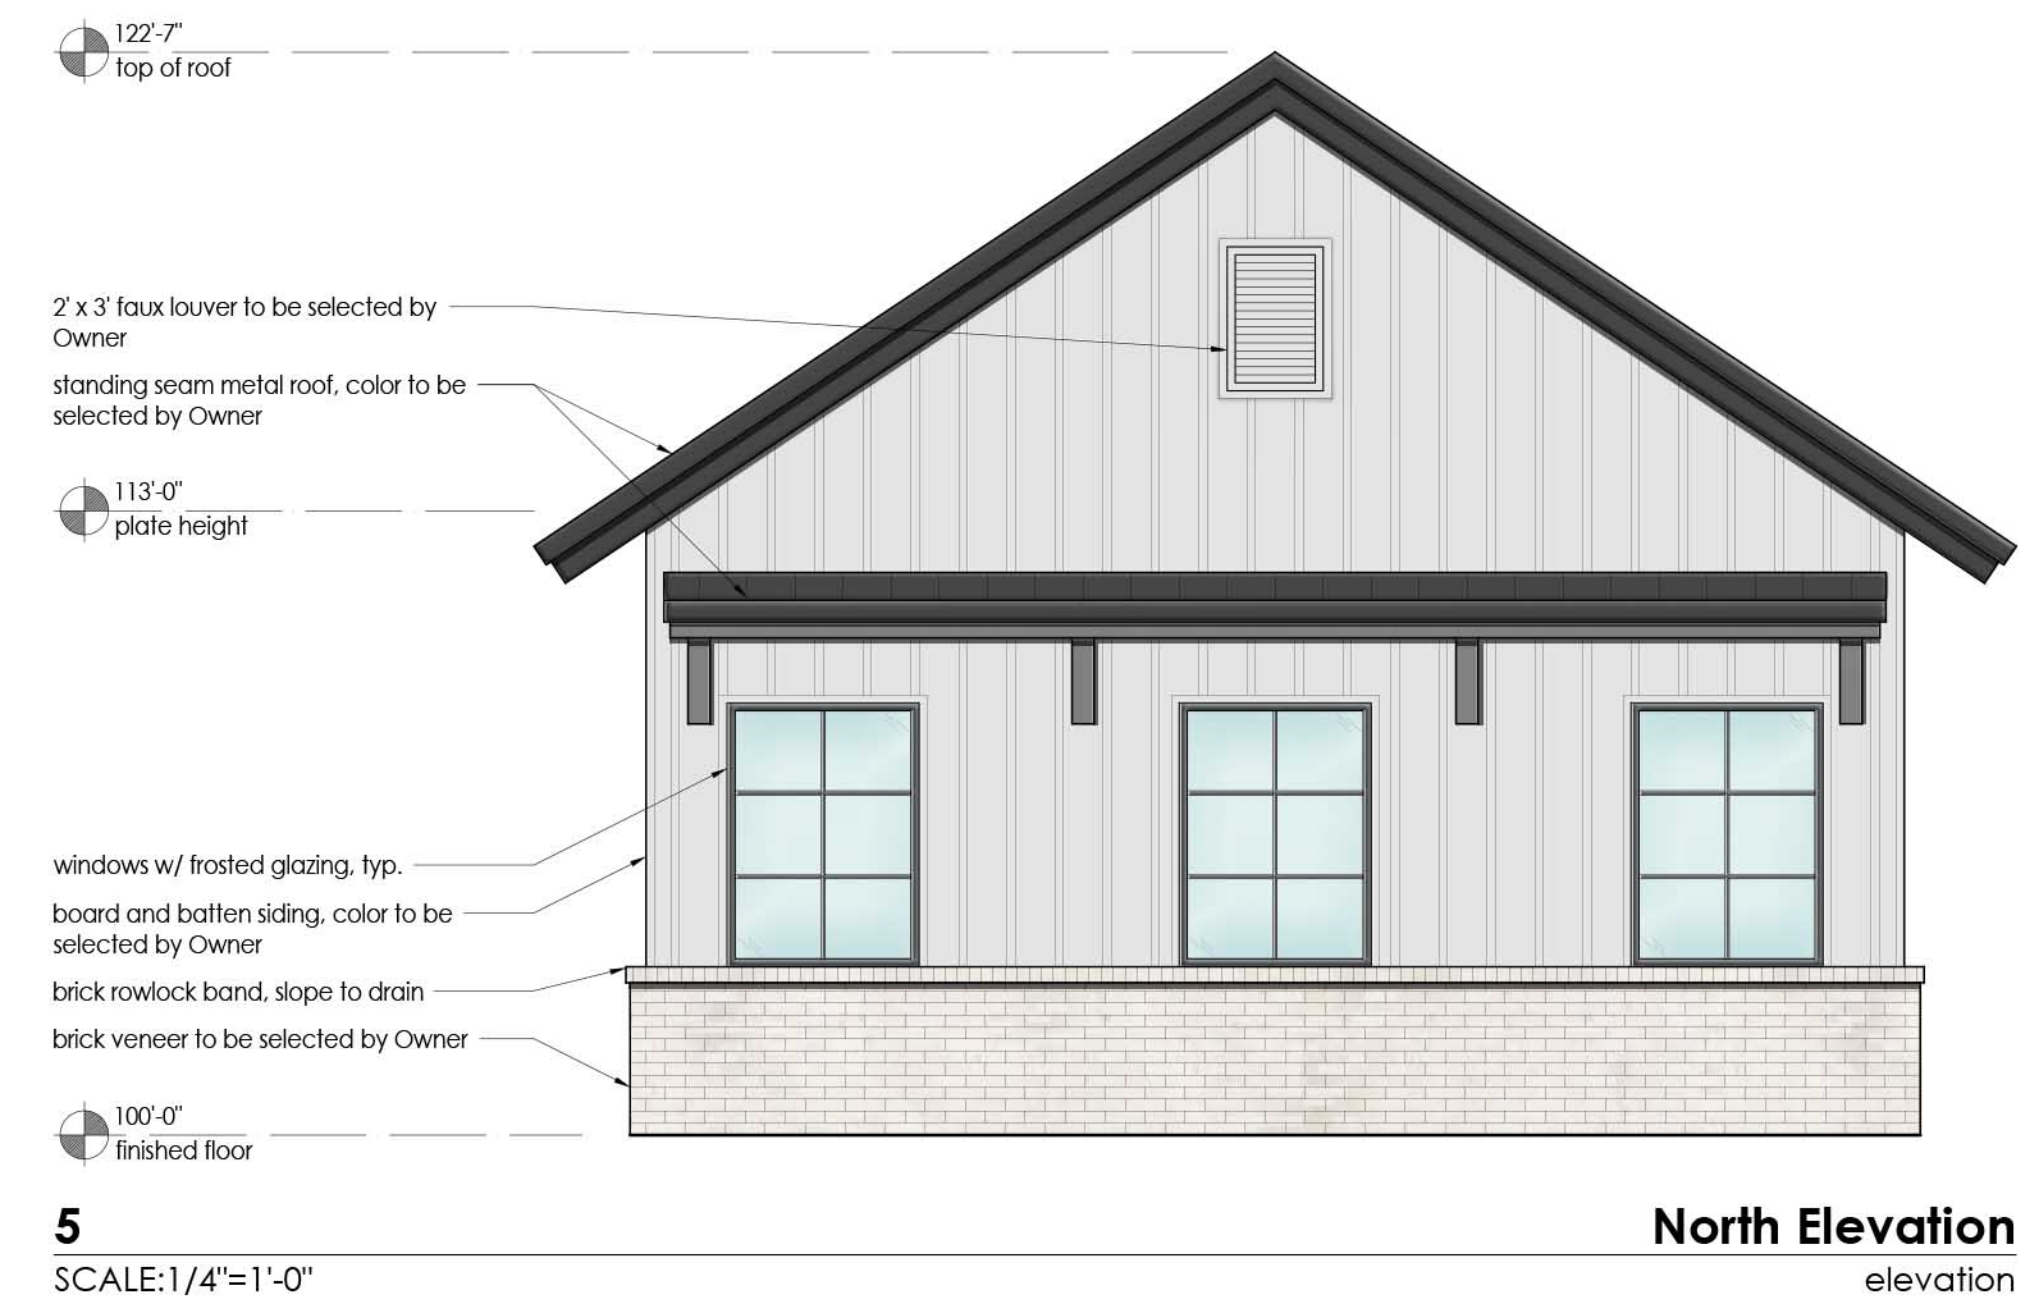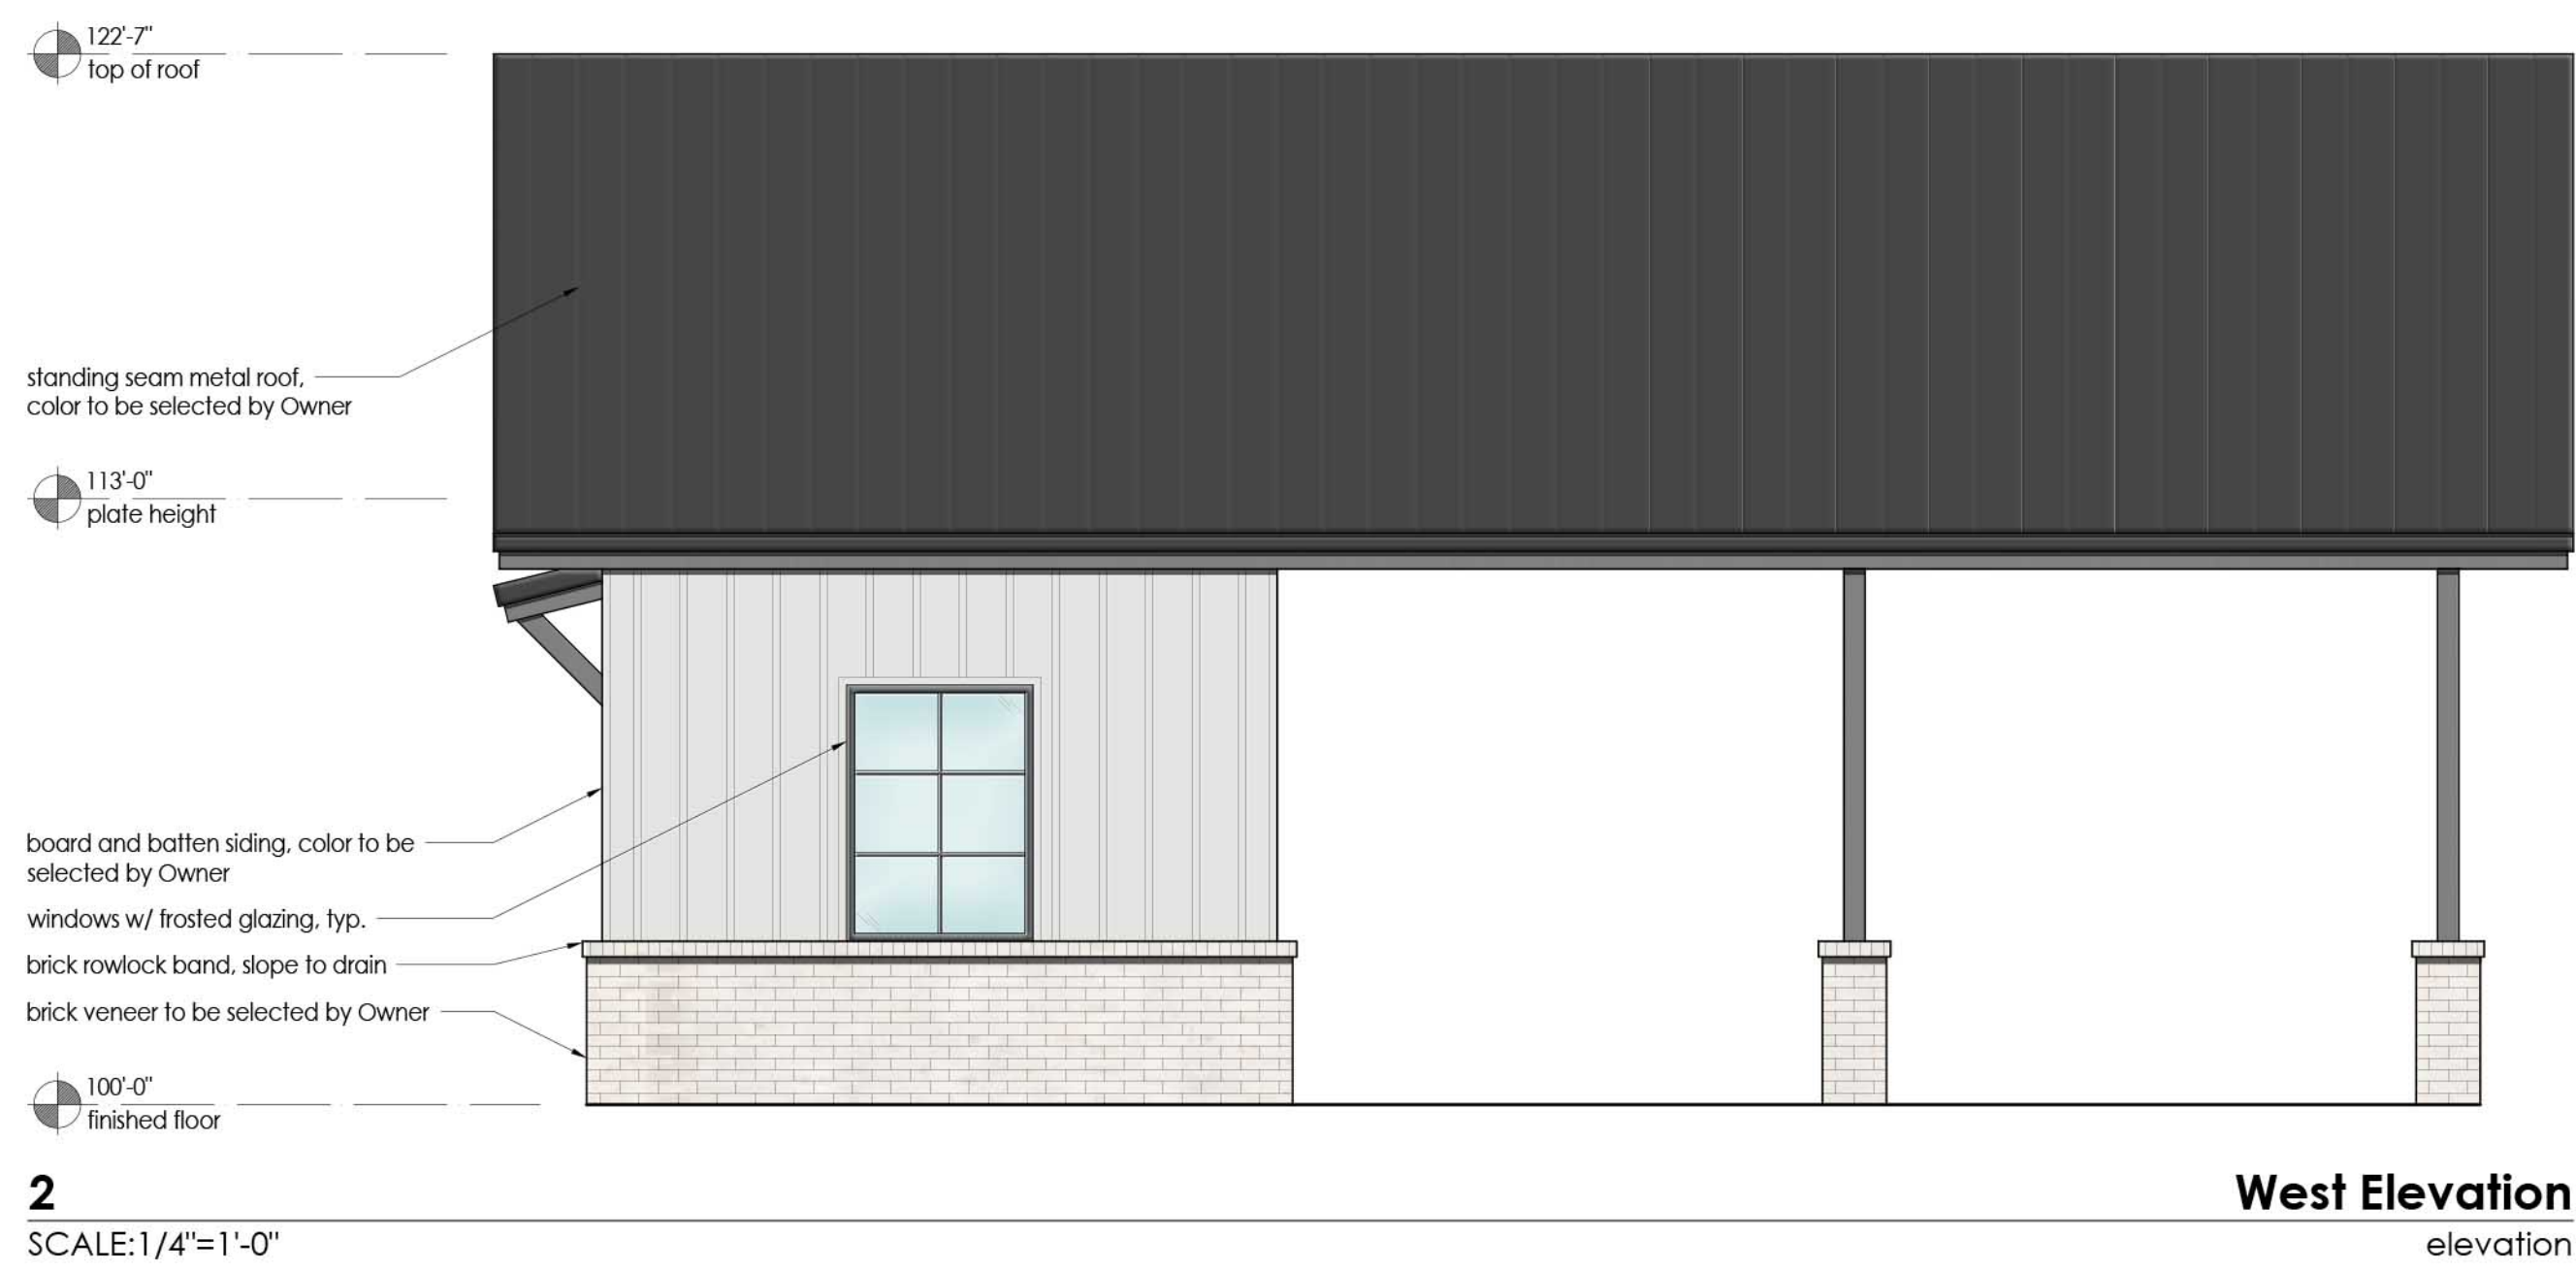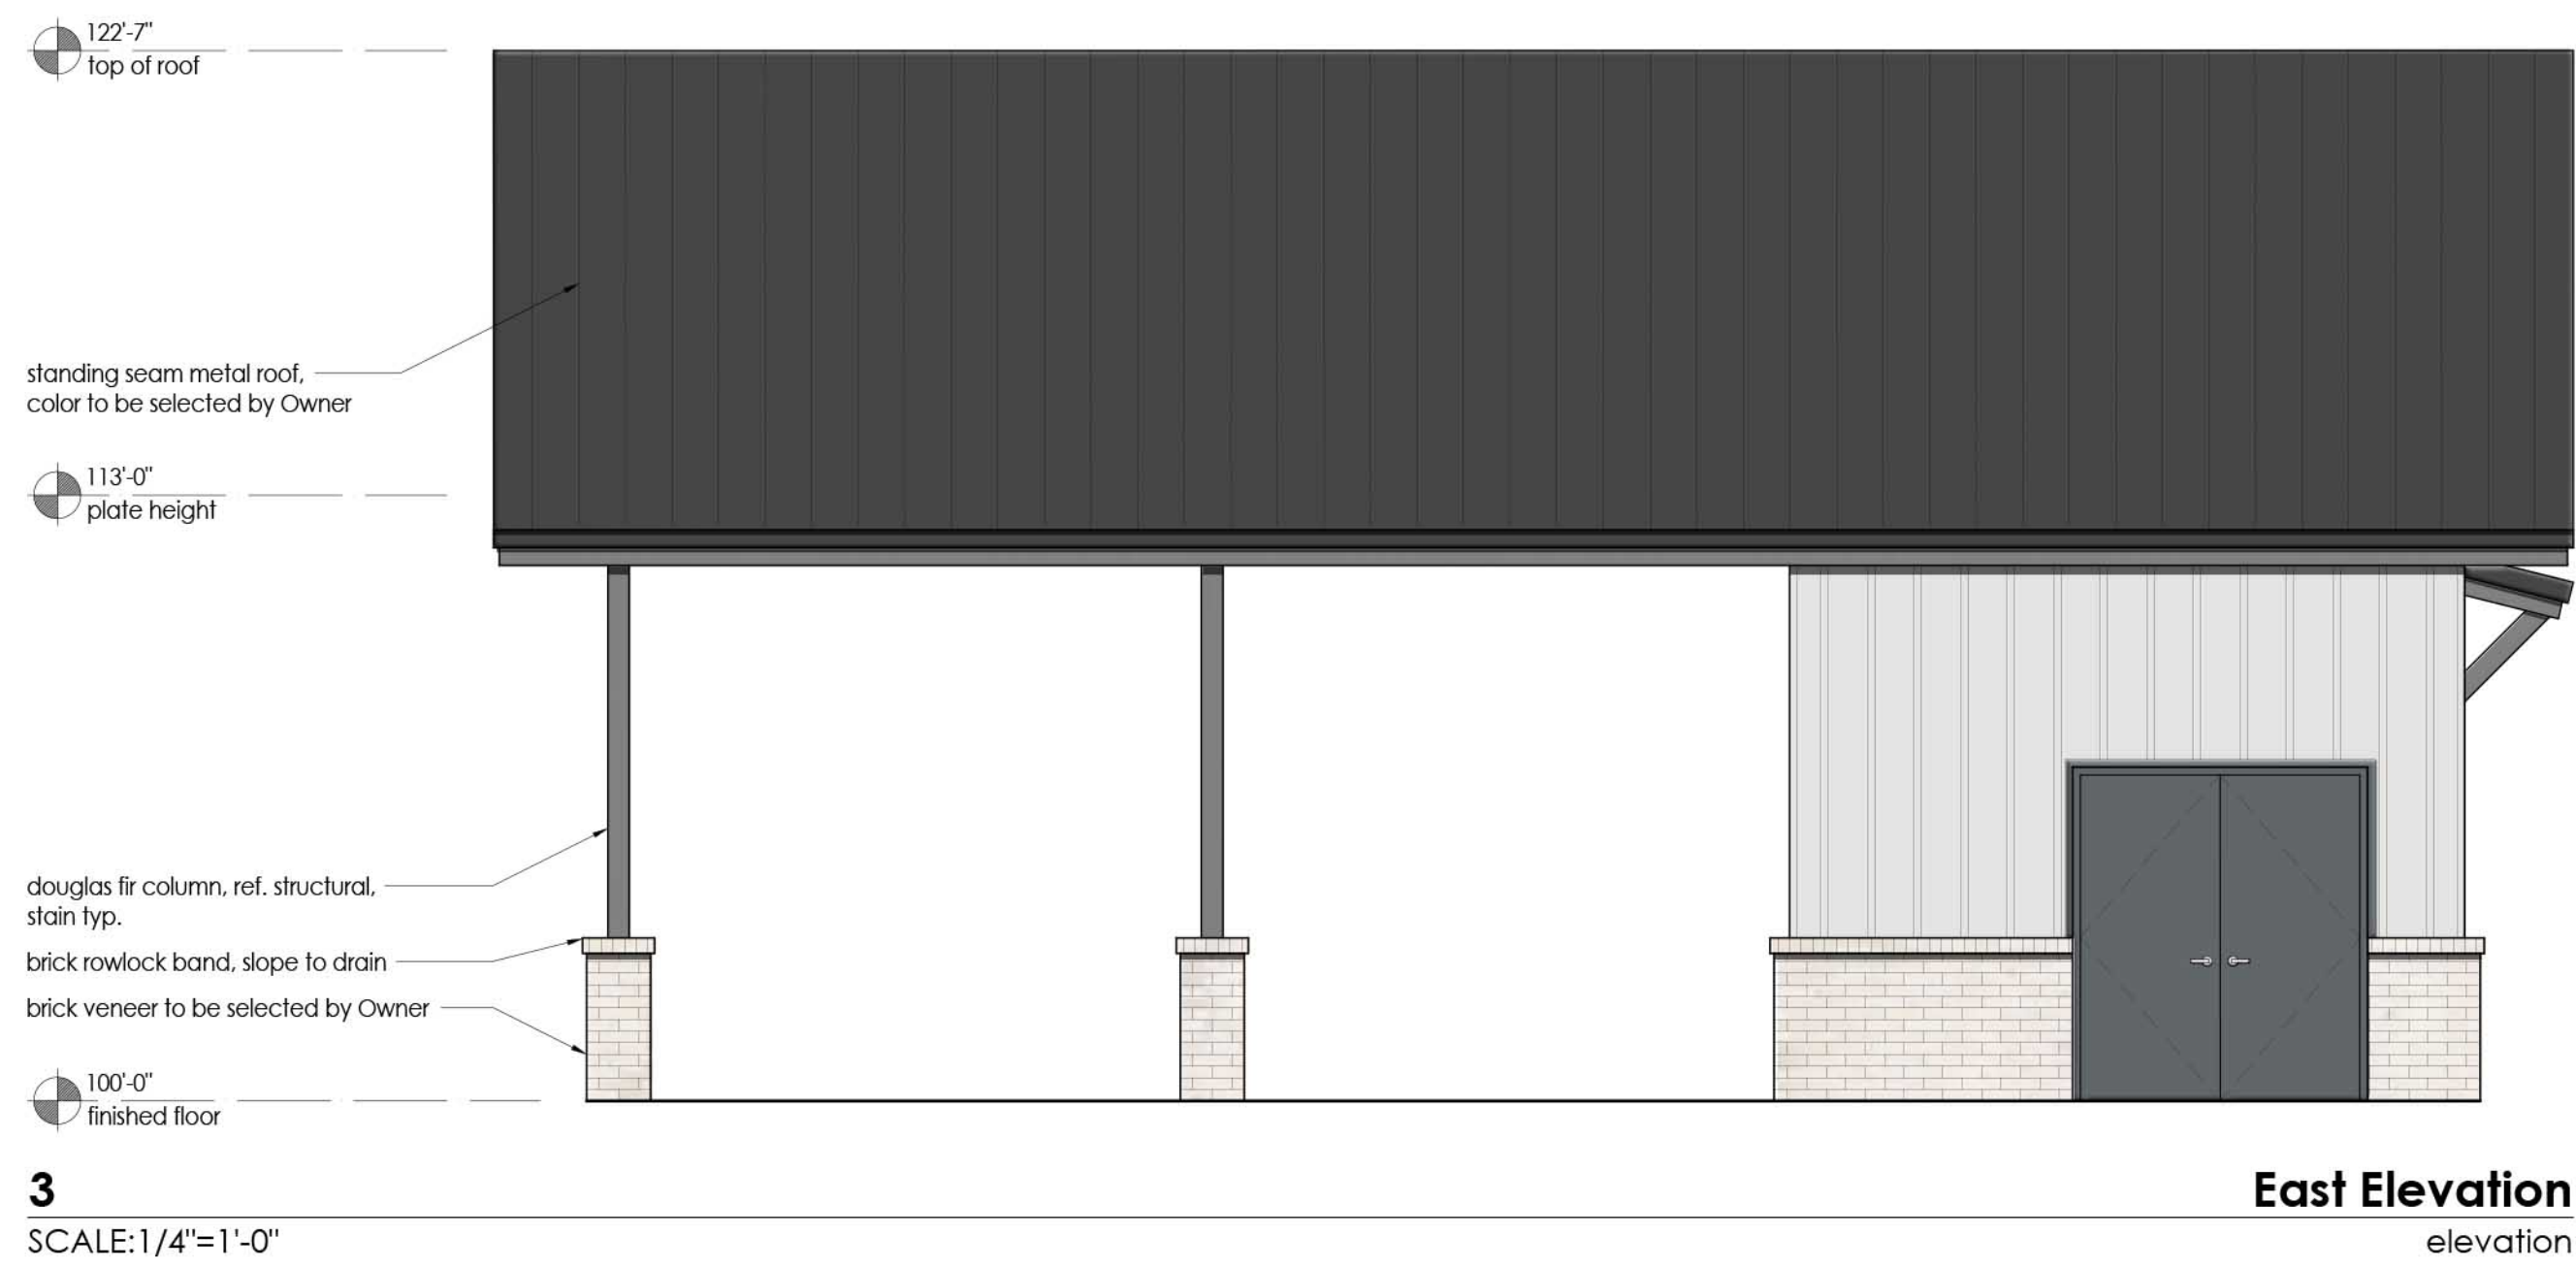

SEAL

Copyright © 2023
DATE: 10.24.2023
SCALE:
JOB NO. MA23027
DRAWN: JV
APPD: KM
ACAD #
EXTERIOR ELEVATIONS

DRAWING NO. REV. NO.

A4.00




SHERWIN WILLIAMS
WEB GRAY
SW 7075




ACME BRICK
ASHWOOD




SHERWIN WILLIAMS
KINGS CANYON (WOOD STAIN)
SW 3026

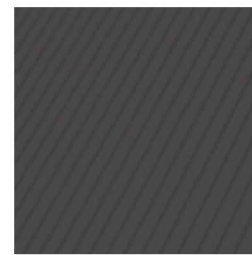

MUELLER, INC.
DARK CHARCOAL

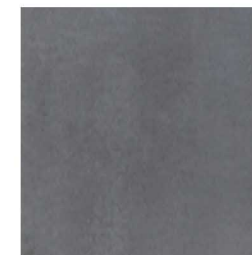

DALTILE
DARK GREY (TILE)
12 X 24

 

SHERWIN WILLIAMS
ICE CUBE
SW 6252



GLASS WINDOW
WITH
FROSTED GLAZING

OWNER/DEVELOPER:

SHADDOCK HOMES, INC
2400 DALLAS PARKWAY, SUITE 460
MCKINNEY, TEXAS 75093
CONTACT: LORA ERDMAN
PHONE: 972-526-7645
EMAIL: LORAERDMAN@SHADDOCKHOMES.COM

LANDSCAPE ARCHITECT:

JOHNSON VOLK CONSULTING
704 CENTRAL PARKWAY EAST, SUITE 1200
PLANO, TEXAS 75074
CONTACT: CODY JOHNSON, RLA, ASLA, LI
PHONE: 972-201-3100
EMAIL: CODYJOHNSON@JOHNSONVOLK.COM


SUBMITTAL DATE: November 13, 2023

SEAL

Copyright © 2023

DATE: _____
SCALE: _____
JOB NO. _____
DRAWN: _____
APPD: _____
ACAD # _____

DRAWING NO. _____ REV. NO. _____

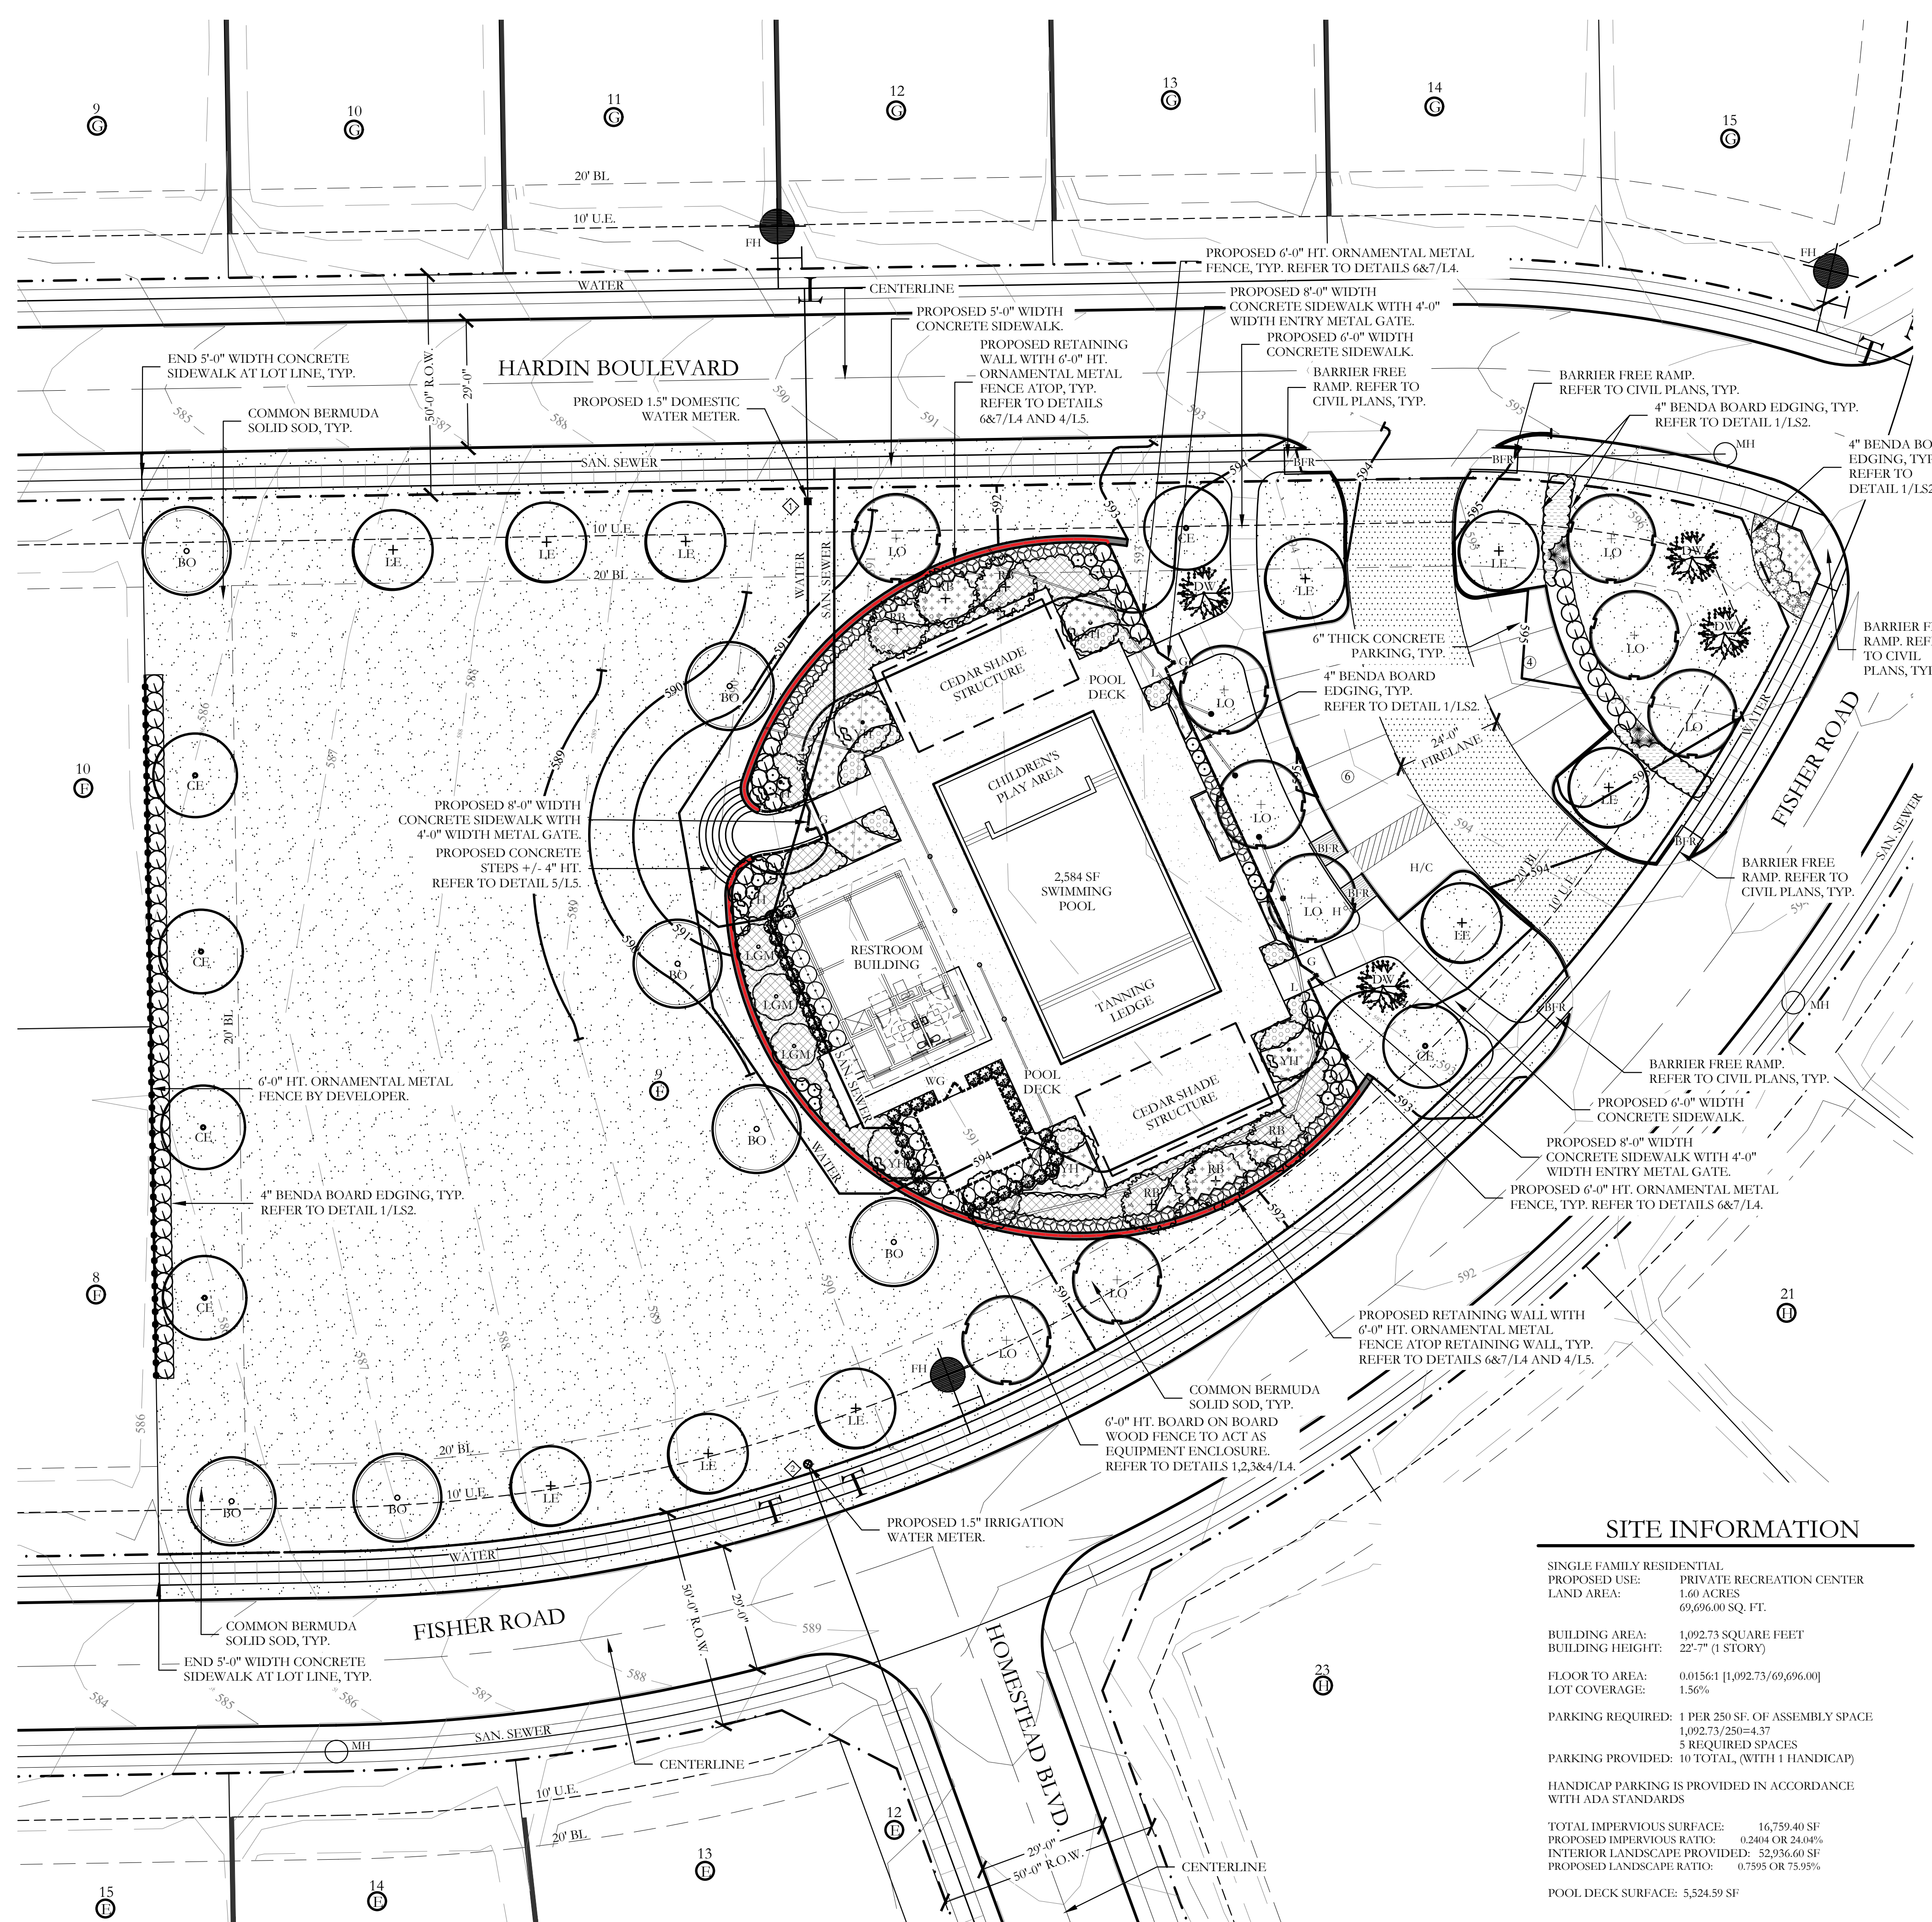

PLANT LEGEND					
SYMBOL	KEY	COMMON NAME	SCIENTIFIC NAME	SIZE	SPACING
	LO	LIVE OAK	QUERCUS VIRGINIANA	4" CALIPER	AS SHOWN
	BO	BUR OAK	QUERCUS MACROCARPA	4" CALIPER	AS SHOWN
	LE	LACEBARK ELM	ULMUS PARVIFOLIA	4" CALIPER	AS SHOWN
	CE	CEDAR ELM	ULMUS CRASSIFOLIA	4" CALIPER	AS SHOWN
	LGM	LITTLE GEM MAGNOLIA	MAGNOLIA GRANDIFLORA 'LITTLE GEM'	2" CALIPER	AS SHOWN
	DW	DESERT WILLOW	CHLOPSIS LINEARIS	2" CALIPER	AS SHOWN
	YH	YAUPON HOLLY	ILEX VOMITORIA	2" CALIPER	AS SHOWN
	RB	TEXAS REDBUD	CERCIS CANADENSIS VAR. TEXENSIS	2" CALIPER	AS SHOWN
		PURPLE DIAMOND LOROPETALUM	LOROPETALUM CHINENSIS 'PURPLE DIAMOND'	7 GALLON	48" O.C.
		TEXAS SAGE	LEUCOPHYLLUM FRUTESCENS	7 GALLON	48" O.C.
		GLOSSY ABELIA	LINNAEA X GRANDIFLORA	7 GALLON	36" O.C.
		DWARF BURFORD HOLLY	ILEX CORNUTA 'DWARF BURFORD'	7 GALLON	36" O.C.
		UPRIGHT ROSEMARY	ROSMARINUS OFFICINALIS 'UPRIGHT'	3 GALLON	36" O.C.
		DWARF MAIDEN GRASS	MISCANTHUS SINENSIS ADAGIO'	3 GALLON	36" O.C.
		MORNING LIGHT MISCANTHUS	MISCANTHUS SINENSIS 'MORNING LIGHT'	3 GALLON	36" O.C.
		RED YUCCA	HESPERALOE PARVIFLORA	3 GALLON	36" O.C.
		PLUM YEW PROSTRATA	CEPHALOTAXUS HARRINGTONIA 'PROSTRATA'	3 GALLON	48" O.C.
		LIRIOPE GRASS	LIRIOPE MUSCARI	1 GALLON	18" O.C.
		MEXICAN FEATHER GRASS	NASSELLA TENUISSIMA	1 GALLON	18" O.C.
		ANNUAL COLOR	TO BE SELECTED BY OWNER	4" POT	8" O.C.
		COMMON BERMUDA GRASS	CYNODON DACTYLON	SQUARE FEET	SOLID SOD

NOTE: IRRIGATION WILL MEET REQUIREMENTS OF UDC.

ALL RESPONSIBILITY FOR ADEQUACY OF DESIGN REMAINS WITH THE DESIGN ENGINEER. THE CITY OF ROCKWALL, IN REVIEWING AND RELEASING PLANS FOR CONSTRUCTION, ASSUMES NO RESPONSIBILITY FOR ADEQUACY OR ACCURACY OF DESIGN.




SITE INFORMATION


SINGLE FAMILY RESIDENTIAL
 PROPOSED USE: PRIVATE RECREATION CENTER
 LAND AREA: 1.60 ACRES
 69,696.00 SQ. FT.
 BUILDING AREA: 1,092.73 SQUARE FEET
 BUILDING HEIGHT: 22'-7" (1 STORY)
 FLOOR TO AREA: 0.0156:1 (1,092.73/69,696.00)
 LOT COVERAGE: 1.56%
 PARKING REQUIRED: 1 PER 250 SF. OF ASSEMBLY SPACE
 1,092.73/250=4.37
 5 REQUIRED SPACES
 PARKING PROVIDED: 10 TOTAL, (WITH 1 HANDICAP)
 HANDICAP PARKING IS PROVIDED IN ACCORDANCE WITH ADA STANDARDS
 TOTAL IMPERVIOUS SURFACE: 16,759.40 SF
 PROPOSED IMPERVIOUS RATIO: 0.2404 OR 24.04%
 INTERIOR LANDSCAPE PROVIDED: 52,936.60 SF
 PROPOSED LANDSCAPE RATIO: 0.7595 OR 75.95%
 POOL DECK SURFACE: 5,524.59 SF

APPROVED:
 I hereby certify that the above and foregoing site plan for a development in the City of Rockwall, Texas, was approved by the Planning & Zoning Commission of the City of Rockwall on the [DAY] day of [MONTH], [YEAR].


WITNESS OUR HANDS, this [DAY] day of [MONTH], [YEAR].

 Planning & Zoning Commission, Chairman Director of Planning and Zoning

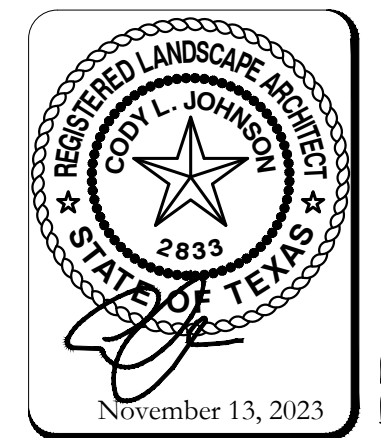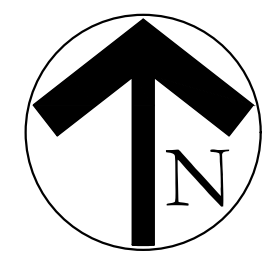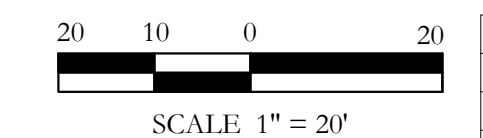


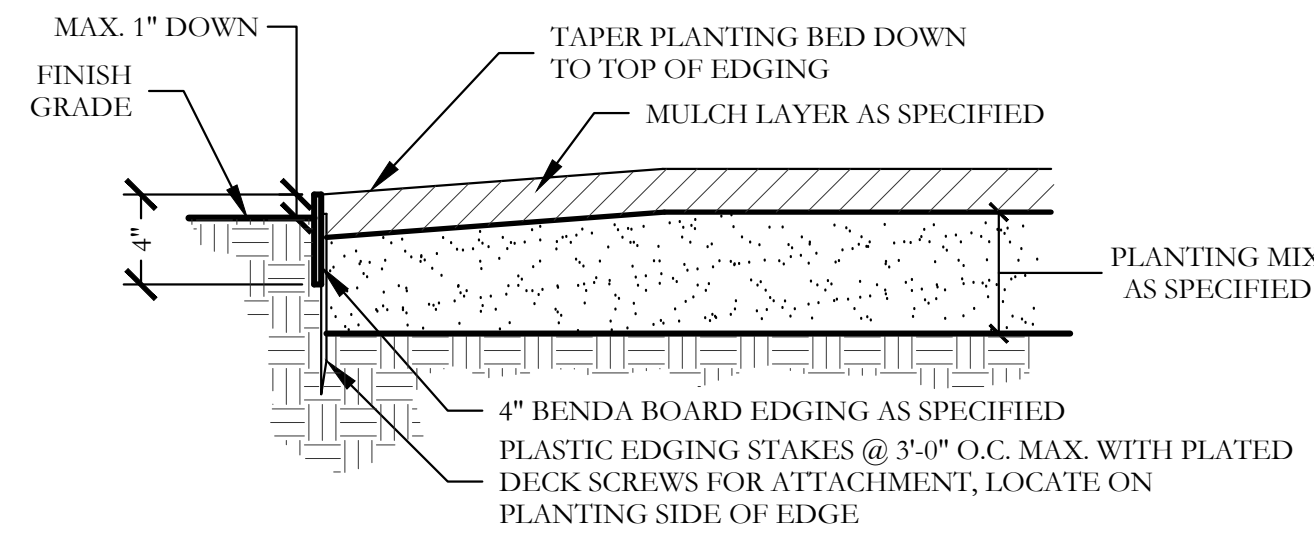

1 TYPICAL BED EDGING DETAIL SECTION NOT TO SCALE

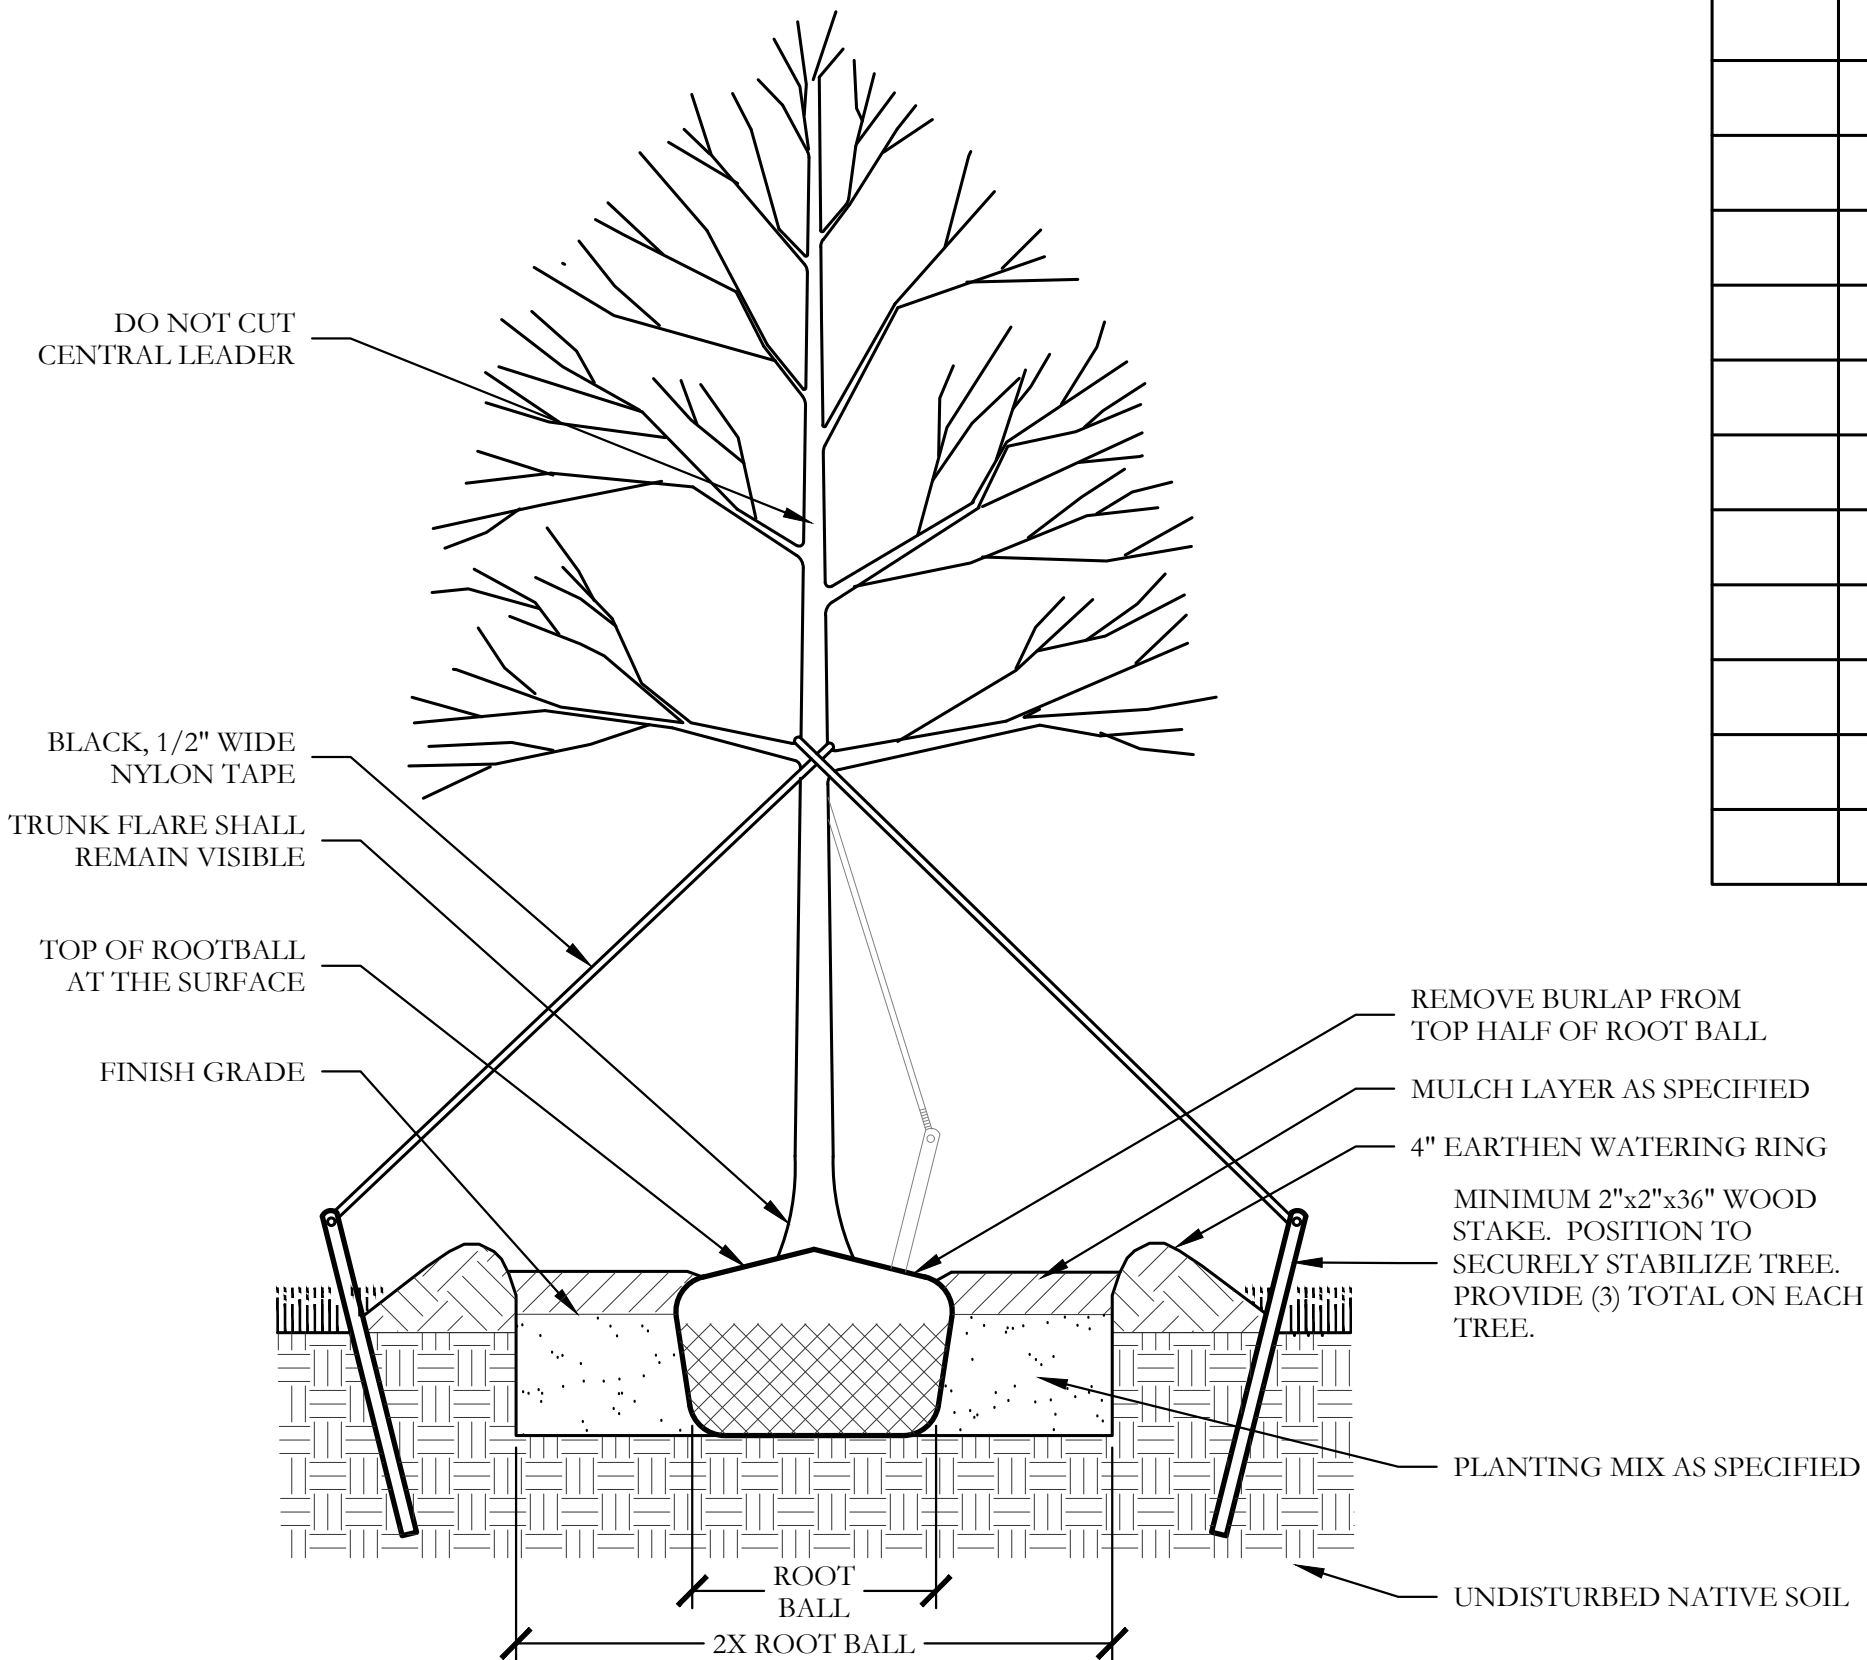

2 TYPICAL TREE PLANTING SECTION NOT TO SCALE

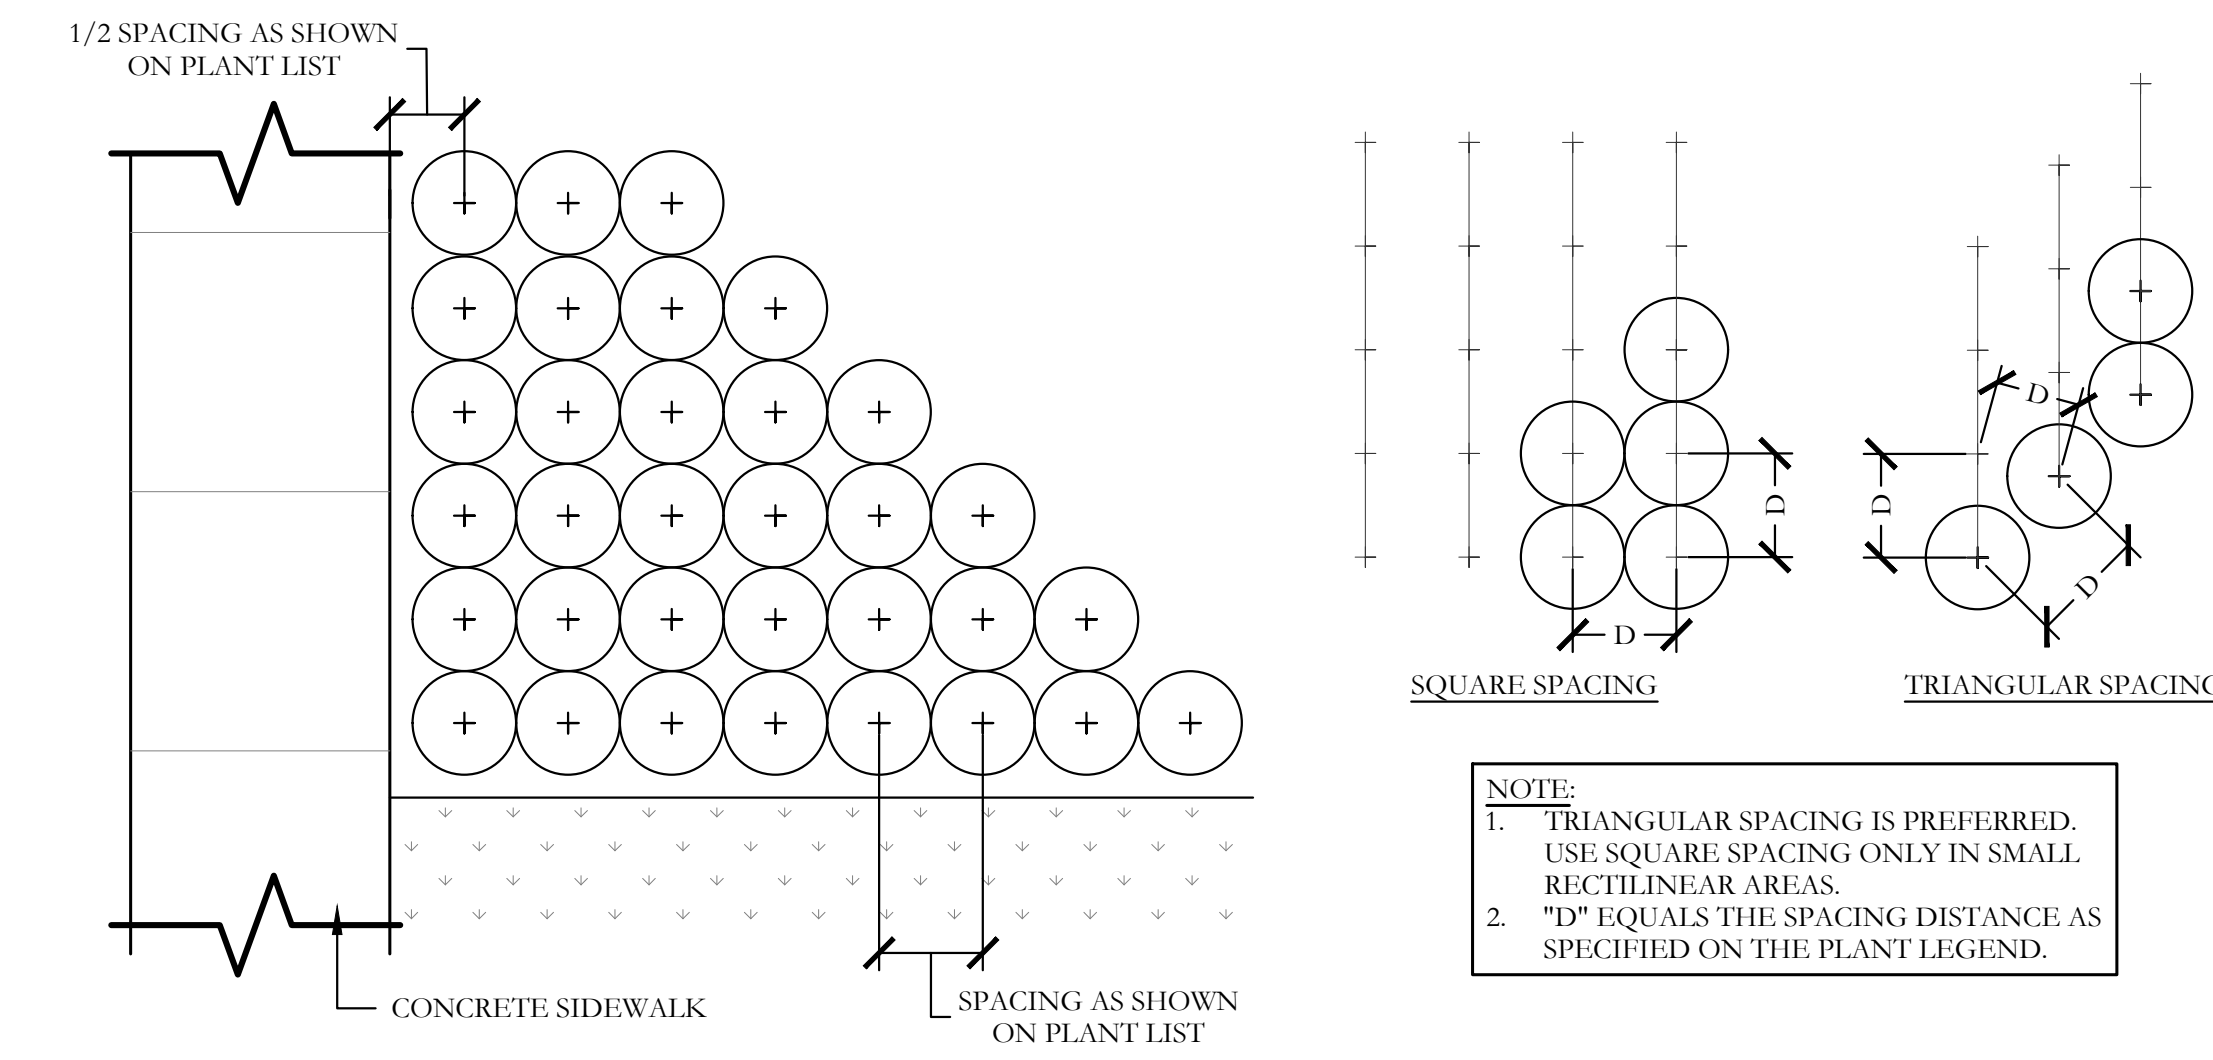

3 TYPICAL SHRUB AND GROUND COVER PLANTING PLAN/SECTION NOT TO SCALE

PLANT LIST						
KEY	ESTIMATED QUANTITY	COMMON NAME	SCIENTIFIC NAME	SIZE	SPACING	REMARKS
LO	9	LIVE OAK	QUERCUS VIRGINIANA	4" CALIPER	AS SHOWN	NURSERY GROWN; FULL HEAD; MINIMUM BRANCHING HEIGHT AT 6'-0"; MINIMUM 10'-0" OVERALL HEIGHT.
BO	7	BUR OAK	QUERCUS MACROCARPA	4" CALIPER	AS SHOWN	NURSERY GROWN; FULL HEAD; MINIMUM BRANCHING HEIGHT AT 6'-0"; MINIMUM 10'-0" OVERALL HEIGHT.
LE	10	LACEBARK ELM	ULMUS PARVIFOLIA	4" CALIPER	AS SHOWN	NURSERY GROWN; FULL HEAD; MINIMUM BRANCHING HEIGHT AT 6'-0"; MINIMUM 10'-0" OVERALL HEIGHT.
CE	6	CEDAR ELM	ULMUS CRASSIFOLIA	4" CALIPER	AS SHOWN	NURSERY GROWN; FULL HEAD; MINIMUM BRANCHING HEIGHT AT 6'-0"; MINIMUM 10'-0" OVERALL HEIGHT.
LGM	3	LITTLE GEM MAGNOLIA	MAGNOLIA GRANDIFLORA 'LITTLE GEM'	2" CALIPER	AS SHOWN	NURSERY GROWN; FULL HEAD; MINIMUM 8'-0" OVERALL HEIGHT.
DW	4	DESERT WILLOW	CHILOPSIS LINEARIS	2" CALIPER	AS SHOWN	NURSERY GROWN; FULL HEAD; MINIMUM 8'-0" OVERALL HEIGHT.
YH	8	YAUPON HOLLY	ILEX VOMITORIA	2" CALIPER	AS SHOWN	NURSERY GROWN; FULL HEAD; MINIMUM 8'-0" OVERALL HEIGHT.
RB	6	TEXAS REDBUD	CERCIS CANADENSIS VAR. TEXENSIS	2" CALIPER	AS SHOWN	NURSERY GROWN; FULL HEAD; MINIMUM 8'-0" OVERALL HEIGHT.
	21	PURPLE DIAMOND LOROPETALUM	LOROPETALUM CHINENSIS 'PURPLE DIAMOND'	7 GALLON	48" O.C.	CONTAINER GROWN; FULL PLANT.
	74	TEXAS SAGE	LEUCOPHYLLUM FRUTESCENS	7 GALLON	48" O.C.	CONTAINER GROWN; FULL PLANT.
	67	GLOSSY ABELIA	LINNAEA X GRANDIFLORA	7 GALLON	36" O.C.	CONTAINER GROWN; FULL PLANT.
	42	DWARF BURFORD HOLLY	ILEX CORNUTA 'DWARF BURFORD'	7 GALLON	36" O.C.	CONTAINER GROWN; FULL PLANT.
	6	UPRIGHT ROSEMARY	ROSMARINUS OFFICINALIS 'UPRIGHT'	3 GALLON	36" O.C.	CONTAINER GROWN; FULL PLANT.
	6	DWARF MAIDEN GRASS	MISCANTHUS SINENSIS ADAGIO'	3 GALLON	36" O.C.	CONTAINER GROWN; FULL PLANT.
	10	MORNING LIGHT MISCANTHUS	MISCANTHUS SINENSIS 'MORNING LIGHT'	3 GALLON	36" O.C.	CONTAINER GROWN; FULL PLANT.
	21	RED YUCCA	HESPERALOE PARVIFLORA	3 GALLON	36" O.C.	CONTAINER GROWN; FULL PLANT.
	70	PLUM YEW PROSTRATA	CEPHALOTAXUS HARRINGTONIA 'PROSTRATA'	3 GALLON	48" O.C.	CONTAINER GROWN; FULL PLANT.
	825	LIRIOPE GRASS	LIRIOPE MUSCARI	1 GALLON	18" O.C.	CONTAINER GROWN; FULL PLANT.
	85	MEXICAN FEATHER GRASS	NASSELLA TENUISSIMA	1 GALLON	18" O.C.	CONTAINER GROWN; FULL PLANT.
	825	ANNUAL COLOR	TO BE SELECTED BY OWNER	4" POT	8" O.C.	CONTAINER GROWN; FULL PLANT.
	50,135	COMMON BERMUDA GRASS	CYNODON DACTYLON	SQUARE FEET	SOLID SOD	MINIMUM 100% COVERAGE ALL AREAS SHOWN

GENERAL LANDSCAPE NOTES

- INSPECTIONS:**
- NO EXCAVATION SHALL OCCUR IN CITY R.O.W. WITHOUT A R.O.W. PERMIT--CONTACT THE PUBLIC WORKS DEPARTMENT.
 - THE CONTRACTOR SHALL MARK ALL WATER LINES, SEWER LINES, AND TREE LOCATIONS PRIOR TO CALLING FOR ROW INSPECTION AND PERMIT.
 - THE LANDSCAPE INSTALLATION SHALL COMPLY WITH APPROVED LANDSCAPE DRAWINGS PRIOR TO FINAL ACCEPTANCE BY THE CITY AND ISSUANCE OF A CERTIFICATE OF OCCUPANCY.
 - WATER METERS, CLEANOUTS AND OTHER APPURTENANCES, SHALL BE ACCESSIBLE, ADJUSTED TO GRADE, CLEARLY MARKED WITH FLAGGING AND COMPLIANT WITH PUBLIC WORKS DEPARTMENT STANDARDS PRIOR TO CALLING FOR FINAL LANDSCAPE AND ROW INSPECTIONS.

- LANDSCAPE STANDARDS:**
- PLANTINGS AND LANDSCAPE ELEMENTS SHALL COMPLY WITH THE CITY'S ENGINEERING DESIGN STANDARDS, PUBLIC R.O.W. VISIBILITY REQUIREMENTS.
 - UNLESS OTHERWISE SPECIFIED, TREES SHALL BE PLANTED NO LESS THAN 4' FROM CURBS, SIDEWALKS, UTILITY LINES, SCREENING WALLS AND OTHER STRUCTURES. THE CITY HAS FINAL APPROVAL FOR ALL TREE PLACEMENTS.
 - A MINIMUM THREE FEET (3') RADIUS AROUND A FIRE HYDRANT MUST REMAIN CLEAR OF LANDSCAPE PURSUANT TO THE FIRE CODE.
 - STREET TREES, WHERE REQUIRED, SHALL BE (10') MINIMUM FROM THE EDGE OF A STORM SEWER CURB INLET BOX AND THE EDGE OF THE ROOT BALL SHALL BE (4') MINIMUM FROM THE WATER METER.
 - THE AMERICAN STANDARD FOR NURSERY STOCK (ANSI Z60.1-2004) SPECIFICATIONS SHALL GOVERN PLANT QUALIFICATIONS, GRADES, AND STANDARDS.
 - TREE PLANTING SHALL COMPLY WITH DETAILS HEREIN AND THE INTERNATIONAL SOCIETY OF ARBORICULTURE (ISA) STANDARDS.
 - A 2-3" LAYER OF MULCH SHALL BE PROVIDED AROUND THE BASE OF THE PLANTED TREE. THE MULCH SHALL BE PULLED BACK 4" FROM THE TRUNK OF THE TREE.
 - TREE PITS SHALL BE TESTED FOR WATER PERCOLATION. IF WATER DOES NOT DRAIN OUT OF TREE PIT WITHIN 24-HOURS, THE TREE SHALL BE MOVED OR DRAINAGE SHALL BE PROVIDED.
 - ALL BEDS TO HAVE 3" OF COMPOSTED SOIL, LIVING EARTH TECHNOLOGY, OR APPROVED EQUAL TILLED AND TURNED TO A DEPTH OF 8" MINIMUM.
 - ALL PLANT BEDS SHALL BE TOP-DRESSED WITH A MINIMUM OF 3 INCHES OF HARDWOOD MULCH.
 - NATIVE SITE TOPSOILS TO BE PROTECTED FROM EROSION OR STOCKPILED. NATIVE SITE TOPSOIL SHALL BE LABORATORY TESTED BY AN ACCREDITED LABORATORY AND AMENDED PER SAID LABORATORY'S RECOMMENDATIONS.

- IRRIGATION STANDARDS:**
- ANY CHANGES TO THESE APPROVED IRRIGATION DRAWINGS SHALL BE AUTHORIZED BY THE CITY.
 - CONTACT DEVELOPMENT SERVICES FOR AN IRRIGATION PERMIT PRIOR TO INSTALLING THE IRRIGATION SYSTEM.
 - IRRIGATION OVER-SPRAY ON STREETS AND WALKS IS PROHIBITED.
 - MAINLINES, VALVES, OR CONTROL WIRES SHALL NOT BE LOCATED IN THE CITY'S ROW.
 - ET IRRIGATION CONTROLLERS SHALL BE PROGRAMMED AND ADJUSTED TO NOT EXCEED THE LANDSCAPE WATER ALLOWANCE (LWA) PRIOR TO APPROVAL OF LANDSCAPE INSTALLATION.
 - VALVES SHALL BE LOCATED A MINIMUM OF (5') AWAY FROM STORM SEWERS, AND SANITARY SEWER LINES AND 5 FEET FROM CITY FIRE HYDRANTS AND WATER VALVES.
 - THE BORE DEPTH UNDER STREETS, DRIVE AISLES, AND FIRE LANES SHALL PROVIDE (2') OF CLEARANCE (MINIMUM).
 - IRRIGATION HEADS THAT RUN PARALLEL AND NEAR PUBLIC WATER AND SANITARY SEWER LINES; SHALL BE FED FROM STUBBED LATERALS OR BULL-BEADS. A MINIMUM FIVE FOOT (5') SEPARATION IS REQUIRED BETWEEN IRRIGATION MAIN LINES AND LATERALS THAT RUN PARALLEL TO PUBLIC WATER AND SANITARY SEWER LINES.
 - NO VALVES, BACKFLOW PREVENTION ASSEMBLIES, QUICK COUPLERS ETC. SHALL BE LOCATED CLOSER THAN 10' FROM THE CURB AT STREET OR DRIVE INTERSECTION.

- MAINTENANCE STANDARDS:**
- THE OWNER SHALL BE RESPONSIBLE FOR THE ESTABLISHMENT, MAINTENANCE, AND VIGOR OF PLANT MATERIAL IN ACCORDANCE WITH THE DESIGN INTENT AND AS APPROPRIATE FOR THE SEASON OF THE YEAR.
 - LANDSCAPE AND OPEN AREAS SHALL BE FREE OF TRASH, LITTER AND WEEDS.
 - NO PLANT MATERIAL SHALL BE ALLOWED TO ENCRUCH ON R.O.W., SIDEWALKS OR EASEMENTS TO THE EXTENT THAT VISION OR ROUTE OF TRAVEL FOR VEHICULAR, PEDESTRIAN, OR BICYCLE TRAFFIC IS IMPEDED.
 - TREE MAINTENANCE SHALL BE IN ACCORDANCE WITH THE STANDARDS OF THE INTERNATIONAL SOCIETY OF ARBORICULTURE.
 - TREE STAKING MATERIALS, IF USED, SHALL BE REMOVED AFTER (1) GROWING SEASON, NO MORE THAN (1) YEAR AFTER INSTALLATION (STEEL TREE STAKES, WIRES, AND HOSES ARE PROHIBITED).

- TREE PROTECTION NOTES:**
- CONTACT DEVELOPMENT SERVICES FOR A TREE REMOVAL PERMIT PRIOR TO REMOVAL OR TRANSPLANTING OF ANY TREES.
 - ALL TREES WHICH ARE TO REMAIN ON SITE SHALL BE PROTECTED WITH A (4') TALL BRIGHTLY COLORED PLASTIC FENCE, OR SILT FENCE, PLACED AT THE DRIP LINE OF THE TREES.
 - PRIOR TO THE PRE-CONSTRUCTION MEETING OR OBTAINING A GRADING PERMIT, ALL TREE MARKINGS AND PROTECTIVE FENCING SHALL BE INSTALLED BY THE OWNER AND BE INSPECTED BY DEVELOPMENT SERVICES.
 - NO EQUIPMENT SHALL BE CLEANED, OR HARMFUL LIQUIDS DEPOSITED WITHIN THE LIMITS OF THE ROOT ZONE OF TREES WHICH REMAIN ON SITE.
 - NO SIGNS, WIRES, OR OTHER ATTACHMENTS SHALL BE ATTACHED TO ANY TREE TO REMAIN ON SITE.
 - VEHICULAR AND CONSTRUCTION EQUIPMENT SHALL NOT PARK OR DRIVE WITHIN THE LIMITS OF THE DRIP LINE.
 - GRADE CHANGES IN EXCESS OF 3 INCHES (CUT OR FILL) SHALL NOT BE ALLOWED WITHIN A ROOT ZONE, UNLESS ADEQUATE TREE PRESERVATION METHODS ARE APPROVED BY THE CITY.
 - NO TRENCHING SHALL BE ALLOWED WITHIN THE DRIP-LINE OF A TREE, UNLESS APPROVED BY THE CITY.
 - ALL REMOVED TREES SHALL BE CHIPPED AND USED FOR MULCH ON SITE OR HAULED OFF-SITE.
 - ALL TREE MAINTENANCE TECHNIQUES SHALL BE IN CONFORMANCE WITH INDUSTRY IDENTIFIED STANDARDS. IMPROPER OR MALICIOUS PRUNING TECHNIQUES ARE STRICTLY PROHIBITED.

ALL RESPONSIBILITY FOR ADEQUACY OF DESIGN REMAINS WITH THE DESIGN ENGINEER. THE CITY OF ROCKWALL, IN REVIEWING AND RELEASING PLANS FOR CONSTRUCTION, ASSUMES NO RESPONSIBILITY FOR ADEQUACY OR ACCURACY OF DESIGN.

APPROVED:
I hereby certify that the above and foregoing site plan for a development in the City of Rockwall, Texas, was approved by the Planning & Zoning Commission of the City of Rockwall on the [DAY] day of [MONTH], [YEAR].

WITNESS OUR HANDS, this [DAY] day of [MONTH], [YEAR].

Planning & Zoning Commission, Chairman

Director of Planning and Zoning



JOHNSON VOLK CONSULTING

704 Central Parkway East | Suite 1200 | Plano, Texas 75074 | 972.201.3100

Planning and Zoning Department
City of Rockwall – Planning and Zoning Department
385 S. Goliad Street
Rockwall, Texas 75087

November 13, 2023

Tree Survey Affidavit

Nelson Lake Estates, Phase 1, Amenity Center
City of Rockwall, Rockwall County, Texas

To Whom it May Concern,

After an extensive field investigation and tree inventory, we have determined that no protected trees exist on site for this development. Because of this, we have not prepared tree survey plans, checklists, and applicable plans for tree survey, mitigation, and/or tree preservation per the City of Rockwall Ordinance.

If you have any questions or concerns, please let me know.

Sincerely,

Cody Johnson, RLA, ASLA, LI
Johnson Volk Consulting
407 Central Parkway East
Suite 1200
Plano, Texas 75074

PROJECT COMMENTS



CITY OF ROCKWALL
385 S. GOLIAD STREET
ROCKWALL, TEXAS 75087
PHONE: (972) 771-7700

DATE: 11/20/2023

PROJECT NUMBER: SP2023-046
PROJECT NAME: Site Plan for Phase 1, Homestead Subdivision
SITE ADDRESS/LOCATIONS: 3200 FISHER RD, ROCKWALL, 75032

CASE CAPTION: Discuss and consider a request by Cody Johnson of Johnson Volk Consulting on behalf of Stephen Pepper of SH Dev Klutts Rockwall, LLC for the approval of a Site Plan for Phase 1 of the Homestead Subdivision being a 196.009-acre tract of land identified as Tract 6 of the J. A. Ramsey Survey, Abstract No. 186, City of Rockwall, Rockwall County, Texas, zoned Planned Development District 92 (PD-92), generally located at the northeast corner of the intersection of FM-549 and FM-1139, and take any action necessary.

DEPARTMENT	REVIEWER	DATE OF REVIEW	STATUS OF PROJECT
PLANNING	Henry Lee	11/20/2023	Needs Review

11/20/2023: Please address the following comments (M= Mandatory Comments; I = Informational Comments)

I.1 This is a request by Cody Johnson of Johnson Volk Consulting on behalf of Stephen Pepper of SH Dev Klutts Rockwall, LLC for the approval of a Site Plan for Phase 1 of the Homestead Subdivision being a 196.009-acre tract of land identified as Tract 6 of the J. A. Ramsey Survey, Abstract No. 186, City of Rockwall, Rockwall County, Texas, zoned Planned Development District 92 (PD-92), generally located at the northeast corner of the intersection of FM-549 and FM-1139.

I.2 For questions or comments concerning this case please contact Henry Lee in the Planning Department at (972) 772-6434 or email hlee@rockwall.com.

M.3 For reference, include the case number (SP2023-046) in the lower right-hand corner of all pages of all revised plan submittals. (Subsection 01.02(D), Article 11, Unified Development Code [UDC])

M.4 Provide the standard signature block with signature space for the Planning and Zoning Chairman and the Planning Director on all pages of the plans. Also remove the red placeholder text from the signature block. (Subsection 03.04. A, of Article 11, UDC)

APPROVED:

I hereby certify that the above and foregoing site plan for a development in the City of Rockwall, Texas, was approved by the Planning & Zoning Commission of the City of Rockwall on the ____ day of _____, _____.

WITNESS OUR HANDS, this ____ day of _____, _____.

Planning & Zoning Commission, Chairman

Director of Planning and Zoning

M.5 Site Plan:

(1) Wood fencing is not permitted as for the pool utility screening. That being said, horizontal composite board fencing has been approved previously. (Planned Development District 92)

(2) Please provide fence exhibits for each fence type. (Planned Development District 92)

(3) Please provide exhibits of the shade structures. (Planned Development District 92)

M.6 Photometric Plan:

- (1) The foot-candles cannot exceed 0.2 FC at the property lines. (Subsection 03.03. G, of Article 07)
- (2) No light pole, base or combination thereof shall exceed 20 feet. (Planned Development District 92)
- (3) Up lighting is not permitted for any of the proposed light fixtures. (Subsection 03.03, of Article 07)
- (4) Please provide cut sheets for all proposed lighting fixtures. (Subsection 03.03, of Article 07)

M.7 Building Elevations:

- (1) Please remove the doors and windows from the material percentages. (Subsection 05.01, of Article 05, UDC)
- (2) Cementitious material shall not exceed 50% on each façade. (Planned Development District 92)
- (3) Exterior walls shall consist of 90% masonry materials excluding doors and windows. (Planned Development District 92)
- (4) Please continue the brick up the columns. (Planned Development District 92)
- (5) The minimum roof pitch is 8:12. (Planned Development District 92)
- (6) The building elevations indicate the final materials and colors will be selected by the owner. This statement must be removed and all final materials and colors must be selected before approval. (Planned Development District 92)

I.8 Please note that failure to address all comments provided by staff by 3:00 PM on December 5, 2023 will result in the automatic denial of the case on the grounds of an incomplete submittal. No refund will be given for cases that are denied due to an incomplete submittal, and a new application and fee will be required to resubmit the case.

I.9 Staff has identified the aforementioned items necessary to continue the submittal process. Please make these revisions and corrections, and provide any additional information that is requested. Revisions for this case will be due on December 5, 2023; however, it is encouraged for applicants to submit revisions as soon as possible to give staff ample time to review the case prior to the December 12, 2023 Planning & Zoning Meeting.

I.10 Please note the scheduled meetings for this case:

- 1) Planning & Zoning Work Session meeting will be held on November 28, 2023.
- 2) Planning & Zoning meeting/public hearing meeting will be held on December 12, 2023.

I.11 All meetings will be held in person and in the City's Council Chambers. All meetings listed above are scheduled to begin at 6:00 p.m. (P&Z). A representative(s) must be present for these meetings. During the upcoming work session meeting with the Planning and Zoning Commission, representative(s) are expected to present their case and answer any questions the Planning Commission may have regarding this request.

DEPARTMENT	REVIEWER	DATE OF REVIEW	STATUS OF PROJECT
ENGINEERING	Madelyn Price	11/14/2023	Approved w/ Comments

11/14/2023: 1. Shaddock Boulevard

2. Please show proposed water and sewer house connections on site plan for this building.
3. Retaining walls over 3' in height will need to be engineered and a retaining wall permit application shall be submitted to the engineering department for review.
4. Label as rock or stone retaining wall.
5. Make sure landscaping doesn't impede drainage and can't fill in swale.
6. Edging must be higher than mulch to contain.

General Comments:

General Items:

- Must meet City's 2023 Standards of Design and Construction
- 4% Engineering Inspection Fees
- Impact Fees (Water, Wastewater & Roadway)
- Minimum easement width is 20' for new easements. No structures including walls allowed in easements.
- Retaining walls 3' and over must be engineered.

- All retaining walls (18" or taller) must be rock, stone, or stone face. No smooth concrete walls.
- All utilities must be underground.
- Need to show proposed water and sewer on site plan.

Water and Wastewater Items:

- Only one "use" off a dead-end line (domestic, irrigation, fire sprinkler, fire hydrant, etc.)
- Water and sewer must be 10' apart.
- Sanitary sewer service must be connected to a manhole.

Roadway Paving Items:

- All Parking to be 20'x9' minimum.
- No dead-end parking allowed without an City approved turnaround.
- Drive isles to be 24' wide.
- Fire lane to have 20' min radius if buildings are less than 30' tall. If any of the buildings are 30' or more, the fire lane will be 30' radius minimum. - Fire lane to be in a platted easement.

Landscaping:

- No trees to be with 10' of any public water, sewer or storm line that is 10" in diameter or larger.
- No trees to be with 5' of any public water, sewer, or storm line that is less than 10".

DEPARTMENT	REVIEWER	DATE OF REVIEW	STATUS OF PROJECT
BUILDING	Henry Lee	11/20/2023	Approved w/ Comments

11/16/2023: SEPARATE PERMIT REQUIRED FOR AMENITY CENTER, RETAINING WALL, IRRIGATION AND POOL, POOL AND BARRIER REQUIREMENT TO MEET 2021 ISPSC AND TEXAS HEALTH AND SAFETY CODES

DEPARTMENT	REVIEWER	DATE OF REVIEW	STATUS OF PROJECT
FIRE	Ariana Kistner	11/17/2023	Approved

No Comments

DEPARTMENT	REVIEWER	DATE OF REVIEW	STATUS OF PROJECT
GIS	Lance Singleton	11/14/2023	Approved w/ Comments


11/14/2023: Amenity Center address will be 3200 FISHER RD, ROCKWALL, TX 75032
Also, Hardin Blvd. should be Shaddock Blvd on drawings.

DEPARTMENT	REVIEWER	DATE OF REVIEW	STATUS OF PROJECT
POLICE	Henry Lee	11/20/2023	N/A

No Comments

DEPARTMENT	REVIEWER	DATE OF REVIEW	STATUS OF PROJECT
PARKS	Travis Sales	11/14/2023	Approved w/ Comments

11/14/2023: 1. Very nice looking landscape
2. Suggestion of replacing the Common Bermuda Sod which one of the newer varieties such as Tif Tuf, Tahoma 31, Northbridge, Latitude 36 of which all are more cold, drought, wear tolerant.

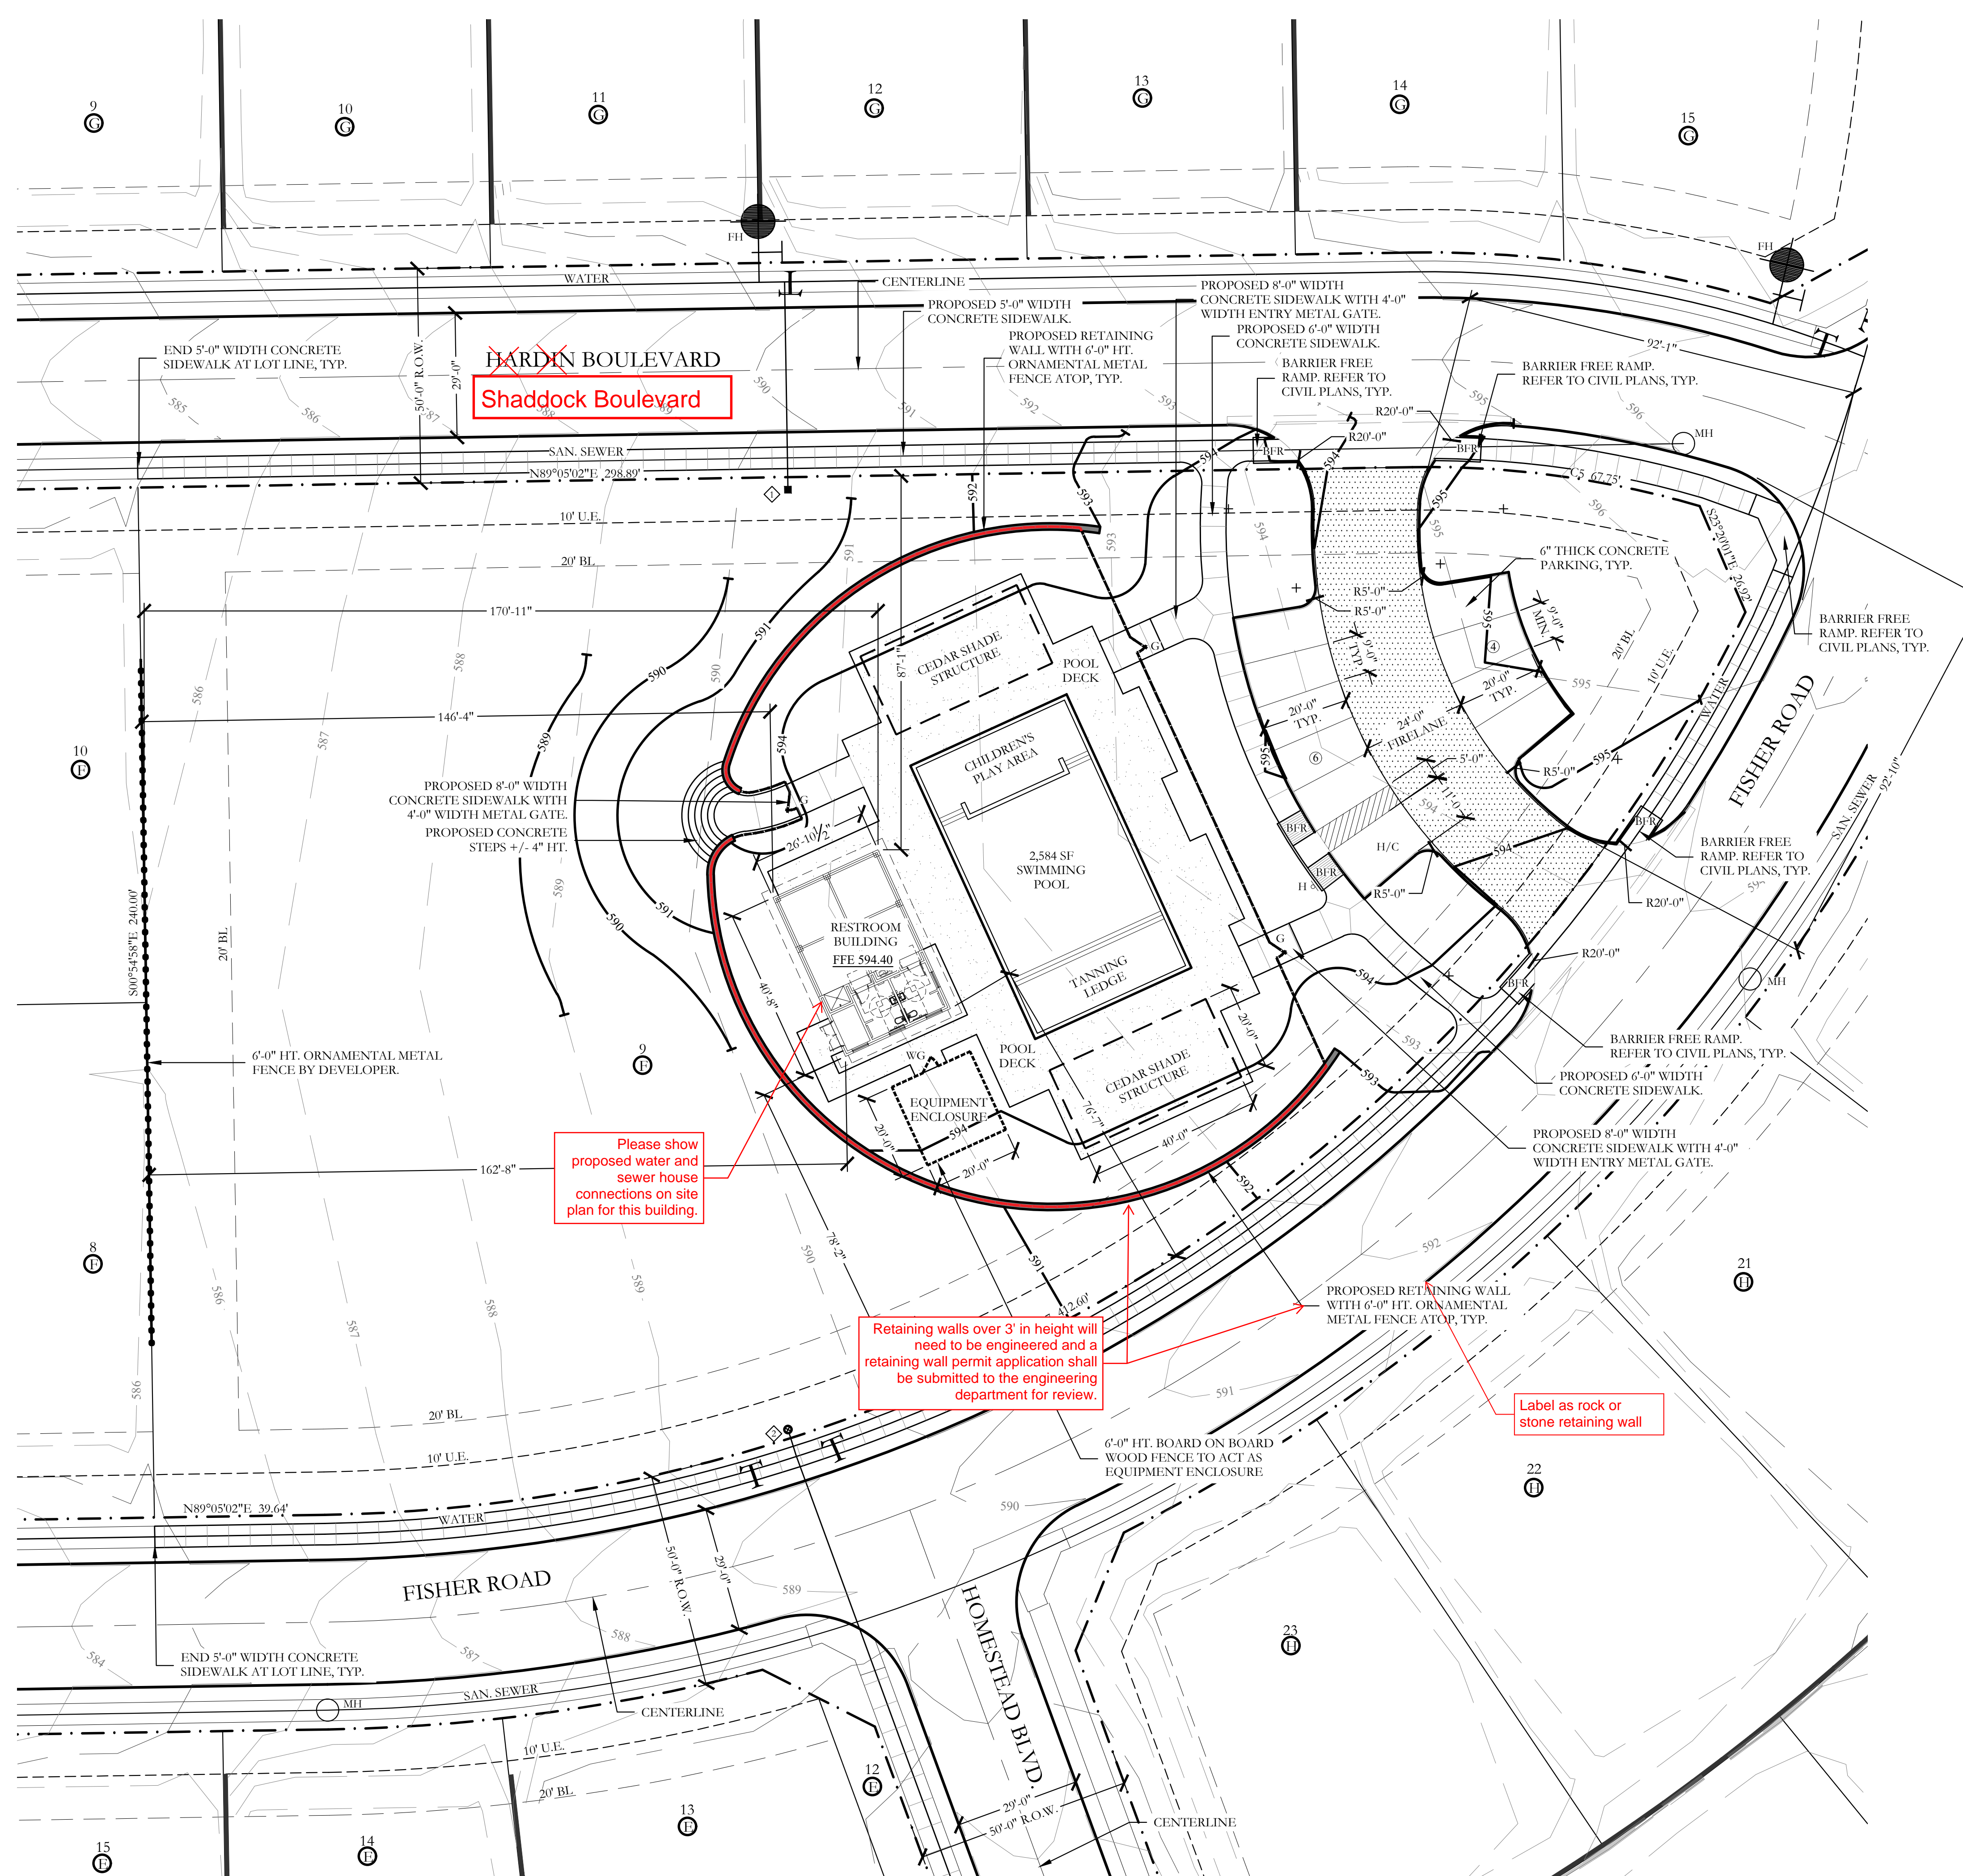

LEGEND

- ④ PROPOSED PARKING COUNT
- H/C PROPOSED HANDICAP PARKING SPACE
- BFR PROPOSED BARRIER FREE RAMP
- FH EXISTING FIRE HYDRANT
- MH EXISTING SANITARY SEWER MANHOLE
- EXISTING WATER MAIN W/ VALVE
- EXISTING SANITARY SEWER
- - - RIGHT-OF-WAY
- - - 593 EXISTING CONTOUR INTERVAL
- - - 592 PROPOSED CONTOUR INTERVAL
- FFE 594.40 FINISHED FLOOR ELEVATION
- ◊ PROPOSED 1.5" DOMESTIC WATER METER
- ◊ PROPOSED 1.5" IRRIGATION WATER METER
- H P HANDICAP PARKING SIGN
- PROPOSED RETAINING WALL
- ORNAMENTAL METAL FENCE (6'-0" HT. AROUND SWIMMING POOL AREA)
- ORNAMENTAL METAL FENCE ATOP RETAINING WALL (6'-0" HT. AROUND SWIMMING POOL AREA)
- ▲ 1 - 4'-0" WIDTH SELF LATCHING, SELF CLOSING METAL GATE
- ▲ 1 - 4'-0" WIDTH SELF LATCHING, SELF CLOSING WOODEN GATE
- 6'-0" HT. WOOD FENCE TO ACT AS POOL EQUIPMENT AND TRASH TOTE ENCLOSURE
- ORNAMENTAL METAL FENCE ALONG PROPERTY LINE
- ▨ FIRELANE PAVING PER CITY STANDARD DETAILS

WATER METER SCHEDULE

METER ID NUMBER	WATER SERVICE SIZE	WATER METER SIZE	METER DOM.	METER IRR.	SAN. SERVICE SIZE
◊	1.5"	1.5"	X		6"
◊	1.5"	1.5"		X	

SITE PLAN NOTES:

- NO 100 YEAR FLOOD PLAIN EXISTS ON PROPERTY.
- FOR ALL BARRIER FREE RAMPS NOTED ON PLAN, REFERENCE THE CITY OF ROCKWALL STANDARD CONSTRUCTION DETAILS.
- ALL HANDICAP PARKING SPACES SHALL BE A MINIMUM OF 11'-0" WIDTH x 20'-0" LENGTH WITH A 5'-0" LOADING AISLE.
- STANDARD PARKING SPACES SHALL BE A MINIMUM OF 9'-0" WIDTH x 20'-0" LENGTH.
- THE PERIMETER FENCING SHALL BE 6'-0" HT. ORNAMENTAL METAL FENCE.
- ALL VEHICULAR AND SIDEWALK PAVING SHOWN ON THESE PLANS SHALL BE MAINTAINED BY THE HOA.

- General Items:**
- Must meet City's 2023 Standards of Design and Construction
 - 4% Engineering Inspection Fees
 - Impact Fees (Water, Wastewater & Roadway)
 - Minimum easement width is 20' for new easements. No structures including walls allowed in easements.
 - Retaining walls 3' and over must be engineered.
 - All retaining walls (18" or taller) must be rock, stone, or stone face. No smooth concrete walls.
 - All utilities must be underground.
 - Need to show proposed water and sewer on site plan.

- Water and Wastewater Items:**
- Only one "use" off a dead-end line (domestic, irrigation, fire sprinkler, fire hydrant, etc.)
 - Water and sewer must be 10' apart.
 - Sanitary sewer service must be connected to a manhole.


- Roadway Paving Items:**
- All Parking to be 20'x9' minimum.
 - No dead-end parking allowed without an City approved turnaround.
 - Drive isles to be 24' wide.
 - Fire lane to have 20' min radius if buildings are less than 30' tall. If any of the buildings are 30' or more, the fire lane will be 30' radius minimum.
 - Fire lane to be in a platted easement.

- Landscaping:**
- No trees to be with 10' of any public water, sewer or storm line that is 10" in diameter or larger.
 - No trees to be with 5' of any public water, sewer, or storm line that is less than 10".



Please show proposed water and sewer house connections on site plan for this building.

Retaining walls over 3' in height will need to be engineered and a retaining wall permit application shall be submitted to the engineering department for review.

Label as rock or stone retaining wall

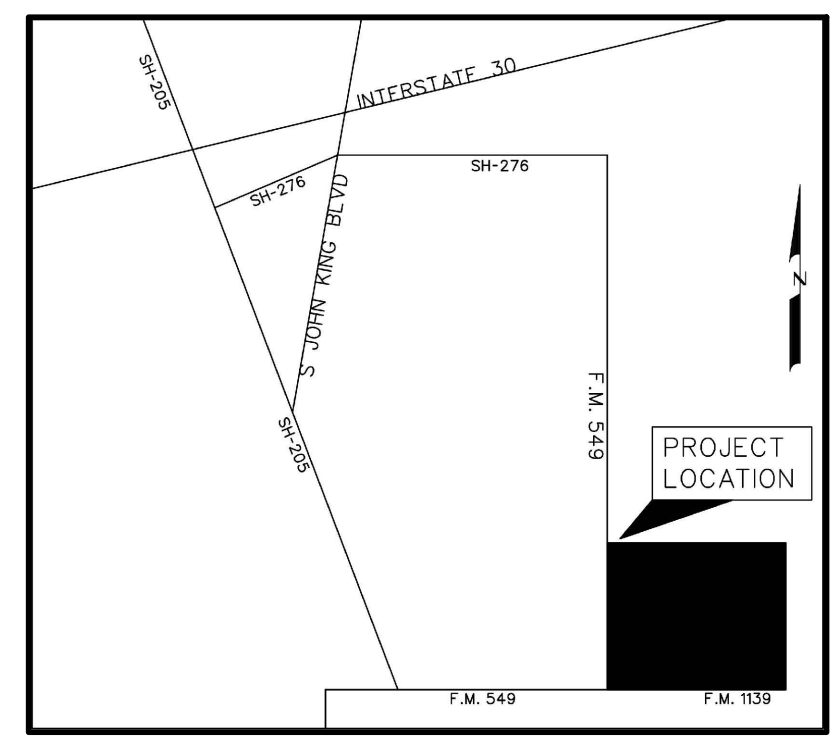

LOCATION MAP
NOT TO SCALE

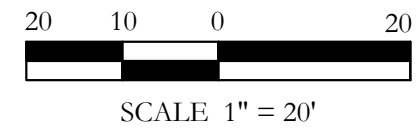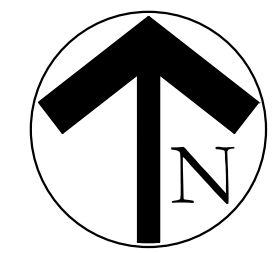

**SITE PLAN
HOMESTEAD, PHASE 1
LOT 9, BLOCK F
~AMENITY CENTER~**


BEING 1.600 ACRES OUT OF THE
J.A. RAMSEY SURVEY
ABSTRACT NO. 186 IN THE
CITY OF ROCKWALL, ROCKWALL COUNTY, TEXAS

OWNER / DEVELOPER:
SHADDOCK HOMES, INC
2400 DALLAS PARKWAY, SUITE 460
MCKINNEY, TEXAS 75093
CONTACT: LORA ERDMAN


LANDSCAPE ARCHITECT/CIVIL ENGINEER:
JOHNSON VOLK CONSULTING
704 CENTRAL PARKWAY EAST, SUITE 1200
PLANO, TEXAS 75074
PH. 972-201-3100
CONTACT: CODY JOHNSON, RLA, ASLA, LI




November 13, 2023

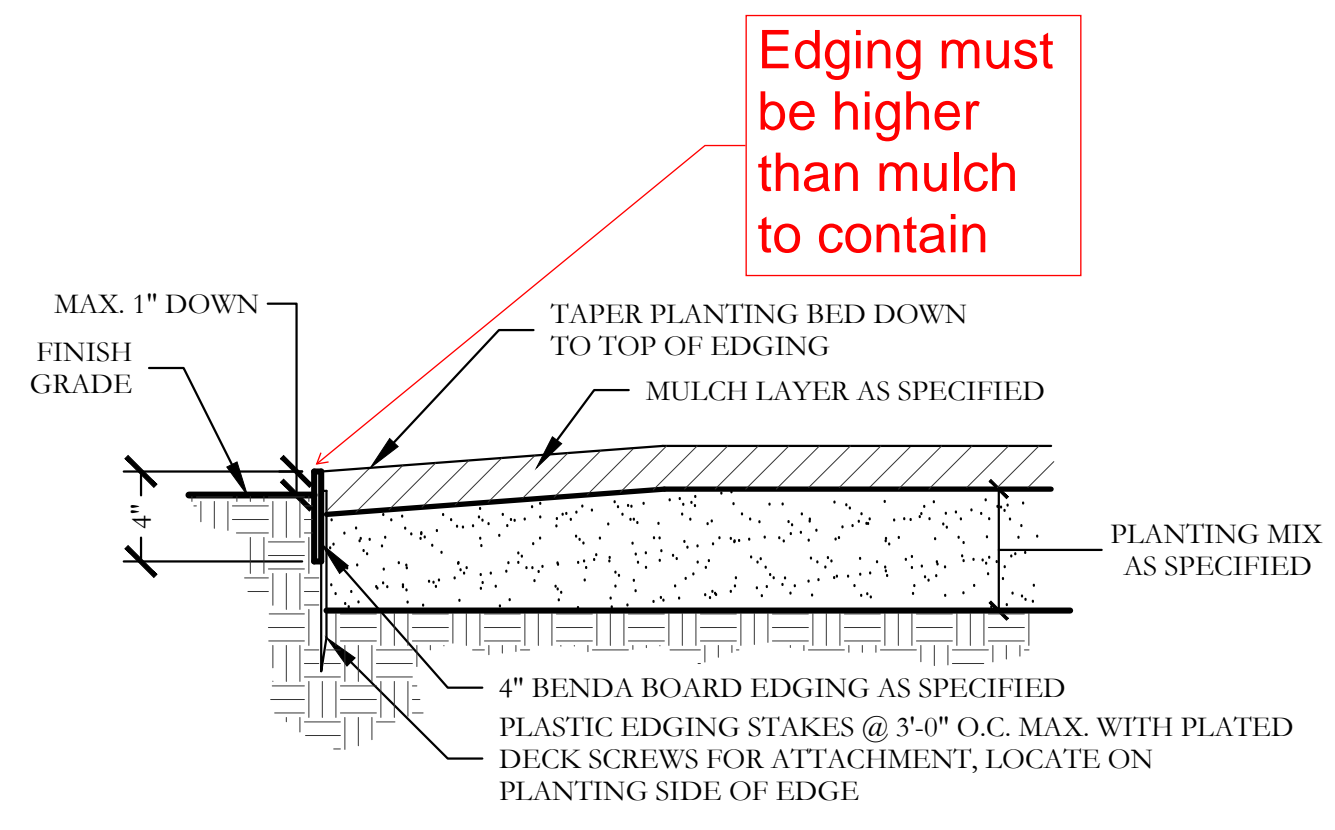

1 TYPICAL BED EDGING DETAIL SECTION NOT TO SCALE

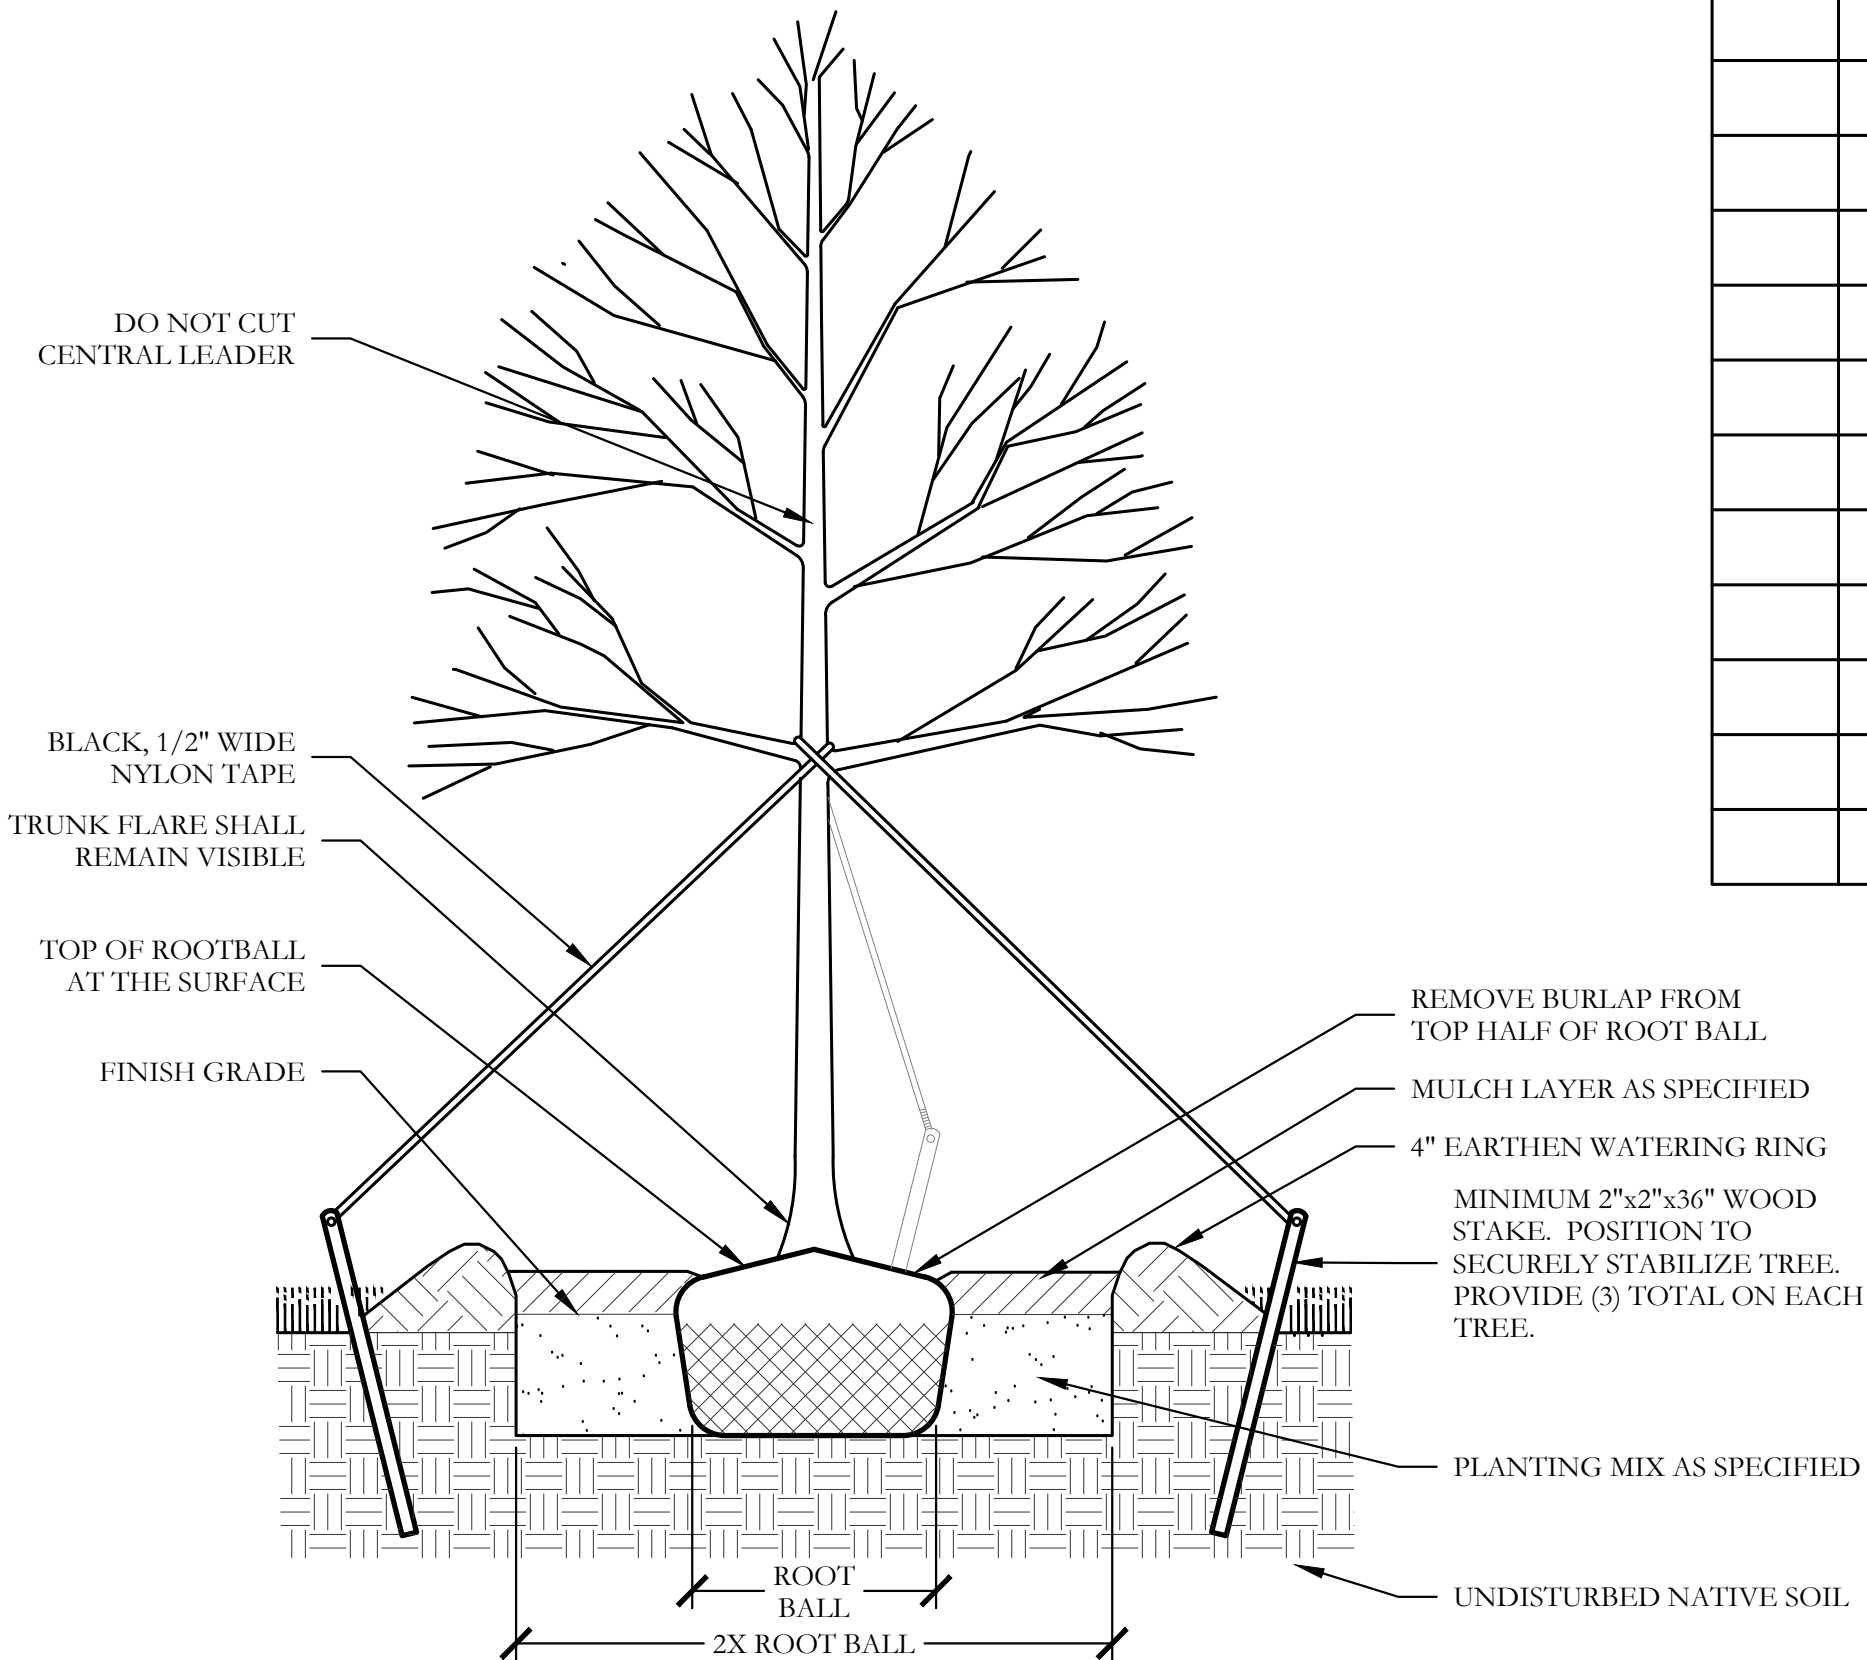

2 TYPICAL TREE PLANTING SECTION NOT TO SCALE

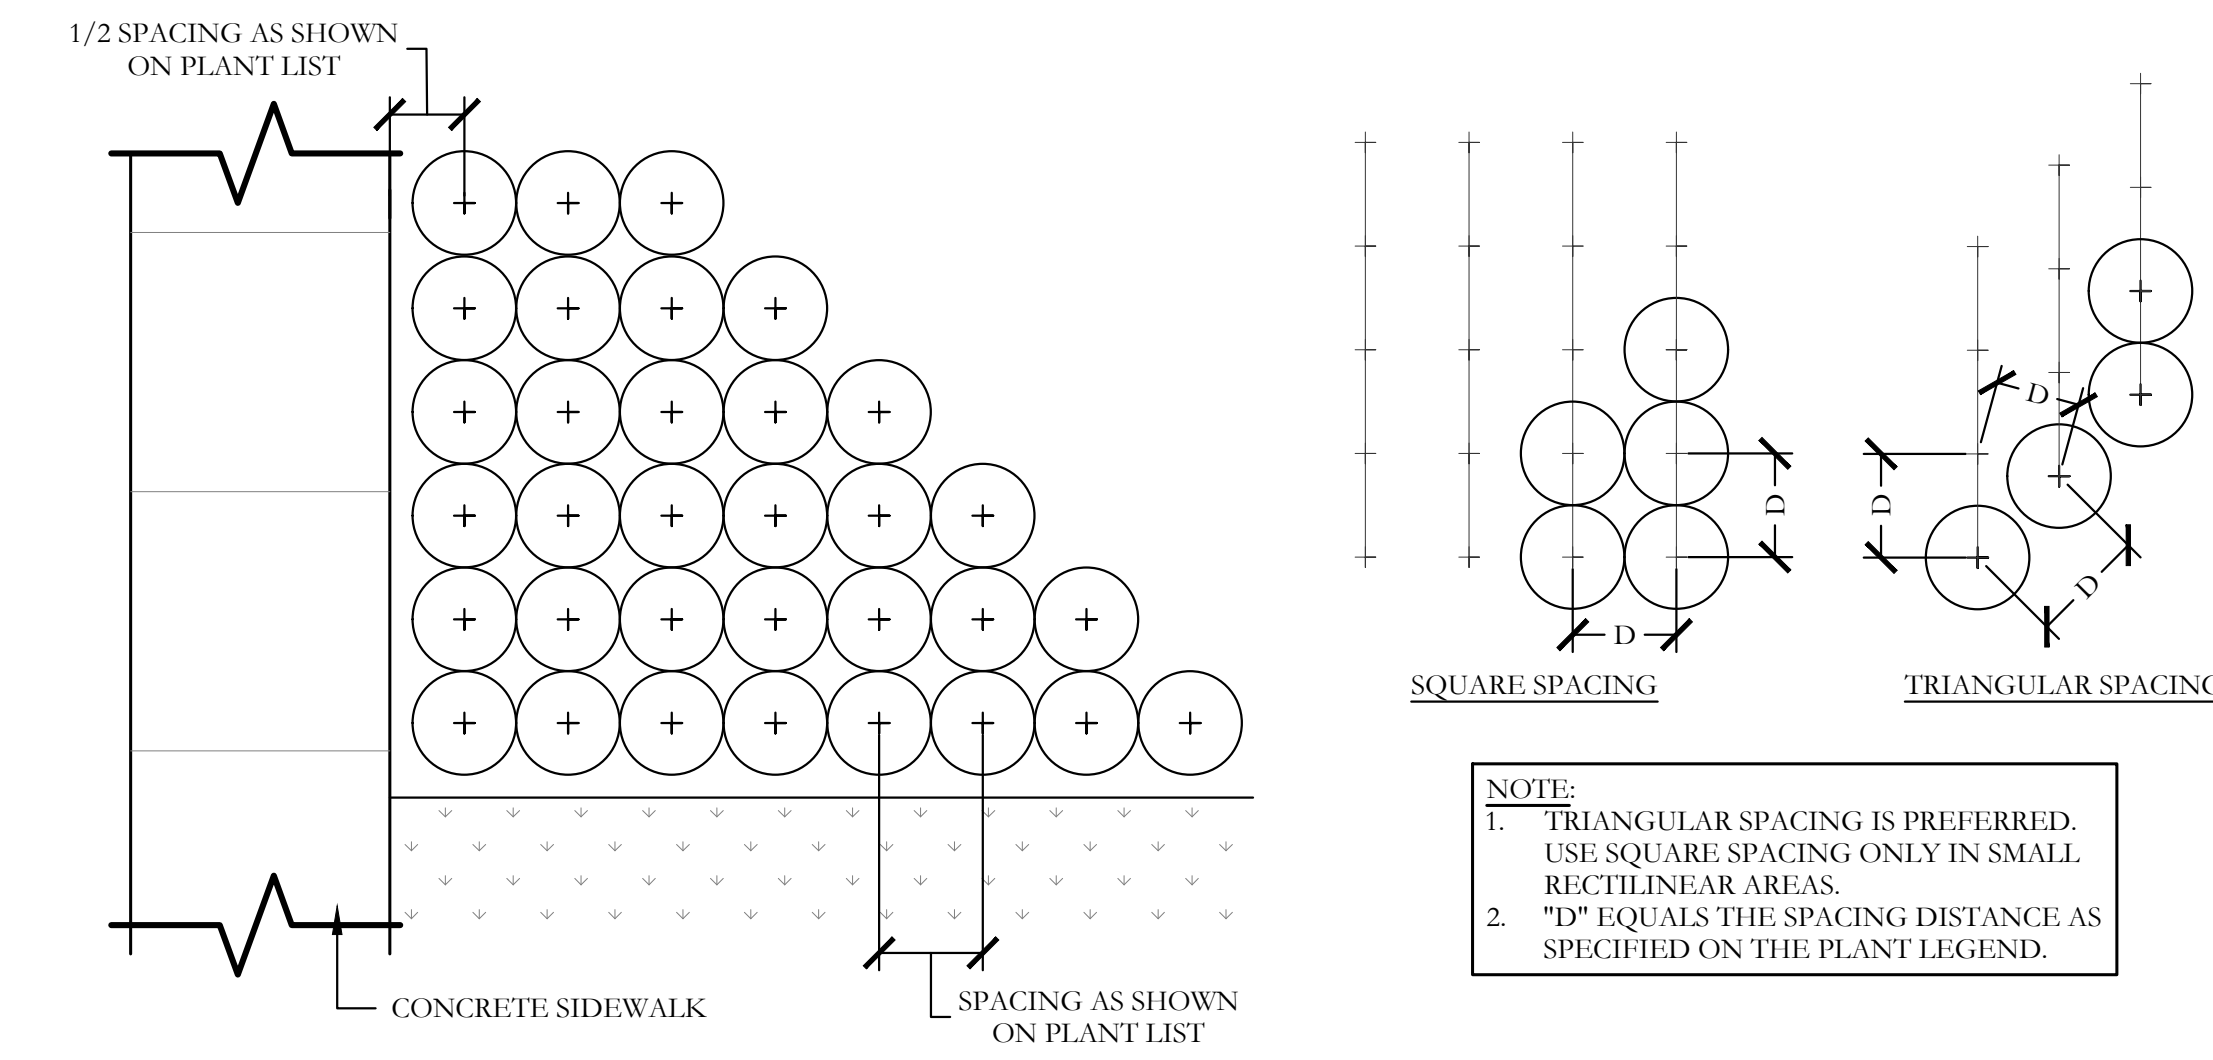

3 TYPICAL SHRUB AND GROUND COVER PLANTING PLAN/SECTION NOT TO SCALE

PLANT LIST						
KEY	ESTIMATED QUANTITY	COMMON NAME	SCIENTIFIC NAME	SIZE	SPACING	REMARKS
LO	9	LIVE OAK	QUERCUS VIRGINIANA	4" CALIPER	AS SHOWN	NURSERY GROWN; FULL HEAD; MINIMUM BRANCHING HEIGHT AT 6'-0"; MINIMUM 10'-0" OVERALL HEIGHT.
BO	7	BUR OAK	QUERCUS MACROCARPA	4" CALIPER	AS SHOWN	NURSERY GROWN; FULL HEAD; MINIMUM BRANCHING HEIGHT AT 6'-0"; MINIMUM 10'-0" OVERALL HEIGHT.
LE	10	LACEBARK ELM	ULMUS PARVIFOLIA	4" CALIPER	AS SHOWN	NURSERY GROWN; FULL HEAD; MINIMUM BRANCHING HEIGHT AT 6'-0"; MINIMUM 10'-0" OVERALL HEIGHT.
CE	6	CEDAR ELM	ULMUS CRASSIFOLIA	4" CALIPER	AS SHOWN	NURSERY GROWN; FULL HEAD; MINIMUM BRANCHING HEIGHT AT 6'-0"; MINIMUM 10'-0" OVERALL HEIGHT.
LGM	3	LITTLE GEM MAGNOLIA	MAGNOLIA GRANDIFLORA 'LITTLE GEM'	2" CALIPER	AS SHOWN	NURSERY GROWN; FULL HEAD; MINIMUM 8'-0" OVERALL HEIGHT.
DW	4	DESERT WILLOW	CHILOPSIS LINEARIS	2" CALIPER	AS SHOWN	NURSERY GROWN; FULL HEAD; MINIMUM 8'-0" OVERALL HEIGHT.
YH	8	YAUPON HOLLY	ILEX VOMITORIA	2" CALIPER	AS SHOWN	NURSERY GROWN; FULL HEAD; MINIMUM 8'-0" OVERALL HEIGHT.
RB	6	TEXAS REDBUD	CERCIS CANADENSIS VAR. TEXENSIS	2" CALIPER	AS SHOWN	NURSERY GROWN; FULL HEAD; MINIMUM 8'-0" OVERALL HEIGHT.
	21	PURPLE DIAMOND LOROPETALUM	LOROPETALUM CHINENSIS 'PURPLE DIAMOND'	7 GALLON	48" O.C.	CONTAINER GROWN; FULL PLANT.
	74	TEXAS SAGE	LEUCOPHYLLUM FRUTESCENS	7 GALLON	48" O.C.	CONTAINER GROWN; FULL PLANT.
	67	GLOSSY ABELIA	LINNAEA X GRANDIFLORA	7 GALLON	36" O.C.	CONTAINER GROWN; FULL PLANT.
	42	DWARF BURFORD HOLLY	ILEX CORNUTA 'DWARF BURFORD'	7 GALLON	36" O.C.	CONTAINER GROWN; FULL PLANT.
	6	UPRIGHT ROSEMARY	ROSMARINUS OFFICINALIS 'UPRIGHT'	3 GALLON	36" O.C.	CONTAINER GROWN; FULL PLANT.
	6	DWARF MAIDEN GRASS	MISCANTHUS SINENSIS ADAGIO'	3 GALLON	36" O.C.	CONTAINER GROWN; FULL PLANT.
	10	MORNING LIGHT MISCANTHUS	MISCANTHUS SINENSIS 'MORNING LIGHT'	3 GALLON	36" O.C.	CONTAINER GROWN; FULL PLANT.
	21	RED YUCCA	HESPERALOE PARVIFLORA	3 GALLON	36" O.C.	CONTAINER GROWN; FULL PLANT.
	70	PLUM YEW PROSTRATA	CEPHALOTAXUS HARRINGTONIA 'PROSTRATA'	3 GALLON	48" O.C.	CONTAINER GROWN; FULL PLANT.
	825	LIRIOPE GRASS	LIRIOPE MUSCARI	1 GALLON	18" O.C.	CONTAINER GROWN; FULL PLANT.
	85	MEXICAN FEATHER GRASS	NASSELLA TENUISSIMA	1 GALLON	18" O.C.	CONTAINER GROWN; FULL PLANT.
	825	ANNUAL COLOR	TO BE SELECTED BY OWNER	4" POT	8" O.C.	CONTAINER GROWN; FULL PLANT.
	50,135	COMMON BERMUDA GRASS	CYNODON DACTYLON	SQUARE FEET	SOLID SOD	MINIMUM 100% COVERAGE ALL AREAS SHOWN

GENERAL LANDSCAPE NOTES

- INSPECTIONS:**
- NO EXCAVATION SHALL OCCUR IN CITY R.O.W. WITHOUT A R.O.W. PERMIT--CONTACT THE PUBLIC WORKS DEPARTMENT.
 - THE CONTRACTOR SHALL MARK ALL WATER LINES, SEWER LINES, AND TREE LOCATIONS PRIOR TO CALLING FOR ROW INSPECTION AND PERMIT.
 - THE LANDSCAPE INSTALLATION SHALL COMPLY WITH APPROVED LANDSCAPE DRAWINGS PRIOR TO FINAL ACCEPTANCE BY THE CITY AND ISSUANCE OF A CERTIFICATE OF OCCUPANCY.
 - WATER METERS, CLEANOUTS AND OTHER APPURTENANCES, SHALL BE ACCESSIBLE, ADJUSTED TO GRADE, CLEARLY MARKED WITH FLAGGING AND COMPLIANT WITH PUBLIC WORKS DEPARTMENT STANDARDS PRIOR TO CALLING FOR FINAL LANDSCAPE AND ROW INSPECTIONS.

- LANDSCAPE STANDARDS:**
- PLANTINGS AND LANDSCAPE ELEMENTS SHALL COMPLY WITH THE CITY'S ENGINEERING DESIGN STANDARDS, PUBLIC ROW VISIBILITY REQUIREMENTS.
 - UNLESS OTHERWISE SPECIFIED, TREES SHALL BE PLANTED NO LESS THAN 4' FROM CURBS, SIDEWALKS, UTILITY LINES, SCREENING WALLS AND OTHER STRUCTURES. THE CITY HAS FINAL APPROVAL FOR ALL TREE PLACEMENTS.
 - A MINIMUM THREE FEET (3') RADIUS AROUND A FIRE HYDRANT MUST REMAIN CLEAR OF LANDSCAPE PURSUANT TO THE FIRE CODE.
 - STREET TREES, WHERE REQUIRED, SHALL BE (10') MINIMUM FROM THE EDGE OF A STORM SEWER CURB INLET BOX AND THE EDGE OF THE ROOT BALL SHALL BE (4') MINIMUM FROM THE WATER METER.
 - THE AMERICAN STANDARD FOR NURSERY STOCK (ANSI Z60.1-2004) SPECIFICATIONS SHALL GOVERN PLANT QUALIFICATIONS, GRADES, AND STANDARDS.
 - TREE PLANTING SHALL COMPLY WITH DETAILS HEREIN AND THE INTERNATIONAL SOCIETY OF ARBORICULTURE (ISA) STANDARDS.
 - A 2-3" LAYER OF MULCH SHALL BE PROVIDED AROUND THE BASE OF THE PLANTED TREE. THE MULCH SHALL BE PULLED BACK 4" FROM THE TRUNK OF THE TREE.
 - TREE PITS SHALL BE TESTED FOR WATER PERCOLATION. IF WATER DOES NOT DRAIN OUT OF TREE PIT WITHIN 24-HOURS, THE TREE SHALL BE MOVED OR DRAINAGE SHALL BE PROVIDED.
 - ALL BEDS TO HAVE 3" OF COMPOSTED SOIL, LIVING EARTH TECHNOLOGY, OR APPROVED EQUAL TILLED AND TURNED TO A DEPTH OF 8" MINIMUM.
 - ALL PLANT BEDS SHALL BE TOP-DRESSED WITH A MINIMUM OF 3 INCHES OF HARDWOOD MULCH.
 - NATIVE SITE TOPSOILS TO BE PROTECTED FROM EROSION OR STOCKPILED. NATIVE SITE TOPSOIL SHALL BE LABORATORY TESTED BY AN ACCREDITED LABORATORY AND AMENDED PER SAID LABORATORY'S RECOMMENDATIONS.

- IRRIGATION STANDARDS:**
- ANY CHANGES TO THESE APPROVED IRRIGATION DRAWINGS SHALL BE AUTHORIZED BY THE CITY.
 - CONTACT DEVELOPMENT SERVICES FOR AN IRRIGATION PERMIT PRIOR TO INSTALLING THE IRRIGATION SYSTEM.
 - IRRIGATION OVER-SPRAY ON STREETS AND WALKS IS PROHIBITED.
 - MAINLINES, VALVES, OR CONTROL WIRES SHALL NOT BE LOCATED IN THE CITY'S ROW.
 - ET IRRIGATION CONTROLLERS SHALL BE PROGRAMMED AND ADJUSTED TO NOT EXCEED THE LANDSCAPE WATER ALLOWANCE (LWA) PRIOR TO APPROVAL OF LANDSCAPE INSTALLATION.
 - VALVES SHALL BE LOCATED A MINIMUM OF (5') AWAY FROM STORM SEWERS, AND SANITARY SEWER LINES AND 5 FEET FROM CITY FIRE HYDRANTS AND WATER VALVES.
 - THE BORE DEPTH UNDER STREETS, DRIVE AISLES, AND FIRE LANES SHALL PROVIDE (2') OF CLEARANCE (MINIMUM).
 - IRRIGATION HEADS THAT RUN PARALLEL AND NEAR PUBLIC WATER AND SANITARY SEWER LINES; SHALL BE FED FROM STUBBED LATERALS OR BULL-BEADS. A MINIMUM FIVE FOOT (5') SEPARATION IS REQUIRED BETWEEN IRRIGATION MAIN LINES AND LATERALS THAT RUN PARALLEL TO PUBLIC WATER AND SANITARY SEWER LINES.
 - NO VALVES, BACKFLOW PREVENTION ASSEMBLIES, QUICK COUPLERS ETC. SHALL BE LOCATED CLOSER THAN 10' FROM THE CURB AT STREET OR DRIVE INTERSECTION.

- MAINTENANCE STANDARDS:**
- THE OWNER SHALL BE RESPONSIBLE FOR THE ESTABLISHMENT, MAINTENANCE, AND VIGOR OF PLANT MATERIAL IN ACCORDANCE WITH THE DESIGN INTENT AND AS APPROPRIATE FOR THE SEASON OF THE YEAR.
 - LANDSCAPE AND OPEN AREAS SHALL BE FREE OF TRASH, LITTER AND WEEDS.
 - NO PLANT MATERIAL SHALL BE ALLOWED TO ENCROUGH ON R.O.W, SIDEWALKS OR EASEMENTS TO THE EXTENT THAT VISION OR ROUTE OF TRAVEL FOR VEHICULAR, PEDESTRIAN, OR BICYCLE TRAFFIC IS IMPEDED.
 - TREE MAINTENANCE SHALL BE IN ACCORDANCE WITH THE STANDARDS OF THE INTERNATIONAL SOCIETY OF ARBORICULTURE.
 - TREE STAKING MATERIALS, IF USED, SHALL BE REMOVED AFTER (1) GROWING SEASON, NO MORE THAN (1) YEAR AFTER INSTALLATION (STEEL TREE STAKES, WIRES, AND HOSES ARE PROHIBITED).

- TREE PROTECTION NOTES:**
- CONTACT DEVELOPMENT SERVICES FOR A TREE REMOVAL PERMIT PRIOR TO REMOVAL OR TRANSPLANTING OF ANY TREES.
 - ALL TREES WHICH ARE TO REMAIN ON SITE SHALL BE PROTECTED WITH A (4') TALL BRIGHTLY COLORED PLASTIC FENCE, OR SILT FENCE, PLACED AT THE DRIP LINE OF THE TREES.
 - PRIOR TO THE PRE-CONSTRUCTION MEETING OR OBTAINING A GRADING PERMIT, ALL TREE MARKINGS AND PROTECTIVE FENCING SHALL BE INSTALLED BY THE OWNER AND BE INSPECTED BY DEVELOPMENT SERVICES.
 - NO EQUIPMENT SHALL BE CLEANED, OR HARMFUL LIQUIDS DEPOSITED WITHIN THE LIMITS OF THE ROOT ZONE OF TREES WHICH REMAIN ON SITE.
 - NO SIGNS, WIRES, OR OTHER ATTACHMENTS SHALL BE ATTACHED TO ANY TREE TO REMAIN ON SITE.
 - VEHICULAR AND CONSTRUCTION EQUIPMENT SHALL NOT PARK OR DRIVE WITHIN THE LIMITS OF THE DRIP LINE.
 - GRADE CHANGES IN EXCESS OF 3 INCHES (CUT OR FILL) SHALL NOT BE ALLOWED WITHIN A ROOT ZONE, UNLESS ADEQUATE TREE PRESERVATION METHODS ARE APPROVED BY THE CITY.
 - NO TRENCHING SHALL BE ALLOWED WITHIN THE DRIP-LINE OF A TREE, UNLESS APPROVED BY THE CITY.
 - ALL REMOVED TREES SHALL BE CHIPPED AND USED FOR MULCH ON SITE OR HAULED OFF-SITE.
 - ALL TREE MAINTENANCE TECHNIQUES SHALL BE IN CONFORMANCE WITH INDUSTRY IDENTIFIED STANDARDS. IMPROPER OR MALICIOUS PRUNING TECHNIQUES ARE STRICTLY PROHIBITED.

ALL RESPONSIBILITY FOR ADEQUACY OF DESIGN REMAINS WITH THE DESIGN ENGINEER. THE CITY OF ROCKWALL, IN REVIEWING AND RELEASING PLANS FOR CONSTRUCTION, ASSUMES NO RESPONSIBILITY FOR ADEQUACY OR ACCURACY OF DESIGN.

APPROVED:
I hereby certify that the above and foregoing site plan for a development in the City of Rockwall, Texas, was approved by the Planning & Zoning Commission of the City of Rockwall on the [DAY] day of [MONTH], [YEAR].

WITNESS OUR HANDS, this [DAY] day of [MONTH], [YEAR].

Planning & Zoning Commission, Chairman

Director of Planning and Zoning



DEVELOPMENT APPLICATION

City of Rockwall
Planning and Zoning Department
385 S. Goliad Street
Rockwall, Texas 75087

STAFF USE ONLY

PLANNING & ZONING CASE NO. _____

NOTE: THE APPLICATION IS NOT CONSIDERED ACCEPTED BY THE CITY UNTIL THE PLANNING DIRECTOR AND CITY ENGINEER HAVE SIGNED BELOW.

DIRECTOR OF PLANNING: _____

CITY ENGINEER: _____

PLEASE CHECK THE APPROPRIATE BOX BELOW TO INDICATE THE TYPE OF DEVELOPMENT REQUEST [SELECT ONLY ONE BOX]:

<p>PLATTING APPLICATION FEES:</p> <p><input type="checkbox"/> MASTER PLAT (\$100.00 + \$15.00 ACRE)¹</p> <p><input type="checkbox"/> PRELIMINARY PLAT (\$200.00 + \$15.00 ACRE)¹</p> <p><input type="checkbox"/> FINAL PLAT (\$300.00 + \$20.00 ACRE)¹</p> <p><input type="checkbox"/> REPLAT (\$300.00 + \$20.00 ACRE)¹</p> <p><input type="checkbox"/> AMENDING OR MINOR PLAT (\$150.00)</p> <p><input type="checkbox"/> PLAT REINSTATEMENT REQUEST (\$100.00)</p> <p>SITE PLAN APPLICATION FEES:</p> <p><input checked="" type="checkbox"/> SITE PLAN (\$250.00 + \$20.00 ACRE)¹</p> <p><input checked="" type="checkbox"/> AMENDED SITE PLAN/ELEVATIONS/LANDSCAPING PLAN (\$100.00)</p>	<p>ZONING APPLICATION FEES:</p> <p><input type="checkbox"/> ZONING CHANGE (\$200.00 + \$15.00 ACRE)¹</p> <p><input type="checkbox"/> SPECIFIC USE PERMIT (\$200.00 + \$15.00 ACRE)^{1&2}</p> <p><input type="checkbox"/> PD DEVELOPMENT PLANS (\$200.00 + \$15.00 ACRE)¹</p> <p>OTHER APPLICATION FEES:</p> <p><input type="checkbox"/> TREE REMOVAL (\$75.00)</p> <p><input type="checkbox"/> VARIANCE REQUEST/SPECIAL EXCEPTIONS (\$100.00)²</p> <p>NOTES:</p> <p>¹: IN DETERMINING THE FEE, PLEASE USE THE EXACT ACREAGE WHEN MULTIPLYING BY THE PER ACRE AMOUNT. FOR REQUESTS ON LESS THAN ONE ACRE, ROUND UP TO ONE (1) ACRE.</p> <p>²: A \$1,000.00 FEE WILL BE ADDED TO THE APPLICATION FEE FOR ANY REQUEST THAT INVOLVES CONSTRUCTION WITHOUT OR NOT IN COMPLIANCE TO AN APPROVED BUILDING PERMIT.</p>
--	--

PROPERTY INFORMATION [PLEASE PRINT]

ADDRESS: Amenity Center within Homestead

SUBDIVISION: Homestead LOT: 9 BLOCK: F

GENERAL LOCATION: Corner of Fisher Road and Hardin Boulevard

ZONING, SITE PLAN AND PLATTING INFORMATION [PLEASE PRINT]

CURRENT ZONING	Single Family Residential	CURRENT USE	Private Recreation Center
PROPOSED ZONING	Single Family Residential	PROPOSED USE	Private Recreation Center
ACREAGE	1.60	LOTS [CURRENT]	1
		LOTS [PROPOSED]	1

SITE PLANS AND PLATS: BY CHECKING THIS BOX YOU ACKNOWLEDGE THAT DUE TO THE PASSAGE OF HB3167 THE CITY NO LONGER HAS FLEXIBILITY WITH REGARD TO ITS APPROVAL PROCESS, AND FAILURE TO ADDRESS ANY OF STAFF'S COMMENTS BY THE DATE PROVIDED ON THE DEVELOPMENT CALENDAR WILL RESULT IN THE DENIAL OF YOUR CASE.

OWNER/APPLICANT/AGENT INFORMATION [PLEASE PRINT/CHECK THE PRIMARY CONTACT/ORIGINAL SIGNATURES ARE REQUIRED]

<input type="checkbox"/> OWNER	SH DEV KLUTTS ROCKWALL LLC	<input checked="" type="checkbox"/> APPLICANT	Johnson Volk Consulting
CONTACT PERSON	Stephen Pepper	CONTACT PERSON	Cody Johnson
ADDRESS	2400 Dallas Parkway Suite 460	ADDRESS	704 Central Parkway East Suite 1200
CITY, STATE & ZIP	Plano, Texas 75093	CITY, STATE & ZIP	Plano, Texas 75074
PHONE	972-526-7700	PHONE	972-201-3100
E-MAIL	stephen.pepper@shaddockhomes.com	E-MAIL	cody.johnson@johnsonvolk.com

NOTARY VERIFICATION [REQUIRED]

BEFORE ME, THE UNDERSIGNED AUTHORITY, ON THIS DAY PERSONALLY APPEARED Stephen Pepper [OWNER] THE UNDERSIGNED, WHO STATED THE INFORMATION ON THIS APPLICATION TO BE TRUE AND CERTIFIED THE FOLLOWING:

"I HEREBY CERTIFY THAT I AM THE OWNER FOR THE PURPOSE OF THIS APPLICATION; ALL INFORMATION SUBMITTED HEREIN IS TRUE AND CORRECT; AND THE APPLICATION FEE OF \$ 382.00 TO COVER THE COST OF THIS APPLICATION, HAS BEEN PAID TO THE CITY OF ROCKWALL ON THIS THE 13th DAY OF November, 2023 BY SIGNING THIS APPLICATION. I AGREE THAT THE CITY OF ROCKWALL (I.E. "CITY") IS AUTHORIZED AND PERMITTED TO PROVIDE INFORMATION CONTAINED WITHIN THIS APPLICATION TO THE PUBLIC. THE CITY IS ALSO AUTHORIZED AND PERMITTED TO REPRODUCE ANY COPYRIGHTED INFORMATION SUBMITTED IN CONJUNCTION WITH THIS APPLICATION, IF SUCH REPRODUCTION IS ASSOCIATED OR IN RESPONSE TO A REQUEST FOR PUBLIC INFORMATION."


GIVEN UNDER MY HAND AND SEAL OF OFFICE ON THIS THE 13th DAY OF November, 2023

OWNER'S SIGNATURE

Stephen Pepper

NOTARY PUBLIC IN AND FOR THE STATE OF TEXAS

Deanna Walker

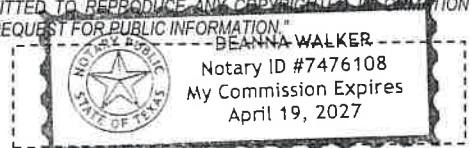

MY COMMISSION EXPIRES

PD-67

Feet

0 230 460 920 1,380 1,840

SP2023-046: Site Plan for Amenity Center within Homestead

AG

549

SFE-4

STEM 549

PD-92

PD-63

SFE-2

AG

1139

BM 1139

C

Case Location Map = 




City of Rockwall

Planning & Zoning Department
385 S. Goliad Street
Rockwall, Texas 75087
(P): (972) 771-7745
(W): www.rockwall.com

The City of Rockwall GIS maps are continually under development and therefore subject to change without notice. While we endeavor to provide timely and accurate information, we make no guarantees. The City of Rockwall makes no warranty, express or implied, including warranties of merchantability and fitness for a particular purpose. Use of the information is the sole responsibility of the user.



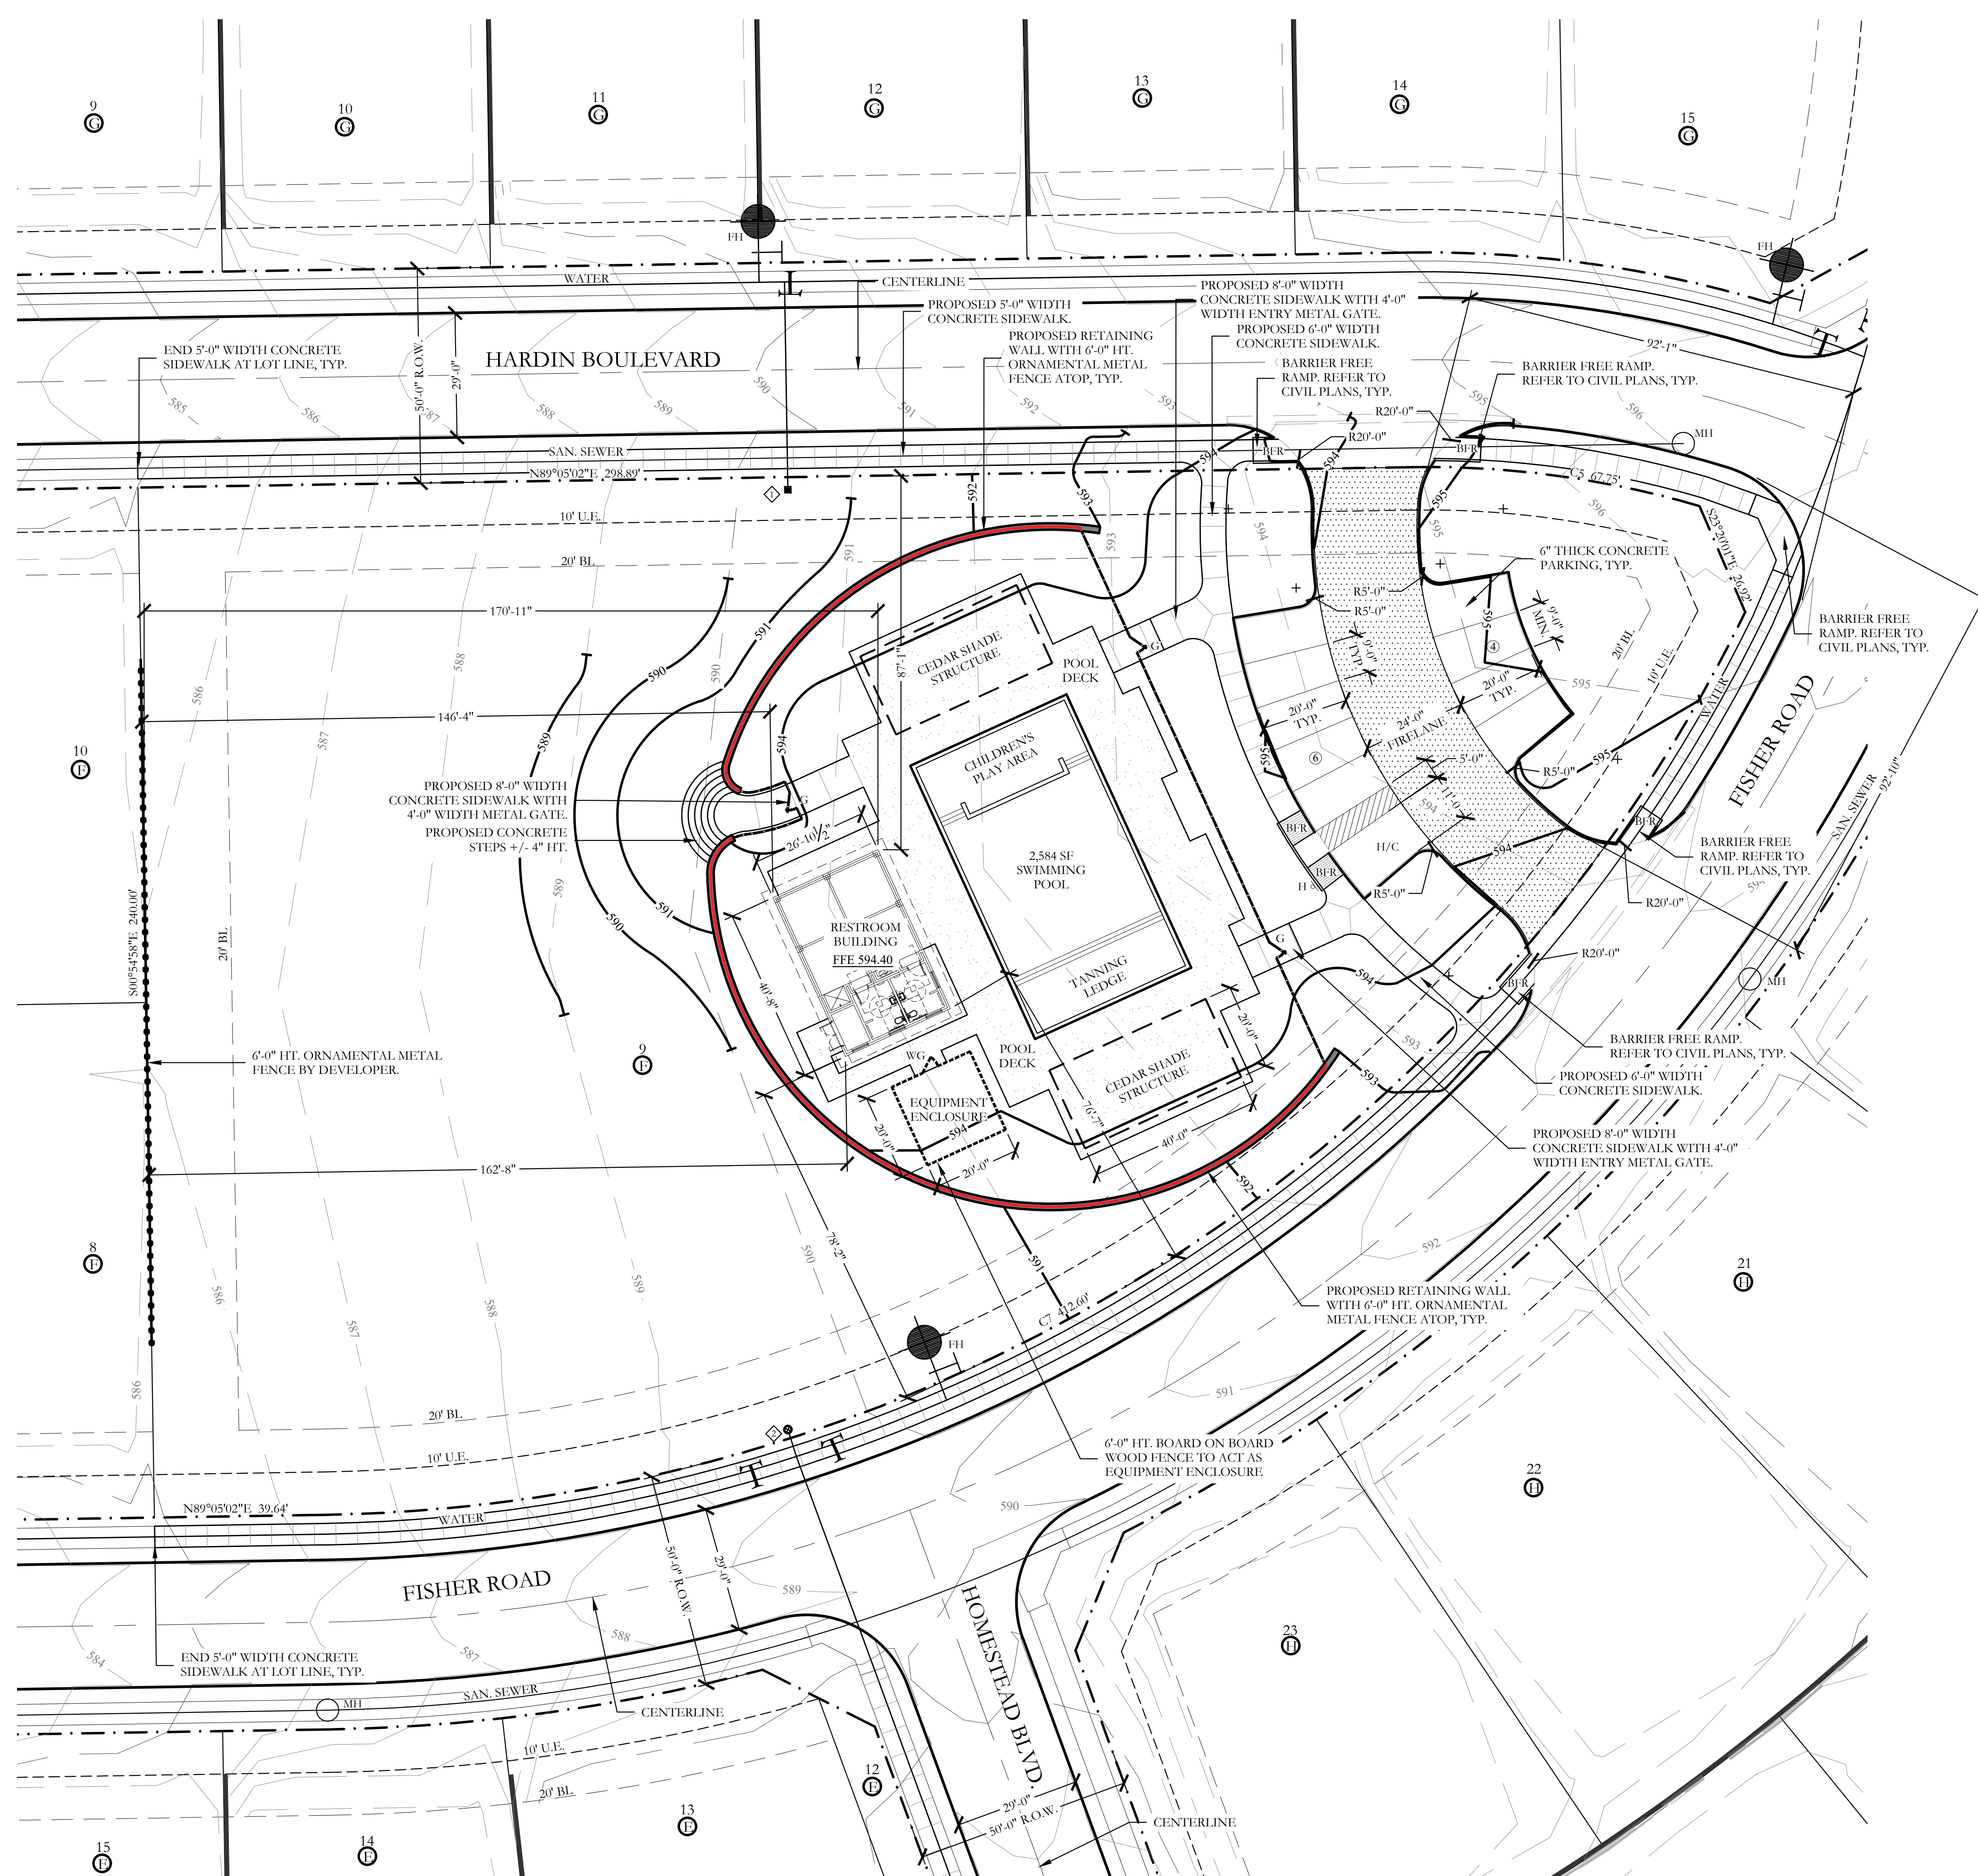

LEGEND

- ④ PROPOSED PARKING COUNT
- H/C PROPOSED HANDICAP PARKING SPACE
- BFR PROPOSED BARRIER FREE RAMP
- FH EXISTING FIRE HYDRANT
- MH EXISTING SANITARY SEWER MANHOLE
- EXISTING WATER MAIN W/ VALVE
- EXISTING SANITARY SEWER
- - - RIGHT-OF-WAY
- 593 - EXISTING CONTOUR INTERVAL
- 592 - PROPOSED CONTOUR INTERVAL
- FFE 594.40 FINISHED FLOOR ELEVATION
- ◊ PROPOSED 1.5" DOMESTIC WATER METER
- ◊ PROPOSED 1.5" IRRIGATION WATER METER
- H HANDICAP PARKING SIGN
- PROPOSED RETAINING WALL
- ORNAMENTAL METAL FENCE (6'-0" HT. AROUND SWIMMING POOL AREA)
- ORNAMENTAL METAL FENCE ATOP RETAINING WALL (6'-0" HT. AROUND SWIMMING POOL AREA)
- ▲ 1 - 4'-0" WIDTH SELF LATCHING, SELF-CLOSING METAL GATE
- ▲ 1 - 4'-0" WIDTH SELF LATCHING, SELF-CLOSING WOODEN GATE
- 6'-0" HT. WOOD FENCE TO ACT AS POOL EQUIPMENT AND TRASH TOTE ENCLOSURE
- ORNAMENTAL METAL FENCE ALONG PROPERTY LINE
- ▨ FIRELANE PAVING PER CITY STANDARD DETAILS

WATER METER SCHEDULE

METER ID NUMBER	WATER SERVICE SIZE	WATER METER SIZE	METER DOM	METER IRR	SAN. SERVICE SIZE
◊	1.5"	1.5"	X		6"
◊	1.5"	1.5"		X	6"

SITE PLAN NOTES:

- NO 100 YEAR FLOOD PLAIN EXISTS ON PROPERTY.
- FOR ALL BARRIER FREE RAMP NOTED ON PLAN, REFERENCE THE CITY OF ROCKWALL STANDARD CONSTRUCTION DETAILS.
- ALL HANDICAP PARKING SPACES SHALL BE A MINIMUM OF 11'-0" WIDTH x 20'-0" LENGTH WITH A 5'-0" LOADING AISLE.
- STANDARD PARKING SPACES SHALL BE A MINIMUM OF 9'-0" WIDTH x 20'-0" LENGTH.
- THE PERIMETER FENCING SHALL BE 6'-0" HT. ORNAMENTAL METAL FENCE.
- ALL VEHICULAR AND SIDEWALK PAVING SHOWN ON THESE PLANS SHALL BE MAINTAINED BY THE HOA.


SITE INFORMATION

SINGLE FAMILY RESIDENTIAL
 PROPOSED USE: PRIVATE RECREATION CENTER
 LAND AREA: 1.60 ACRES
 69,696.00 SQ. FT.
 BUILDING AREA: 1,092.73 SQUARE FEET
 BUILDING HEIGHT: 22'-7" (1 STORY)
 FLOOR TO AREA: 0.0156:1 (1,092.73/69,696.00)
 LOT COVERAGE: 1.56%
 PARKING REQUIRED: 1 PER 250 SF. OF ASSEMBLY SPACE
 1,092.73/250=4.37
 5 REQUIRED SPACES
 PARKING PROVIDED: 10 TOTAL, (WITH 1 HANDICAP)
 HANDICAP PARKING IS PROVIDED IN ACCORDANCE WITH ADA STANDARDS
 TOTAL IMPERVIOUS SURFACE: 16,759.40 SF
 PROPOSED IMPERVIOUS RATIO: 0.2404 OR 24.04%
 INTERIOR LANDSCAPE PROVIDED: 52,936.60 SF
 POOL DECK SURFACE: 5,524.59 SF


APPROVED:
 I hereby certify that the above and foregoing site plan for a development in the City of Rockwall, Texas, was approved by the Planning & Zoning Commission of the City of Rockwall on the [DAY] day of [MONTH], [YEAR].

WITNESS OUR HANDS, this [DAY] day of [MONTH], [YEAR].

 Planning & Zoning Commission, Chairman Director of Planning and Zoning

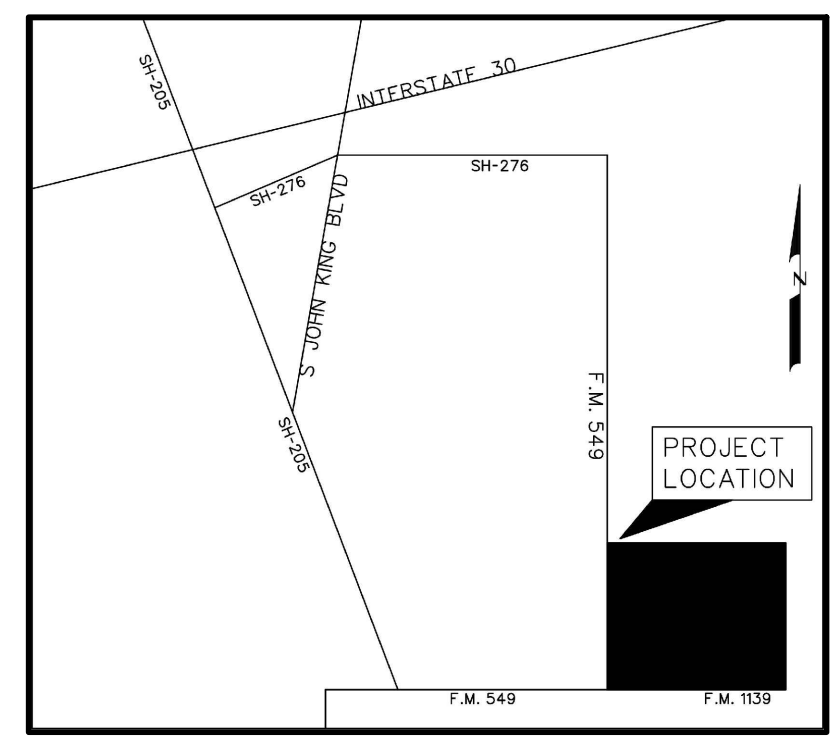

LOCATION MAP
 NOT TO SCALE

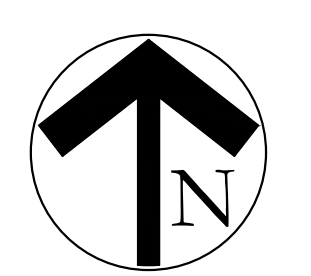

20 10 0 20
 SCALE 1" = 20'

SITE PLAN
HOMESTEAD, PHASE 1
LOT 9, BLOCK F
~AMENITY CENTER~

BEING 1.600 ACRES OUT OF THE
 J.A. RAMSEY SURVEY
 ABSTRACT NO. 186 IN THE
 CITY OF ROCKWALL, ROCKWALL COUNTY, TEXAS

OWNER / DEVELOPER:
 SHADDOCK HOMES, INC
 2400 DALLAS PARKWAY, SUITE 460
 MCKINNEY, TEXAS 75093
 CONTACT: LORA ERDMAN
LANDSCAPE ARCHITECT/CIVIL ENGINEER:
 JOHNSON VOLK CONSULTING
 704 CENTRAL PARKWAY EAST, SUITE 1200
 PLANO, TEXAS 75074
 PH. 972-201-3100
 CONTACT: CODY JOHNSON, RLA, ASLA, LI



November 13, 2023


CITY CASE NO. T8D
 SP1

BUILDING MATERIAL CALCULATIONS


Material	North	Percent	South	Percent	East	Percent	West	Percent
TOTAL SQ FT.	413 S.F.	-	448 S.F.	-	186 S.F.	-	186 S.F.	-
PRIMARY MATERIAL TOTALS	338 S.F.	81.84%	222 S.F.	49.56%	134 S.F.	72.04%	157 S.F.	84.41%
BRICK VENEER (TO BE SELECTED BY OWNER)	94 S.F.	22.76%	36 S.F.	8.04%	41 S.F.	22.04%	63 S.F.	33.87%
BOARD AND BATTEN FIBER CEMENT SIDING (TO BE SELECTED BY OWNER)	244 S.F.	59.08%	186 S.F.	41.52%	93 S.F.	50.00%	94 S.F.	50.54%
SECONDARY MATERIALS	3 S.F.	0.73%	178 S.F.	39.73%	7 S.F.	3.76%	7 S.F.	3.76%
DOUGLAS FIR BEAMS/COLUMNS (STAIN TO BE SELECTED BY OWNER)	3 S.F.	0.73%	81 S.F.	18.08%	7 S.F.	3.76%	7 S.F.	3.76%
TILE AT SHOWER/DRINKING FOUNTAINS (TO BE SELECTED BY OWNER)	-	-	97 S.F.	21.65%	-	-	-	-
DOORS/WINDOWS/TRIM (COLOR TO MATCH ADJACENT MATERIALS)	72 S.F.	17.43%	48 S.F.	10.71%	45 S.F.	24.20%	22 S.F.	11.83%
ROOF (STANDING SEAM METAL, COLOR TO BE SELECTED BY OWNER)	-	-	-	-	-	-	-	-



ACME BRICK
WHITE BLUFF

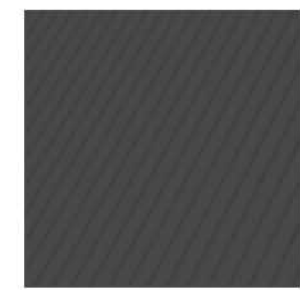

MUELLER, INC.
DARK CHARCOAL

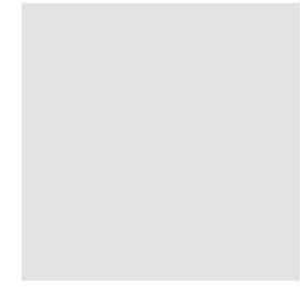

SHERWIN WILLIAMS
ICE CUBE
SW 6252



SHERWIN WILLIAMS
WEB GRAY
SW 7075







SHERWIN WILLIAMS
KINGS CANYON (WOOD STAIN)
SW 3026



DALTILE
DARK GREY (TILE)
12 X 24



GLASS WINDOW
WITH
FROSTED GLAZING

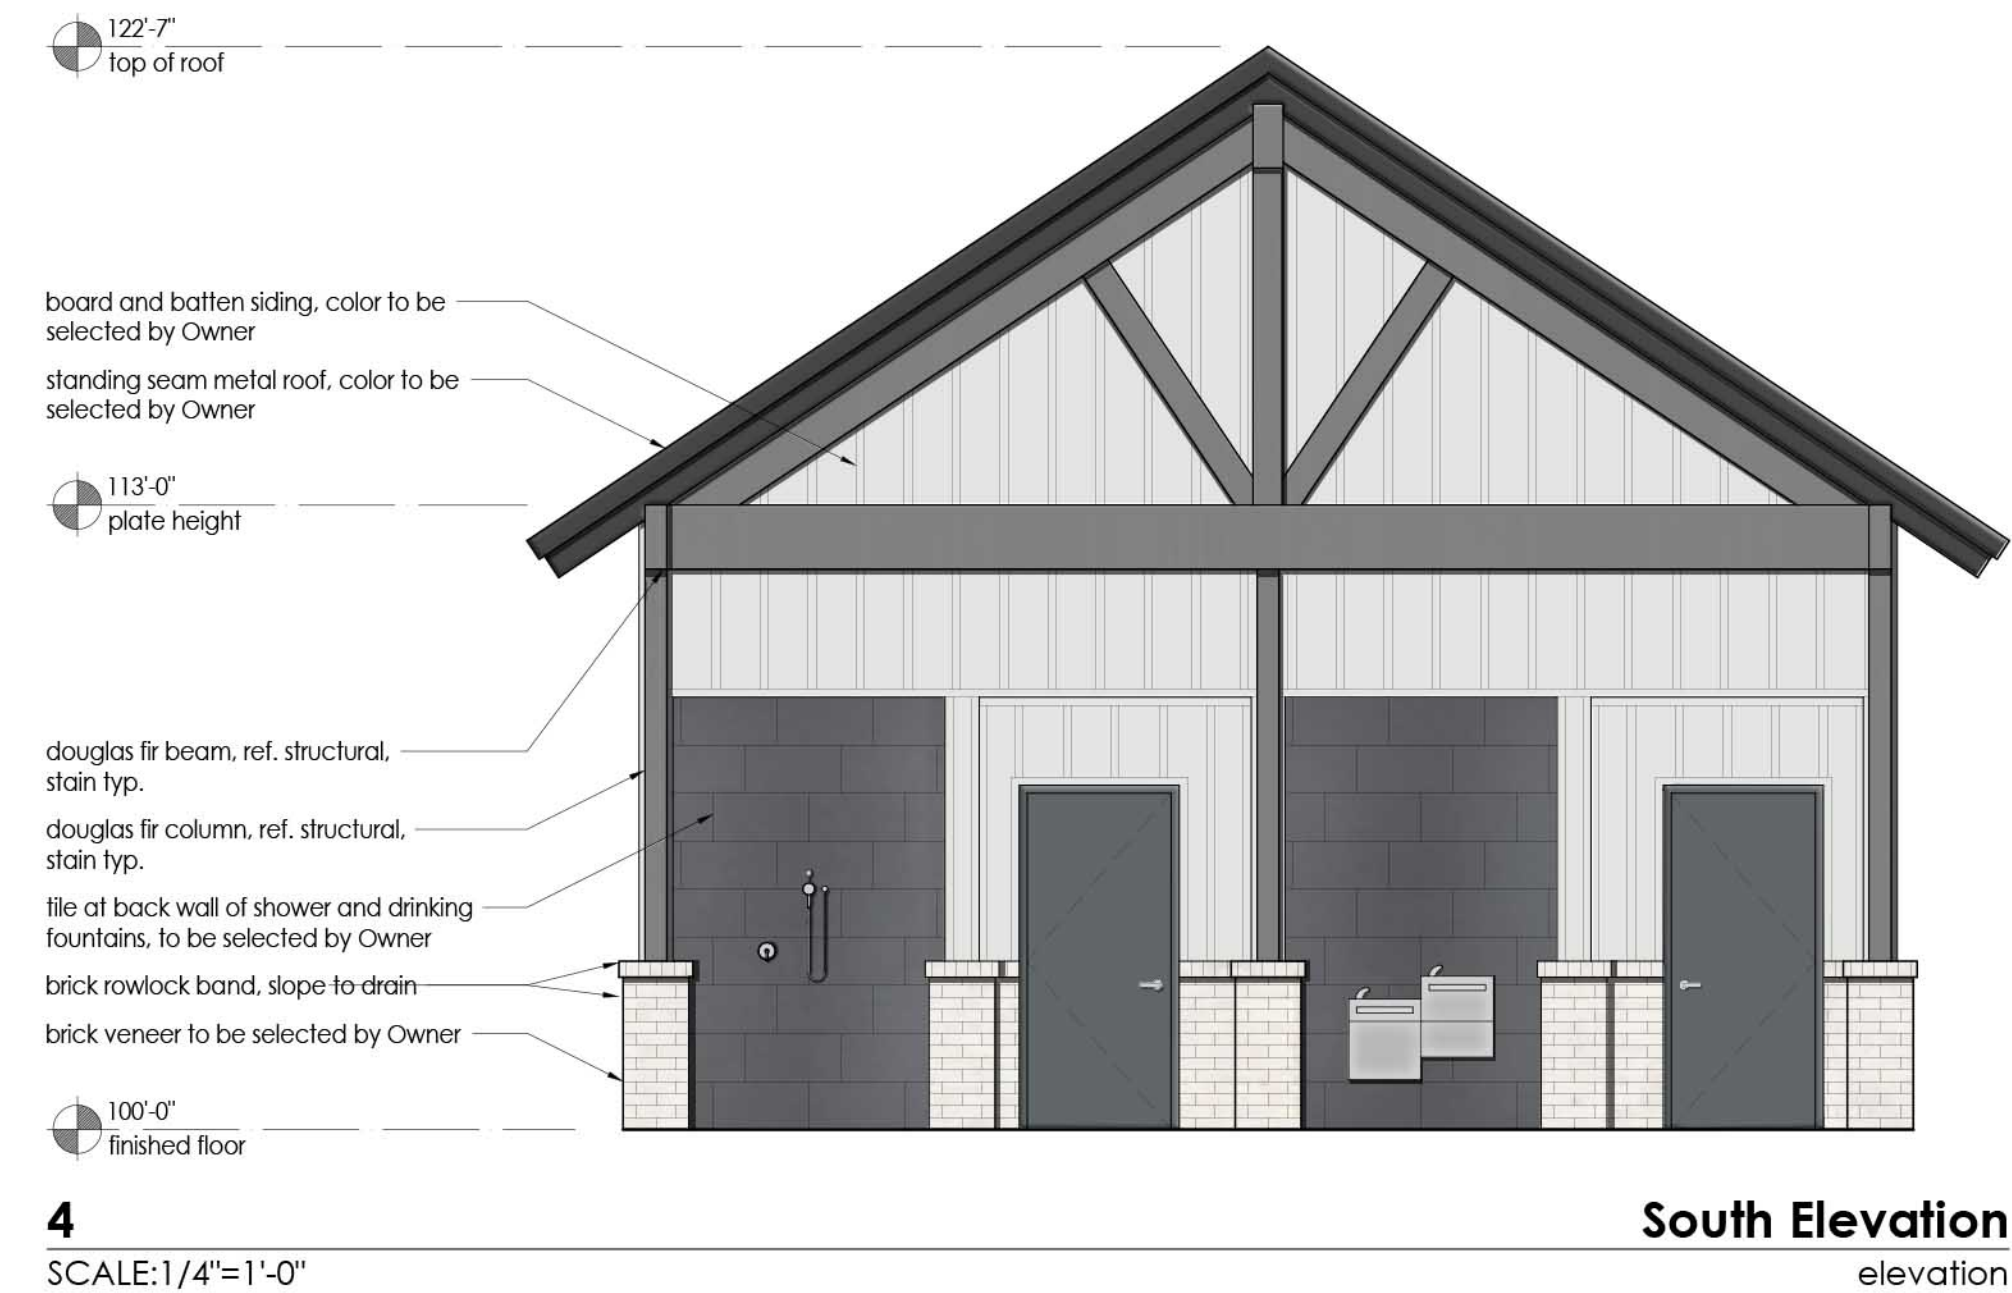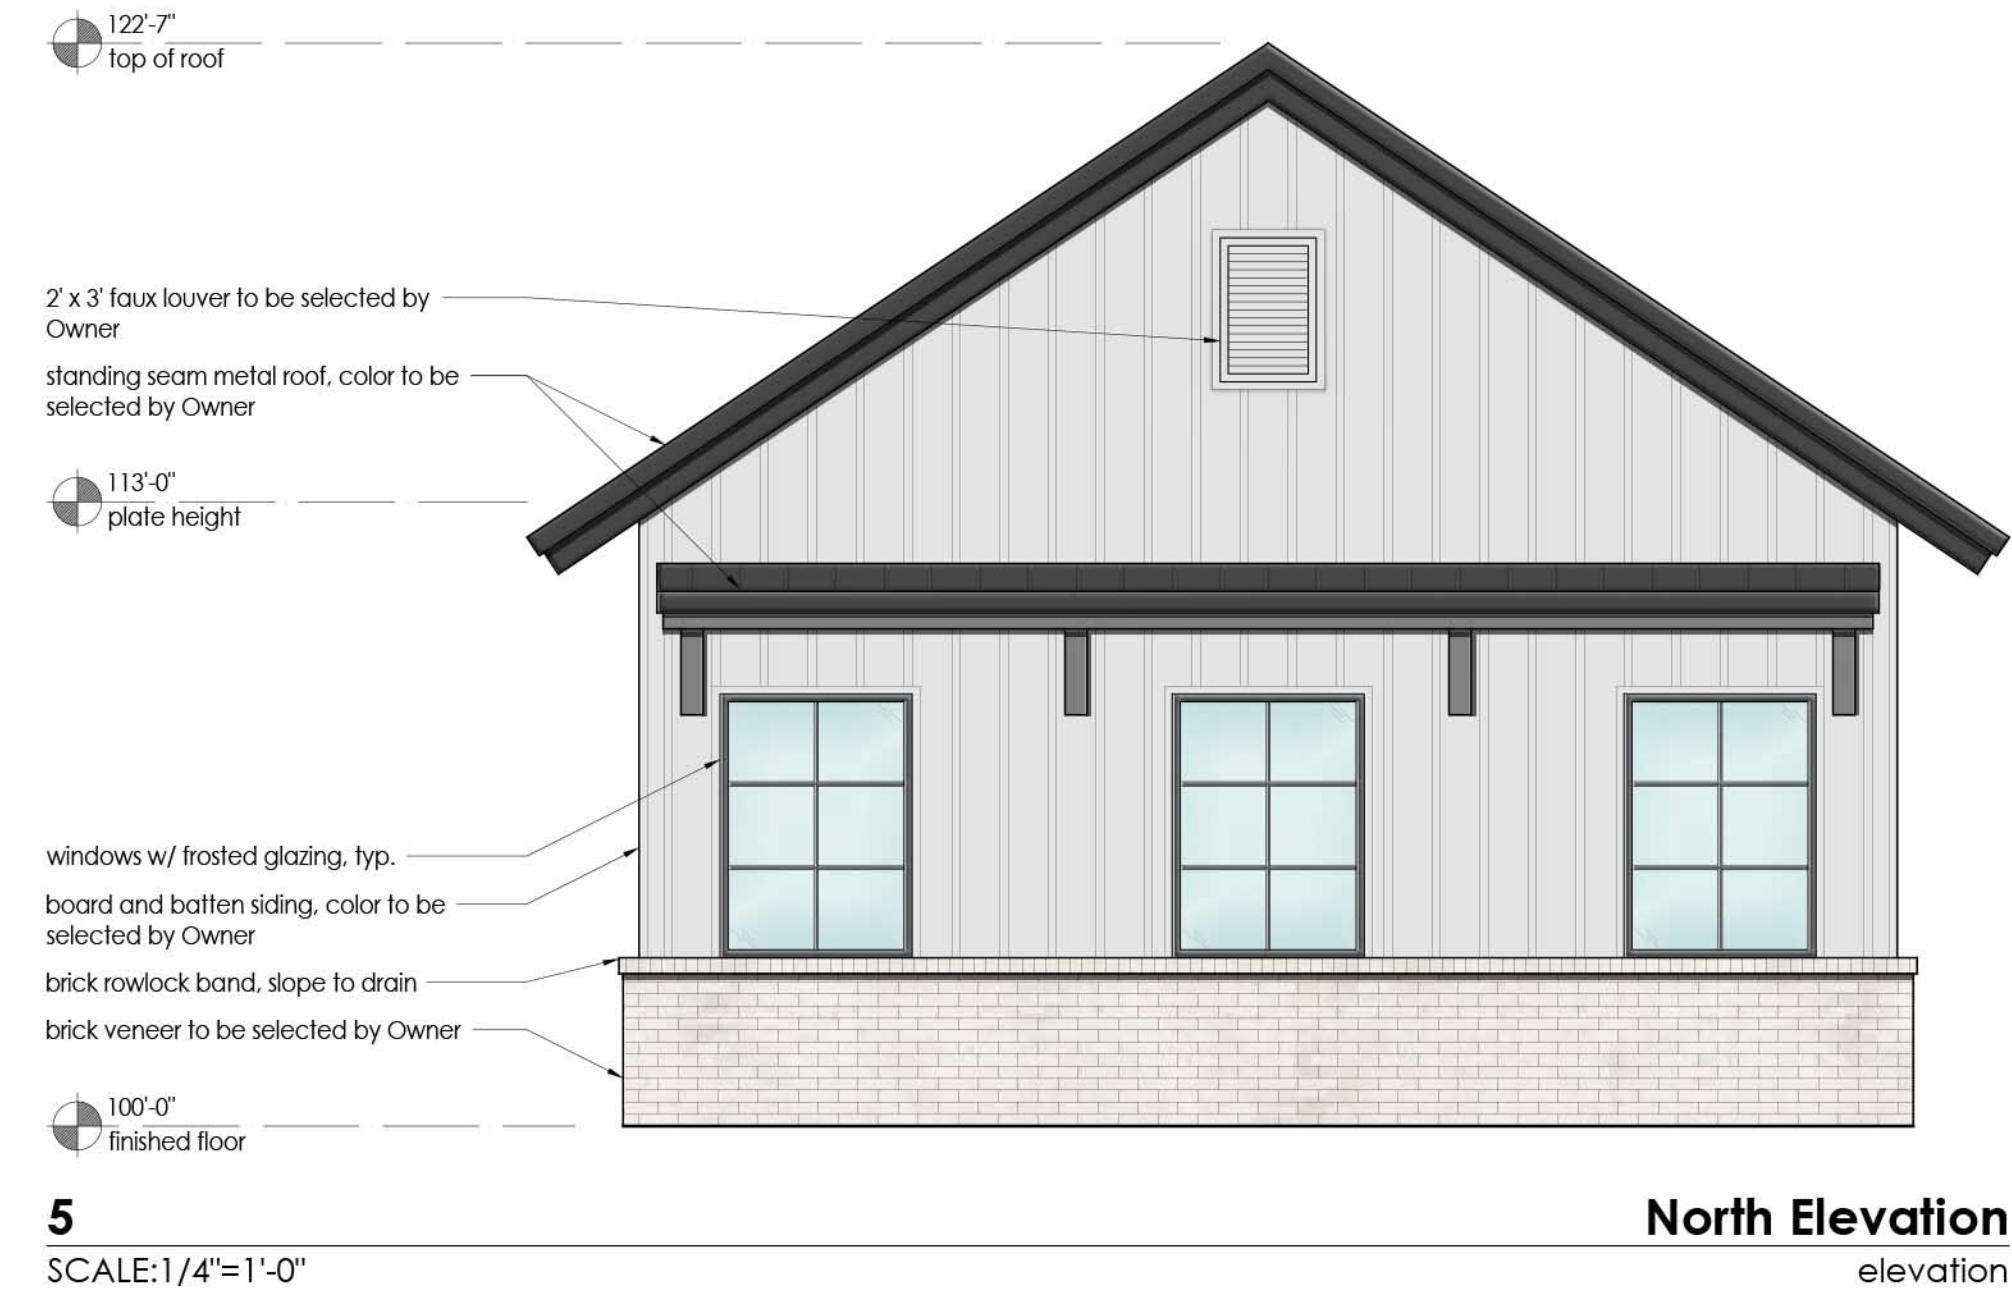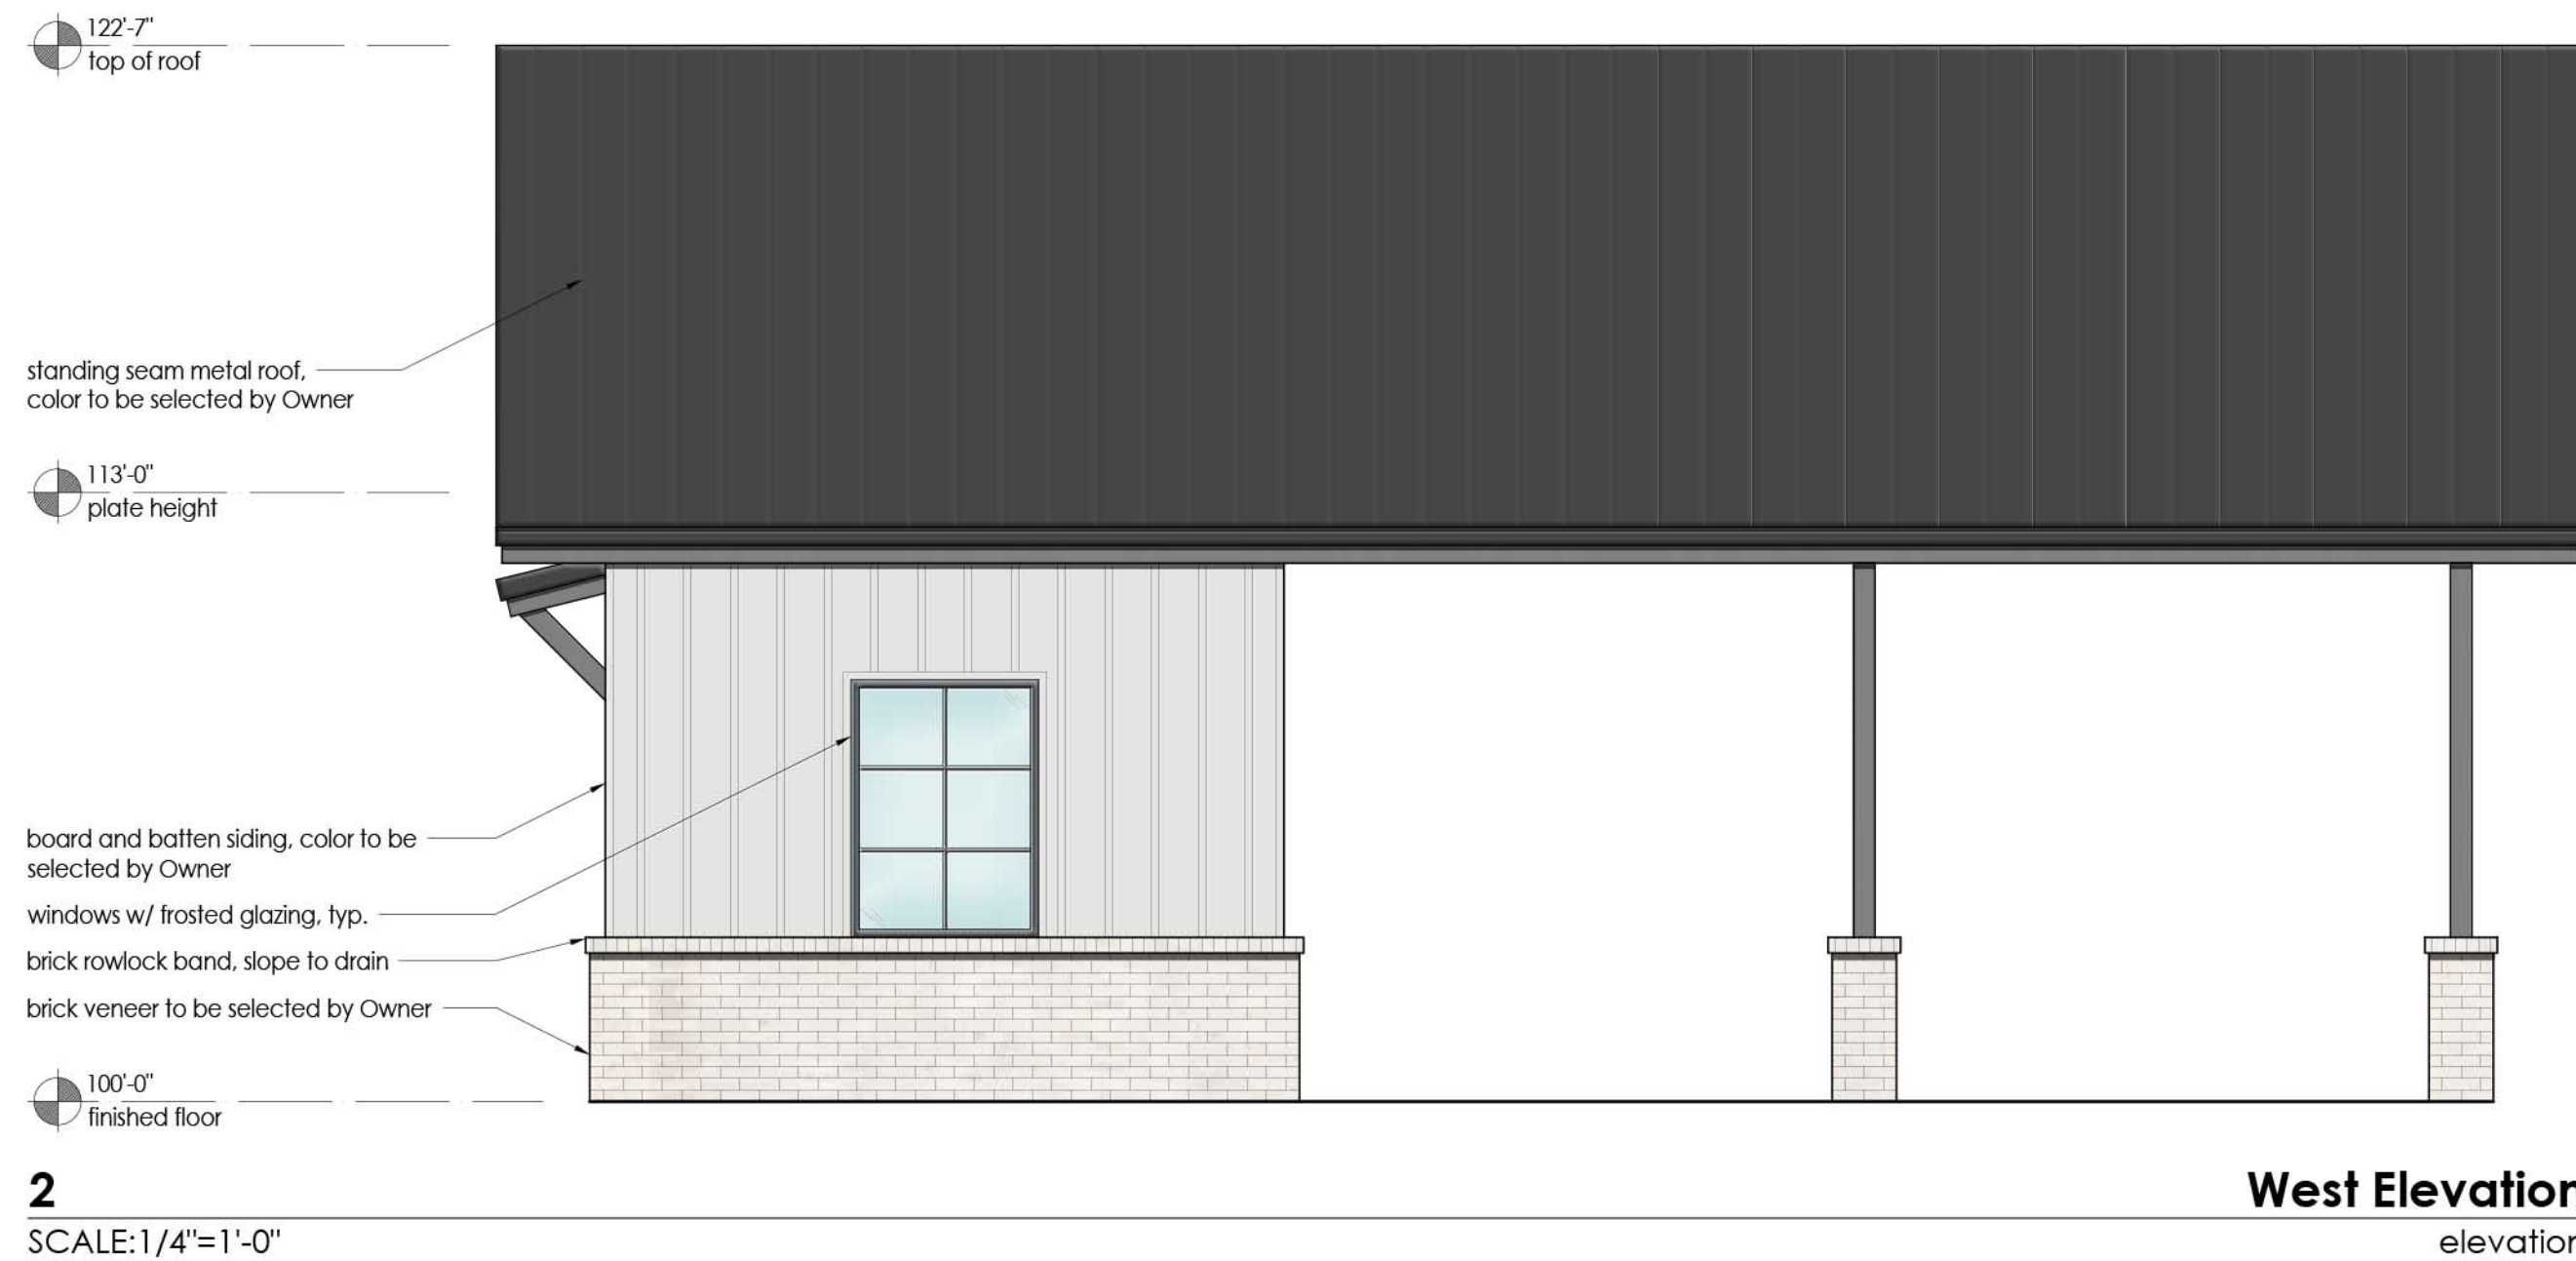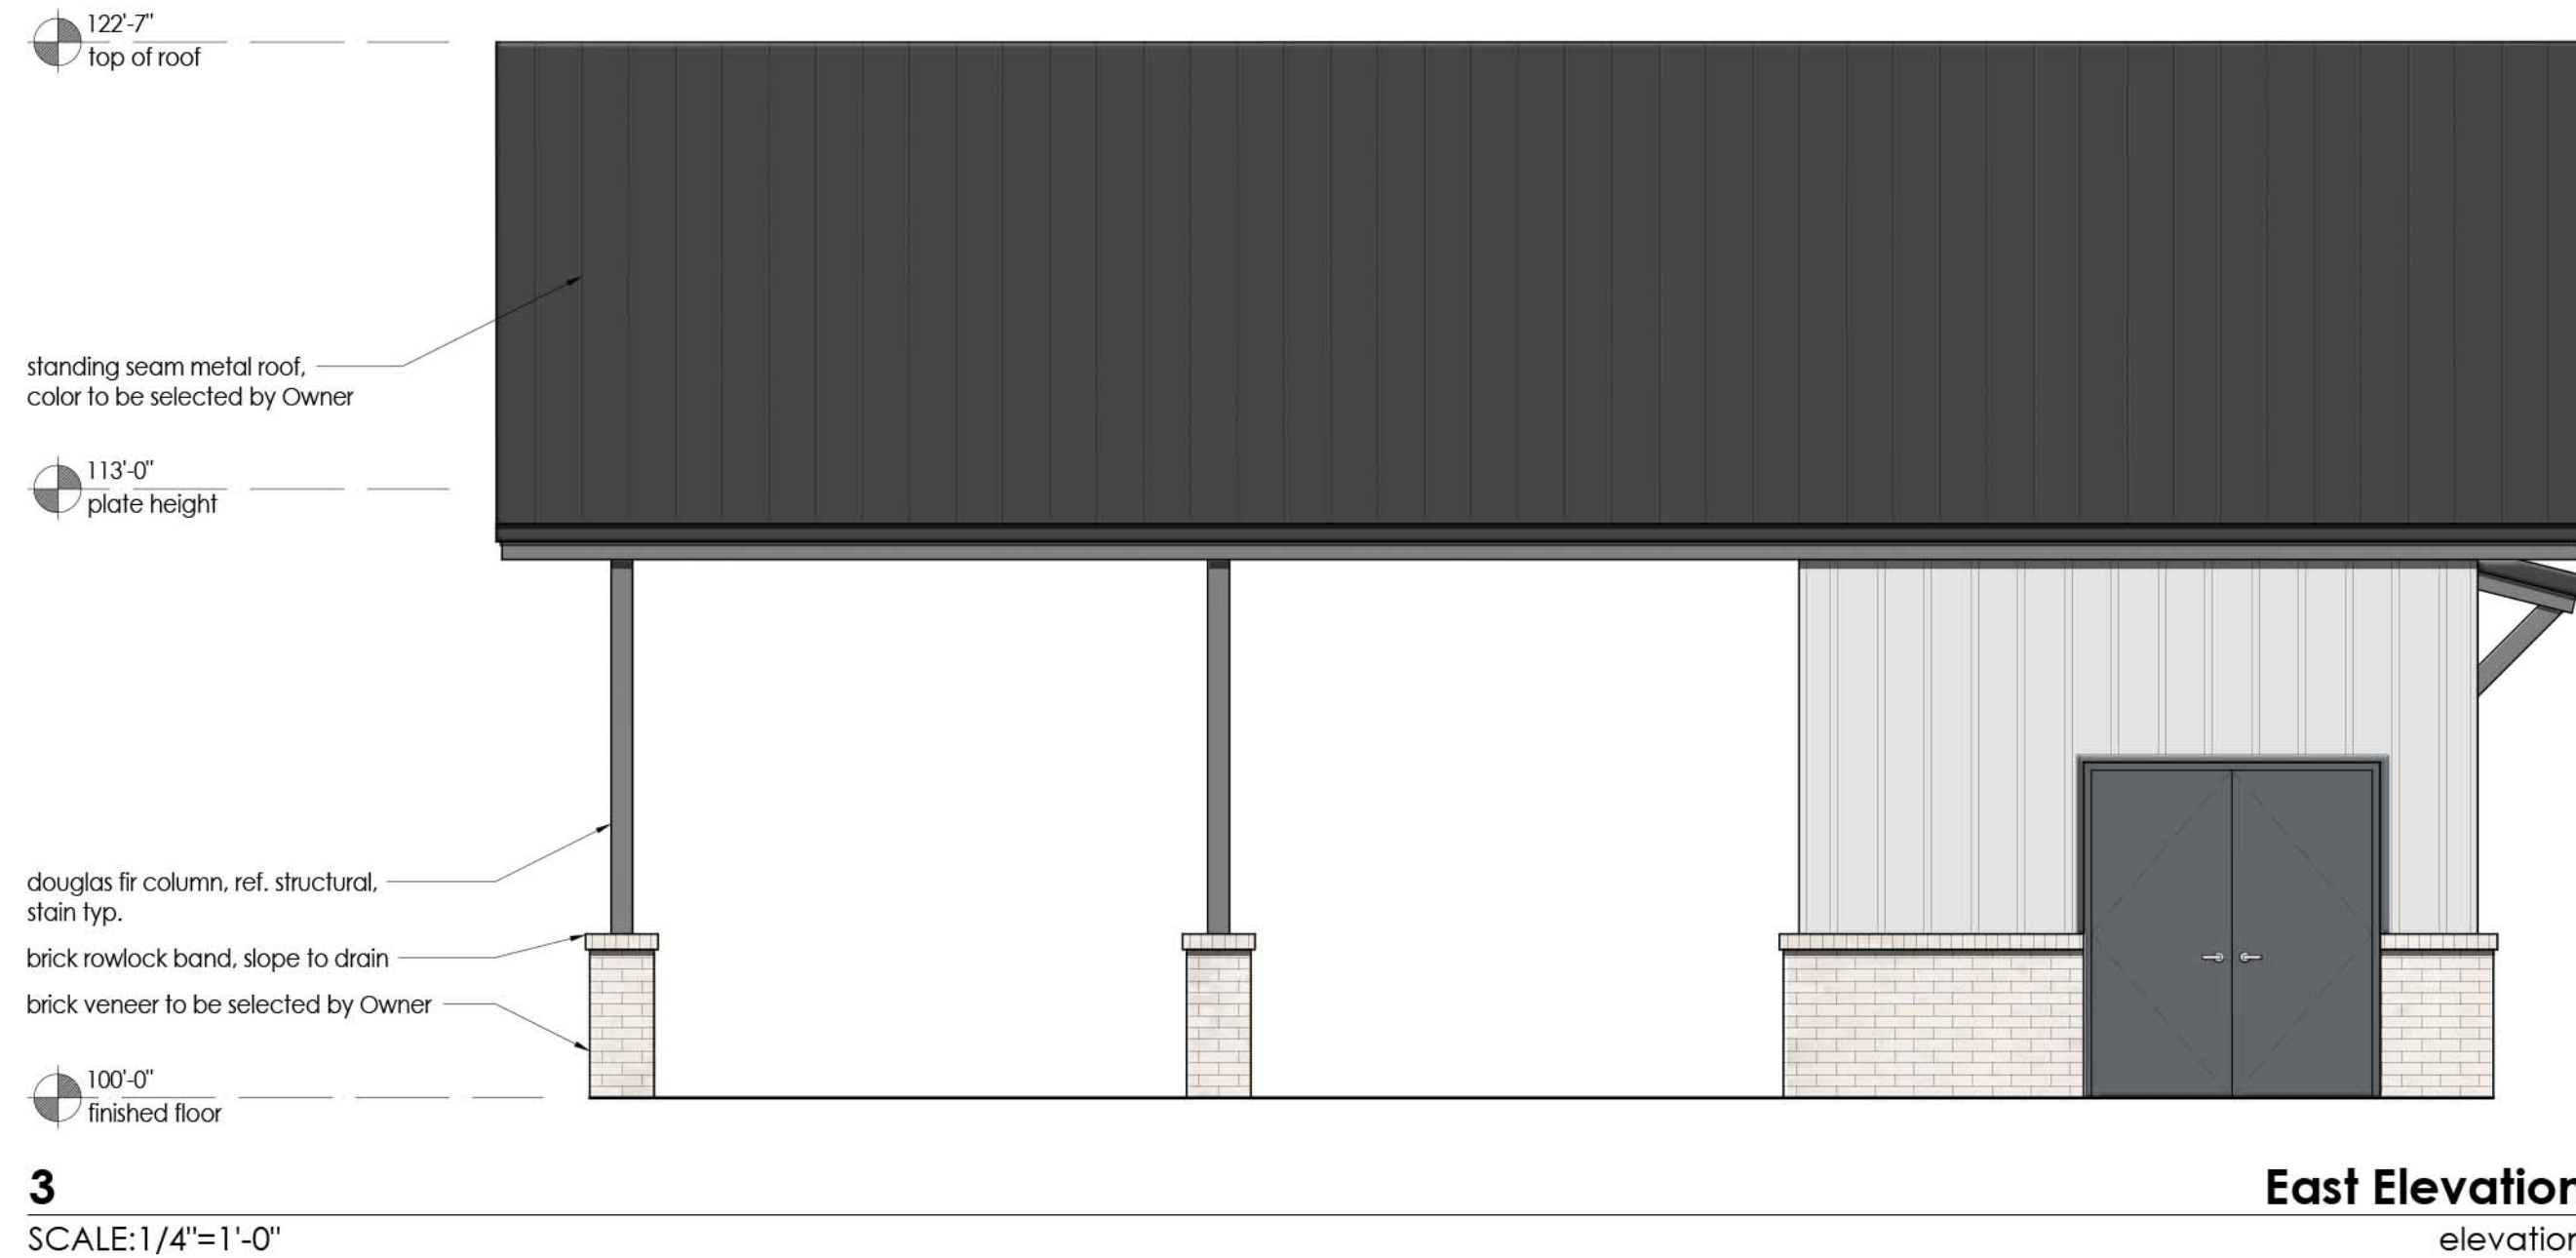


SEAL

Copyright © 2023
DATE: 10.24.2023
SCALE:
JOB NO. MA23027
DRAWN: JV
APPD: KM
ACAD #
EXTERIOR ELEVATIONS

DRAWING NO. REV. NO.

A4.00

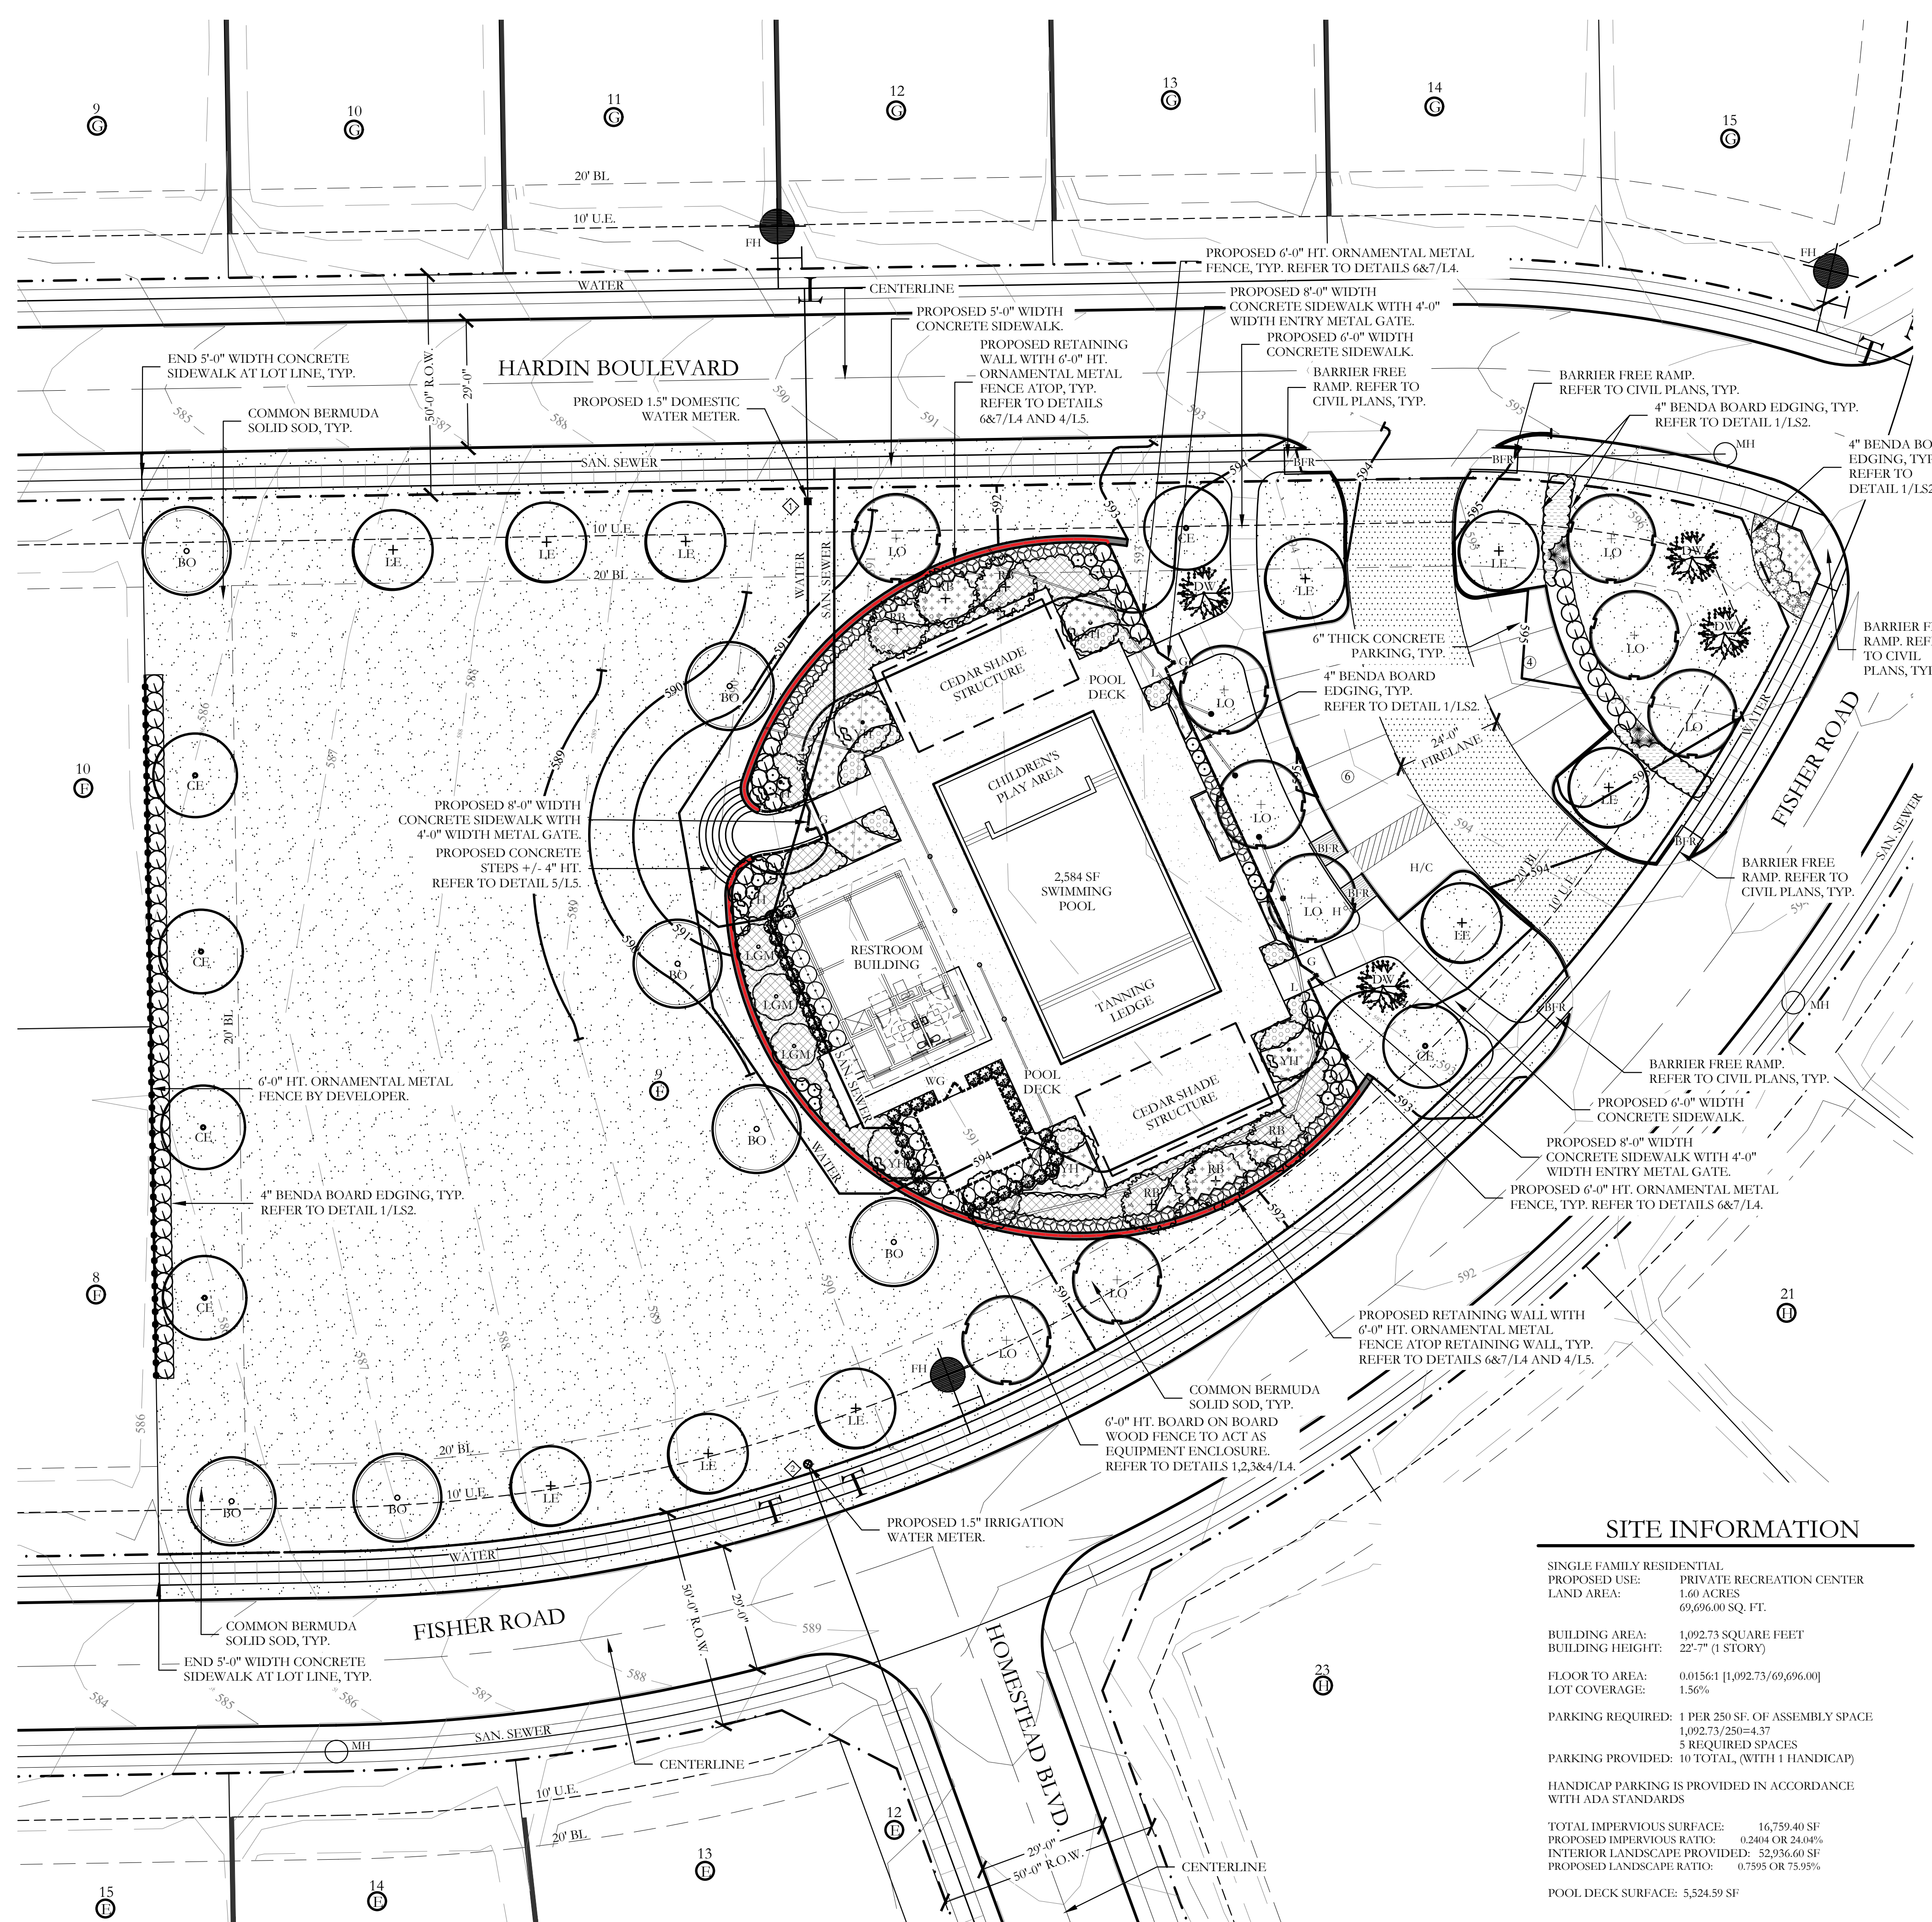

PLANT LEGEND					
SYMBOL	KEY	COMMON NAME	SCIENTIFIC NAME	SIZE	SPACING
	LO	LIVE OAK	QUERCUS VIRGINIANA	4" CALIPER	AS SHOWN
	BO	BUR OAK	QUERCUS MACROCARPA	4" CALIPER	AS SHOWN
	LE	LACEBARK ELM	ULMUS PARVIFOLIA	4" CALIPER	AS SHOWN
	CE	CEDAR ELM	ULMUS CRASSIFOLIA	4" CALIPER	AS SHOWN
	LGM	LITTLE GEM MAGNOLIA	MAGNOLIA GRANDIFLORA 'LITTLE GEM'	2" CALIPER	AS SHOWN
	DW	DESERT WILLOW	CHLOPSIS LINEARIS	2" CALIPER	AS SHOWN
	YH	YAUPON HOLLY	ILEX VOMITORIA	2" CALIPER	AS SHOWN
	RB	TEXAS REDBUD	CERCIS CANADENSIS VAR. TEXENSIS	2" CALIPER	AS SHOWN
		PURPLE DIAMOND LOROPETALUM	LOROPETALUM CHINENSIS 'PURPLE DIAMOND'	7 GALLON	48" O.C.
		TEXAS SAGE	LEUCOPHYLLUM FRUTESCENS	7 GALLON	48" O.C.
		GLOSSY ABELIA	LINNAEA X GRANDIFLORA	7 GALLON	36" O.C.
		DWARF BURFORD HOLLY	ILEX CORNUTA 'DWARF BURFORD'	7 GALLON	36" O.C.
		UPRIGHT ROSEMARY	ROSMARINUS OFFICINALIS 'UPRIGHT'	3 GALLON	36" O.C.
		DWARF MAIDEN GRASS	MISCANTHUS SINENSIS ADAGIO'	3 GALLON	36" O.C.
		MORNING LIGHT MISCANTHUS	MISCANTHUS SINENSIS 'MORNING LIGHT'	3 GALLON	36" O.C.
		RED YUCCA	HESPERALOE PARVIFLORA	3 GALLON	36" O.C.
		PLUM YEW PROSTRATA	CEPHALOTAXUS HARRINGTONIA 'PROSTRATA'	3 GALLON	48" O.C.
		LIRIOPE GRASS	LIRIOPE MUSCARI	1 GALLON	18" O.C.
		MEXICAN FEATHER GRASS	NASSELLA TENUISSIMA	1 GALLON	18" O.C.
		ANNUAL COLOR	TO BE SELECTED BY OWNER	4" POT	8" O.C.
		COMMON BERMUDA GRASS	CYNODON DACTYLON	SQUARE FEET	SOLID SOD

NOTE: IRRIGATION WILL MEET REQUIREMENTS OF UDC.

ALL RESPONSIBILITY FOR ADEQUACY OF DESIGN REMAINS WITH THE DESIGN ENGINEER. THE CITY OF ROCKWALL, IN REVIEWING AND RELEASING PLANS FOR CONSTRUCTION, ASSUMES NO RESPONSIBILITY FOR ADEQUACY OR ACCURACY OF DESIGN.




SITE INFORMATION


SINGLE FAMILY RESIDENTIAL
 PROPOSED USE: PRIVATE RECREATION CENTER
 LAND AREA: 1.60 ACRES
 69,696.00 SQ. FT.
 BUILDING AREA: 1,092.73 SQUARE FEET
 BUILDING HEIGHT: 22'-7" (1 STORY)
 FLOOR TO AREA: 0.0156:1 (1,092.73/69,696.00)
 LOT COVERAGE: 1.56%
 PARKING REQUIRED: 1 PER 250 SF. OF ASSEMBLY SPACE
 1,092.73/250=4.37
 5 REQUIRED SPACES
 PARKING PROVIDED: 10 TOTAL, (WITH 1 HANDICAP)
 HANDICAP PARKING IS PROVIDED IN ACCORDANCE WITH ADA STANDARDS
 TOTAL IMPERVIOUS SURFACE: 16,759.40 SF
 PROPOSED IMPERVIOUS RATIO: 0.2404 OR 24.04%
 INTERIOR LANDSCAPE PROVIDED: 52,936.60 SF
 PROPOSED LANDSCAPE RATIO: 0.7595 OR 75.95%
 POOL DECK SURFACE: 5,524.59 SF

APPROVED:
 I hereby certify that the above and foregoing site plan for a development in the City of Rockwall, Texas, was approved by the Planning & Zoning Commission of the City of Rockwall on the [DAY] day of [MONTH], [YEAR].


WITNESS OUR HANDS, this [DAY] day of [MONTH], [YEAR].

 Planning & Zoning Commission, Chairman Director of Planning and Zoning

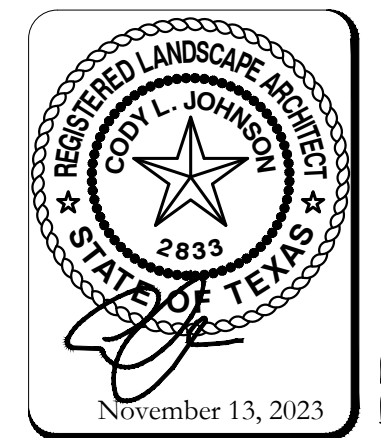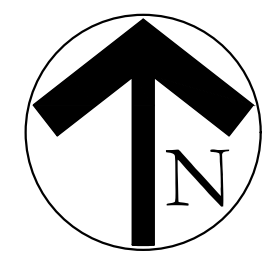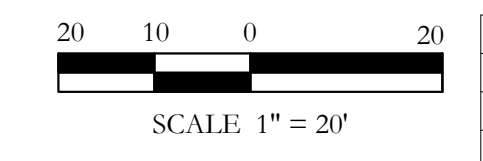


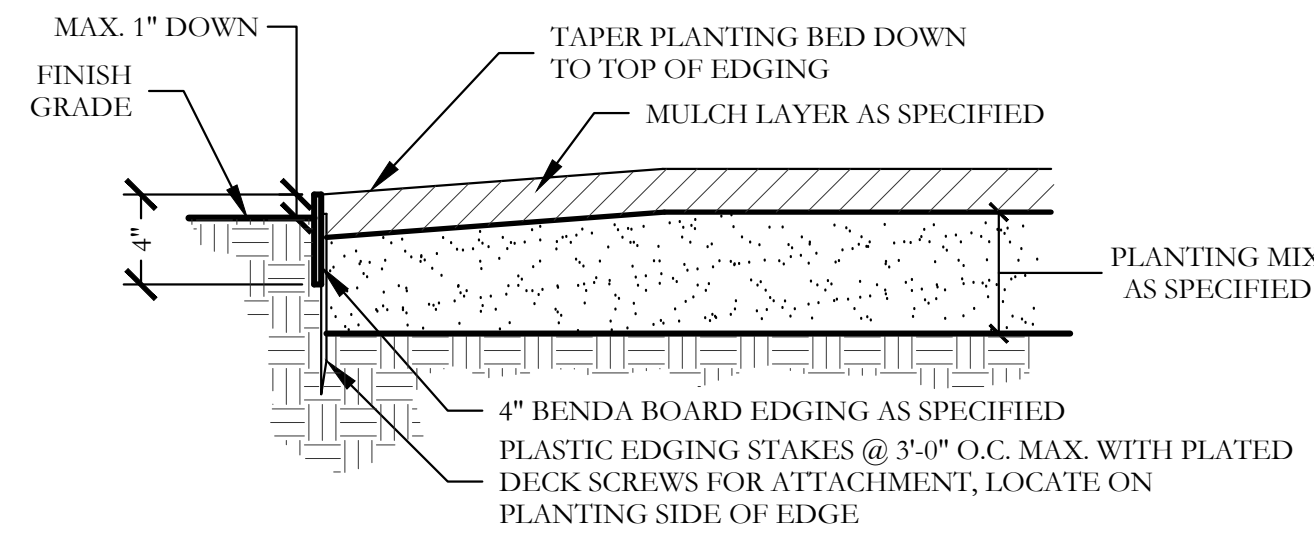

1 TYPICAL BED EDGING DETAIL SECTION NOT TO SCALE

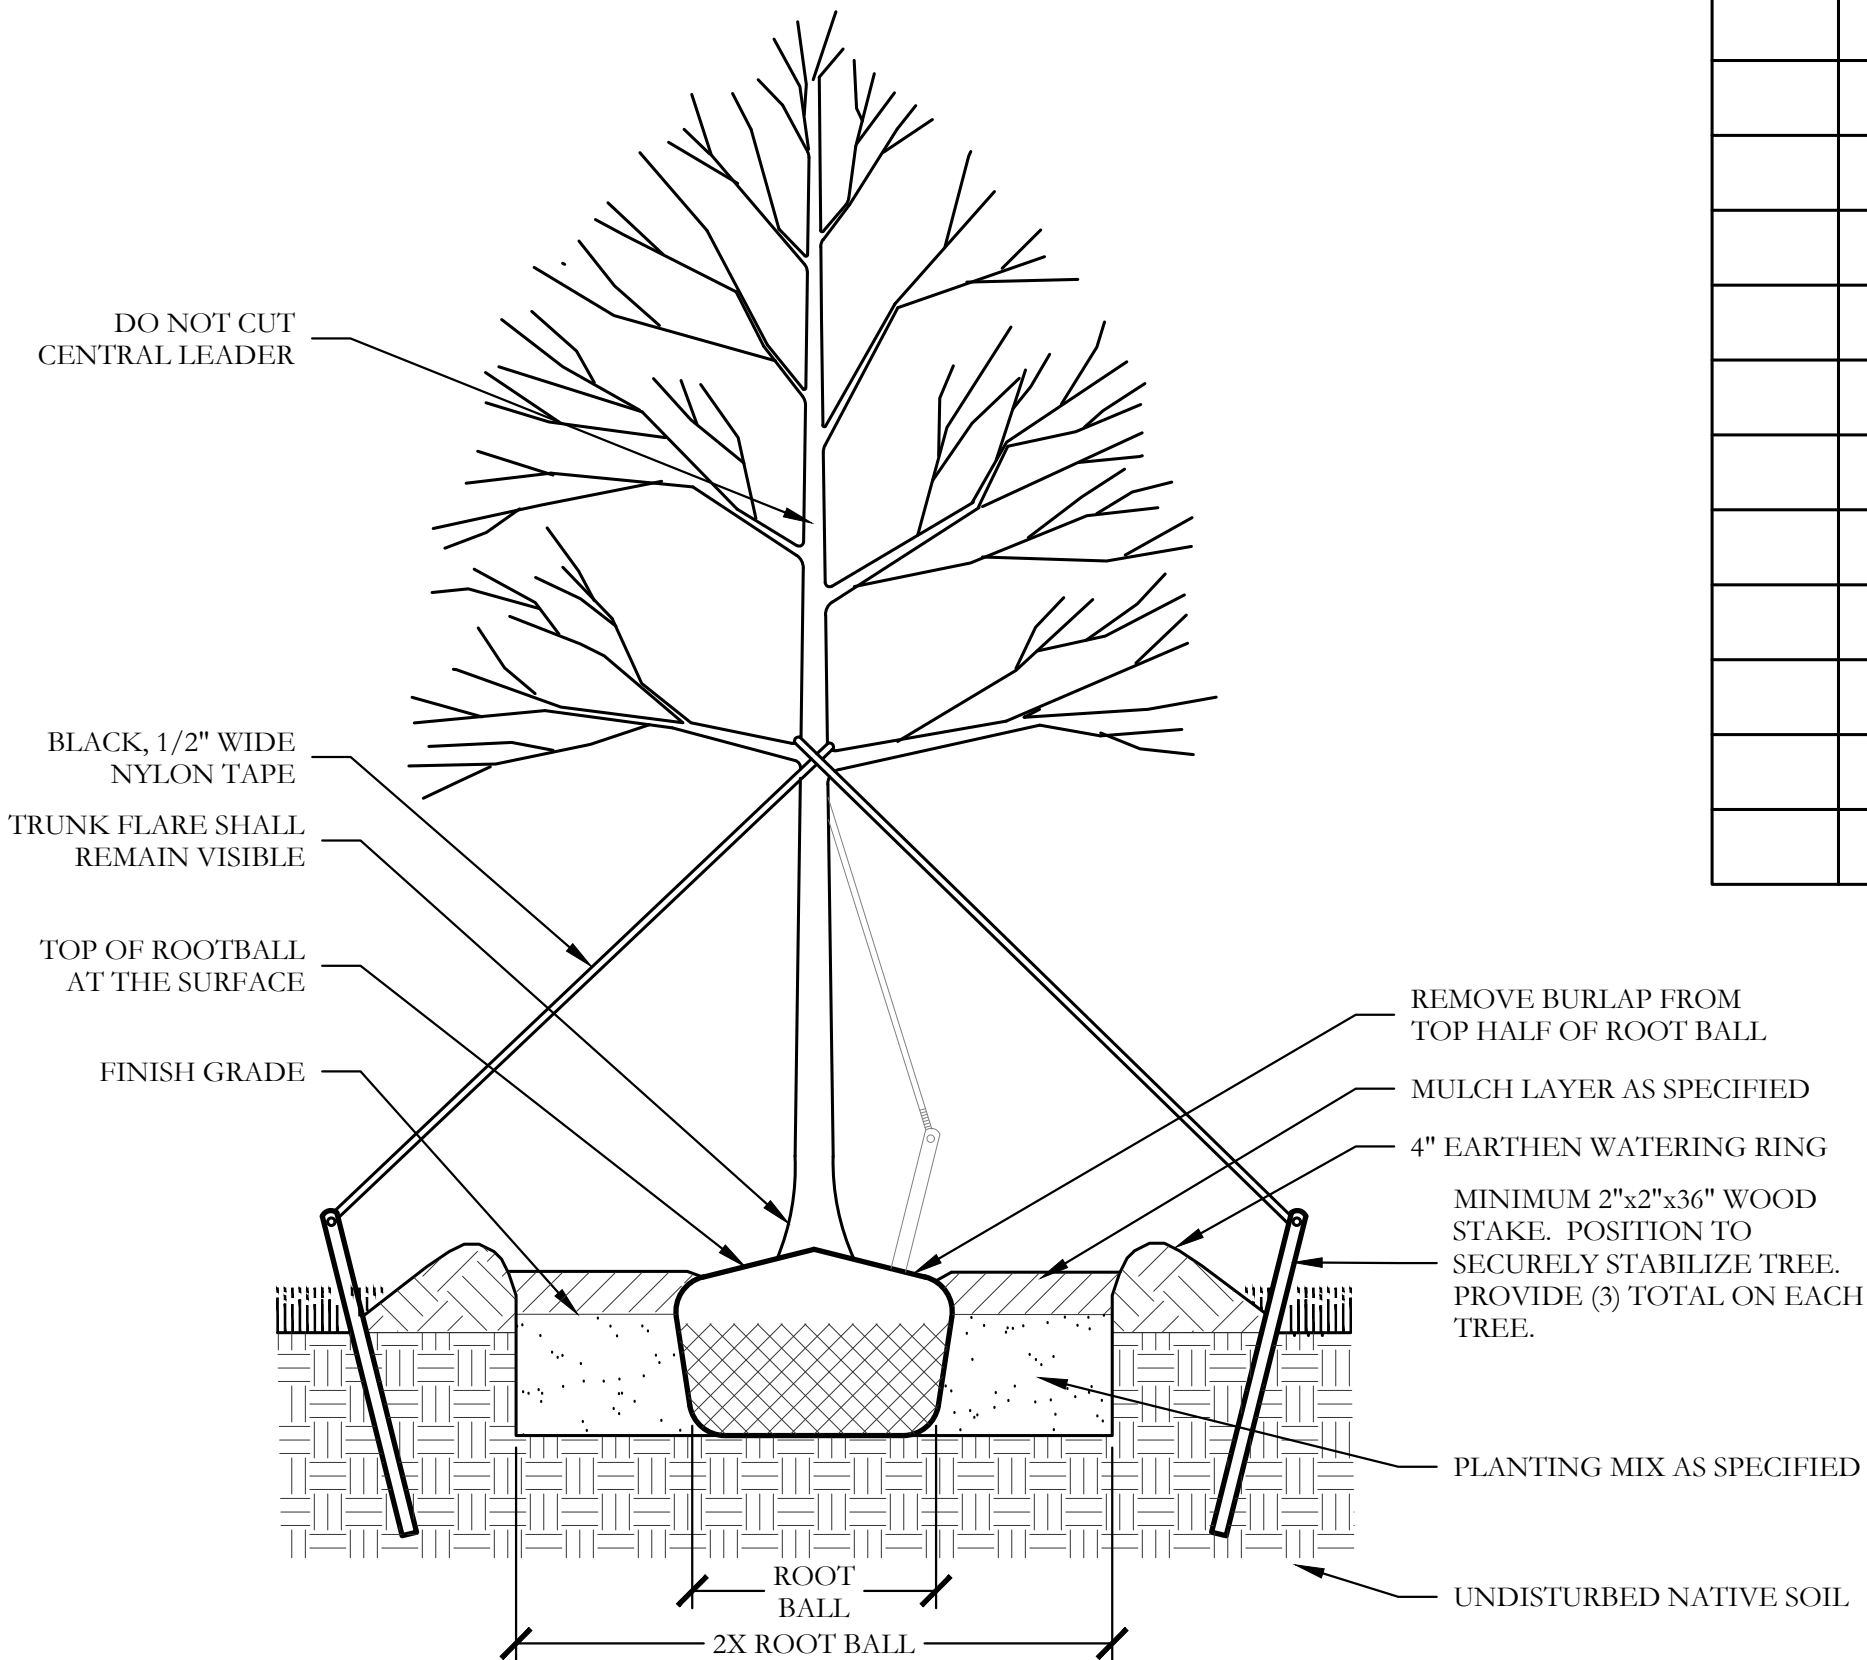

2 TYPICAL TREE PLANTING SECTION NOT TO SCALE

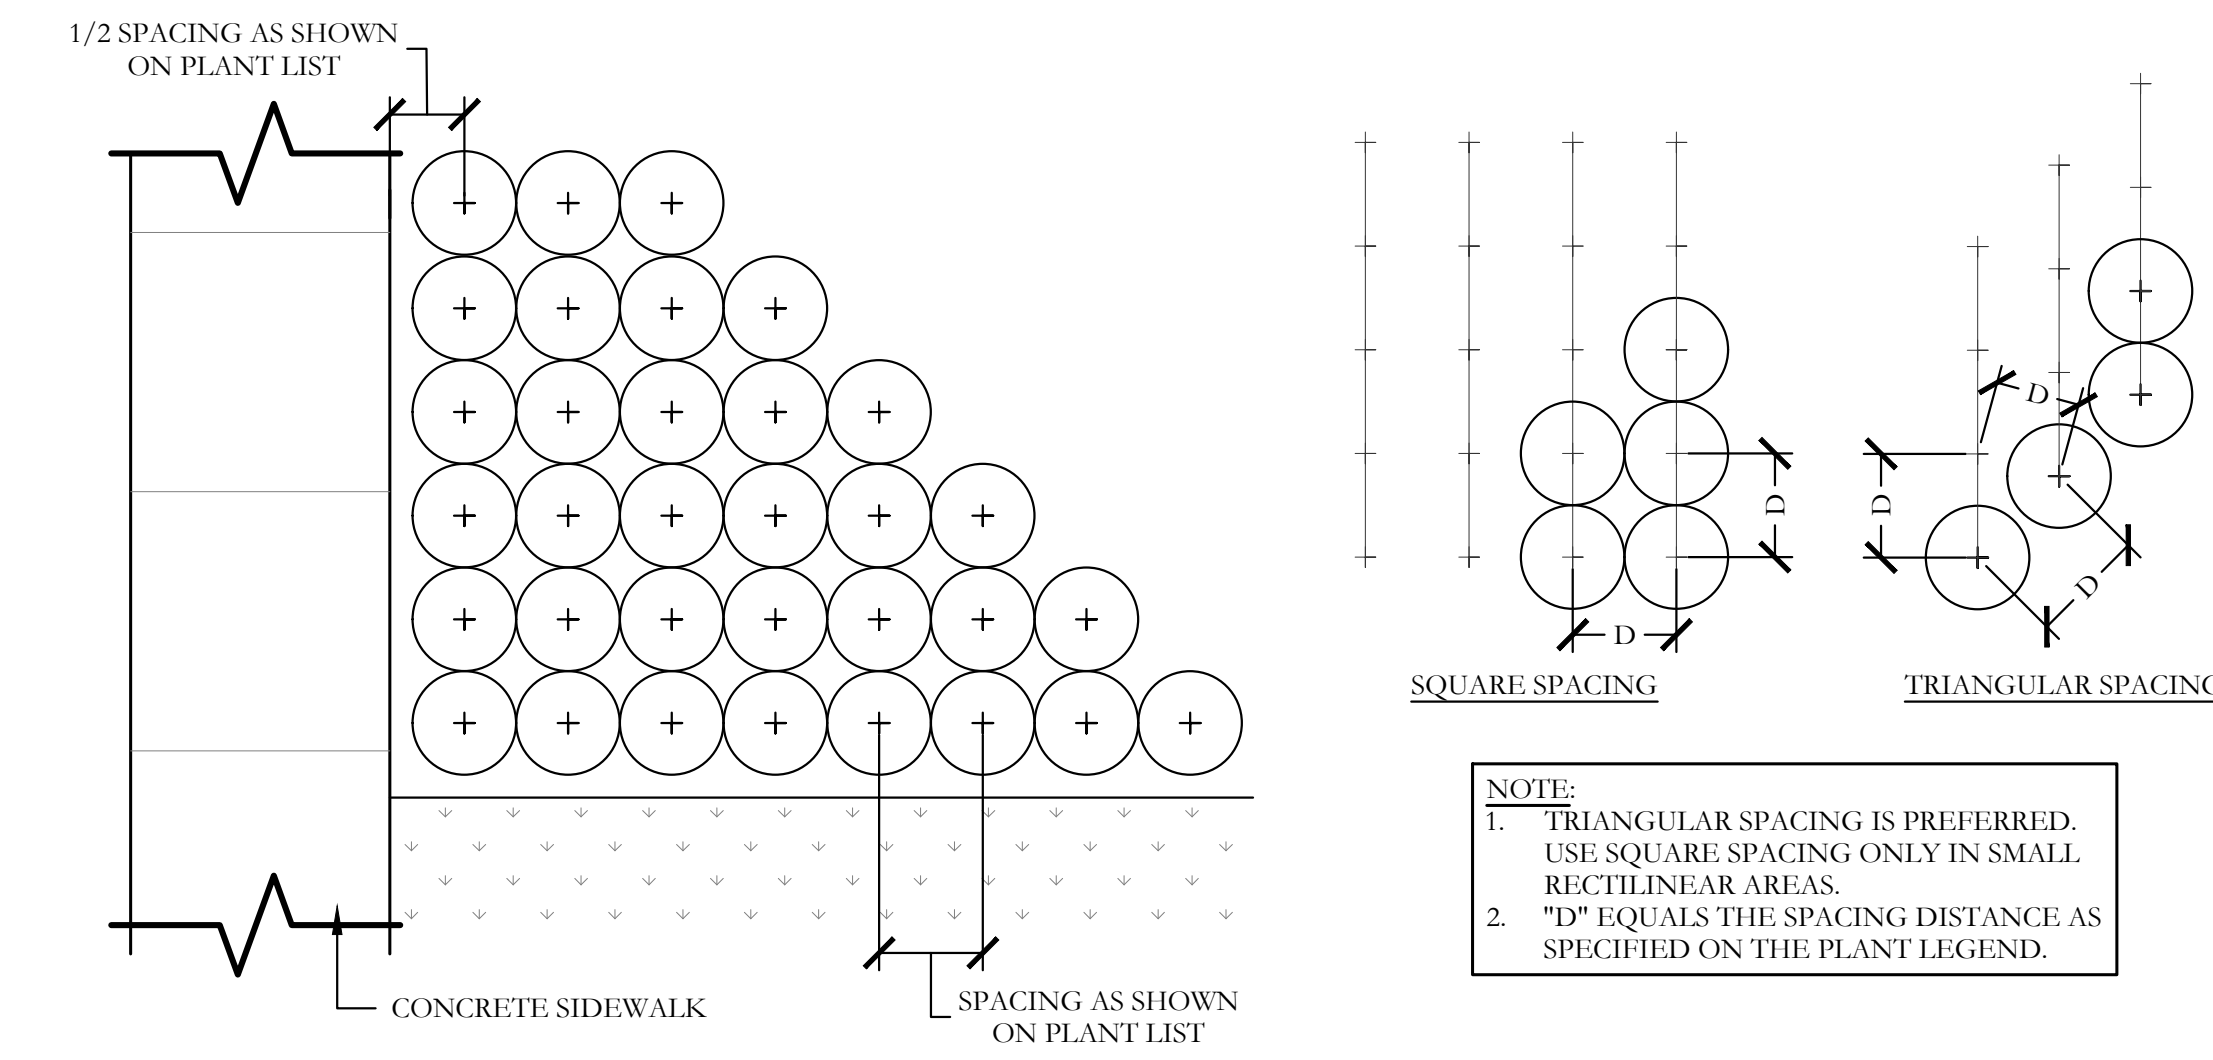

3 TYPICAL SHRUB AND GROUNDCOVER PLANTING PLAN/SECTION NOT TO SCALE

PLANT LIST						
KEY	ESTIMATED QUANTITY	COMMON NAME	SCIENTIFIC NAME	SIZE	SPACING	REMARKS
LO	9	LIVE OAK	QUERCUS VIRGINIANA	4" CALIPER	AS SHOWN	NURSERY GROWN; FULL HEAD; MINIMUM BRANCHING HEIGHT AT 6'-0"; MINIMUM 10'-0" OVERALL HEIGHT.
BO	7	BUR OAK	QUERCUS MACROCARPA	4" CALIPER	AS SHOWN	NURSERY GROWN; FULL HEAD; MINIMUM BRANCHING HEIGHT AT 6'-0"; MINIMUM 10'-0" OVERALL HEIGHT.
LE	10	LACEBARK ELM	ULMUS PARVIFOLIA	4" CALIPER	AS SHOWN	NURSERY GROWN; FULL HEAD; MINIMUM BRANCHING HEIGHT AT 6'-0"; MINIMUM 10'-0" OVERALL HEIGHT.
CE	6	CEDAR ELM	ULMUS CRASSIFOLIA	4" CALIPER	AS SHOWN	NURSERY GROWN; FULL HEAD; MINIMUM BRANCHING HEIGHT AT 6'-0"; MINIMUM 10'-0" OVERALL HEIGHT.
LGM	3	LITTLE GEM MAGNOLIA	MAGNOLIA GRANDIFLORA 'LITTLE GEM'	2" CALIPER	AS SHOWN	NURSERY GROWN; FULL HEAD; MINIMUM 8'-0" OVERALL HEIGHT.
DW	4	DESERT WILLOW	CHILOPSIS LINEARIS	2" CALIPER	AS SHOWN	NURSERY GROWN; FULL HEAD; MINIMUM 8'-0" OVERALL HEIGHT.
YH	8	YAUPON HOLLY	ILEX VOMITORIA	2" CALIPER	AS SHOWN	NURSERY GROWN; FULL HEAD; MINIMUM 8'-0" OVERALL HEIGHT.
RB	6	TEXAS REDBUD	CERCIS CANADENSIS VAR. TEXENSIS	2" CALIPER	AS SHOWN	NURSERY GROWN; FULL HEAD; MINIMUM 8'-0" OVERALL HEIGHT.
	21	PURPLE DIAMOND LOROPETALUM	LOROPETALUM CHINENSIS 'PURPLE DIAMOND'	7 GALLON	48" O.C.	CONTAINER GROWN; FULL PLANT.
	74	TEXAS SAGE	LEUCOPHYLLUM FRUTESCENS	7 GALLON	48" O.C.	CONTAINER GROWN; FULL PLANT.
	67	GLOSSY ABELIA	LINNAEA X GRANDIFLORA	7 GALLON	36" O.C.	CONTAINER GROWN; FULL PLANT.
	42	DWARF BURFORD HOLLY	ILEX CORNUTA 'DWARF BURFORD'	7 GALLON	36" O.C.	CONTAINER GROWN; FULL PLANT.
	6	UPRIGHT ROSEMARY	ROSMARINUS OFFICINALIS 'UPRIGHT'	3 GALLON	36" O.C.	CONTAINER GROWN; FULL PLANT.
	6	DWARF MAIDEN GRASS	MISCANTHUS SINENSIS ADAGIO'	3 GALLON	36" O.C.	CONTAINER GROWN; FULL PLANT.
	10	MORNING LIGHT MISCANTHUS	MISCANTHUS SINENSIS 'MORNING LIGHT'	3 GALLON	36" O.C.	CONTAINER GROWN; FULL PLANT.
	21	RED YUCCA	HESPERALOE PARVIFLORA	3 GALLON	36" O.C.	CONTAINER GROWN; FULL PLANT.
	70	PLUM YEW PROSTRATA	CEPHALOTAXUS HARRINGTONIA 'PROSTRATA'	3 GALLON	48" O.C.	CONTAINER GROWN; FULL PLANT.
	825	LIRIOPE GRASS	LIRIOPE MUSCARI	1 GALLON	18" O.C.	CONTAINER GROWN; FULL PLANT.
	85	MEXICAN FEATHER GRASS	NASSELLA TENUISSIMA	1 GALLON	18" O.C.	CONTAINER GROWN; FULL PLANT.
	825	ANNUAL COLOR	TO BE SELECTED BY OWNER	4" POT	8" O.C.	CONTAINER GROWN; FULL PLANT.
	50,135	COMMON BERMUDA GRASS	CYNODON DACTYLON	SQUARE FEET	SOLID SOD	MINIMUM 100% COVERAGE ALL AREAS SHOWN

GENERAL LANDSCAPE NOTES

- INSPECTIONS:**
- NO EXCAVATION SHALL OCCUR IN CITY R.O.W. WITHOUT A R.O.W. PERMIT--CONTACT THE PUBLIC WORKS DEPARTMENT.
 - THE CONTRACTOR SHALL MARK ALL WATER LINES, SEWER LINES, AND TREE LOCATIONS PRIOR TO CALLING FOR ROW INSPECTION AND PERMIT.
 - THE LANDSCAPE INSTALLATION SHALL COMPLY WITH APPROVED LANDSCAPE DRAWINGS PRIOR TO FINAL ACCEPTANCE BY THE CITY AND ISSUANCE OF A CERTIFICATE OF OCCUPANCY.
 - WATER METERS, CLEANOUTS AND OTHER APPURTENANCES, SHALL BE ACCESSIBLE, ADJUSTED TO GRADE, CLEARLY MARKED WITH FLAGGING AND COMPLIANT WITH PUBLIC WORKS DEPARTMENT STANDARDS PRIOR TO CALLING FOR FINAL LANDSCAPE AND ROW INSPECTIONS.

- LANDSCAPE STANDARDS:**
- PLANTINGS AND LANDSCAPE ELEMENTS SHALL COMPLY WITH THE CITY'S ENGINEERING DESIGN STANDARDS, PUBLIC R.O.W. VISIBILITY REQUIREMENTS.
 - UNLESS OTHERWISE SPECIFIED, TREES SHALL BE PLANTED NO LESS THAN 4' FROM CURBS, SIDEWALKS, UTILITY LINES, SCREENING WALLS AND OTHER STRUCTURES. THE CITY HAS FINAL APPROVAL FOR ALL TREE PLACEMENTS.
 - A MINIMUM THREE FEET (3') RADIUS AROUND A FIRE HYDRANT MUST REMAIN CLEAR OF LANDSCAPE PURSUANT TO THE FIRE CODE.
 - STREET TREES, WHERE REQUIRED, SHALL BE (10') MINIMUM FROM THE EDGE OF A STORM SEWER CURB INLET BOX AND THE EDGE OF THE ROOT BALL SHALL BE (4') MINIMUM FROM THE WATER METER.
 - THE AMERICAN STANDARD FOR NURSERY STOCK (ANSI Z60.1-2004) SPECIFICATIONS SHALL GOVERN PLANT QUALIFICATIONS, GRADES, AND STANDARDS.
 - TREE PLANTING SHALL COMPLY WITH DETAILS HEREIN AND THE INTERNATIONAL SOCIETY OF ARBORICULTURE (ISA) STANDARDS.
 - A 2-3" LAYER OF MULCH SHALL BE PROVIDED AROUND THE BASE OF THE PLANTED TREE. THE MULCH SHALL BE PULLED BACK 4" FROM THE TRUNK OF THE TREE.
 - TREE PITS SHALL BE TESTED FOR WATER PERCOLATION. IF WATER DOES NOT DRAIN OUT OF TREE PIT WITHIN 24-HOURS, THE TREE SHALL BE MOVED OR DRAINAGE SHALL BE PROVIDED.
 - ALL BEDS TO HAVE 3" OF COMPOSTED SOIL, LIVING EARTH TECHNOLOGY, OR APPROVED EQUAL TILLED AND TURNED TO A DEPTH OF 8" MINIMUM.
 - ALL PLANT BEDS SHALL BE TOP-DRESSED WITH A MINIMUM OF 3 INCHES OF HARDWOOD MULCH.
 - NATIVE SITE TOPSOILS TO BE PROTECTED FROM EROSION OR STOCKPILED. NATIVE SITE TOPSOIL SHALL BE LABORATORY TESTED BY AN ACCREDITED LABORATORY AND AMENDED PER SAID LABORATORY'S RECOMMENDATIONS.

- IRRIGATION STANDARDS:**
- ANY CHANGES TO THESE APPROVED IRRIGATION DRAWINGS SHALL BE AUTHORIZED BY THE CITY.
 - CONTACT DEVELOPMENT SERVICES FOR AN IRRIGATION PERMIT PRIOR TO INSTALLING THE IRRIGATION SYSTEM.
 - IRRIGATION OVER-SPRAY ON STREETS AND WALKS IS PROHIBITED.
 - MAINLINES, VALVES, OR CONTROL WIRES SHALL NOT BE LOCATED IN THE CITY'S ROW.
 - ET IRRIGATION CONTROLLERS SHALL BE PROGRAMMED AND ADJUSTED TO NOT EXCEED THE LANDSCAPE WATER ALLOWANCE (LWA) PRIOR TO APPROVAL OF LANDSCAPE INSTALLATION.
 - VALVES SHALL BE LOCATED A MINIMUM OF (5') AWAY FROM STORM SEWERS, AND SANITARY SEWER LINES AND 5 FEET FROM CITY FIRE HYDRANTS AND WATER VALVES.
 - THE BORE DEPTH UNDER STREETS, DRIVE AISLES, AND FIRE LANES SHALL PROVIDE (2') OF CLEARANCE (MINIMUM).
 - IRRIGATION HEADS THAT RUN PARALLEL AND NEAR PUBLIC WATER AND SANITARY SEWER LINES; SHALL BE FED FROM STUBBED LATERALS OR BULL-BEADS. A MINIMUM FIVE FOOT (5') SEPARATION IS REQUIRED BETWEEN IRRIGATION MAIN LINES AND LATERALS THAT RUN PARALLEL TO PUBLIC WATER AND SANITARY SEWER LINES.
 - NO VALVES, BACKFLOW PREVENTION ASSEMBLIES, QUICK COUPLERS ETC. SHALL BE LOCATED CLOSER THAN 10' FROM THE CURB AT STREET OR DRIVE INTERSECTION.

- MAINTENANCE STANDARDS:**
- THE OWNER SHALL BE RESPONSIBLE FOR THE ESTABLISHMENT, MAINTENANCE, AND VIGOR OF PLANT MATERIAL IN ACCORDANCE WITH THE DESIGN INTENT AND AS APPROPRIATE FOR THE SEASON OF THE YEAR.
 - LANDSCAPE AND OPEN AREAS SHALL BE FREE OF TRASH, LITTER AND WEEDS.
 - NO PLANT MATERIAL SHALL BE ALLOWED TO ENCRUSH ON R.O.W., SIDEWALKS OR EASEMENTS TO THE EXTENT THAT VISION OR ROUTE OF TRAVEL FOR VEHICULAR, PEDESTRIAN, OR BICYCLE TRAFFIC IS IMPEDED.
 - TREE MAINTENANCE SHALL BE IN ACCORDANCE WITH THE STANDARDS OF THE INTERNATIONAL SOCIETY OF ARBORICULTURE.
 - TREE STAKING MATERIALS, IF USED, SHALL BE REMOVED AFTER (1) GROWING SEASON, NO MORE THAN (1) YEAR AFTER INSTALLATION (STEEL TREE STAKES, WIRES, AND HOSES ARE PROHIBITED).

- TREE PROTECTION NOTES:**
- CONTACT DEVELOPMENT SERVICES FOR A TREE REMOVAL PERMIT PRIOR TO REMOVAL OR TRANSPLANTING OF ANY TREES.
 - ALL TREES WHICH ARE TO REMAIN ON SITE SHALL BE PROTECTED WITH A (4') TALL BRIGHTLY COLORED PLASTIC FENCE, OR SILT FENCE, PLACED AT THE DRIP LINE OF THE TREES.
 - PRIOR TO THE PRE-CONSTRUCTION MEETING OR OBTAINING A GRADING PERMIT, ALL TREE MARKINGS AND PROTECTIVE FENCING SHALL BE INSTALLED BY THE OWNER AND BE INSPECTED BY DEVELOPMENT SERVICES.
 - NO EQUIPMENT SHALL BE CLEANED, OR HARMFUL LIQUIDS DEPOSITED WITHIN THE LIMITS OF THE ROOT ZONE OF TREES WHICH REMAIN ON SITE.
 - NO SIGNS, WIRES, OR OTHER ATTACHMENTS SHALL BE ATTACHED TO ANY TREE TO REMAIN ON SITE.
 - VEHICULAR AND CONSTRUCTION EQUIPMENT SHALL NOT PARK OR DRIVE WITHIN THE LIMITS OF THE DRIP LINE.
 - GRADE CHANGES IN EXCESS OF 3 INCHES (CUT OR FILL) SHALL NOT BE ALLOWED WITHIN A ROOT ZONE, UNLESS ADEQUATE TREE PRESERVATION METHODS ARE APPROVED BY THE CITY.
 - NO TRENCHING SHALL BE ALLOWED WITHIN THE DRIP-LINE OF A TREE, UNLESS APPROVED BY THE CITY.
 - ALL REMOVED TREES SHALL BE CHIPPED AND USED FOR MULCH ON SITE OR HAULED OFF-SITE.
 - ALL TREE MAINTENANCE TECHNIQUES SHALL BE IN CONFORMANCE WITH INDUSTRY IDENTIFIED STANDARDS. IMPROPER OR MALICIOUS PRUNING TECHNIQUES ARE STRICTLY PROHIBITED.

ALL RESPONSIBILITY FOR ADEQUACY OF DESIGN REMAINS WITH THE DESIGN ENGINEER. THE CITY OF ROCKWALL, IN REVIEWING AND RELEASING PLANS FOR CONSTRUCTION, ASSUMES NO RESPONSIBILITY FOR ADEQUACY OR ACCURACY OF DESIGN.

APPROVED:
I hereby certify that the above and foregoing site plan for a development in the City of Rockwall, Texas, was approved by the Planning & Zoning Commission of the City of Rockwall on the [DAY] day of [MONTH], [YEAR].

WITNESS OUR HANDS, this [DAY] day of [MONTH], [YEAR].

Planning & Zoning Commission, Chairman

Director of Planning and Zoning



JOHNSON VOLK CONSULTING

704 Central Parkway East | Suite 1200 | Plano, Texas 75074 | 972.201.3100

Planning and Zoning Department
City of Rockwall – Planning and Zoning Department
385 S. Goliad Street
Rockwall, Texas 75087

November 13, 2023

Tree Survey Affidavit

Nelson Lake Estates, Phase 1, Amenity Center
City of Rockwall, Rockwall County, Texas

To Whom it May Concern,

After an extensive field investigation and tree inventory, we have determined that no protected trees exist on site for this development. Because of this, we have not prepared tree survey plans, checklists, and applicable plans for tree survey, mitigation, and/or tree preservation per the City of Rockwall Ordinance.

If you have any questions or concerns, please let me know.

Sincerely,

Cody Johnson, RLA, ASLA, LI
Johnson Volk Consulting
407 Central Parkway East
Suite 1200
Plano, Texas 75074



CITY OF ROCKWALL

PLANNING AND ZONING COMMISSION MEMORANDUM

PLANNING AND ZONING DEPARTMENT

385 S. GOLIAD STREET • ROCKWALL, TX 75087

PHONE: (972) 771-7745 • EMAIL: PLANNING@ROCKWALL.COM

TO: Planning and Zoning Commission
FROM: Henry Lee, *Senior Planner*
DATE: December 12, 2023
SUBJECT: SP2023-046; *PD Site Plan for the Homestead Subdivision Amenity Center*

The applicant, Cody Johnson of Johnson Volk Consulting, is requesting the approval of a site plan for the amenity center within the Homestead Subdivision. The Homestead Subdivision is situated on a 196.009-acre tract of land (i.e. *Tract 6 of the J. A. Ramsey Survey, Abstract No. 186*) that is generally located at the northeast corner of the intersection of FM-549 and FM-1139. Phase 1 of the Homestead Subdivision was approved for a *Final Plat [Case No. P2022-055]* and a *PD Site Plan [Case No. SP2022-048]* in accordance with the submittal schedule contained in the Planned Development District ordinance. As part of this site plan application, the applicant has submitted a site plan, landscape plan, hardscape plan, photometric plan, and building elevations for the proposed amenity center.

The site plan submitted by the applicant indicates that a pavilion with restrooms, swimming pool, and parking lot will be constructed on the subject property. The landscape plan shows that all of the required landscaping as stipulated by the Planned Development District ordinance will be provided, and that the pool equipment will be screened in accordance with the requirements of Article 08, *Landscape and Fence Standards*, of the Unified Development Code (UDC). The hardscape plan details the location of all sidewalks and trails, the pool, and each fence types associated with the development. The submitted site plan, landscape plan, hardscape plan, photometric plan, and building elevations all conform to the applicable technical requirements contained in Planned Development District 92 (PD-92) and the Unified Development Code (UDC). Since the proposed site plan conforms to the technical requirements, this case is being placed on the consent agenda. Should the Planning and Zoning Commission have any questions concerning the applicant's request, staff and the applicant will be available at the December 12, 2023 Planning and Zoning Commission meeting.



DEVELOPMENT APPLICATION

City of Rockwall
Planning and Zoning Department
385 S. Goliad Street
Rockwall, Texas 75087

STAFF USE ONLY

PLANNING & ZONING CASE NO. _____

NOTE: THE APPLICATION IS NOT CONSIDERED ACCEPTED BY THE CITY UNTIL THE PLANNING DIRECTOR AND CITY ENGINEER HAVE SIGNED BELOW.

DIRECTOR OF PLANNING: _____

CITY ENGINEER: _____

PLEASE CHECK THE APPROPRIATE BOX BELOW TO INDICATE THE TYPE OF DEVELOPMENT REQUEST [SELECT ONLY ONE BOX]:

<p>PLATTING APPLICATION FEES:</p> <p><input type="checkbox"/> MASTER PLAT (\$100.00 + \$15.00 ACRE)¹</p> <p><input type="checkbox"/> PRELIMINARY PLAT (\$200.00 + \$15.00 ACRE)¹</p> <p><input type="checkbox"/> FINAL PLAT (\$300.00 + \$20.00 ACRE)¹</p> <p><input type="checkbox"/> REPLAT (\$300.00 + \$20.00 ACRE)¹</p> <p><input type="checkbox"/> AMENDING OR MINOR PLAT (\$150.00)</p> <p><input type="checkbox"/> PLAT REINSTATEMENT REQUEST (\$100.00)</p> <p>SITE PLAN APPLICATION FEES:</p> <p><input checked="" type="checkbox"/> SITE PLAN (\$250.00 + \$20.00 ACRE)¹</p> <p><input checked="" type="checkbox"/> AMENDED SITE PLAN/ELEVATIONS/LANDSCAPING PLAN (\$100.00)</p>	<p>ZONING APPLICATION FEES:</p> <p><input type="checkbox"/> ZONING CHANGE (\$200.00 + \$15.00 ACRE)¹</p> <p><input type="checkbox"/> SPECIFIC USE PERMIT (\$200.00 + \$15.00 ACRE)^{1&2}</p> <p><input type="checkbox"/> PD DEVELOPMENT PLANS (\$200.00 + \$15.00 ACRE)¹</p> <p>OTHER APPLICATION FEES:</p> <p><input type="checkbox"/> TREE REMOVAL (\$75.00)</p> <p><input type="checkbox"/> VARIANCE REQUEST/SPECIAL EXCEPTIONS (\$100.00)²</p> <p>NOTES:</p> <p>¹: IN DETERMINING THE FEE, PLEASE USE THE EXACT ACREAGE WHEN MULTIPLYING BY THE PER ACRE AMOUNT. FOR REQUESTS ON LESS THAN ONE ACRE, ROUND UP TO ONE (1) ACRE.</p> <p>²: A \$1,000.00 FEE WILL BE ADDED TO THE APPLICATION FEE FOR ANY REQUEST THAT INVOLVES CONSTRUCTION WITHOUT OR NOT IN COMPLIANCE TO AN APPROVED BUILDING PERMIT.</p>
--	--

PROPERTY INFORMATION [PLEASE PRINT]

ADDRESS: Amenity Center within Homestead

SUBDIVISION: Homestead LOT: 9 BLOCK: F

GENERAL LOCATION: Corner of Fisher Road and Hardin Boulevard

ZONING, SITE PLAN AND PLATTING INFORMATION [PLEASE PRINT]

CURRENT ZONING	Single Family Residential	CURRENT USE	Private Recreation Center
PROPOSED ZONING	Single Family Residential	PROPOSED USE	Private Recreation Center
ACREAGE	1.60	LOTS [CURRENT]	1
		LOTS [PROPOSED]	1

SITE PLANS AND PLATS: BY CHECKING THIS BOX YOU ACKNOWLEDGE THAT DUE TO THE PASSAGE OF HB3167 THE CITY NO LONGER HAS FLEXIBILITY WITH REGARD TO ITS APPROVAL PROCESS, AND FAILURE TO ADDRESS ANY OF STAFF'S COMMENTS BY THE DATE PROVIDED ON THE DEVELOPMENT CALENDAR WILL RESULT IN THE DENIAL OF YOUR CASE.

OWNER/APPLICANT/AGENT INFORMATION [PLEASE PRINT/CHECK THE PRIMARY CONTACT/ORIGINAL SIGNATURES ARE REQUIRED]

<input type="checkbox"/> OWNER	SH DEV KLUTTS ROCKWALL LLC	<input checked="" type="checkbox"/> APPLICANT	Johnson Volk Consulting
CONTACT PERSON	Stephen Pepper	CONTACT PERSON	Cody Johnson
ADDRESS	2400 Dallas Parkway Suite 460	ADDRESS	704 Central Parkway East Suite 1200
CITY, STATE & ZIP	Plano, Texas 75093	CITY, STATE & ZIP	Plano, Texas 75074
PHONE	972-526-7700	PHONE	972-201-3100
E-MAIL	stephen.pepper@shaddockhomes.com	E-MAIL	cody.johnson@johnsonvolk.com

NOTARY VERIFICATION [REQUIRED]

BEFORE ME, THE UNDERSIGNED AUTHORITY, ON THIS DAY PERSONALLY APPEARED Stephen Pepper [OWNER] THE UNDERSIGNED, WHO STATED THE INFORMATION ON THIS APPLICATION TO BE TRUE AND CERTIFIED THE FOLLOWING:

"I HEREBY CERTIFY THAT I AM THE OWNER FOR THE PURPOSE OF THIS APPLICATION; ALL INFORMATION SUBMITTED HEREIN IS TRUE AND CORRECT; AND THE APPLICATION FEE OF \$ 382.00 TO COVER THE COST OF THIS APPLICATION, HAS BEEN PAID TO THE CITY OF ROCKWALL ON THIS THE 13th DAY OF November, 2023 BY SIGNING THIS APPLICATION. I AGREE THAT THE CITY OF ROCKWALL (I.E. "CITY") IS AUTHORIZED AND PERMITTED TO PROVIDE INFORMATION CONTAINED WITHIN THIS APPLICATION TO THE PUBLIC. THE CITY IS ALSO AUTHORIZED AND PERMITTED TO REPRODUCE ANY COPYRIGHTED INFORMATION SUBMITTED IN CONJUNCTION WITH THIS APPLICATION, IF SUCH REPRODUCTION IS ASSOCIATED OR IN RESPONSE TO A REQUEST FOR PUBLIC INFORMATION."


GIVEN UNDER MY HAND AND SEAL OF OFFICE ON THIS THE 13th DAY OF November, 2023

OWNER'S SIGNATURE

Stephen Pepper

NOTARY PUBLIC IN AND FOR THE STATE OF TEXAS

Deanna Walker

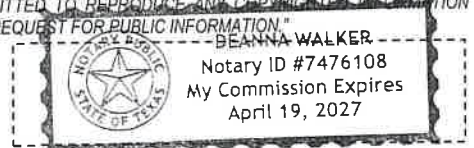

MY COMMISSION EXPIRES

PD-67

Feet

0 230 460 920 1,380 1,840

SP2023-046: Site Plan for Amenity Center within Homestead

AG

549

SFE-4

STEM 549

PD-92

PD-63

SFE-2

AG

1139

BM 1139

C

Case Location Map = 




City of Rockwall

Planning & Zoning Department
385 S. Goliad Street
Rockwall, Texas 75087
(P): (972) 771-7745
(W): www.rockwall.com

The City of Rockwall GIS maps are continually under development and therefore subject to change without notice. While we endeavor to provide timely and accurate information, we make no guarantees. The City of Rockwall makes no warranty, express or implied, including warranties of merchantability and fitness for a particular purpose. Use of the information is the sole responsibility of the user.



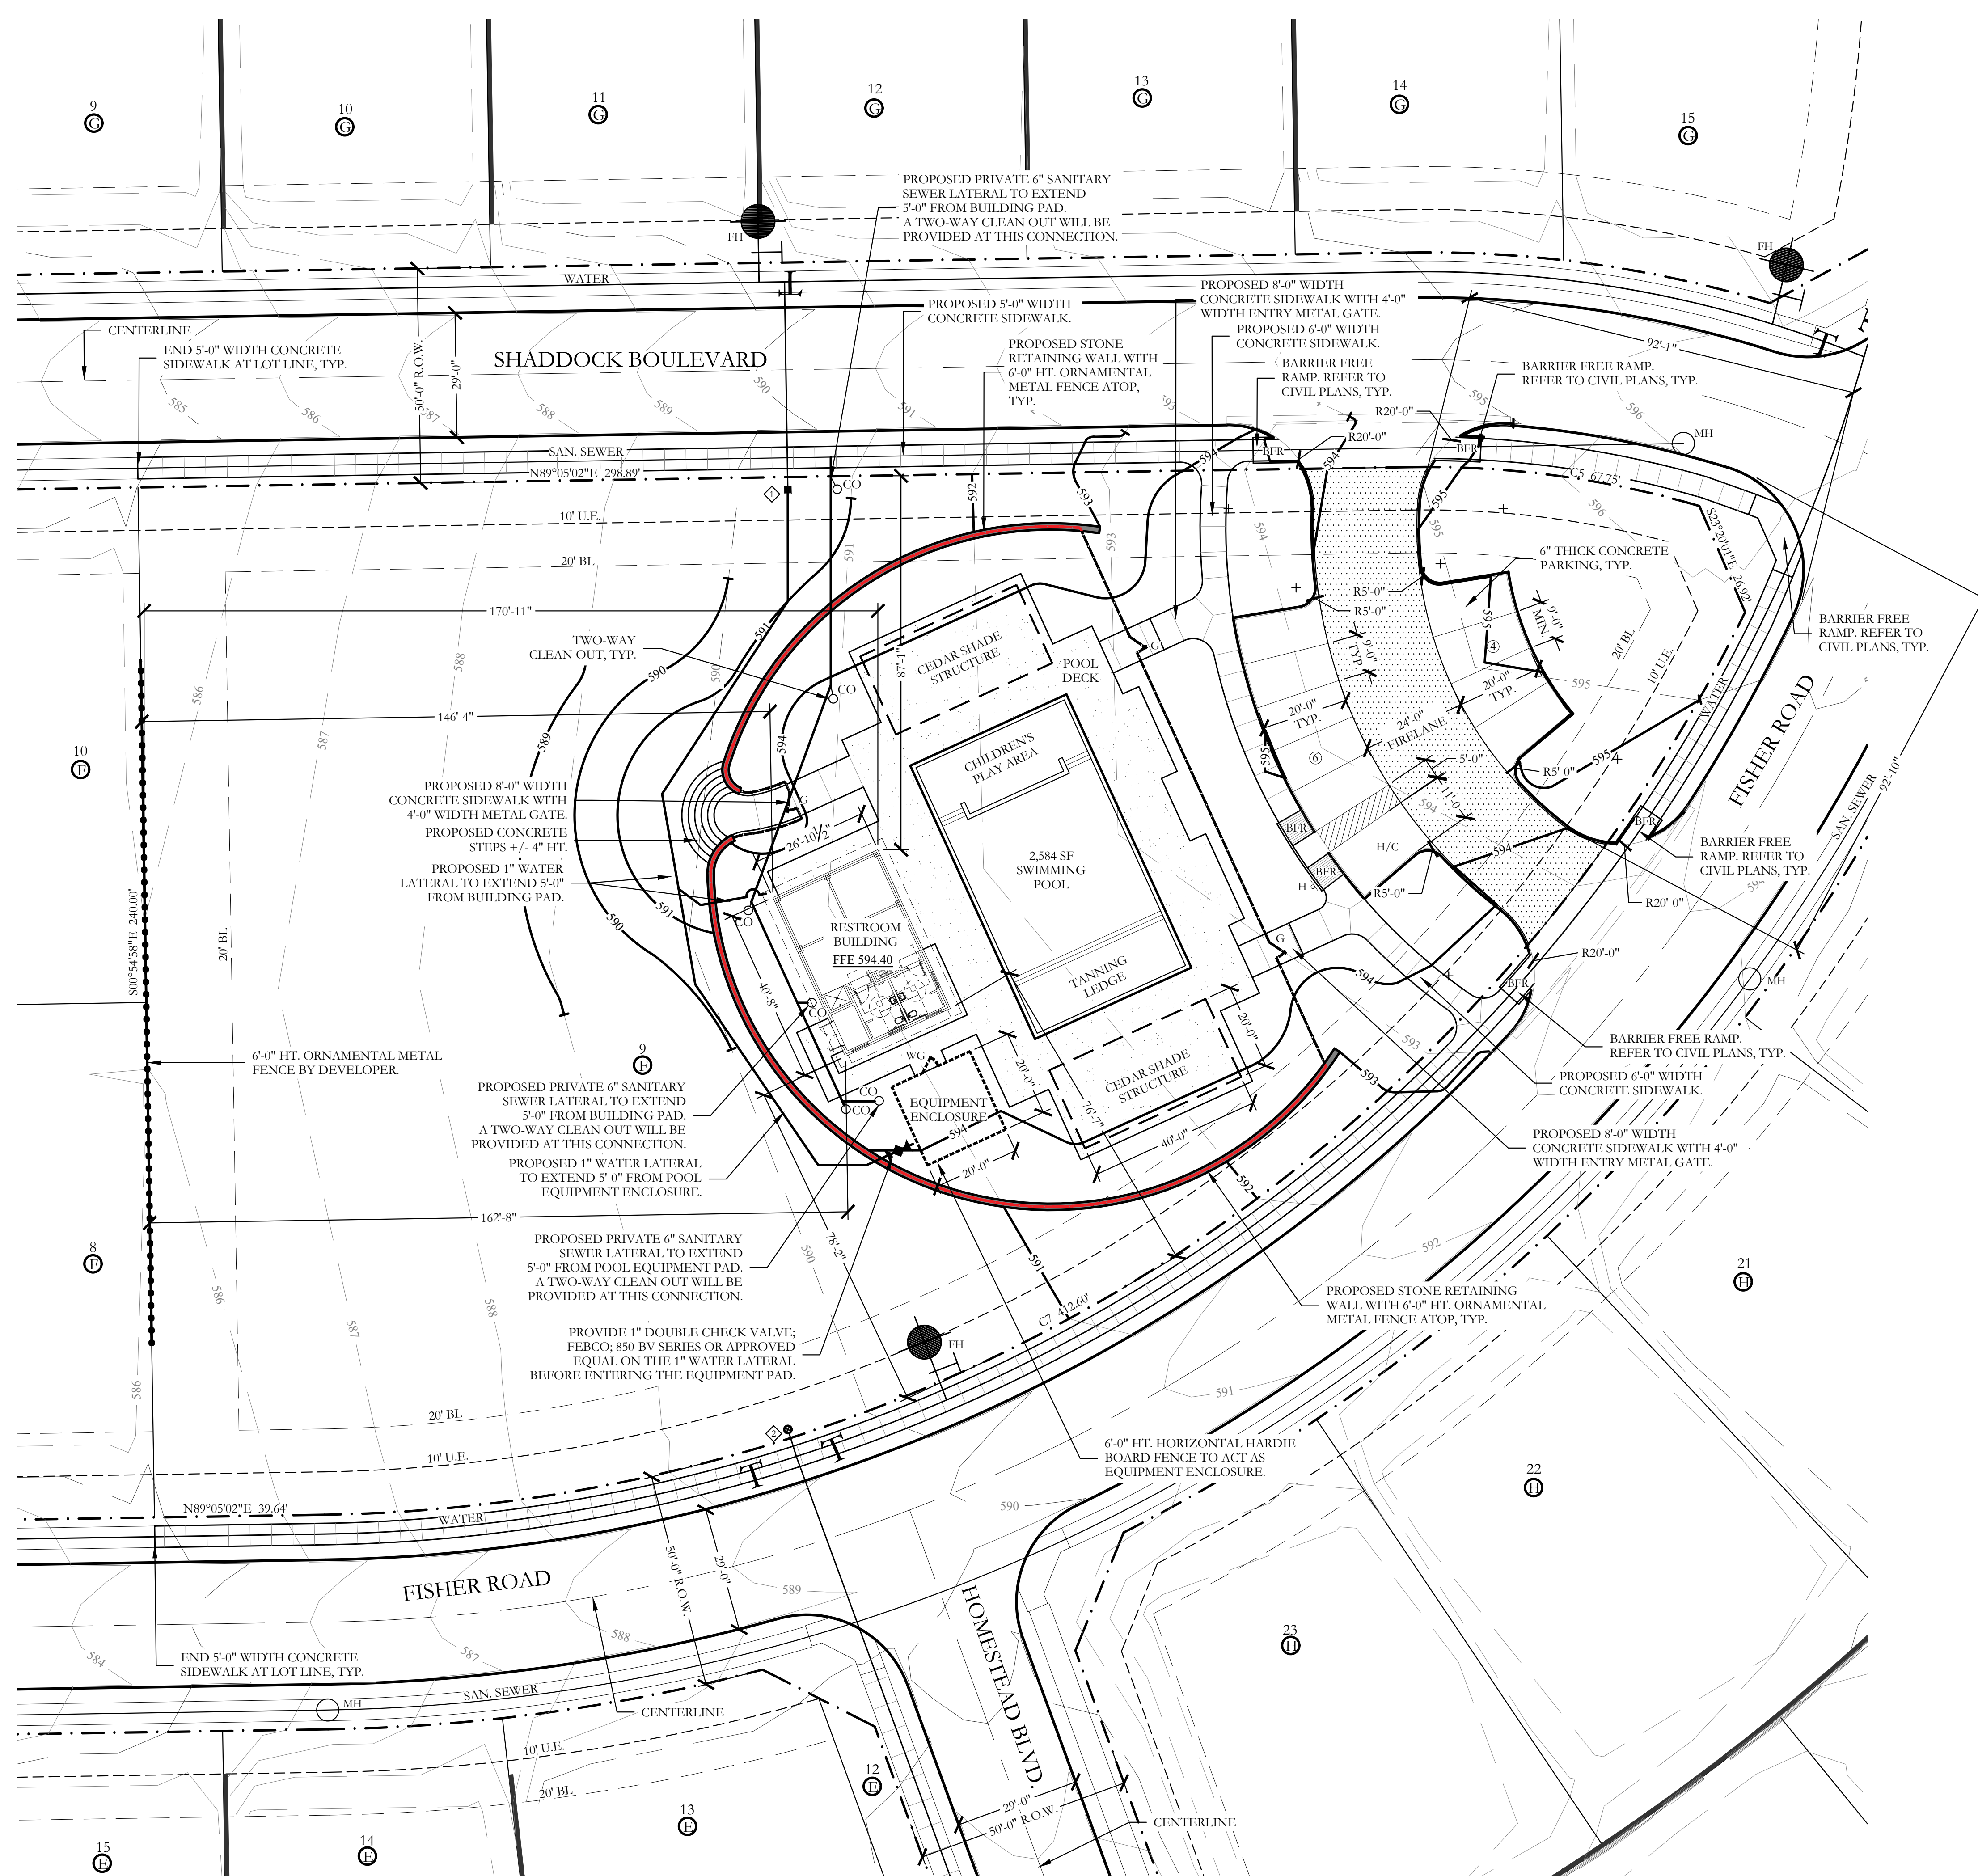

LEGEND

- ④ PROPOSED PARKING COUNT
- H/C PROPOSED HANDICAP PARKING SPACE
- BFR PROPOSED BARRIER FREE RAMP
- FH EXISTING FIRE HYDRANT
- MH EXISTING SANITARY SEWER MANHOLE
- EXISTING WATER MAIN W/ VALVE
- EXISTING SANITARY SEWER
- - - RIGHT-OF-WAY
- - - EXISTING CONTOUR INTERVAL
- - - PROPOSED CONTOUR INTERVAL
- FFE 594.40 FINISHED FLOOR ELEVATION
- ◊ PROPOSED 1.5" DOMESTIC WATER METER
- ◊ PROPOSED 1.5" IRRIGATION WATER METER
- H HANDICAP PARKING SIGN
- PROPOSED STONE RETAINING WALL
- ORNAMENTAL METAL FENCE (6'-0" HT. AROUND SWIMMING POOL AREA)
- ORNAMENTAL METAL FENCE ATOP RETAINING WALL (6'-0" HT. AROUND SWIMMING POOL AREA)
- 1-4'-0" WIDTH SELF LATCHING, SELF CLOSING METAL GATE
- 1-4'-0" WIDTH SELF LATCHING, SELF CLOSING WOODEN GATE
- 6'-0" HT. WOOD FENCE TO ACT AS POOL EQUIPMENT AND TRASH TOTE ENCLOSURE
- ORNAMENTAL METAL FENCE ALONG PROPERTY LINE
- FIRELANE PAVING PER CITY STANDARD DETAILS

WATER METER SCHEDULE

METER ID NUMBER	WATER SERVICE SIZE	WATER METER SIZE	METER DOM	METER IRR	SAN. SERVICE SIZE
◊	1.5"	1.5"	X		6"
◊	1.5"	1.5"		X	6"

SITE PLAN NOTES:

- NO 100 YEAR FLOOD PLAIN EXISTS ON PROPERTY.
- FOR ALL BARRIER FREE RAMPS NOTED ON PLAN, REFERENCE THE CITY OF ROCKWALL STANDARD CONSTRUCTION DETAILS.
- ALL HANDICAP PARKING SPACES SHALL BE A MINIMUM OF 11'-0" WIDTH x 20'-0" LENGTH WITH A 5'-0" LOADING AISLE.
- STANDARD PARKING SPACES SHALL BE A MINIMUM OF 9'-0" WIDTH x 20'-0" LENGTH.
- THE PERIMETER FENCING SHALL BE 6'-0" HT. ORNAMENTAL METAL FENCE.
- ALL VEHICULAR AND SIDEWALK PAVING SHOWN ON THESE PLANS SHALL BE MAINTAINED BY THE HOA.

NOTE: RETAINING WALLS OVER 3' IN HEIGHT WILL NEED TO BE ENGINEERED AND A RETAINING WALL PERMIT APPLICATION SHALL BE SUBMITTED TO THE ENGINEERING DEPARTMENT FOR REVIEW.

SITE INFORMATION


SINGLE FAMILY RESIDENTIAL
 PROPOSED USE: PRIVATE RECREATION CENTER
 LAND AREA: 1.60 ACRES
 69,696.00 SQ. FT.
 BUILDING AREA: 1,092.73 SQUARE FEET
 BUILDING HEIGHT: 22'-7" (1 STORY)
 FLOOR TO AREA: 0.0156:1 (1,092.73/69,696.00)
 LOT COVERAGE: 1.56%
 PARKING REQUIRED: 1 PER 250 SF. OF ASSEMBLY SPACE
 1,092.73/250=4.37
 5 REQUIRED SPACES
 PARKING PROVIDED: 10 TOTAL, (WITH 1 HANDICAP)
 HANDICAP PARKING IS PROVIDED IN ACCORDANCE WITH ADA STANDARDS
 TOTAL IMPERVIOUS SURFACE: 16,759.40 SF
 PROPOSED IMPERVIOUS RATIO: 0.244 OR 24.04%
 INTERIOR LANDSCAPE PROVIDED: 52,936.60 SF
 POOL DECK SURFACE: 5,524.59 SF

APPROVED:


I hereby certify that the above and foregoing site plan for a development in the City of Rockwall, Texas, was approved by the Planning & Zoning Commission of the City of Rockwall on the ___ day of ___, 2023.

WITNESS OUR HANDS, this ___ day of ___, 2023.

 Planning & Zoning Commission, Chairman Director of Planning and Zoning

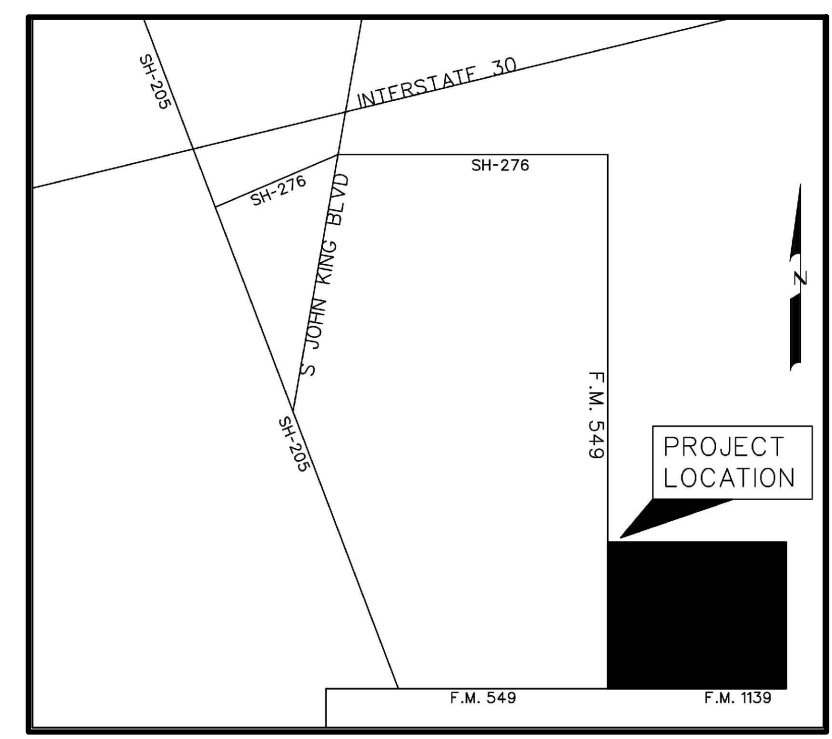

LOCATION MAP
NOT TO SCALE

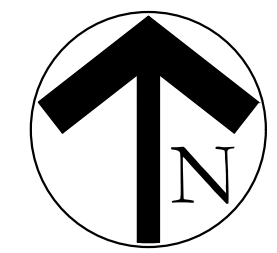

20 10 0 20
 SCALE 1" = 20'

SITE PLAN
HOMESTEAD, PHASE 1
LOT 9, BLOCK F
~AMENITY CENTER~

BEING 1.600 ACRES OUT OF THE
 J.A. RAMSEY SURVEY
 ABSTRACT NO. 186 IN THE
 CITY OF ROCKWALL, ROCKWALL COUNTY, TEXAS

OWNER / DEVELOPER:

SHADDOCK HOMES, INC
 2400 DALLAS PARKWAY, SUITE 460
 MCKINNEY, TEXAS 75093
 CONTACT: LORA ERDMAN

LANDSCAPE ARCHITECT/CIVIL ENGINEER:




JOHNSON VOLK CONSULTING
 704 CENTRAL PARKWAY EAST, SUITE 1200
 PLANO, TEXAS 75074
 PH. 972-201-3100
 CONTACT: CODY JOHNSON, RLA, ASLA, LI



December 05, 2023

BUILDING MATERIAL CALCULATIONS

Material	North	Percent	South	Percent	East	Percent	West	Percent
TOTAL SQ FT. (EXCLUDING DOORS/WINDOWS/TRIM/ROOF AREA)	341 S.F.	-	400 S.F.	-	141 S.F.	-	164 S.F.	-
PRIMARY MATERIAL TOTALS	338 S.F.	99.12%	288 S.F.	72.00%	139 S.F.	98.58%	162 S.F.	98.78%
BRICK VENEER	229 S.F.	67.16%	226 S.F.	56.50%	139 S.F.	98.58%	162 S.F.	98.78%
BOARD AND BATTEN FIBER CEMENT SIDING	109 S.F.	31.96%	62 S.F.	15.50%	-	-	-	-
SECONDARY MATERIALS	3 S.F.	0.88%	112 S.F.	28.00%	2 S.F.	1.42%	2 S.F.	1.22%
DOUGLAS FIR BEAMS/COLUMNS	3 S.F.	0.88%	72 S.F.	18.00%	2 S.F.	1.42%	2 S.F.	1.22%
TILE AT SHOWER	-	-	40 S.F.	10.00%	-	-	-	-
DOORS/WINDOWS/TRIM (COLOR TO MATCH ADJACENT MATERIALS)	72 S.F.	-	48 S.F.	-	45 S.F.	-	22 S.F.	-
STANDING SEAM METAL ROOF	-	-	-	-	-	-	-	-

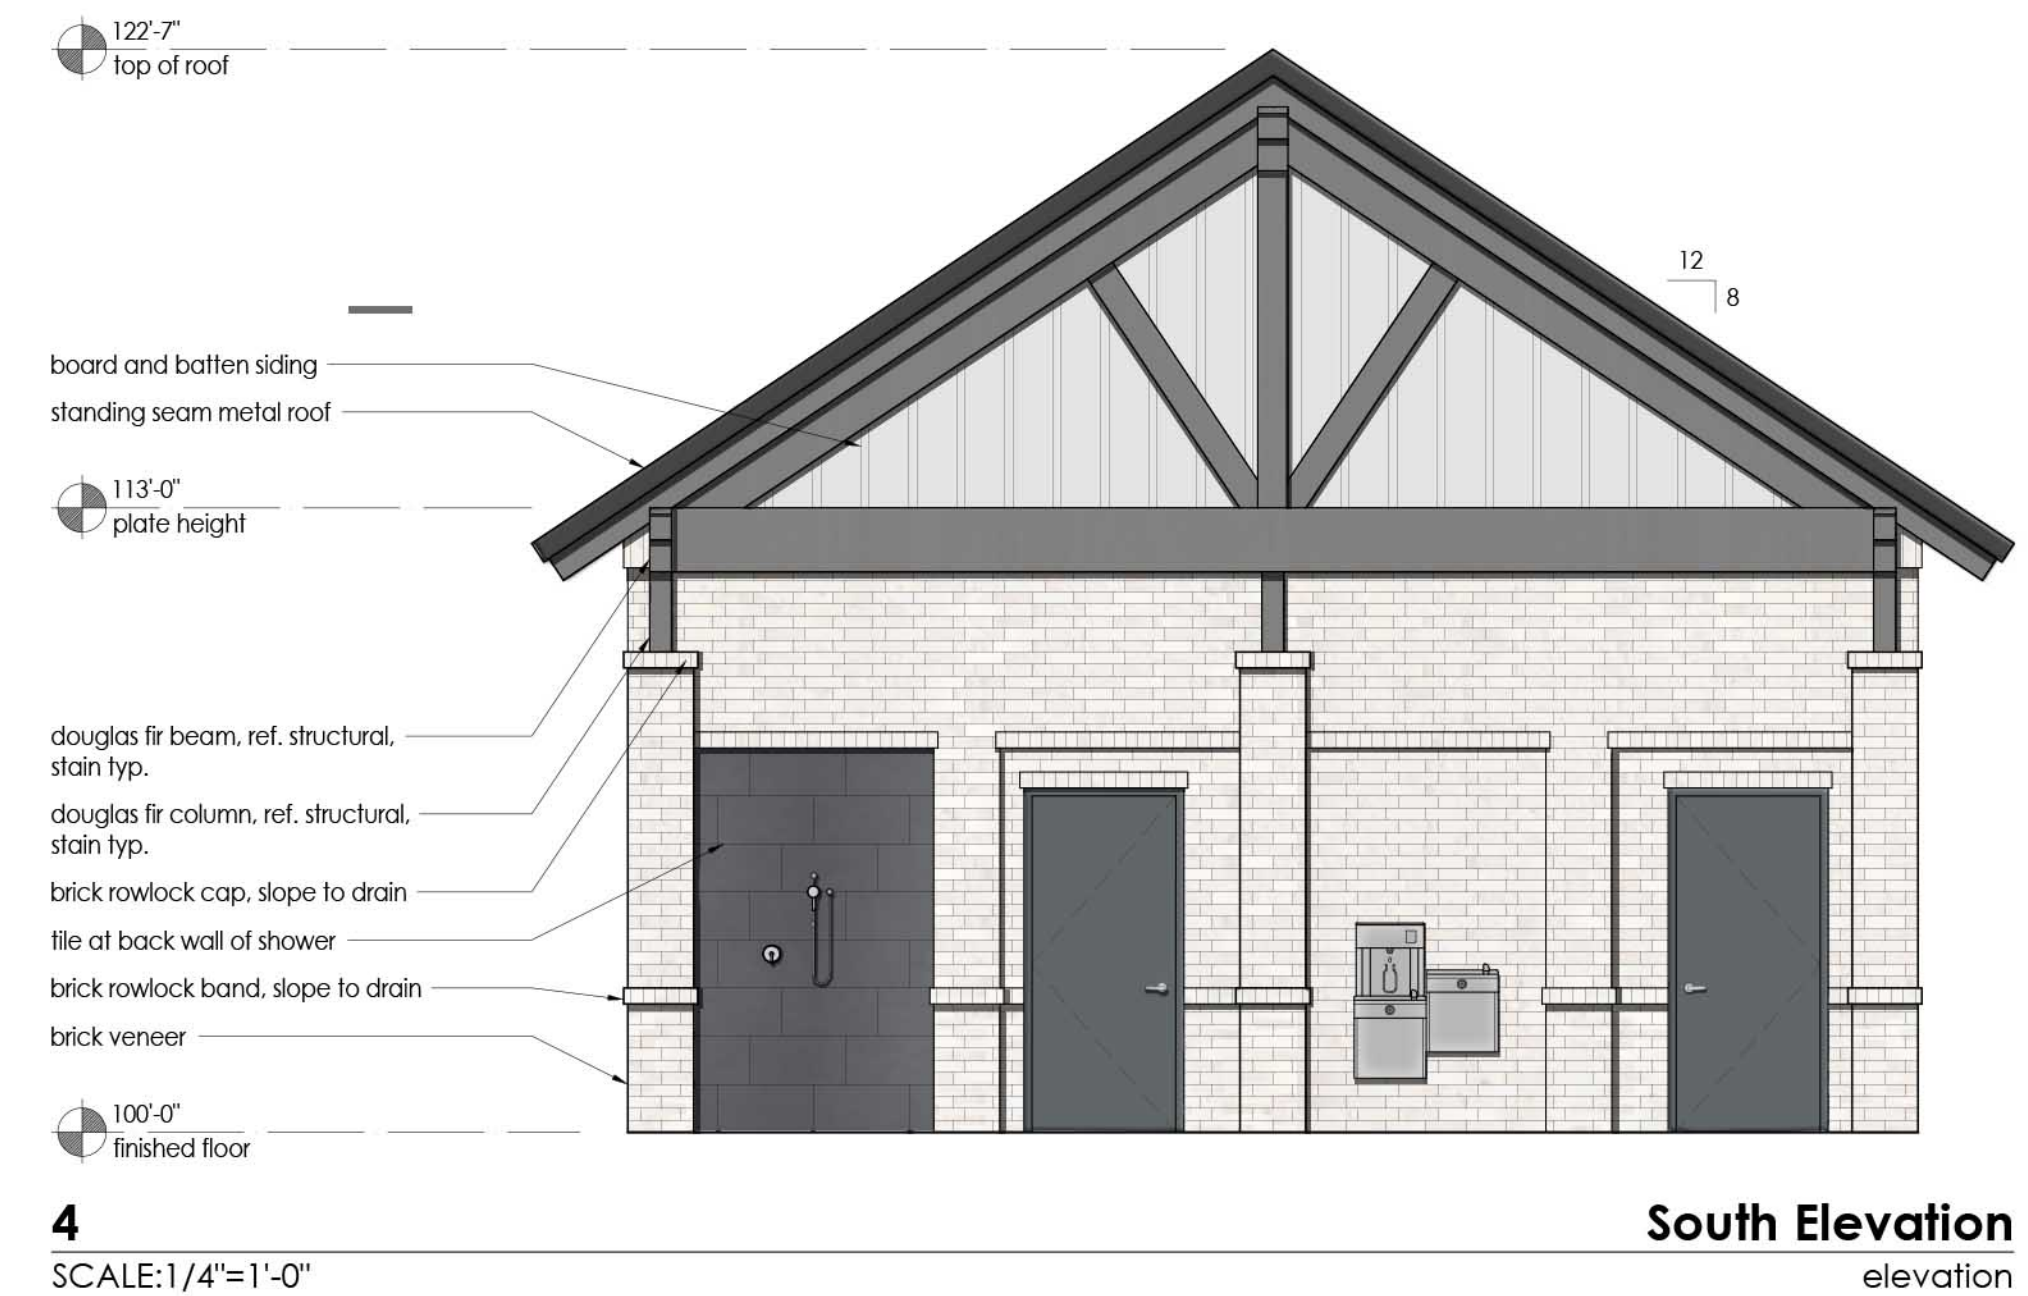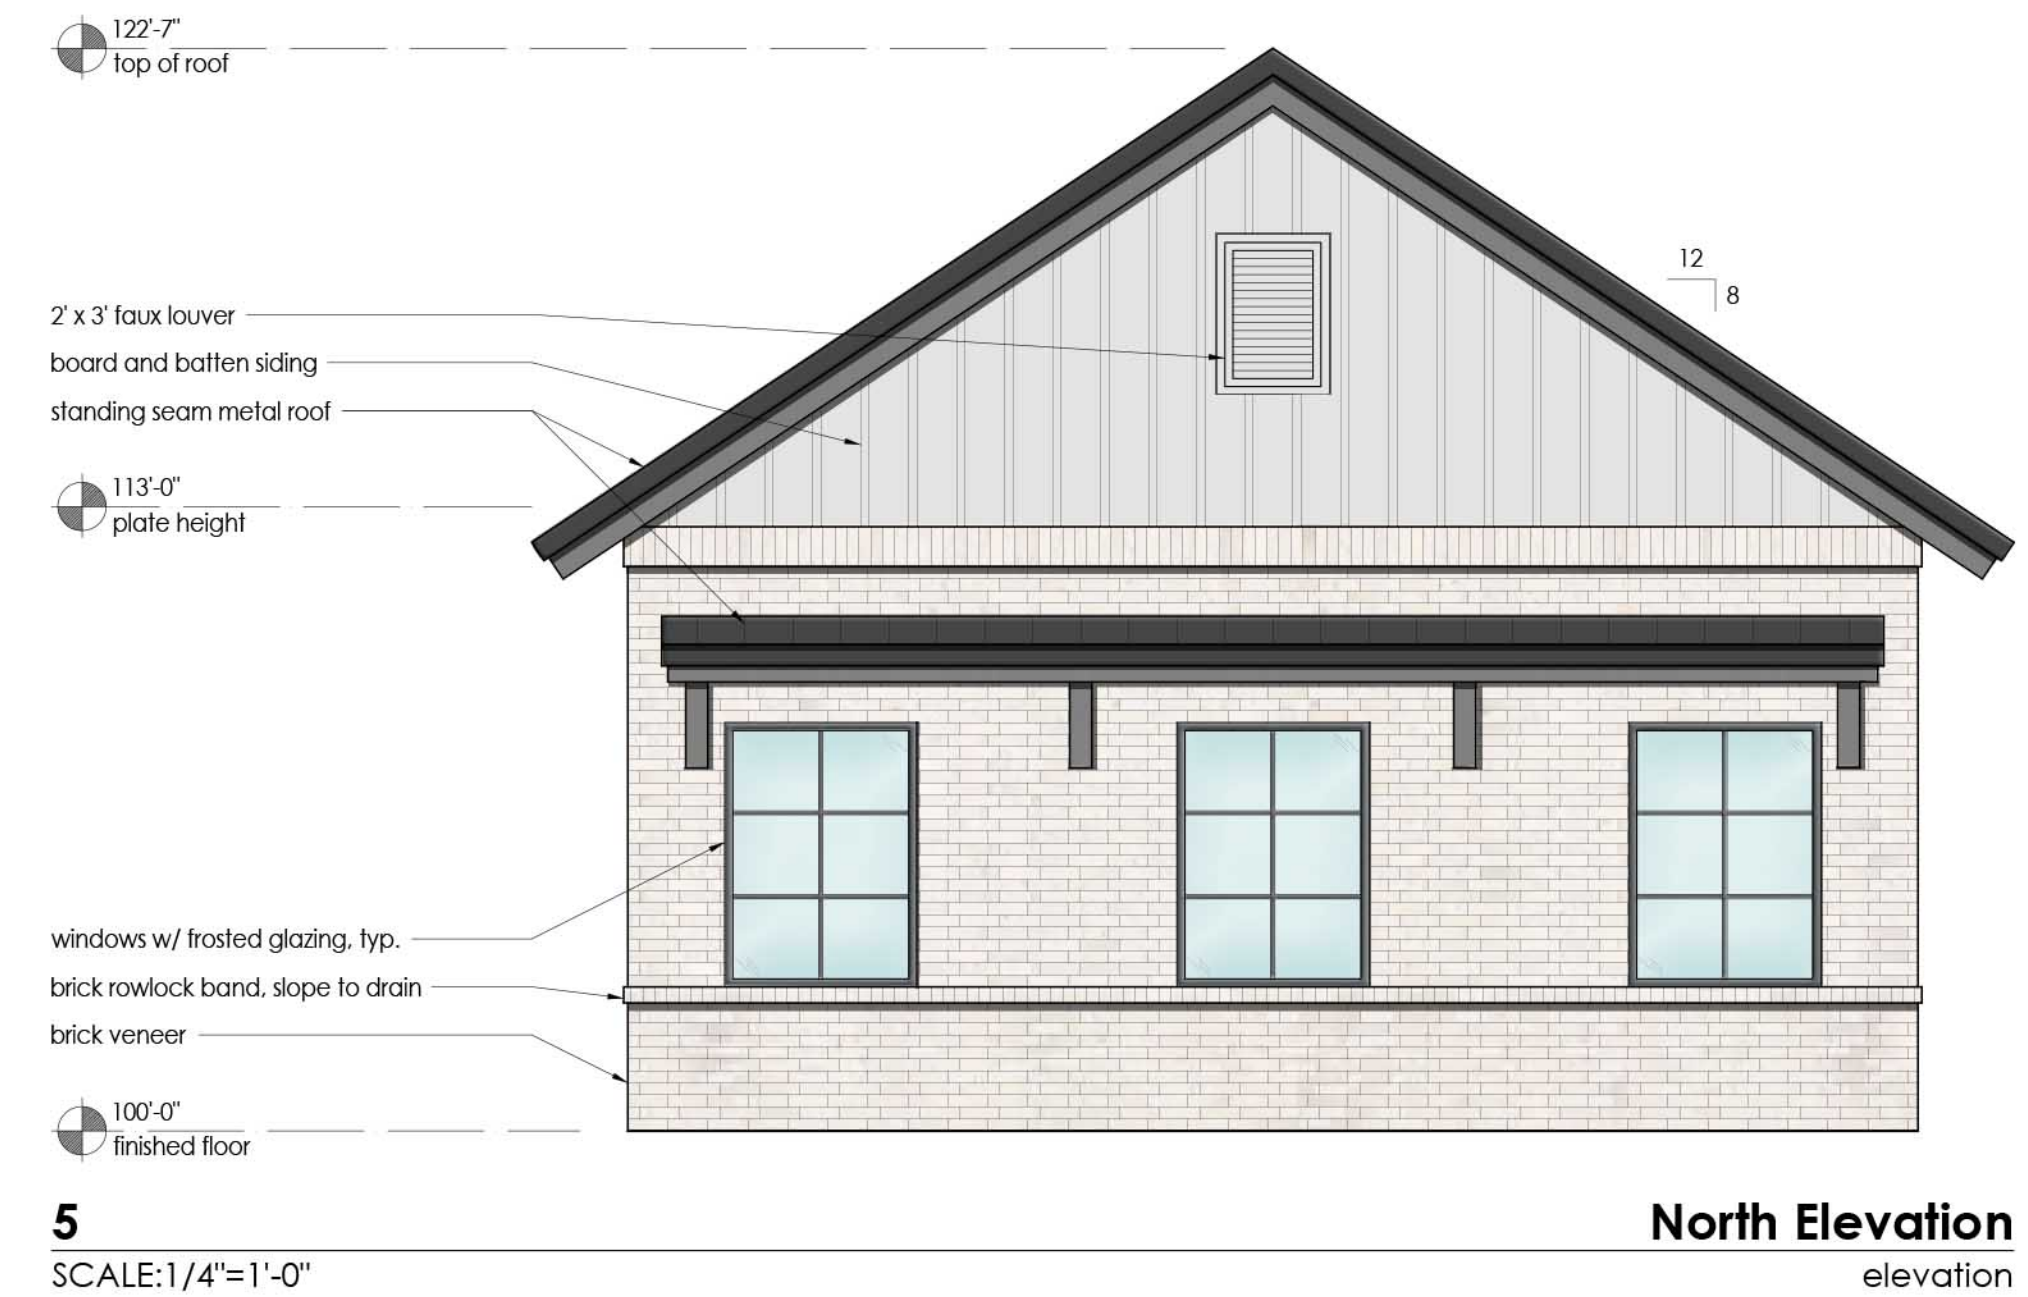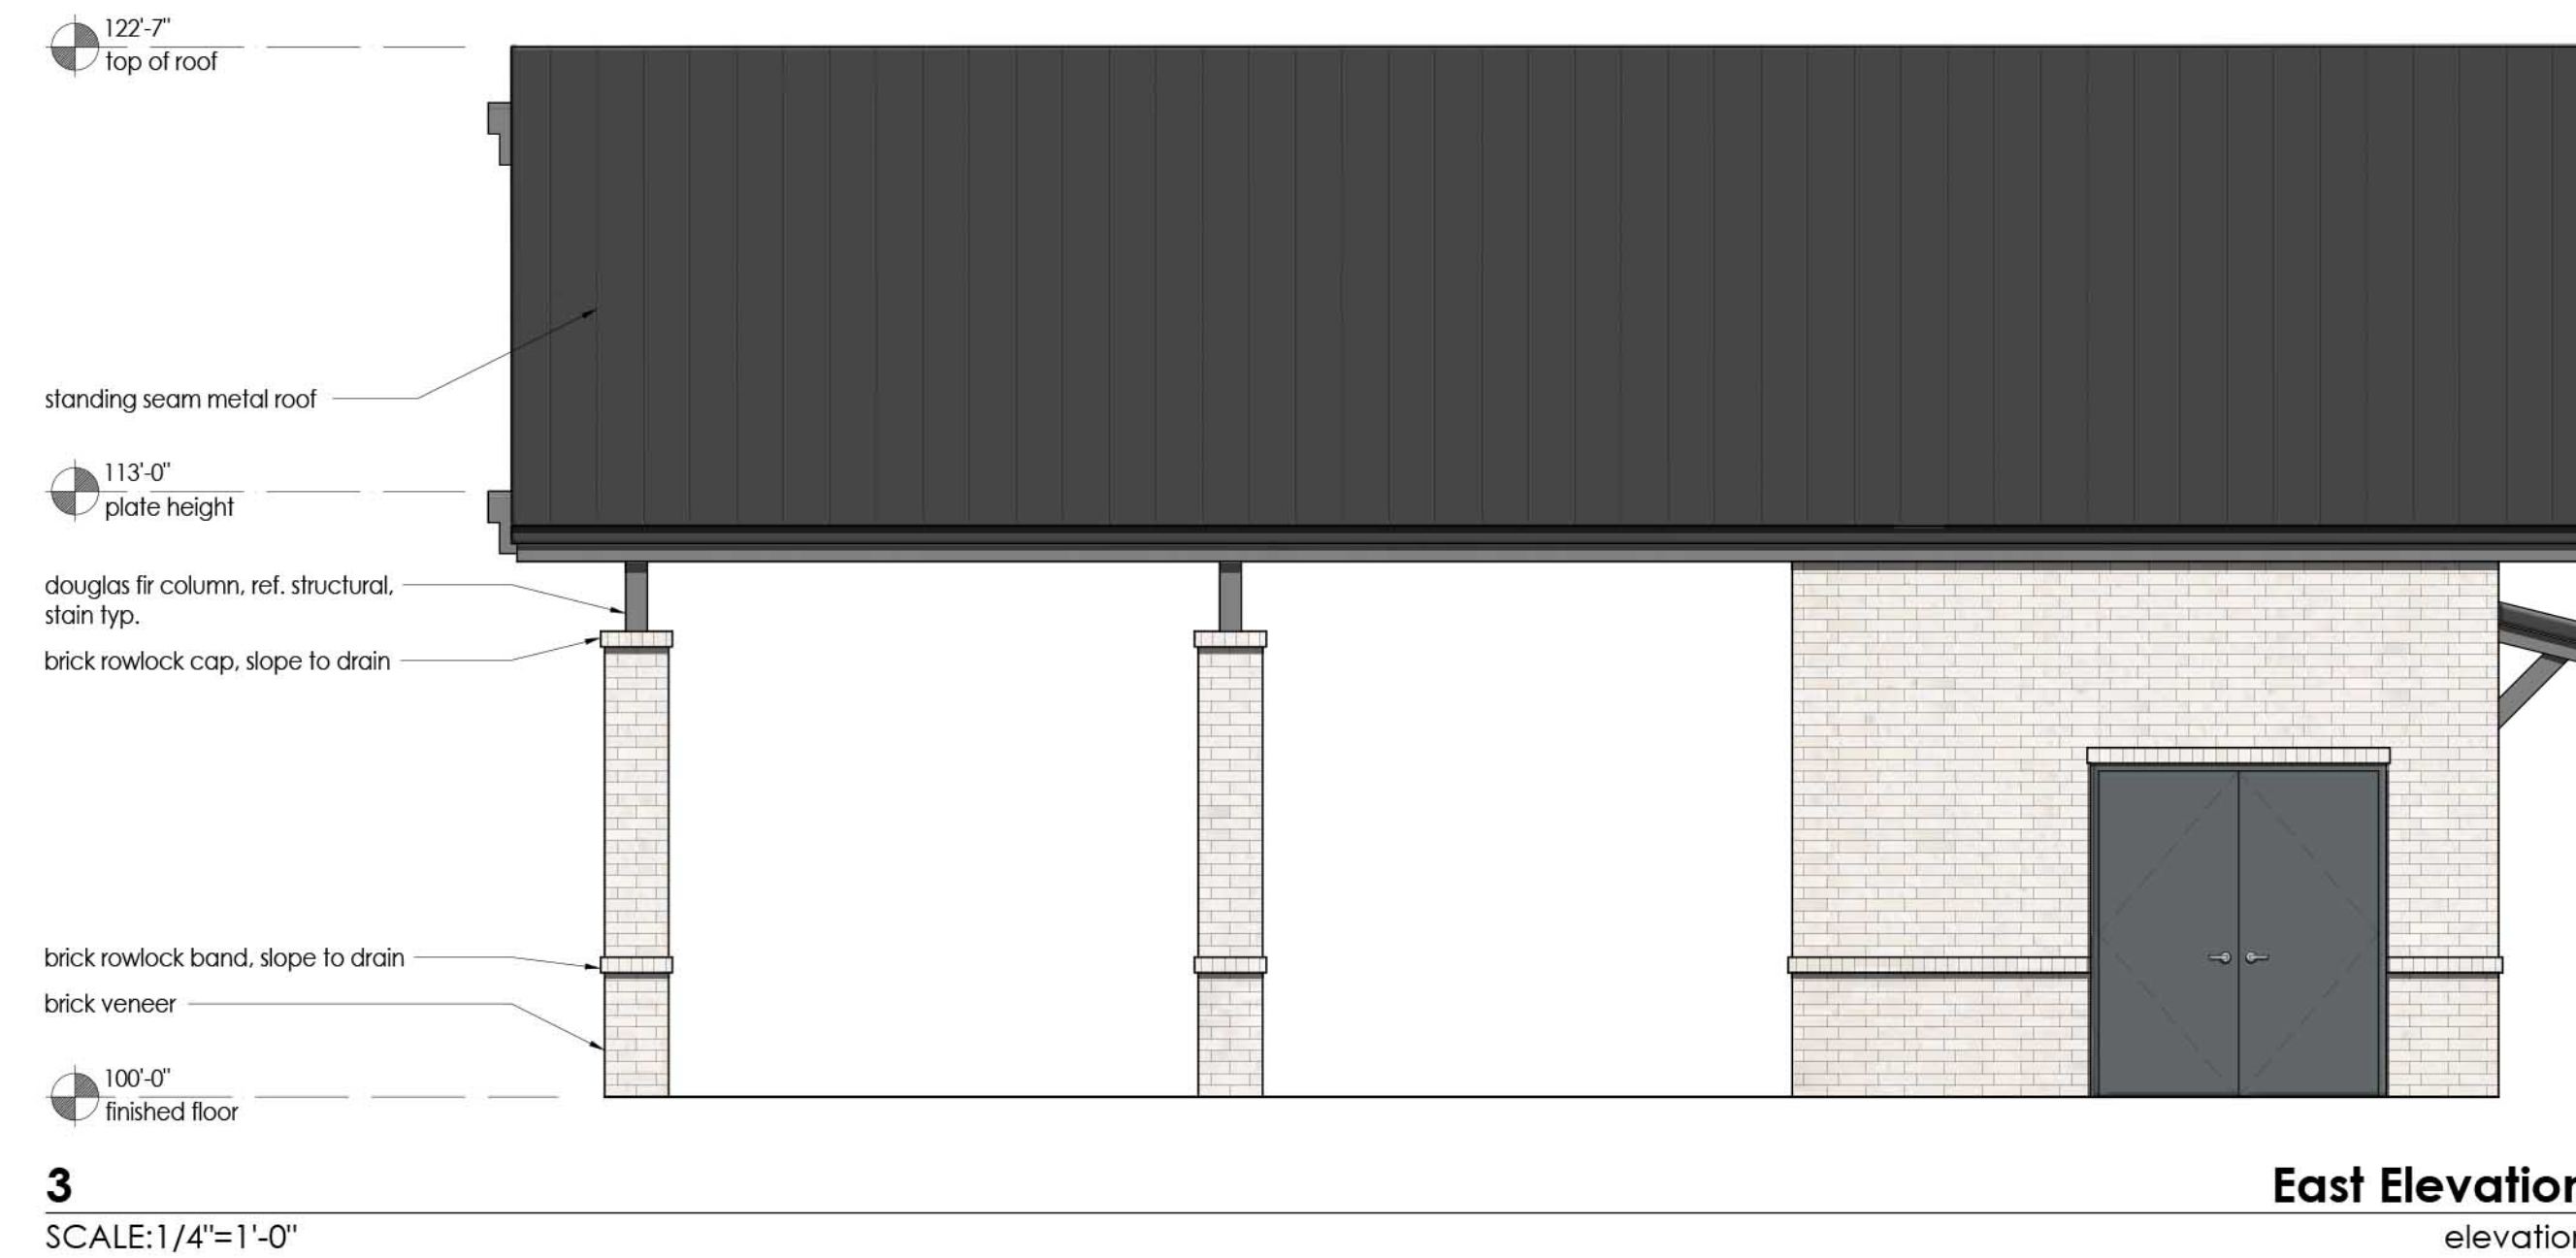

FACADE PLAN
HOMESTEAD, PHASE 1
LOT 9, BLOCK F
~AMENITY CENTER~

BEING 1.600 ACRES OUT OF THE
J.A. RAMSEY SURVEY
ABSTRACT NO. 186 IN THE
CITY OF ROCKWALL, ROCKWALL COUNTY, TEXAS

APPROVED:
I hereby certify that the above and foregoing site plan for a development in the City of Rockwall, Texas, was approved by the Planning & Zoning Commission of the City of Rockwall on the ___ day of ___, ____.

WITNESS OUR HANDS, this ___ day of ___, ____.

Planning & Zoning Commission, Chairman

Director of Planning and Zoning

OWNER / DEVELOPER:
SHADDOCK HOMES, INC
2400 DALLAS PARKWAY, SUITE 460
MCKINNEY, TEXAS 75093
CONTACT: LORA ERDMAN

LANDSCAPE ARCHITECT/CIVIL ENGINEER:
JOHNSON VOLK CONSULTING
704 CENTRAL PARKWAY EAST, SUITE 1200
PLANO, TEXAS 75074
PH. 972-201-3100
CONTACT: CODY JOHNSON, RLA, ASLA, LI




SHERWIN WILLIAMS
WEB GRAY
SW 7075



ACME BRICK
ASHWOOD




SHERWIN WILLIAMS
KINGS CANYON (WOOD STAIN)
SW 3026

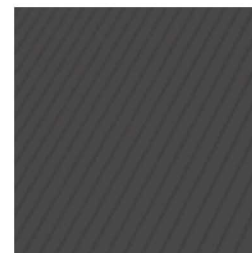

MUELLER, INC.
DARK CHARCOAL



 DALTILE
DARK GREY (TILE)
12 X 24



SHERWIN WILLIAMS
ICE CUBE
SW 6252



GLASS WINDOW
WITH
FROSTED GLAZING

OWNER/DEVELOPER:

SHADDOCK HOMES, INC
2400 DALLAS PARKWAY, SUITE 460
MCKINNEY, TEXAS 75093
CONTACT: LORA ERDMAN
PHONE: 972-526-7645
EMAIL: LORAERDMAN@SHADDOCKHOMES.COM

LANDSCAPE ARCHITECT:

JOHNSON VOLK CONSULTING
704 CENTRAL PARKWAY EAST, SUITE 1200
PLANO, TEXAS 75074
CONTACT: CODY JOHNSON, RLA, ASLA, LI
PHONE: 972-201-3100
EMAIL: CODYJOHNSON@JOHNSONVOLK.COM


SUBMITTAL DATE: November 13, 2023

SEAL


Copyright © 2023

DATE: _____
SCALE: _____
JOB NO. _____
DRAWN: _____
APPD: _____
ACAD # _____


DRAWING NO. _____ REV. NO. _____

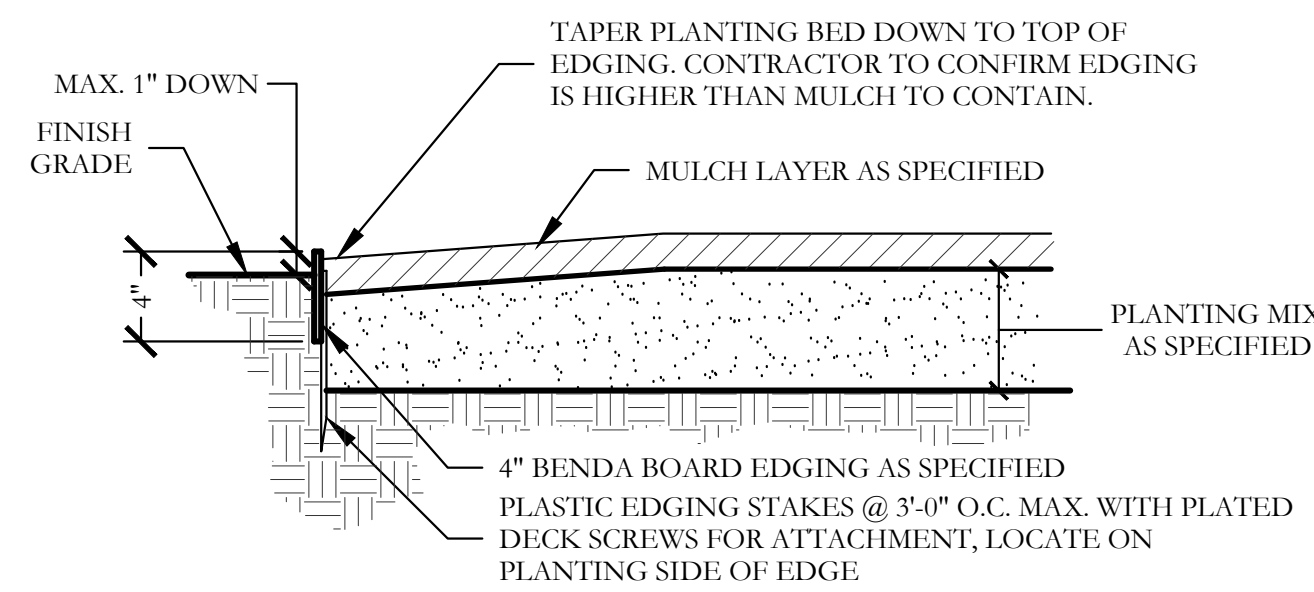

1 TYPICAL BED EDGING DETAIL SECTION NOT TO SCALE

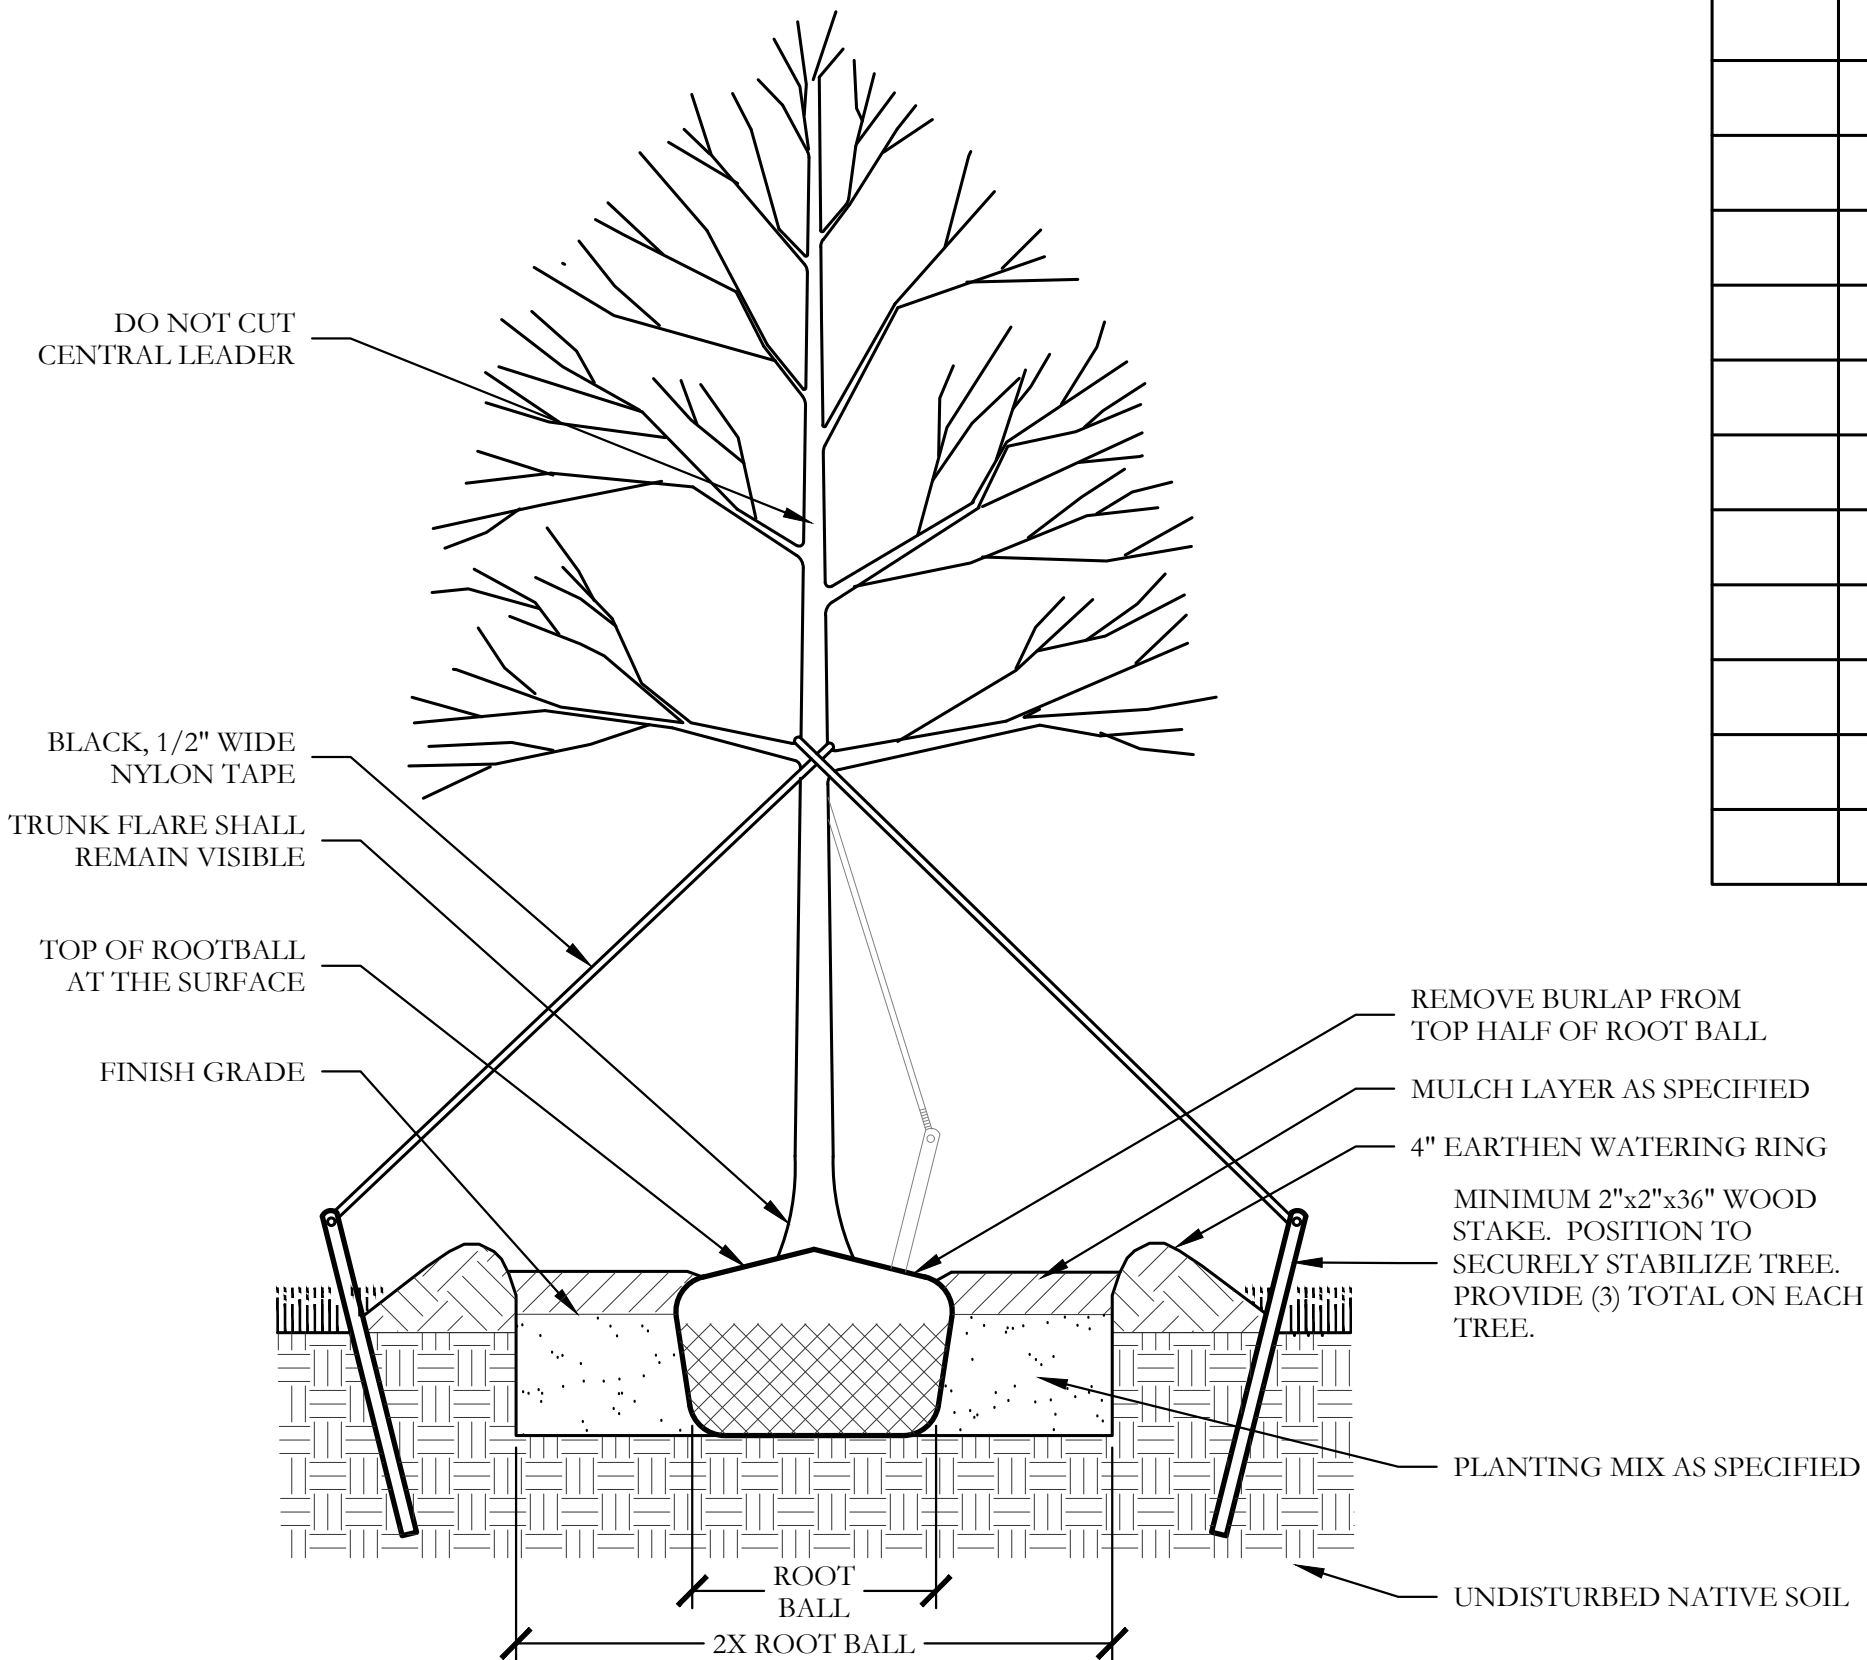

2 TYPICAL TREE PLANTING SECTION NOT TO SCALE

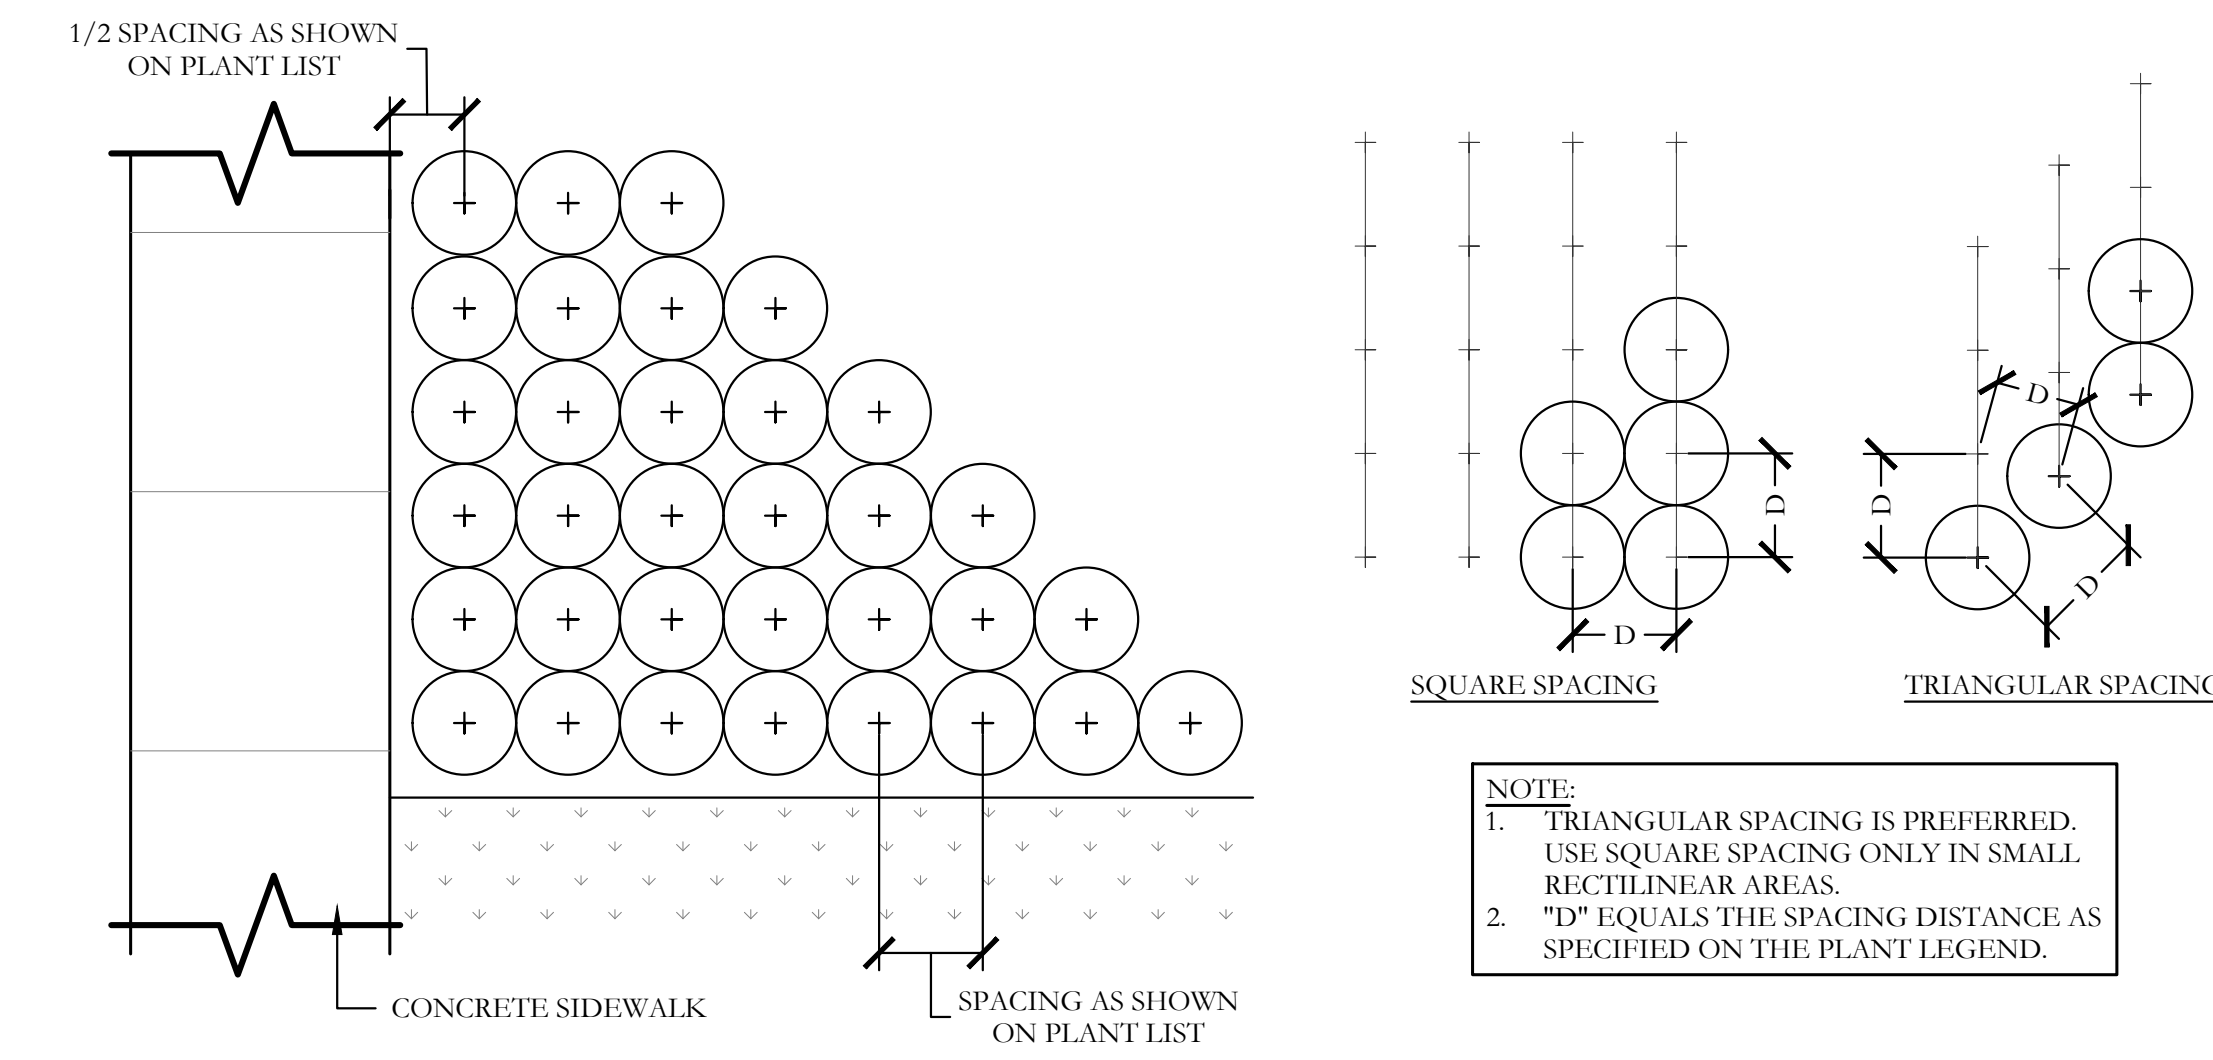

3 TYPICAL SHRUB AND GROUNDCOVER PLANTING PLAN/SECTION NOT TO SCALE

PLANT LIST						
KEY	ESTIMATED QUANTITY	COMMON NAME	SCIENTIFIC NAME	SIZE	SPACING	REMARKS
LO	9	LIVE OAK	QUERCUS VIRGINIANA	4" CALIPER	AS SHOWN	NURSERY GROWN; FULL HEAD; MINIMUM BRANCHING HEIGHT AT 6'-0"; MINIMUM 10'-0" OVERALL HEIGHT.
BO	7	BUR OAK	QUERCUS MACROCARPA	4" CALIPER	AS SHOWN	NURSERY GROWN; FULL HEAD; MINIMUM BRANCHING HEIGHT AT 6'-0"; MINIMUM 10'-0" OVERALL HEIGHT.
LE	10	LACEBARK ELM	ULMUS PARVIFOLIA	4" CALIPER	AS SHOWN	NURSERY GROWN; FULL HEAD; MINIMUM BRANCHING HEIGHT AT 6'-0"; MINIMUM 10'-0" OVERALL HEIGHT.
CE	6	CEDAR ELM	ULMUS CRASSIFOLIA	4" CALIPER	AS SHOWN	NURSERY GROWN; FULL HEAD; MINIMUM BRANCHING HEIGHT AT 6'-0"; MINIMUM 10'-0" OVERALL HEIGHT.
LGM	3	LITTLE GEM MAGNOLIA	MAGNOLIA GRANDIFLORA 'LITTLE GEM'	2" CALIPER	AS SHOWN	NURSERY GROWN; FULL HEAD; MINIMUM 8'-0" OVERALL HEIGHT.
DW	4	DESERT WILLOW	CHILOPSIS LINEARIS	2" CALIPER	AS SHOWN	NURSERY GROWN; FULL HEAD; MINIMUM 8'-0" OVERALL HEIGHT.
YH	8	YAUPON HOLLY	ILEX VOMITORIA	2" CALIPER	AS SHOWN	NURSERY GROWN; FULL HEAD; MINIMUM 8'-0" OVERALL HEIGHT.
RB	6	TEXAS REDBUD	CERCIS CANADENSIS VAR. TEXENSIS	2" CALIPER	AS SHOWN	NURSERY GROWN; FULL HEAD; MINIMUM 8'-0" OVERALL HEIGHT.
	21	PURPLE DIAMOND LOROPETALUM	LOROPETALUM CHINENSIS 'PURPLE DIAMOND'	7 GALLON	48" O.C.	CONTAINER GROWN; FULL PLANT.
	74	TEXAS SAGE	LEUCOPHYLLUM FRUTESCENS	7 GALLON	48" O.C.	CONTAINER GROWN; FULL PLANT.
	67	GLOSSY ABELIA	LINNAEA X GRANDIFLORA	7 GALLON	36" O.C.	CONTAINER GROWN; FULL PLANT.
	42	DWARF BURFORD HOLLY	ILEX CORNUTA 'DWARF BURFORD'	7 GALLON	36" O.C.	CONTAINER GROWN; FULL PLANT.
	6	UPRIGHT ROSEMARY	ROSMARINUS OFFICINALIS 'UPRIGHT'	3 GALLON	36" O.C.	CONTAINER GROWN; FULL PLANT.
	6	DWARF MAIDEN GRASS	MISCANTHUS SINENSIS ADAGIO'	3 GALLON	36" O.C.	CONTAINER GROWN; FULL PLANT.
	10	MORNING LIGHT MISCANTHUS	MISCANTHUS SINENSIS 'MORNING LIGHT'	3 GALLON	36" O.C.	CONTAINER GROWN; FULL PLANT.
	21	RED YUCCA	HESPERALOE PARVIFLORA	3 GALLON	36" O.C.	CONTAINER GROWN; FULL PLANT.
	70	PLUM YEW PROSTRATA	CEPHALOTAXUS HARRINGTONIA 'PROSTRATA'	3 GALLON	48" O.C.	CONTAINER GROWN; FULL PLANT.
	825	LIRIOPE GRASS	LIRIOPE MUSCARI	1 GALLON	18" O.C.	CONTAINER GROWN; FULL PLANT.
	85	MEXICAN FEATHER GRASS	NASSELLA TENUISSIMA	1 GALLON	18" O.C.	CONTAINER GROWN; FULL PLANT.
	825	ANNUAL COLOR	TO BE SELECTED BY OWNER	4" POT	8" O.C.	CONTAINER GROWN; FULL PLANT.
	50,135	COMMON BERMUDA GRASS	CYNODON DACTYLON	SQUARE FEET	SOLID SOD	MINIMUM 100% COVERAGE ALL AREAS SHOWN

GENERAL LANDSCAPE NOTES

- INSPECTIONS:**
- NO EXCAVATION SHALL OCCUR IN CITY R.O.W. WITHOUT A R.O.W. PERMIT--CONTACT THE PUBLIC WORKS DEPARTMENT.
 - THE CONTRACTOR SHALL MARK ALL WATER LINES, SEWER LINES, AND TREE LOCATIONS PRIOR TO CALLING FOR ROW INSPECTION AND PERMIT.
 - THE LANDSCAPE INSTALLATION SHALL COMPLY WITH APPROVED LANDSCAPE DRAWINGS PRIOR TO FINAL ACCEPTANCE BY THE CITY AND ISSUANCE OF A CERTIFICATE OF OCCUPANCY.
 - WATER METERS, CLEANOUTS AND OTHER APPURTENANCES, SHALL BE ACCESSIBLE, ADJUSTED TO GRADE, CLEARLY MARKED WITH FLAGGING AND COMPLIANT WITH PUBLIC WORKS DEPARTMENT STANDARDS PRIOR TO CALLING FOR FINAL LANDSCAPE AND ROW INSPECTIONS.

- LANDSCAPE STANDARDS:**
- PLANTINGS AND LANDSCAPE ELEMENTS SHALL COMPLY WITH THE CITY'S ENGINEERING DESIGN STANDARDS, PUBLIC R.O.W. VISIBILITY REQUIREMENTS.
 - UNLESS OTHERWISE SPECIFIED, TREES SHALL BE PLANTED NO LESS THAN 4' FROM CURBS, SIDEWALKS, UTILITY LINES, SCREENING WALLS AND OTHER STRUCTURES. THE CITY HAS FINAL APPROVAL FOR ALL TREE PLACEMENTS.
 - A MINIMUM THREE FEET (3') RADIUS AROUND A FIRE HYDRANT MUST REMAIN CLEAR OF LANDSCAPE PURSUANT TO THE FIRE CODE.
 - STREET TREES, WHERE REQUIRED, SHALL BE (10') MINIMUM FROM THE EDGE OF A STORM SEWER CURB INLET BOX AND THE EDGE OF THE ROOT BALL SHALL BE (4') MINIMUM FROM THE WATER METER.
 - THE AMERICAN STANDARD FOR NURSERY STOCK (ANSI Z60.1-2004) SPECIFICATIONS SHALL GOVERN PLANT QUALIFICATIONS, GRADES, AND STANDARDS.
 - TREE PLANTING SHALL COMPLY WITH DETAILS HEREIN AND THE INTERNATIONAL SOCIETY OF ARBORICULTURE (ISA) STANDARDS.
 - A 2-3" LAYER OF MULCH SHALL BE PROVIDED AROUND THE BASE OF THE PLANTED TREE. THE MULCH SHALL BE PULLED BACK 4" FROM THE TRUNK OF THE TREE.
 - TREE PITS SHALL BE TESTED FOR WATER PERCOLATION. IF WATER DOES NOT DRAIN OUT OF TREE PIT WITHIN 24-HOURS, THE TREE SHALL BE MOVED OR DRAINAGE SHALL BE PROVIDED.
 - ALL BEDS TO HAVE 3" OF COMPOSTED SOIL, LIVING EARTH TECHNOLOGY, OR APPROVED EQUAL TILLED AND TURNED TO A DEPTH OF 8" MINIMUM.
 - ALL PLANT BEDS SHALL BE TOP-DRESSED WITH A MINIMUM OF 3 INCHES OF HARDWOOD MULCH.
 - NATIVE SITE TOPSOILS TO BE PROTECTED FROM EROSION OR STOCKPILED. NATIVE SITE TOPSOIL SHALL BE LABORATORY TESTED BY AN ACCREDITED LABORATORY AND AMENDED PER SAID LABORATORY'S RECOMMENDATIONS.

- IRRIGATION STANDARDS:**
- ANY CHANGES TO THESE APPROVED IRRIGATION DRAWINGS SHALL BE AUTHORIZED BY THE CITY.
 - CONTACT DEVELOPMENT SERVICES FOR AN IRRIGATION PERMIT PRIOR TO INSTALLING THE IRRIGATION SYSTEM.
 - IRRIGATION OVER-SPRAY ON STREETS AND WALKS IS PROHIBITED.
 - MAINLINES, VALVES, OR CONTROL WIRES SHALL NOT BE LOCATED IN THE CITY'S ROW.
 - ET IRRIGATION CONTROLLERS SHALL BE PROGRAMMED AND ADJUSTED TO NOT EXCEED THE LANDSCAPE WATER ALLOWANCE (LWA) PRIOR TO APPROVAL OF LANDSCAPE INSTALLATION.
 - VALVES SHALL BE LOCATED A MINIMUM OF (5') AWAY FROM STORM SEWERS, AND SANITARY SEWER LINES AND 5 FEET FROM CITY FIRE HYDRANTS AND WATER VALVES.
 - THE BORE DEPTH UNDER STREETS, DRIVE AISLES, AND FIRE LANES SHALL PROVIDE (2') OF CLEARANCE (MINIMUM).
 - IRRIGATION HEADS THAT RUN PARALLEL AND NEAR PUBLIC WATER AND SANITARY SEWER LINES; SHALL BE FED FROM STUBBED LATERALS OR BULL-BEADS. A MINIMUM FIVE FOOT (5') SEPARATION IS REQUIRED BETWEEN IRRIGATION MAIN LINES AND LATERALS THAT RUN PARALLEL TO PUBLIC WATER AND SANITARY SEWER LINES.
 - NO VALVES, BACKFLOW PREVENTION ASSEMBLIES, QUICK COUPLERS ETC. SHALL BE LOCATED CLOSER THAN 10' FROM THE CURB AT STREET OR DRIVE INTERSECTION.

- MAINTENANCE STANDARDS:**
- THE OWNER SHALL BE RESPONSIBLE FOR THE ESTABLISHMENT, MAINTENANCE, AND VIGOR OF PLANT MATERIAL IN ACCORDANCE WITH THE DESIGN INTENT AND AS APPROPRIATE FOR THE SEASON OF THE YEAR.
 - LANDSCAPE AND OPEN AREAS SHALL BE FREE OF TRASH, LITTER AND WEEDS.
 - NO PLANT MATERIAL SHALL BE ALLOWED TO ENCROUGH ON R.O.W., SIDEWALKS OR EASEMENTS TO THE EXTENT THAT VISION OR ROUTE OF TRAVEL FOR VEHICULAR, PEDESTRIAN, OR BICYCLE TRAFFIC IS IMPEDED.
 - TREE MAINTENANCE SHALL BE IN ACCORDANCE WITH THE STANDARDS OF THE INTERNATIONAL SOCIETY OF ARBORICULTURE.
 - TREE STAKING MATERIALS, IF USED, SHALL BE REMOVED AFTER (1) GROWING SEASON, NO MORE THAN (1) YEAR AFTER INSTALLATION (STEEL TREE STAKES, WIRES, AND HOSES ARE PROHIBITED).

- TREE PROTECTION NOTES:**
- CONTACT DEVELOPMENT SERVICES FOR A TREE REMOVAL PERMIT PRIOR TO REMOVAL OR TRANSPLANTING OF ANY TREES.
 - ALL TREES WHICH ARE TO REMAIN ON SITE SHALL BE PROTECTED WITH A (4') TALL BRIGHTLY COLORED PLASTIC FENCE, OR SILT FENCE, PLACED AT THE DRIP LINE OF THE TREES.
 - PRIOR TO THE PRE-CONSTRUCTION MEETING OR OBTAINING A GRADING PERMIT, ALL TREE MARKINGS AND PROTECTIVE FENCING SHALL BE INSTALLED BY THE OWNER AND BE INSPECTED BY DEVELOPMENT SERVICES.
 - NO EQUIPMENT SHALL BE CLEANED, OR HARMFUL LIQUIDS DEPOSITED WITHIN THE LIMITS OF THE ROOT ZONE OF TREES WHICH REMAIN ON SITE.
 - NO SIGNS, WIRES, OR OTHER ATTACHMENTS SHALL BE ATTACHED TO ANY TREE TO REMAIN ON SITE.
 - VEHICULAR AND CONSTRUCTION EQUIPMENT SHALL NOT PARK OR DRIVE WITHIN THE LIMITS OF THE DRIP LINE.
 - GRADE CHANGES IN EXCESS OF 3 INCHES (CUT OR FILL) SHALL NOT BE ALLOWED WITHIN A ROOT ZONE, UNLESS ADEQUATE TREE PRESERVATION METHODS ARE APPROVED BY THE CITY.
 - NO TRENCHING SHALL BE ALLOWED WITHIN THE DRIP-LINE OF A TREE, UNLESS APPROVED BY THE CITY.
 - ALL REMOVED TREES SHALL BE CHIPPED AND USED FOR MULCH ON SITE OR HAULED OFF-SITE.
 - ALL TREE MAINTENANCE TECHNIQUES SHALL BE IN CONFORMANCE WITH INDUSTRY IDENTIFIED STANDARDS. IMPROPER OR MALICIOUS PRUNING TECHNIQUES ARE STRICTLY PROHIBITED.


ALL RESPONSIBILITY FOR ADEQUACY OF DESIGN REMAINS WITH THE DESIGN ENGINEER. THE CITY OF ROCKWALL, IN REVIEWING AND RELEASING PLANS FOR CONSTRUCTION, ASSUMES NO RESPONSIBILITY FOR ADEQUACY OR ACCURACY OF DESIGN.

APPROVED:
I hereby certify that the above and foregoing site plan for a development in the City of Rockwall, Texas, was approved by the Planning & Zoning Commission of the City of Rockwall on the ___ day of ___, ___.


WITNESS OUR HANDS, this ___ day of ___, ___.

Planning & Zoning Commission, Chairman


Director of Planning and Zoning

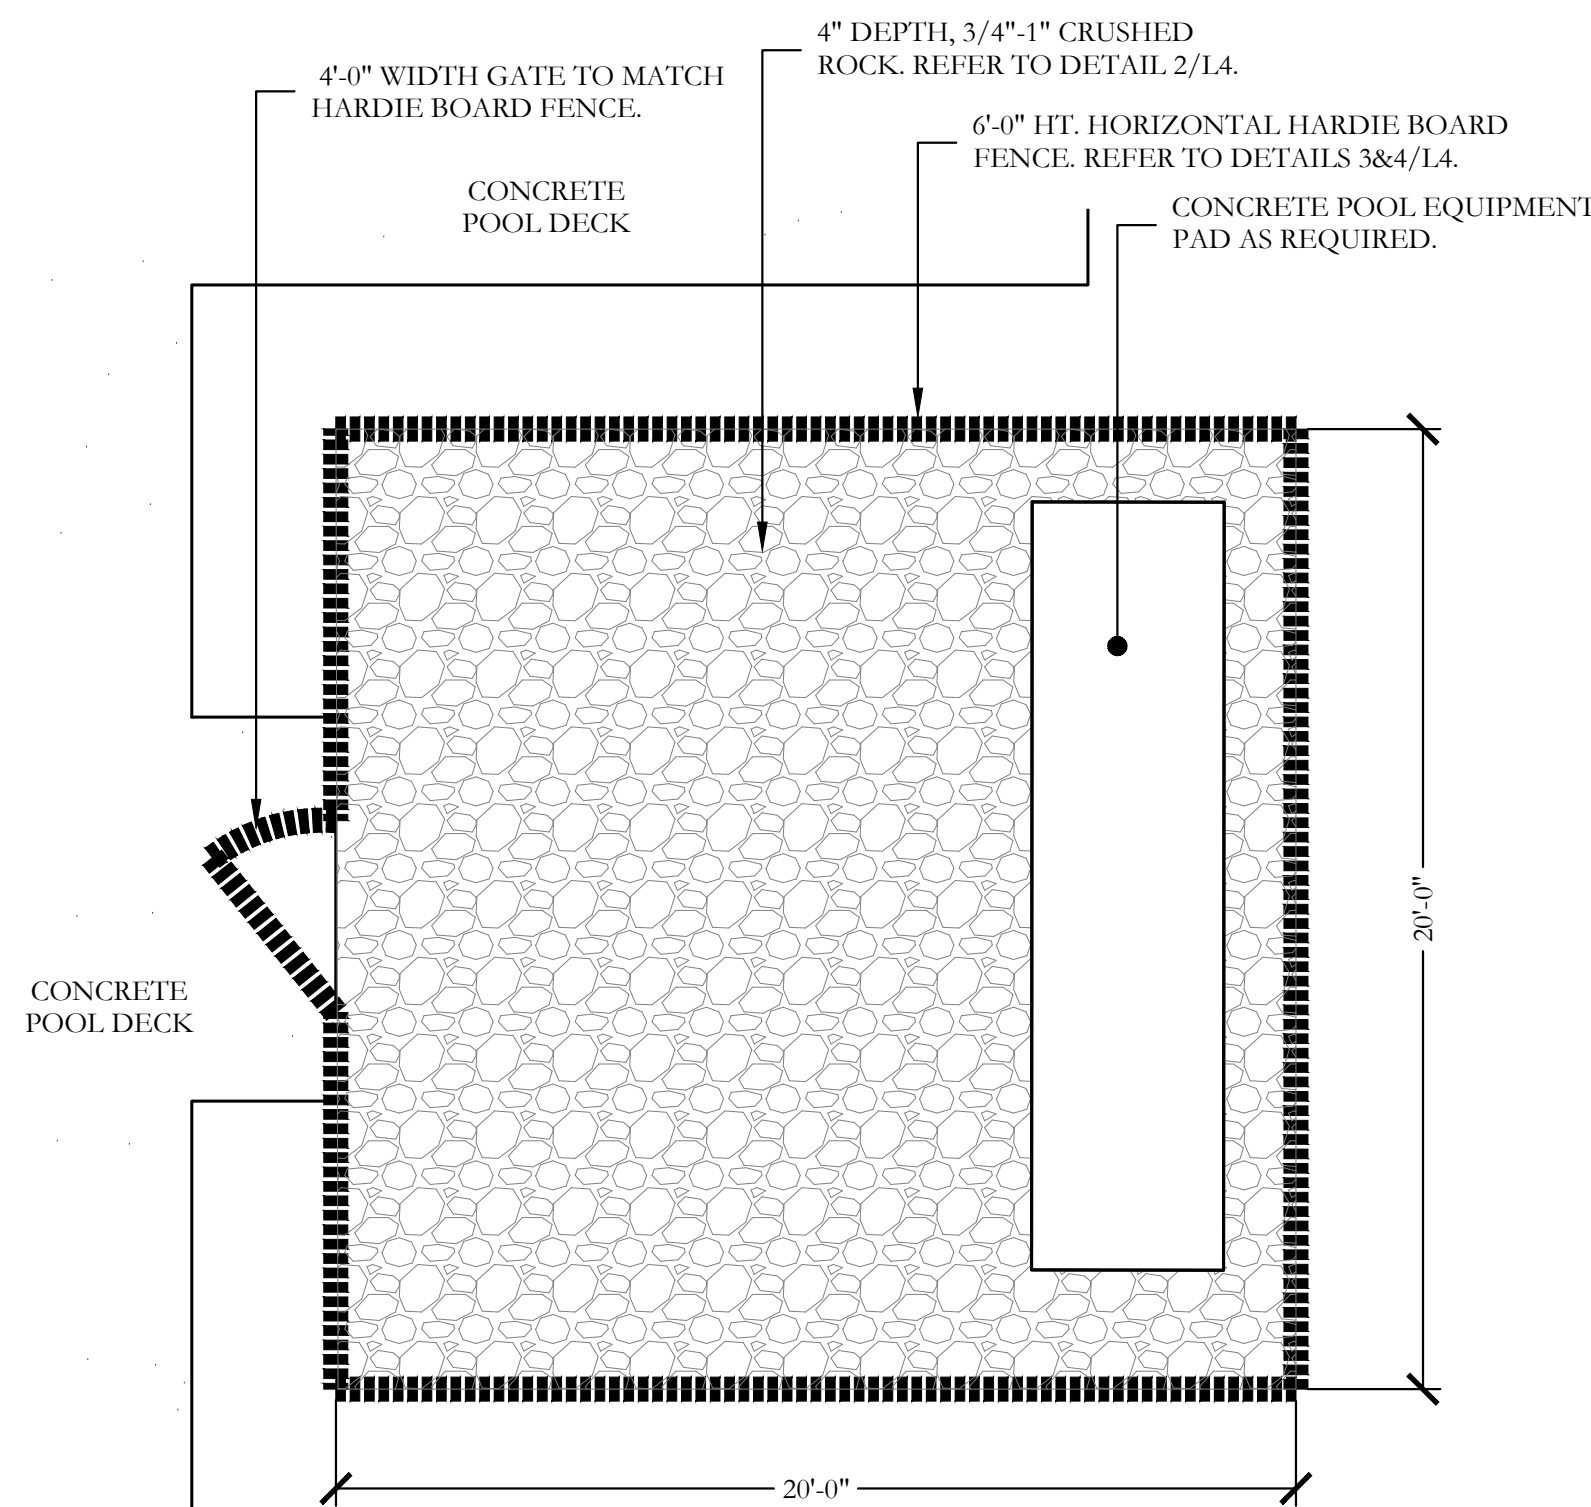

1 POOL EQUIPMENT & TRASH TOTE ENCLOSURE PLAN
SCALE: 1/4" = 1'-0"

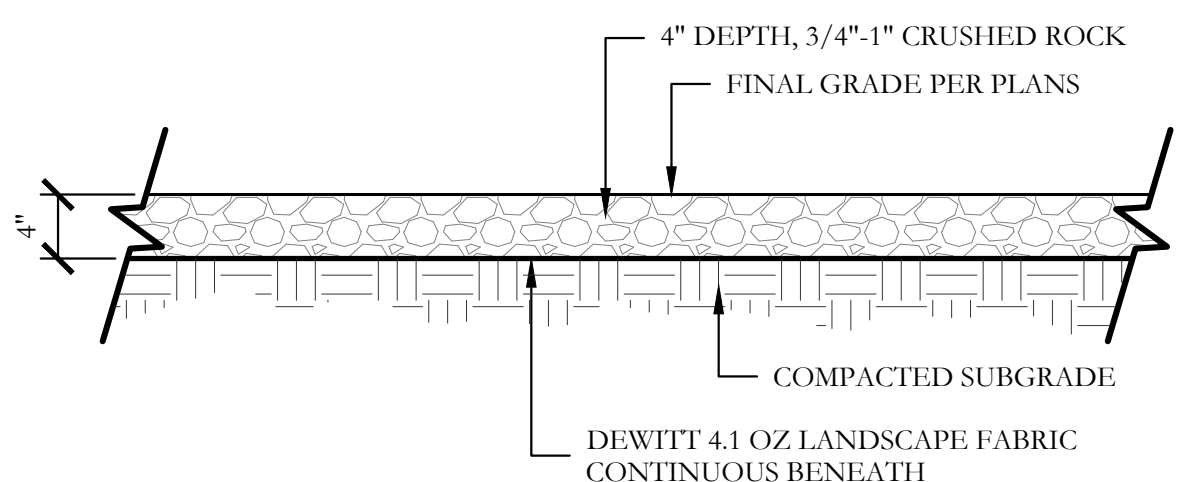

2 CRUSHED ROCK BASE SECTION
SCALE: 1" = 1'-0"

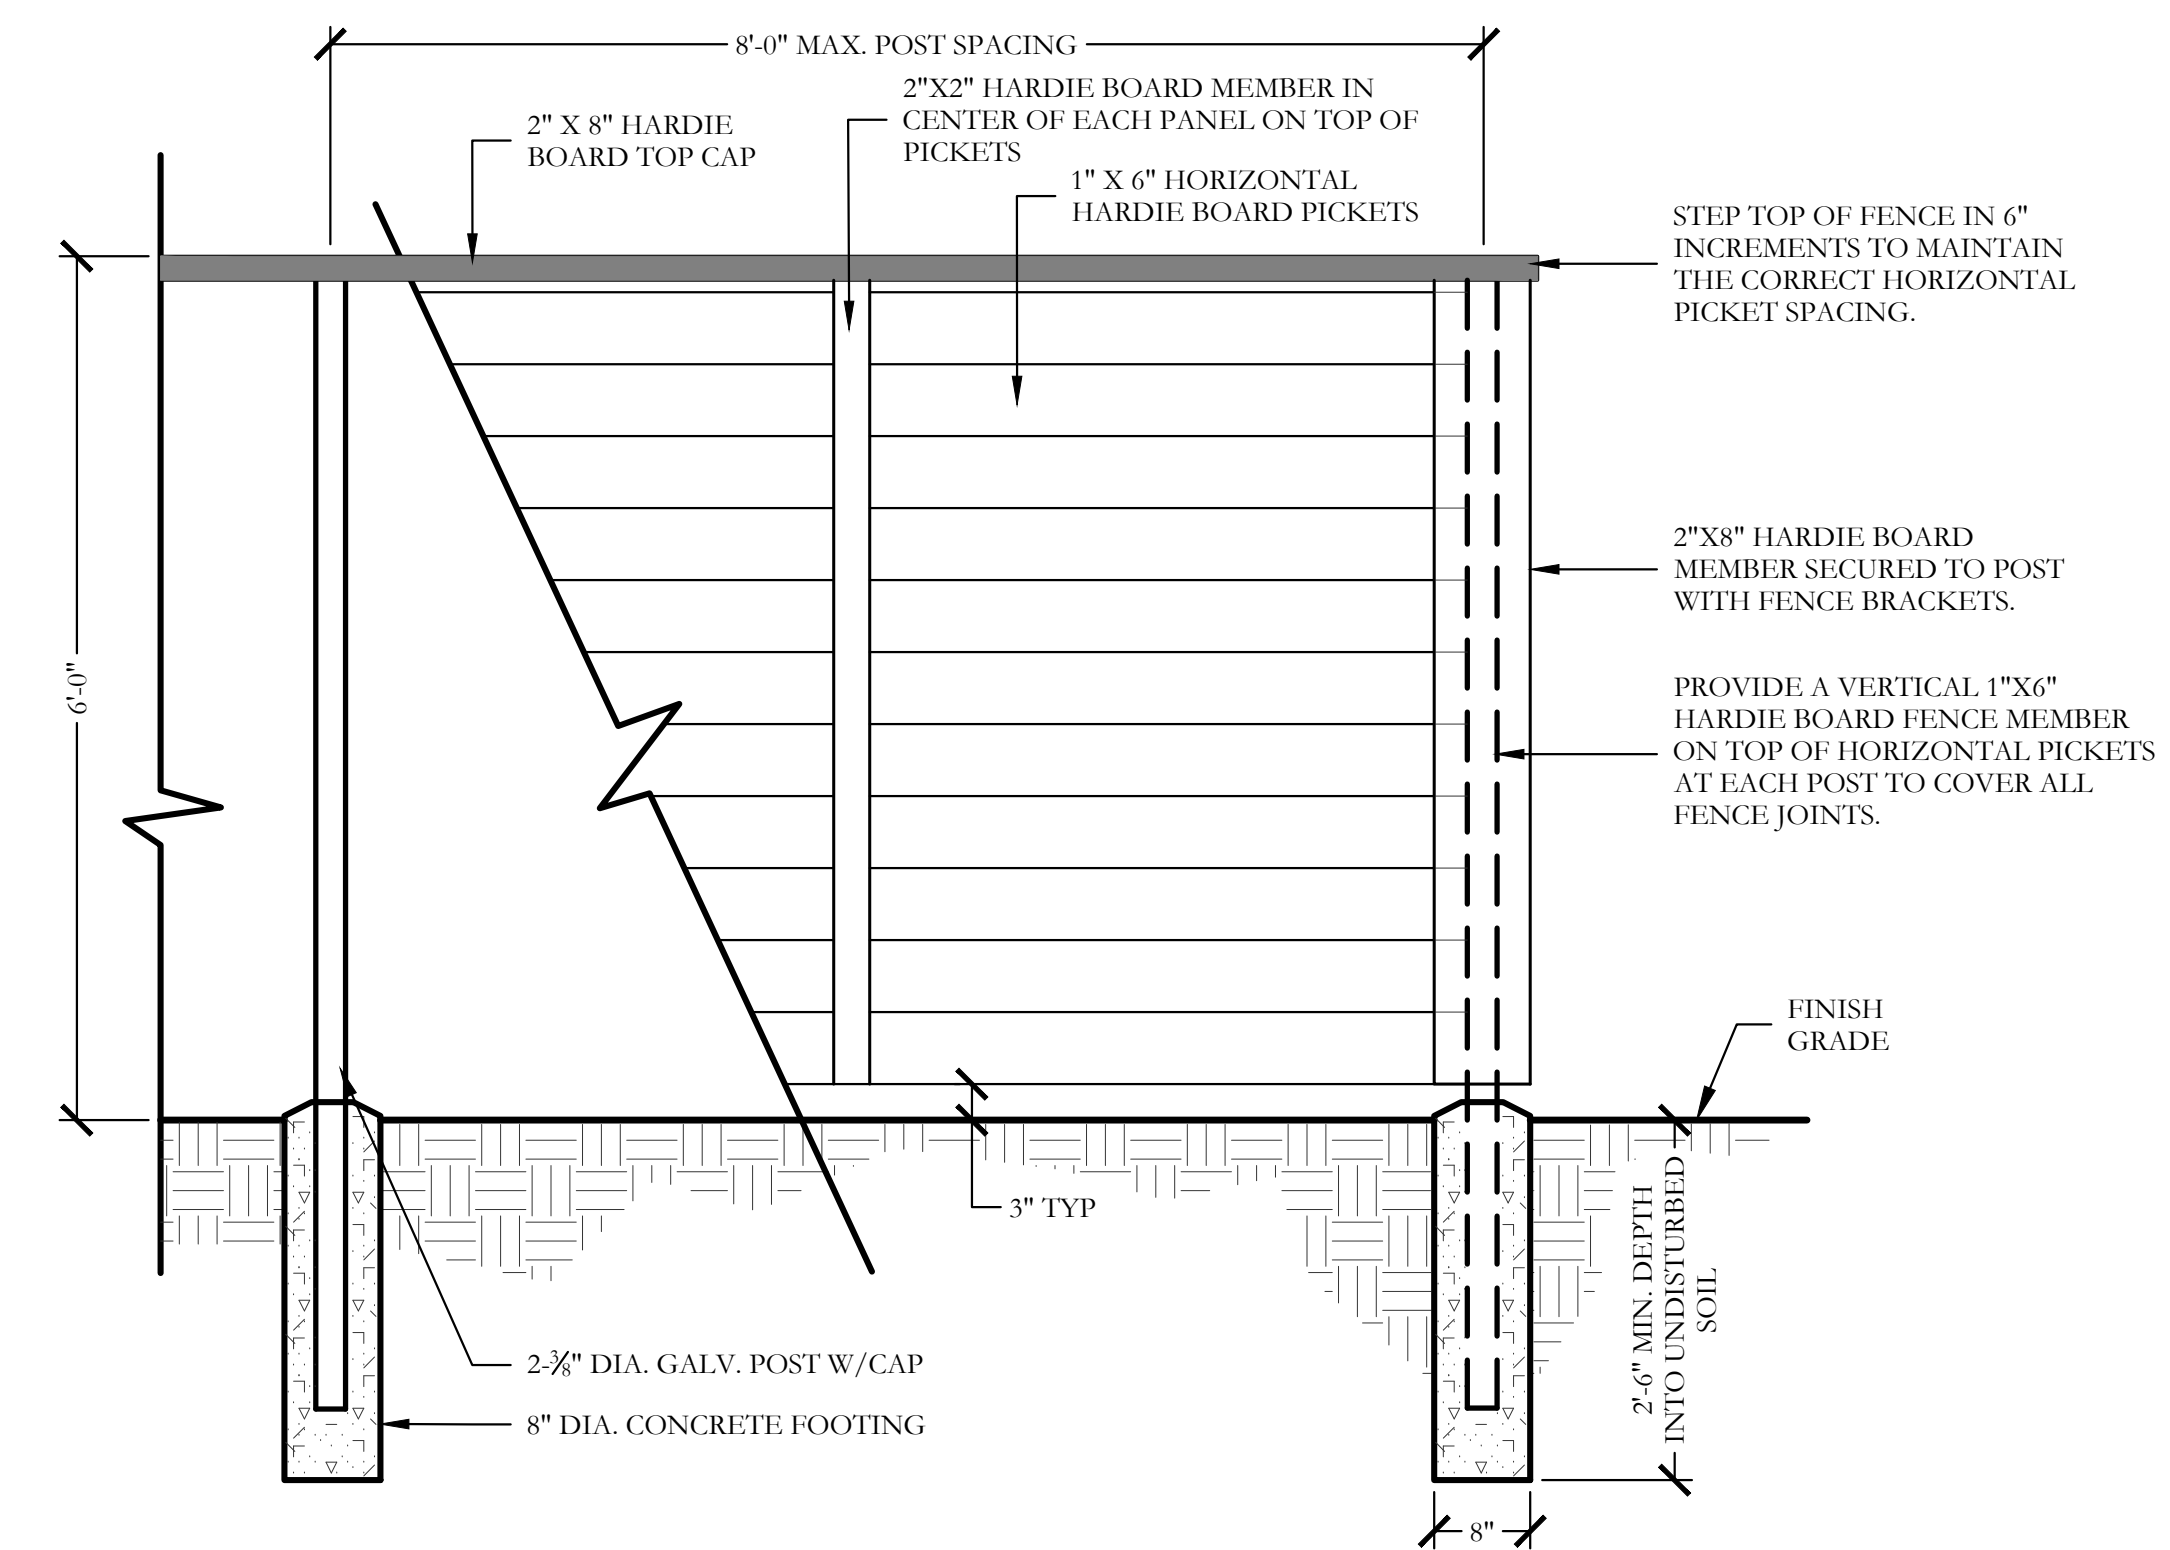


3 6'-0" HT. HORIZONTAL HARDIE BOARD FENCE ELEVATION
SCALE: 3/4" = 1'-0"

HORIZONTAL HARDIE BOARD FENCE NOTES


1. THE CONTRACTOR IS RESPONSIBLE FOR MAKING HIMSELF FAMILIAR WITH ALL UNDERGROUND UTILITIES, PIPES, AND STRUCTURES EITHER SHOWN OR NOT SHOWN ON THE PLANS. THE CONTRACTOR WILL BE RESPONSIBLE FOR ANY COST INCURRED DUE TO DAMAGE OR REPLACEMENT OF SAID UTILITIES AND STRUCTURES CAUSED BY HIS FORCES VERIFY LOCATION OF ALL UTILITIES WITH THE TOWN AND VARIOUS UTILITY COMPANIES BEFORE DRILLING PIERS.
2. ALL CONCRETE USED IN FOOTINGS SHALL HAVE A MINIMUM COMPRESSIVE STRENGTH OF 3000 PSI @ 28 DAYS.
3. THE CONTRACTOR IS RESPONSIBLE FOR ALL NECESSARY AND REQUIRED PERMITS AND INSPECTIONS. CONSTRUCTION SHALL BE IN ACCORDANCE WITH CITY OF ROCKWALL CODES AND REQUIREMENTS.
4. HARDIE BOARD MATERIAL FOR FENCE
 - 4.1. STRINGERS - HARDIE BOARD MATERIAL OR BETTER.
 - 4.2. PICKETS - HARDIE BOARD MATERIAL OR BETTER.
 - 4.3. CAPS - HARDIE BOARD MATERIAL OR BETTER.
5. ALL FENCE POST TO BE SCHEDULE 40 - GALVANIZED.
6. ALL FASTENERS, NAILS, BRACKETS, STEEL POSTS, ETC. ARE TO BE HOT DIPPED GALVANIZED.
7. ALL PICKETS ARE TO BE FASTENED TO THE RAILS USING GALVANIZED SCREWS, STAPLES AND/OR NAILS WILL NOT BE ALLOWED. SCREW WITHOUT SPLITTING MEMBERS, DRILL PILOT HOLES IF NECESSARY. ALL SPLIT MEMBERS WILL BE REQUIRED TO BE REPLACED AT NO ADDITIONAL COST TO THE OWNER.
8. ACCURATELY CUT, FIT FASTEN MEMBERS, MAKE PLUMB, LEVEL, TRUE, AND RIGID. DO NOT SPLICE INDIVIDUAL FRAMING MEMBERS BETWEEN SUPPORTS. ERECT FACES OF FRAMING MEMBERS IN STRAIGHT EVEN PLANES TO RECEIVE FINISH MATERIALS. INSTALL STRINGERS WITH BOTTOM EDGES FREE OF DEFECTS. MITER ALL EXPOSED FINISHED JOINTS.
9. REMOVE ALL MARKS, STAMPS, DIRT, LOOSE FIBERS FROM ALL MATERIAL SURFACES.
10. CONTRACTOR IS RESPONSIBLE FOR OBTAINING ALL REQUIRED PERMITS.
11. ALL HARDIE BOARD MEMBERS SHALL RECEIVE TWO COATS OF MARINE GRADE PAINT; FINISH AND COLOR SHALL MATCH THE BUILDING FACILITY.

ORNAMENTAL METAL FENCE NOTES


1. THE CONTRACTOR IS RESPONSIBLE FOR MAKING HIMSELF FAMILIAR WITH ALL UNDERGROUND UTILITIES, PIPES, AND STRUCTURES EITHER SHOWN OR NOT SHOWN ON THE PLANS. THE CONTRACTOR WILL BE RESPONSIBLE FOR ANY COST INCURRED DUE TO DAMAGE OR REPLACEMENT OF SAID UTILITIES AND STRUCTURES CAUSED BY HIS FORCES.
2. ALL CONCRETE USED IN FOOTING AND PIERS SHALL HAVE A MINIMUM COMPRESSIVE STRENGTH OF 3000 PSI @ 28 DAYS.
3. THE CONTRACTOR IS RESPONSIBLE FOR ALL REQUIRED PERMITS AND CITY INSPECTIONS.
4. ALL ORNAMENTAL METAL TUBES, POSTS, RAILS AND PICKETS SHALL BE FLUSH AND FREE OF ALL DENTS, SPURS, AND SHARP EDGES AND SHALL BE INSTALLED LEVEL, PLUMB, AND SQUARE.
5. PROVIDE CONTINUOUS WELDS ALONG ALL EDGES OF FENCE MEMBERS. GRIND SMOOTH ALL WELDS.
6. ALL METAL SURFACES SHALL BE PRIMED AND PAINTED WITH TWO COATS OF URBANE BRONZE (SW7048) BY SHERWIN WILLIAMS PAINT CO., COLOR TO BE FLAT BLACK. CONTRACTOR TO SUBMIT SAMPLES AS REQUIRED.
7. CONTRACTOR IS RESPONSIBLE FOR VERIFYING ALL DIMENSIONS BEFORE MANUFACTURING GATES AND FENCE.
8. ALL ORNAMENTAL METAL FENCE MEMBERS ARE TO BE TUBULAR MEMBERS IN ACCORDANCE WITH ASTM 513 HOT ROLLED STRUCTURAL STEEL 50,000 PSI TENSILE STRENGTH, 60,000 PSI YIELD STRENGTH.
9. FENCE MEMBER SIZES TO BE AS FOLLOWS:
 - 9.1. PICKETS, 3/4" SQUARE 16 GA.
 - 9.2. RAILS, 1-1/2" X 1-1/2" TUBE 16 GA.
 - 9.3. POSTS, 2" SQUARE 11 GA.
10. CONTRACTOR TO PROVIDE SHOP DRAWINGS FOR ALL FENCE GATES AND OPENERS. SHOP DRAWINGS SHALL INCLUDE ALL PRODUCT CUT SHEETS AS WELL AS INSTALLATION AND MANUFACTURING DETAILS. CONTRACTOR TO BE RESPONSIBLE FOR STRUCTURAL DESIGN OF GATES.
11. CONCRETE FOOTING FOR POSTS SHALL BE 3X POST WIDTH.
12. GATE IS TO BE SELF-CLOSING. FALCON B561DBD626 SATIN CHROME DANE SFC CLASSROOM LOCK BY A&H TURF OR APPROVED EQUAL. DEADLOCKING LATCH BOLT BY LEVERS. OUTSIDE LEVER IS LOCKED BY KEY IN OUTSIDE LEVER. INSIDE LEVER IS ALWAYS FREE.
13. POSTS SHALL BE PLACED AT A MINIMUM DISTANCE OF 6'-0" O.C. AND A MAXIMUM DISTANCE OF 7'-0" O.C.
14. POOL FENCE SHALL MEET LOCAL CODES AND REQUIREMENTS. CONTRACTOR SHALL BE RESPONSIBLE FOR ENSURING COMPLIANCE INCLUDING NECESSARY UP-SIZING OF POSTS, PICKETS AND HORIZONTAL BARS AND INCREASING THE HEIGHT OF THE FENCE AS IT APPEARS IN THIS DETAIL AT NO ADDITIONAL COST TO THE OWNER FOR MATERIALS AND/OR LABOR.
15. LATCH SHALL BE SELF-LATCHING, ON POOL SIDE OF ENCLOSURE AT A MIN. 42" ABOVE FINISH PAVING.
16. RESTRICTIVE MESH SHALL HAVE NO OPENINGS GREATER THAN 1/2".

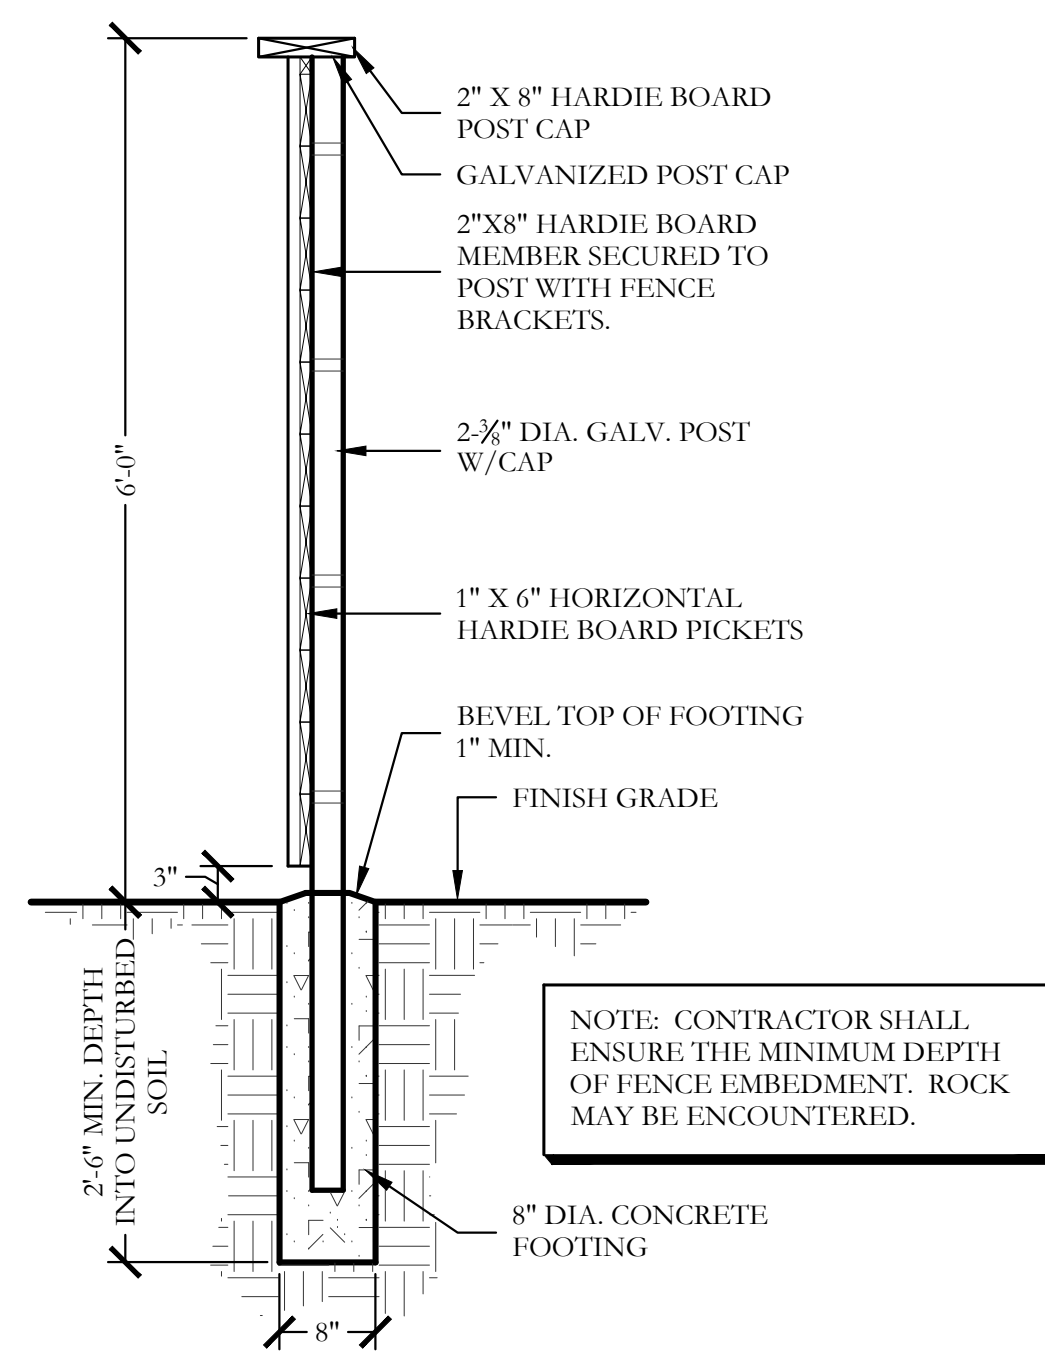


4 6'-0" HT. HARDIE BOARD FENCE SECTION
SCALE: 3/4" = 1'-0"

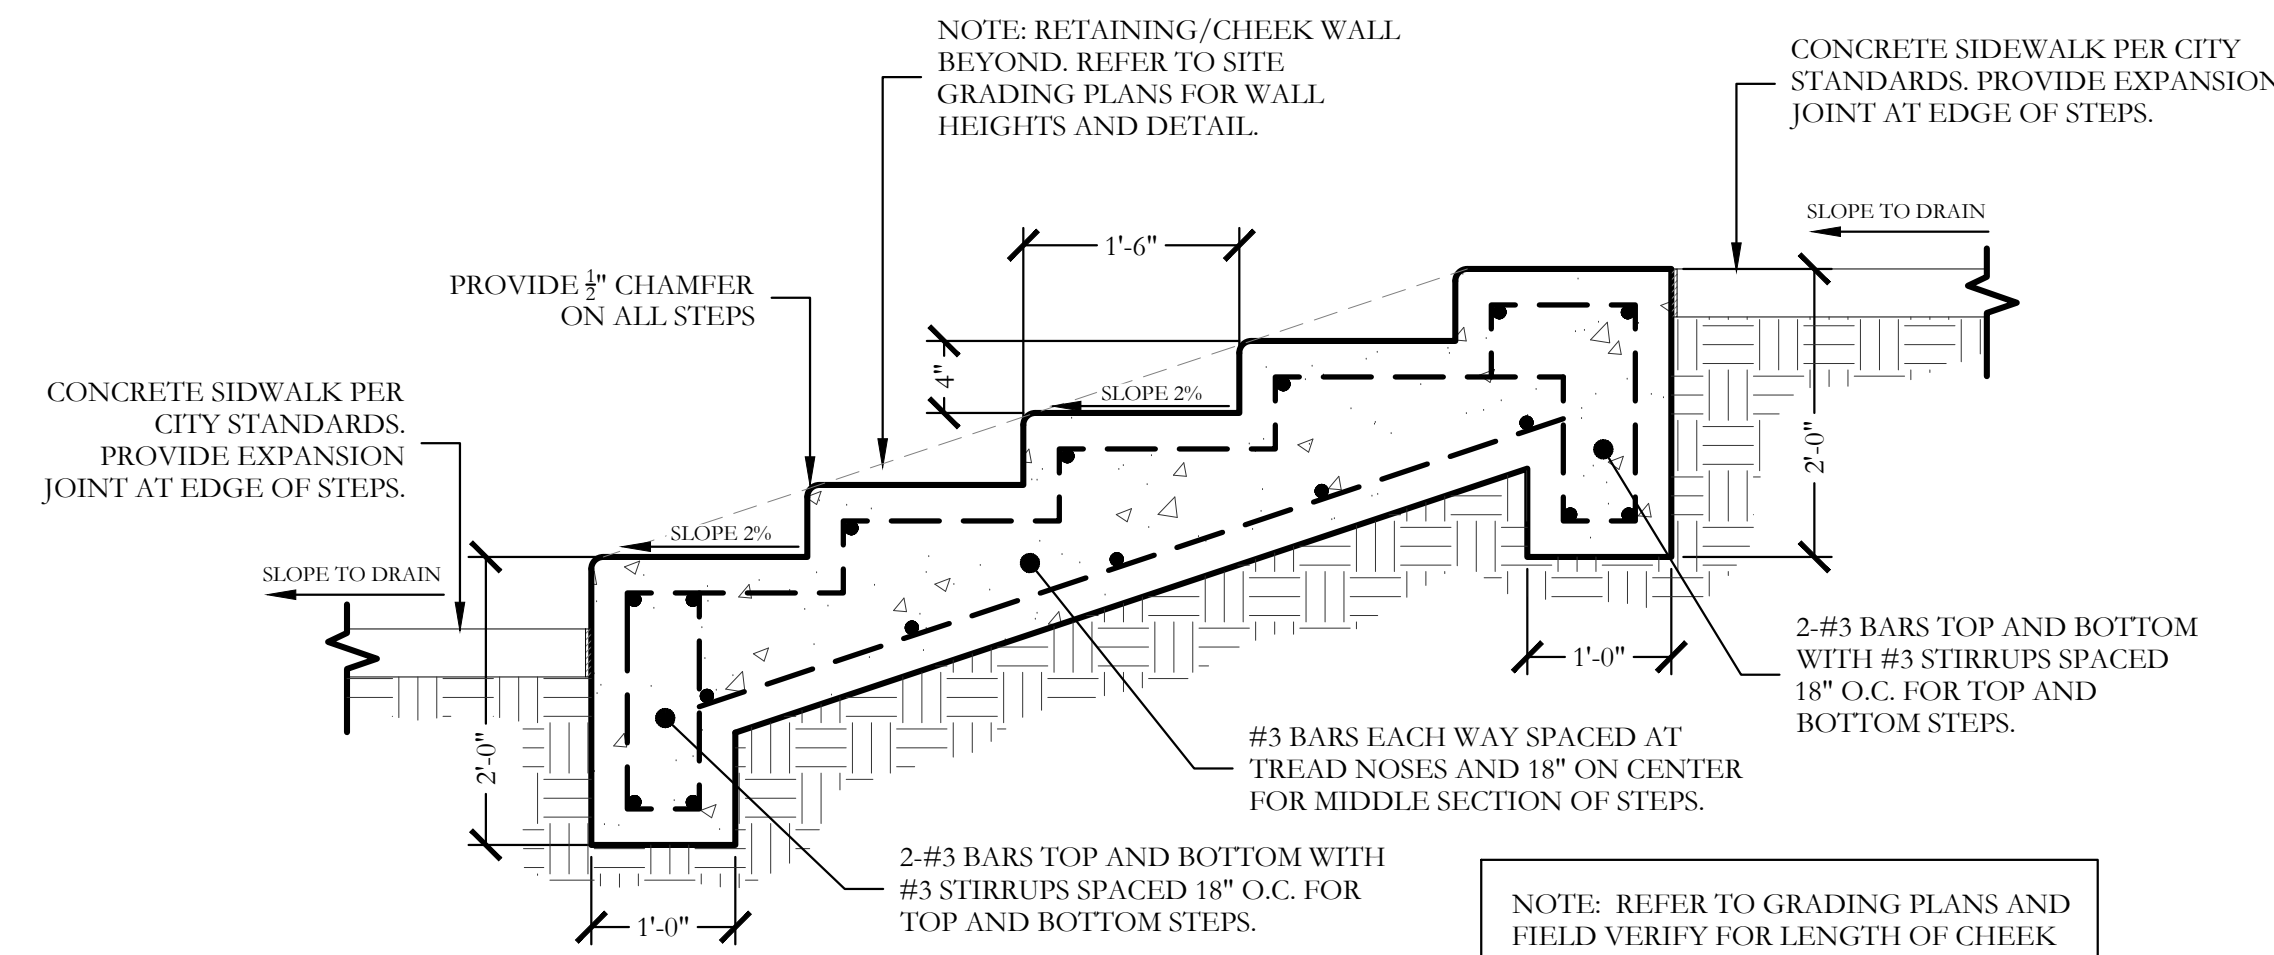

5 TYPICAL CONCRETE STAIR DETAIL SECTION
NOT TO SCALE

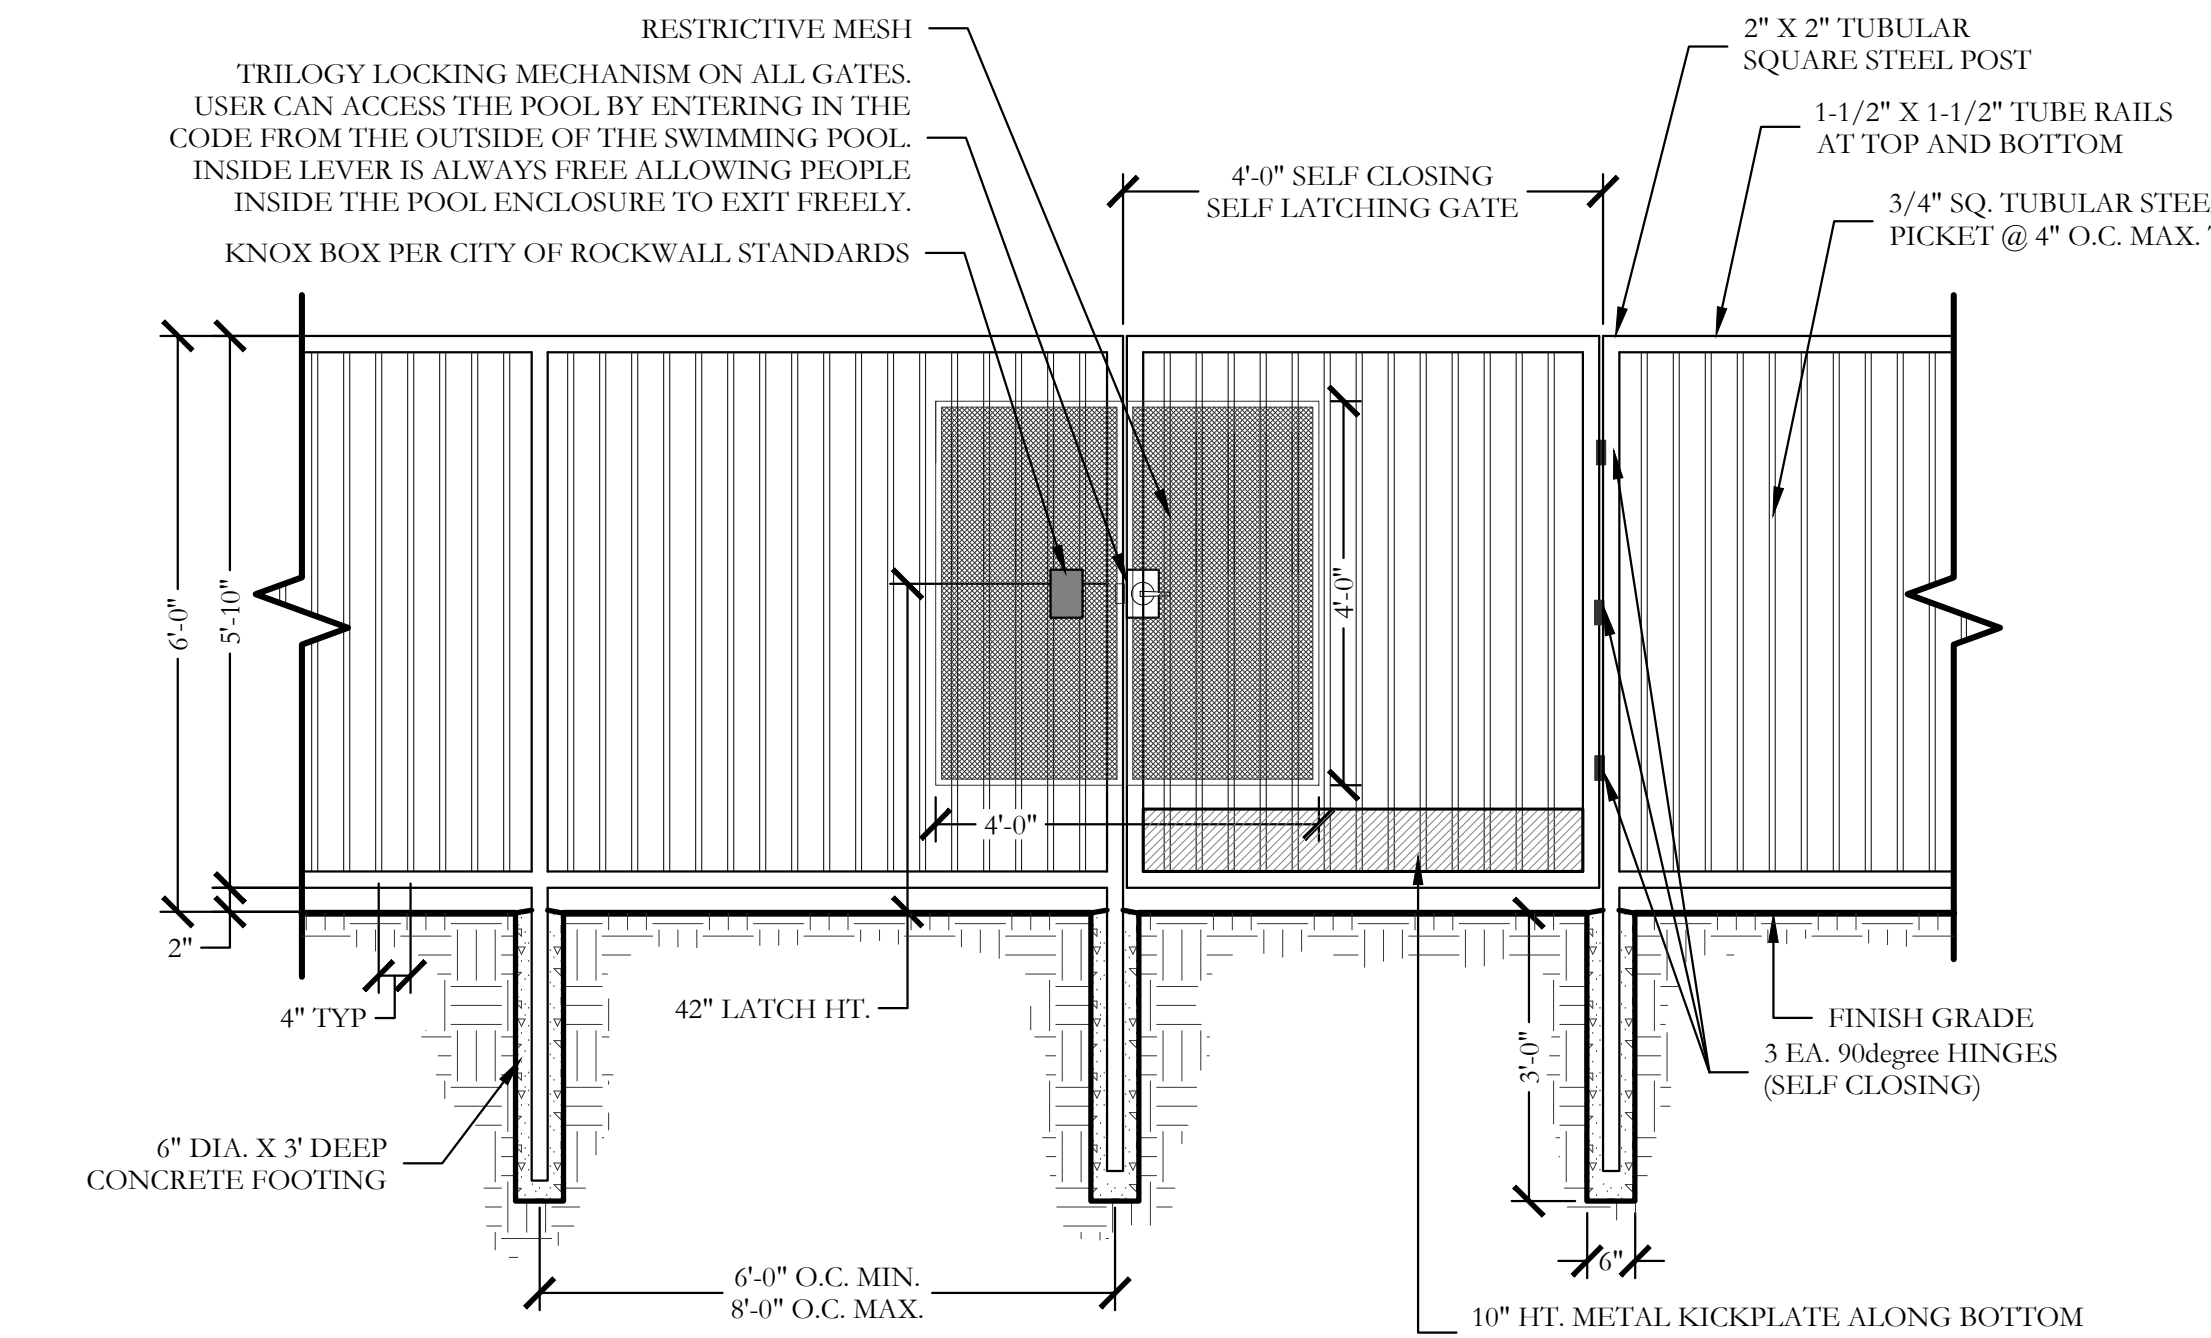

6 6'-0" HT. ORNAMENTAL METAL FENCE AND GATE ELEVATION
SCALE: 1/2" = 1'-0"

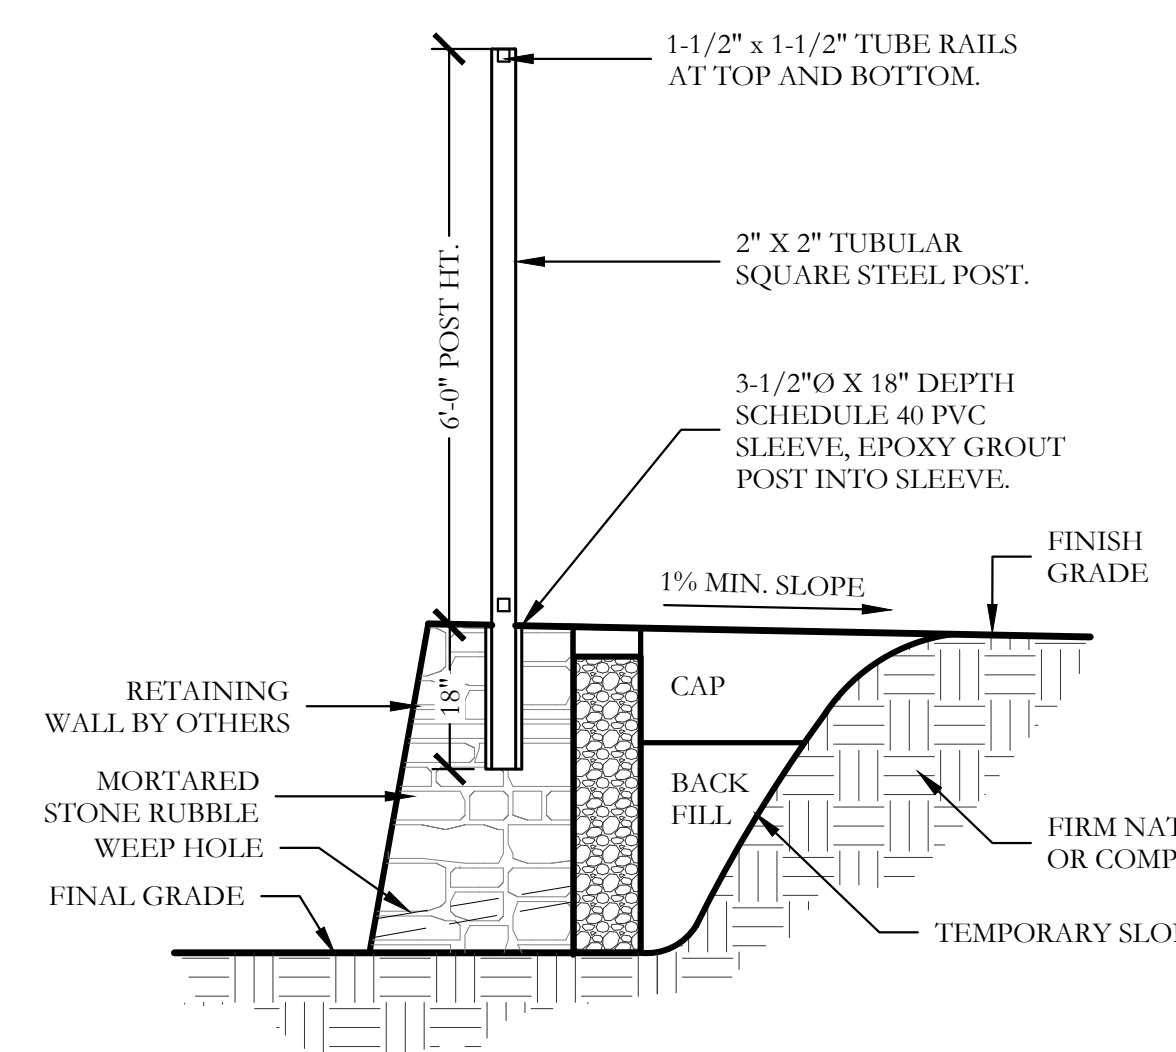

7 6'-0" HT. ORN. METAL FENCE ATOP RET. WALL SECTION
SCALE: 1/2" = 1'-0"

APPROVED:
I hereby certify that the above and foregoing site plan for a development in the City of Rockwall, Texas, was approved by the Planning & Zoning Commission of the City of Rockwall on the ___ day of ___, ___.

WITNESS OUR HANDS, this ___ day of ___, ___.

Planning & Zoning Commission, Chairman


Director of Planning and Zoning

PERMITTED BY BUILDING INSPECTORS.


ALL RESPONSIBILITY FOR ADEQUACY OF DESIGN REMAINS WITH THE DESIGN ENGINEER. THE CITY OF ROCKWALL, IN REVIEWING AND RELEASING PLANS FOR CONSTRUCTION, ASSUMES NO RESPONSIBILITY FOR ADEQUACY OR ACCURACY OF DESIGN.

ORNAMENTAL METAL FENCE NOTES


1. THE CONTRACTOR IS RESPONSIBLE FOR MAKING HIMSELF FAMILIAR WITH ALL UNDERGROUND UTILITIES, PIPES, AND STRUCTURES EITHER SHOWN OR NOT SHOWN ON THE PLANS. THE CONTRACTOR WILL BE RESPONSIBLE FOR ANY COST INCURRED DUE TO DAMAGE OR REPLACEMENT OF SAID UTILITIES AND STRUCTURES CAUSED BY HIS FORCES.
2. ALL CONCRETE USED IN FOOTING AND PIERS SHALL HAVE A MINIMUM COMPRESSIVE STRENGTH OF 3000 PSI @ 28 DAYS.
3. THE CONTRACTOR IS RESPONSIBLE FOR ALL REQUIRED PERMITS AND TOWN INSPECTIONS.
4. ALL ORNAMENTAL METAL TUBES, POSTS, RAILS AND PICKETS SHALL BE FLUSH AND FREE OF ALL DENTS, SPURS, AND SHARP EDGES AND SHALL BE INSTALLED LEVEL, PLUMB, AND SQUARE. PROVIDE CONTINUOUS WELDS ALONG ALL EDGES OF FENCE MEMBERS.
5. GRIND SMOOTH ALL WELDS.
6. ALL METAL SURFACES SHALL BE PRIMED AND PAINTED WITH TWO COATS OF RUSTPROOF PAINT, COLOR TO BE FLAT BLACK. CONTRACTOR TO SUBMIT SAMPLES AS REQUIRED.
7. CONTRACTOR IS RESPONSIBLE FOR VERIFYING ALL DIMENSIONS BEFORE MANUFACTURING GATES AND FENCE. GATE LOCKING MECHANISM SHALL BE SELECTED BY OWNER.
8. ALL ORNAMENTAL METAL FENCE MEMBERS ARE TO BE TUBULAR MEMBERS IN ACCORDANCE WITH ASTM 513 HOT ROLLED STRUCTURAL STEEL 50,000 PSI TENSILE STRENGTH, 60,000 PSI YIELD STRENGTH.
9. FENCE MEMBER SIZES TO BE AS FOLLOWS:
 101. PICKETS, 3/4" SQUARE 16 GA.
 102. RAILS, 1-1/2" X 1-1/2" TUBE 16 GA.
 103. POSTS, 2" SQUARE 11 GA.
10. CONTRACTOR TO PROVIDE SHOP DRAWINGS FOR ALL FENCE GATES AND OPENERS. SHOP DRAWINGS SHALL INCLUDE ALL PRODUCT CUT SHEETS AS WELL AS INSTALLATION AND MANUFACTURING DETAILS. CONTRACTOR TO BE RESPONSIBLE FOR STRUCTURAL DESIGN OF GATES.
11. CONCRETE FOOTING FOR POSTS SHALL BE 3X POST WIDTH FOR 2" SQUARE POSTS AND 2X POST WIDTH FOR 6" SQUARE POSTS.
12. POSTS SHALL BE PLACED AT A MINIMUM DISTANCE OF 6'-0" O.C AND A MAXIMUM DISTANCE OF 8'-0" O.C.
13. FENCE SHALL MEET LOCAL CODES AND REQUIREMENTS. CONTRACTOR SHALL BE RESPONSIBLE FOR ENSURING COMPLIANCE INCLUDING NECESSARY UPSIZING OF POSTS, PICKETS AND HORIZONTAL BARS AND INCREASING THE HEIGHT OF THE FENCE AS IT APPEARS IN THIS DETAIL AT NO ADDITIONAL COST TO THE OWNER FOR MATERIALS AND/OR LABOR.

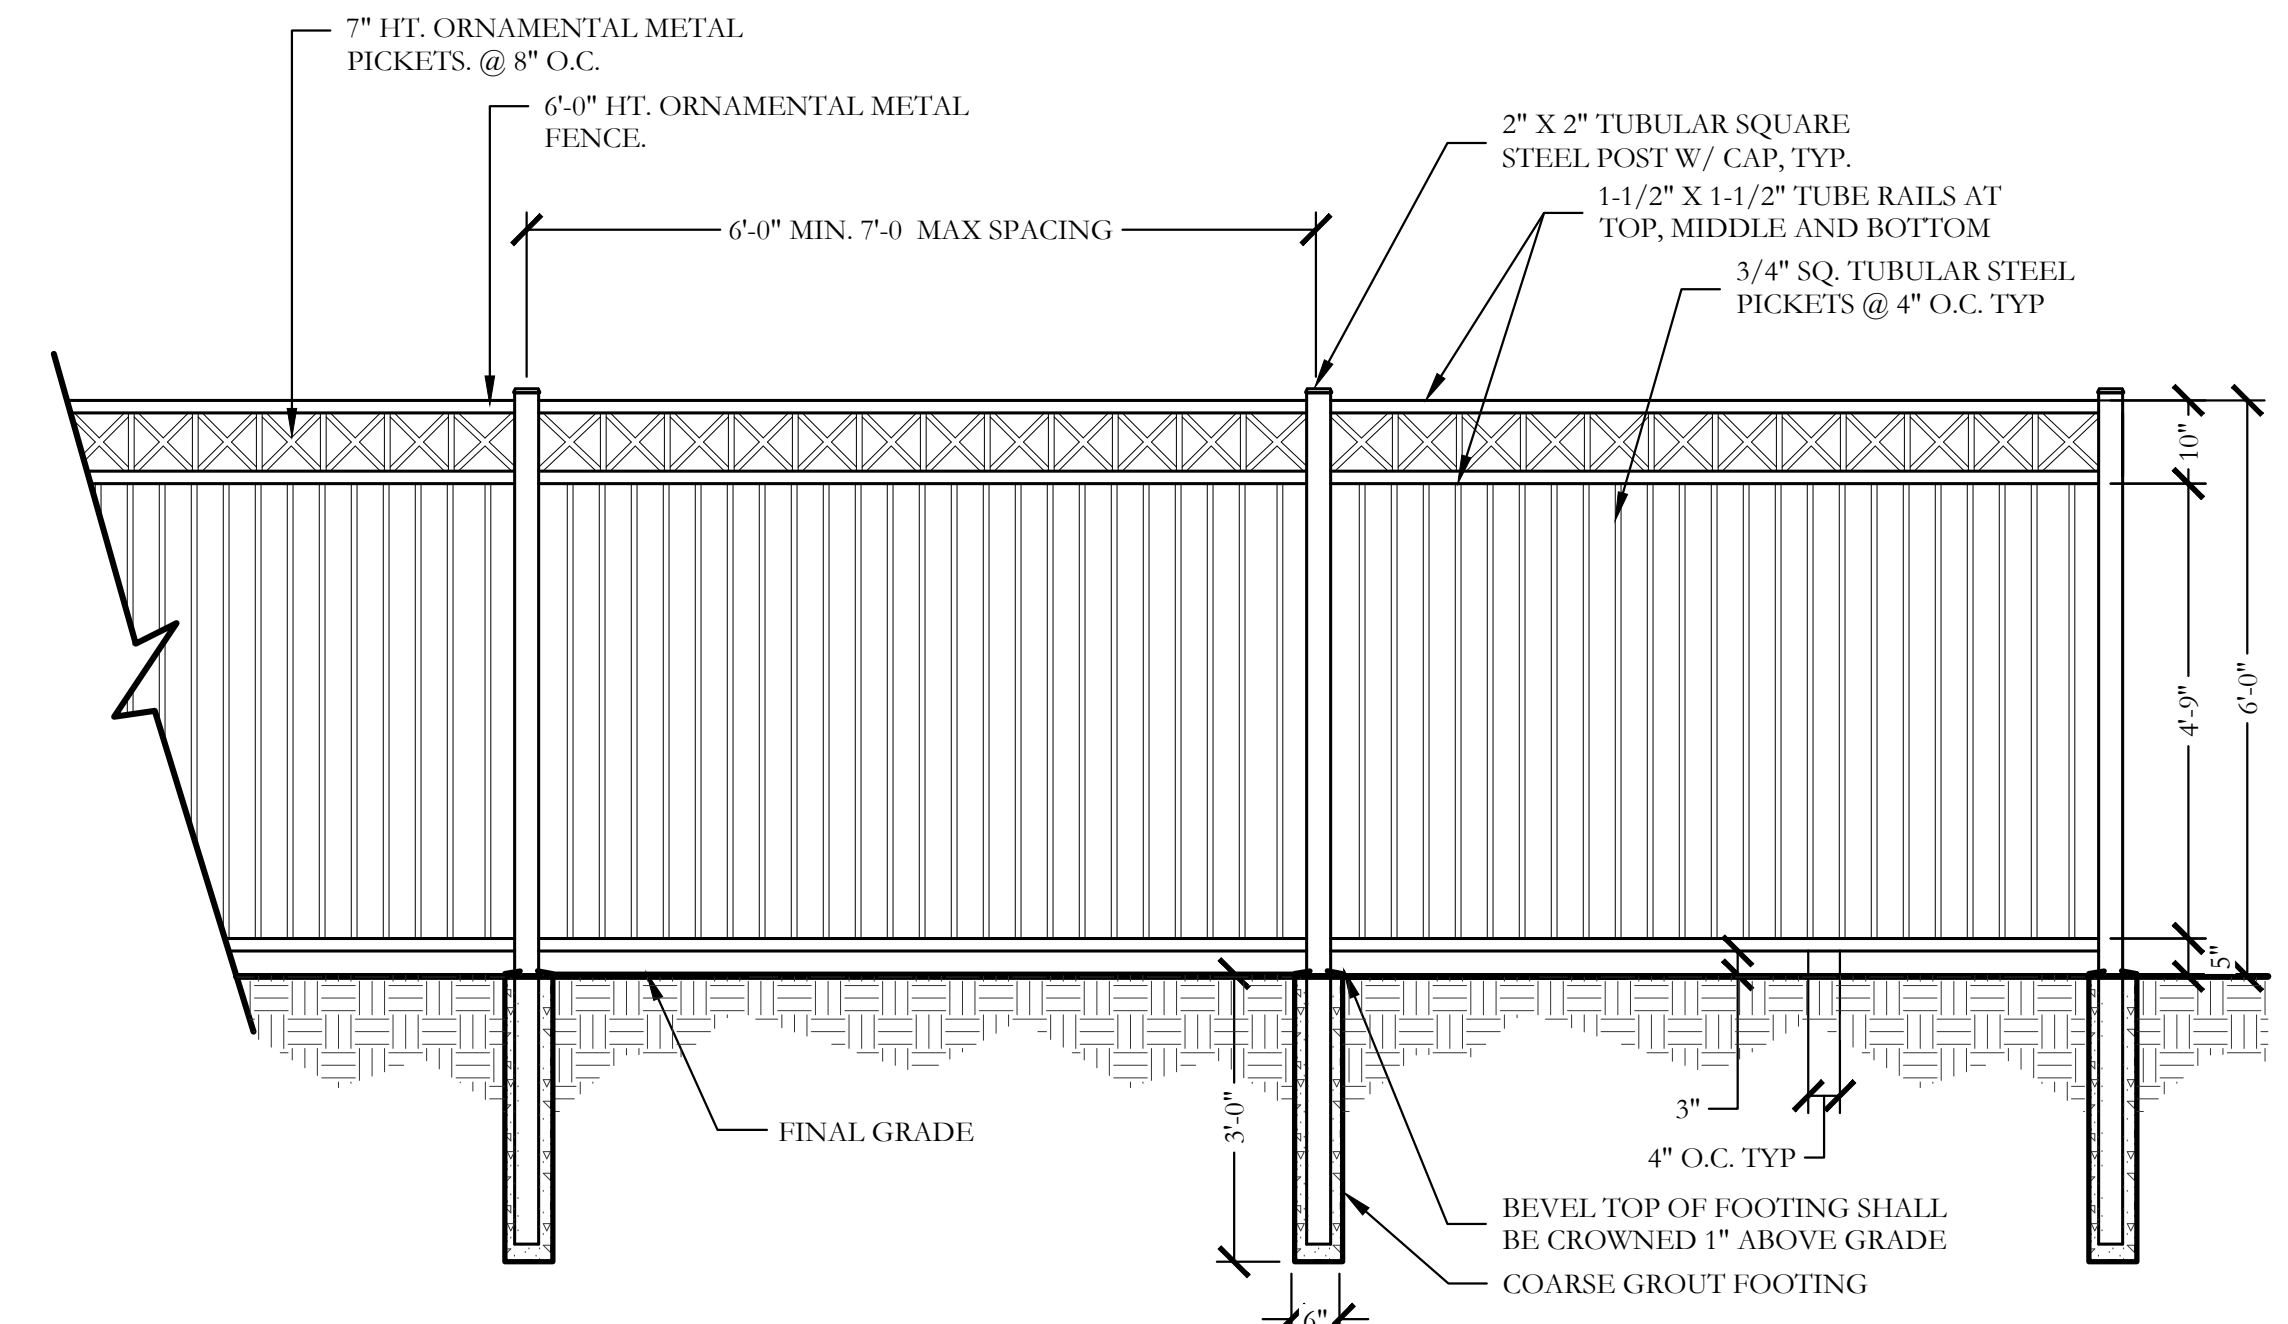


3 6'-0" HT. ORNAMENTAL METAL FENCE ELEVATION SCALE: 1/2"=1'-0"

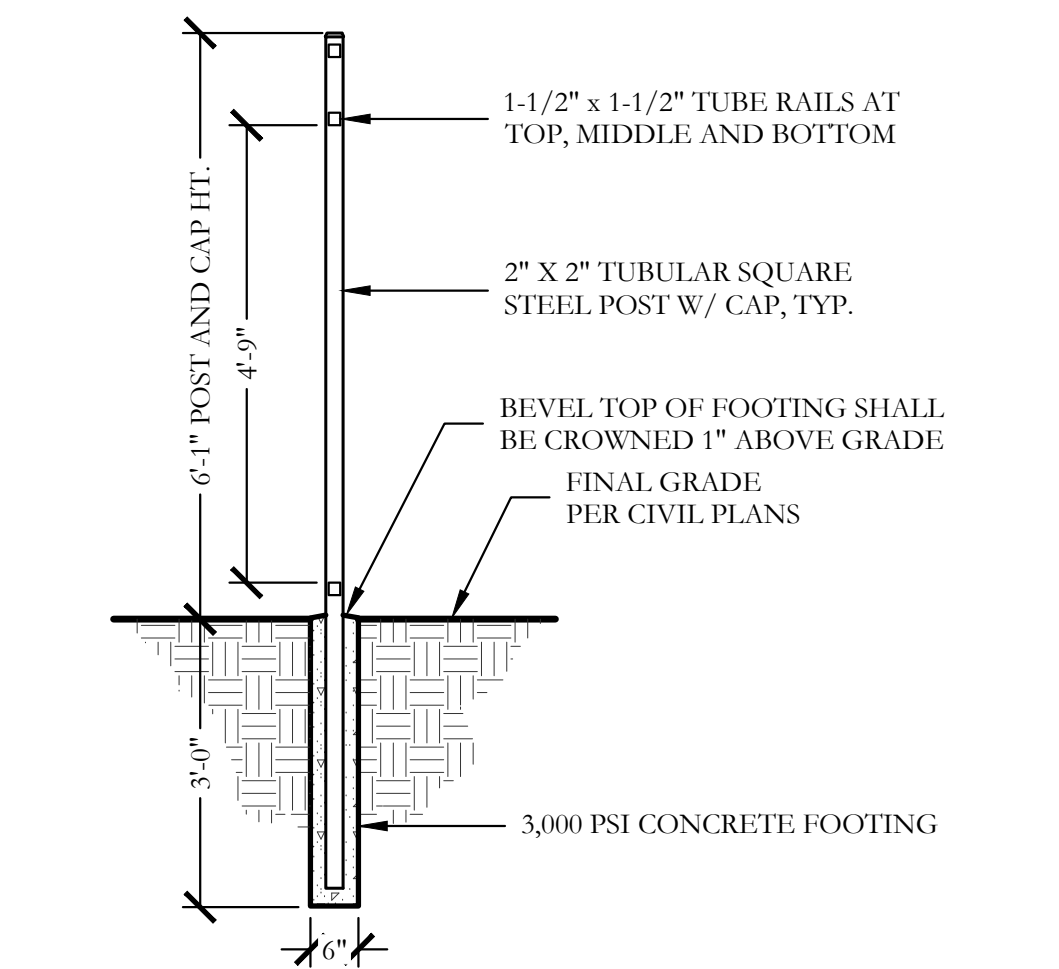

4 TYP. METAL POST FOOTING SECTION SCALE: 1/2"=1'-0"

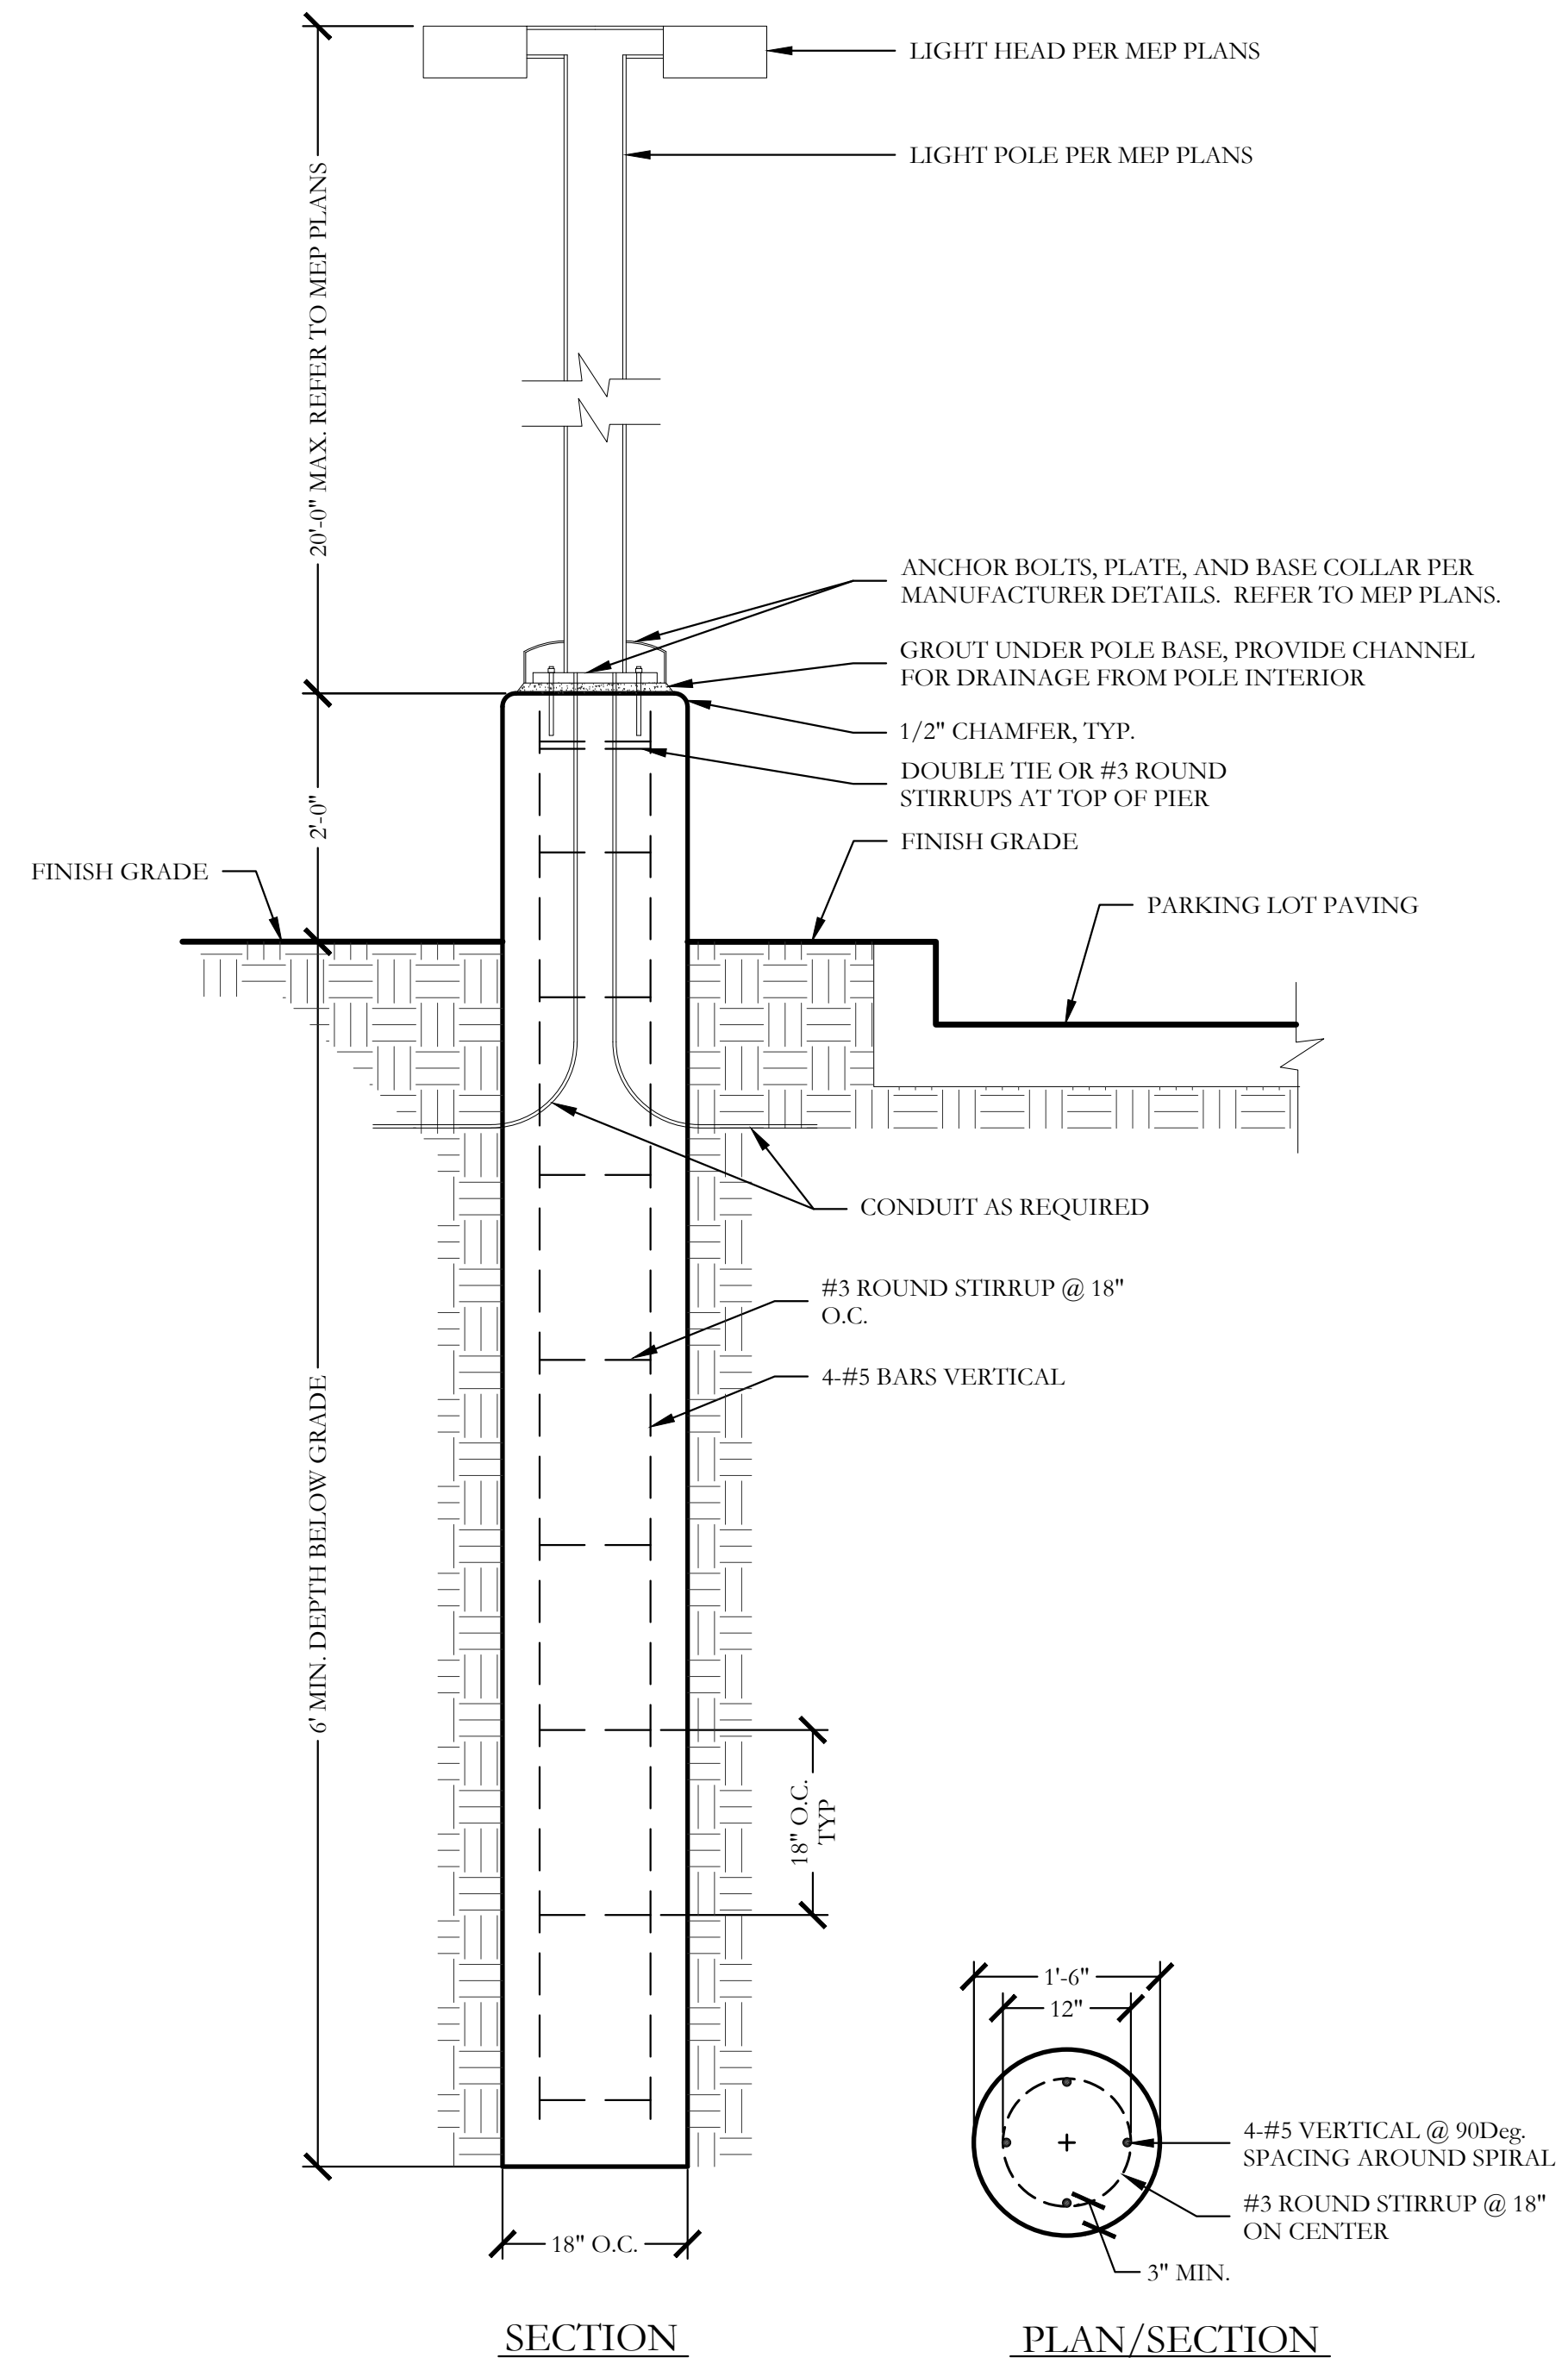

1 LIGHT POLE WITHIN PARKING LOT PLAN/SECTION SCALE: 3/4" = 1'-0"

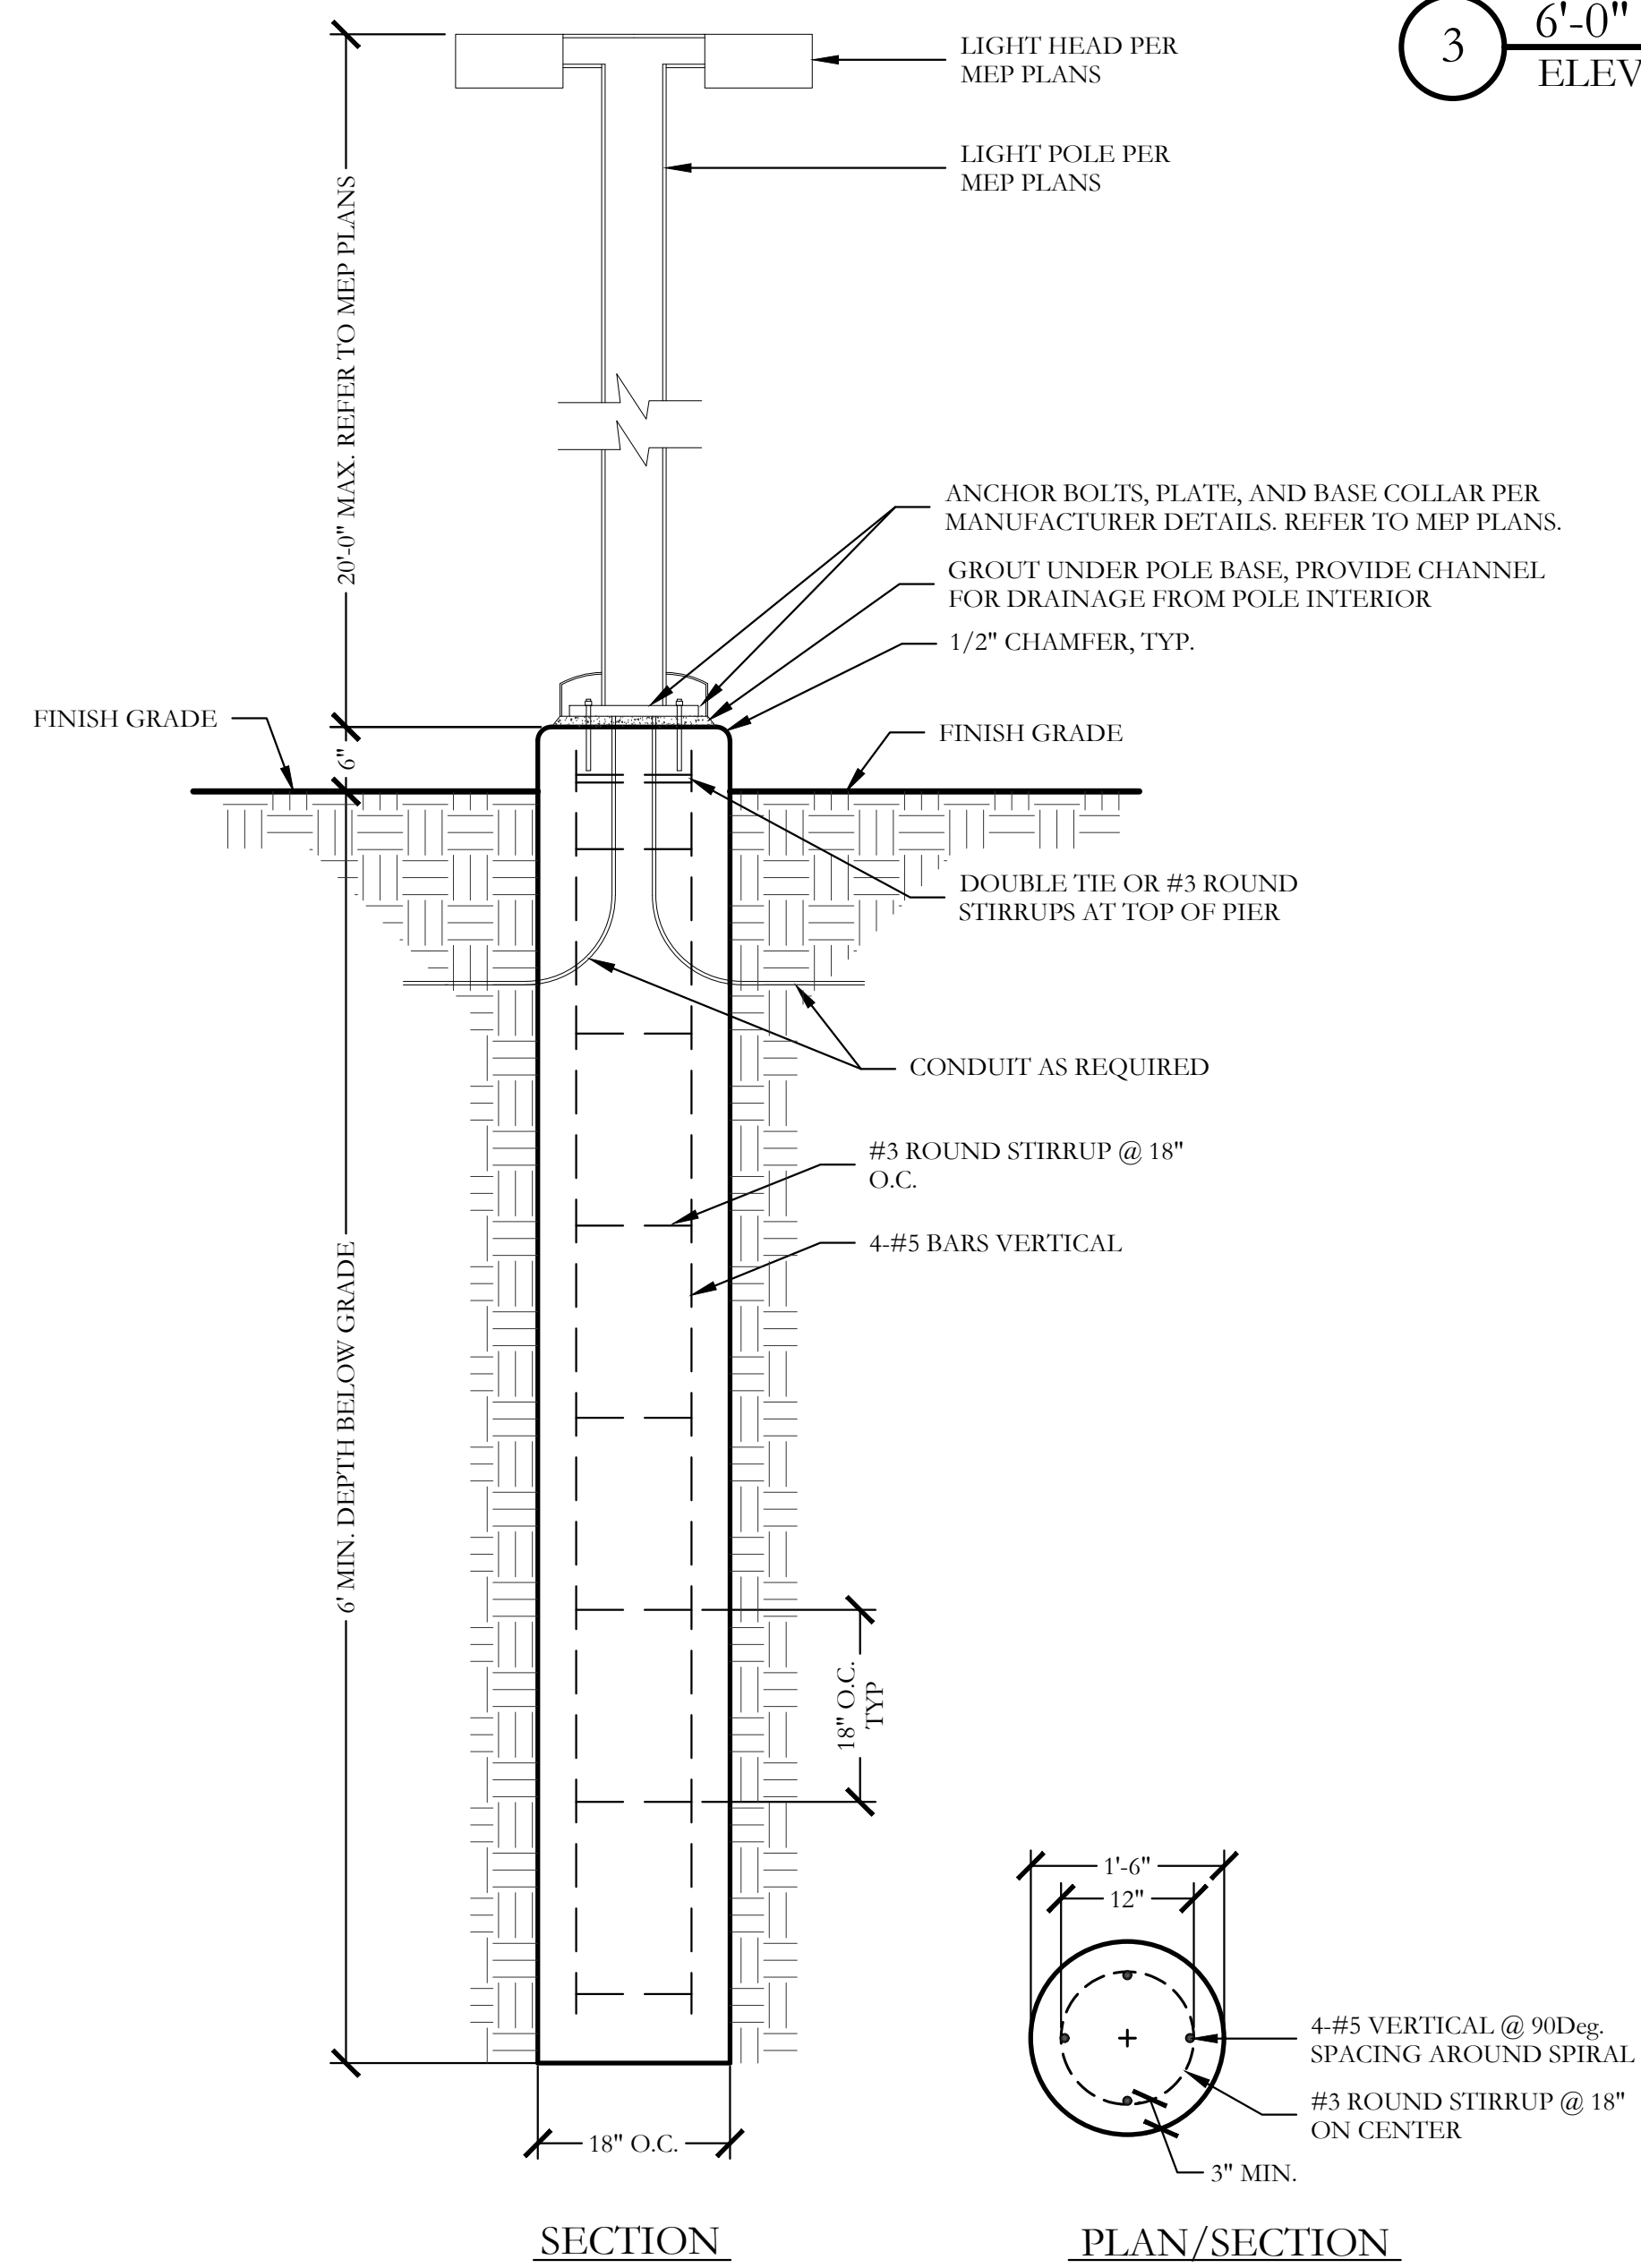

2 LIGHT POLE WITHIN POOL AREA PLAN/SECTION SCALE: 3/4" = 1'-0"

APPROVED:
 I hereby certify that the above and foregoing site plan for a development in the City of Rockwall, Texas, was approved by the Planning & Zoning Commission of the City of Rockwall on the ___ day of ___, 2023.

WITNESS OUR HANDS, this ___ day of ___, 2023.

 Planning & Zoning Commission, Chairman

 Director of Planning and Zoning


CONTRACTOR SHALL COORDINATE
MEP DRAWINGS WITH ALL OTHER
DISCIPLINES



Texas Registered Engineering Firm F-9218
5020 Temyson Parkway - Plano, TX 75024
Dallas / Fort Worth 214.432.3030
Houston 832.532.2007



**HOMESTEAD
AMENITY CENTER**
ROCKWALL, TEXAS

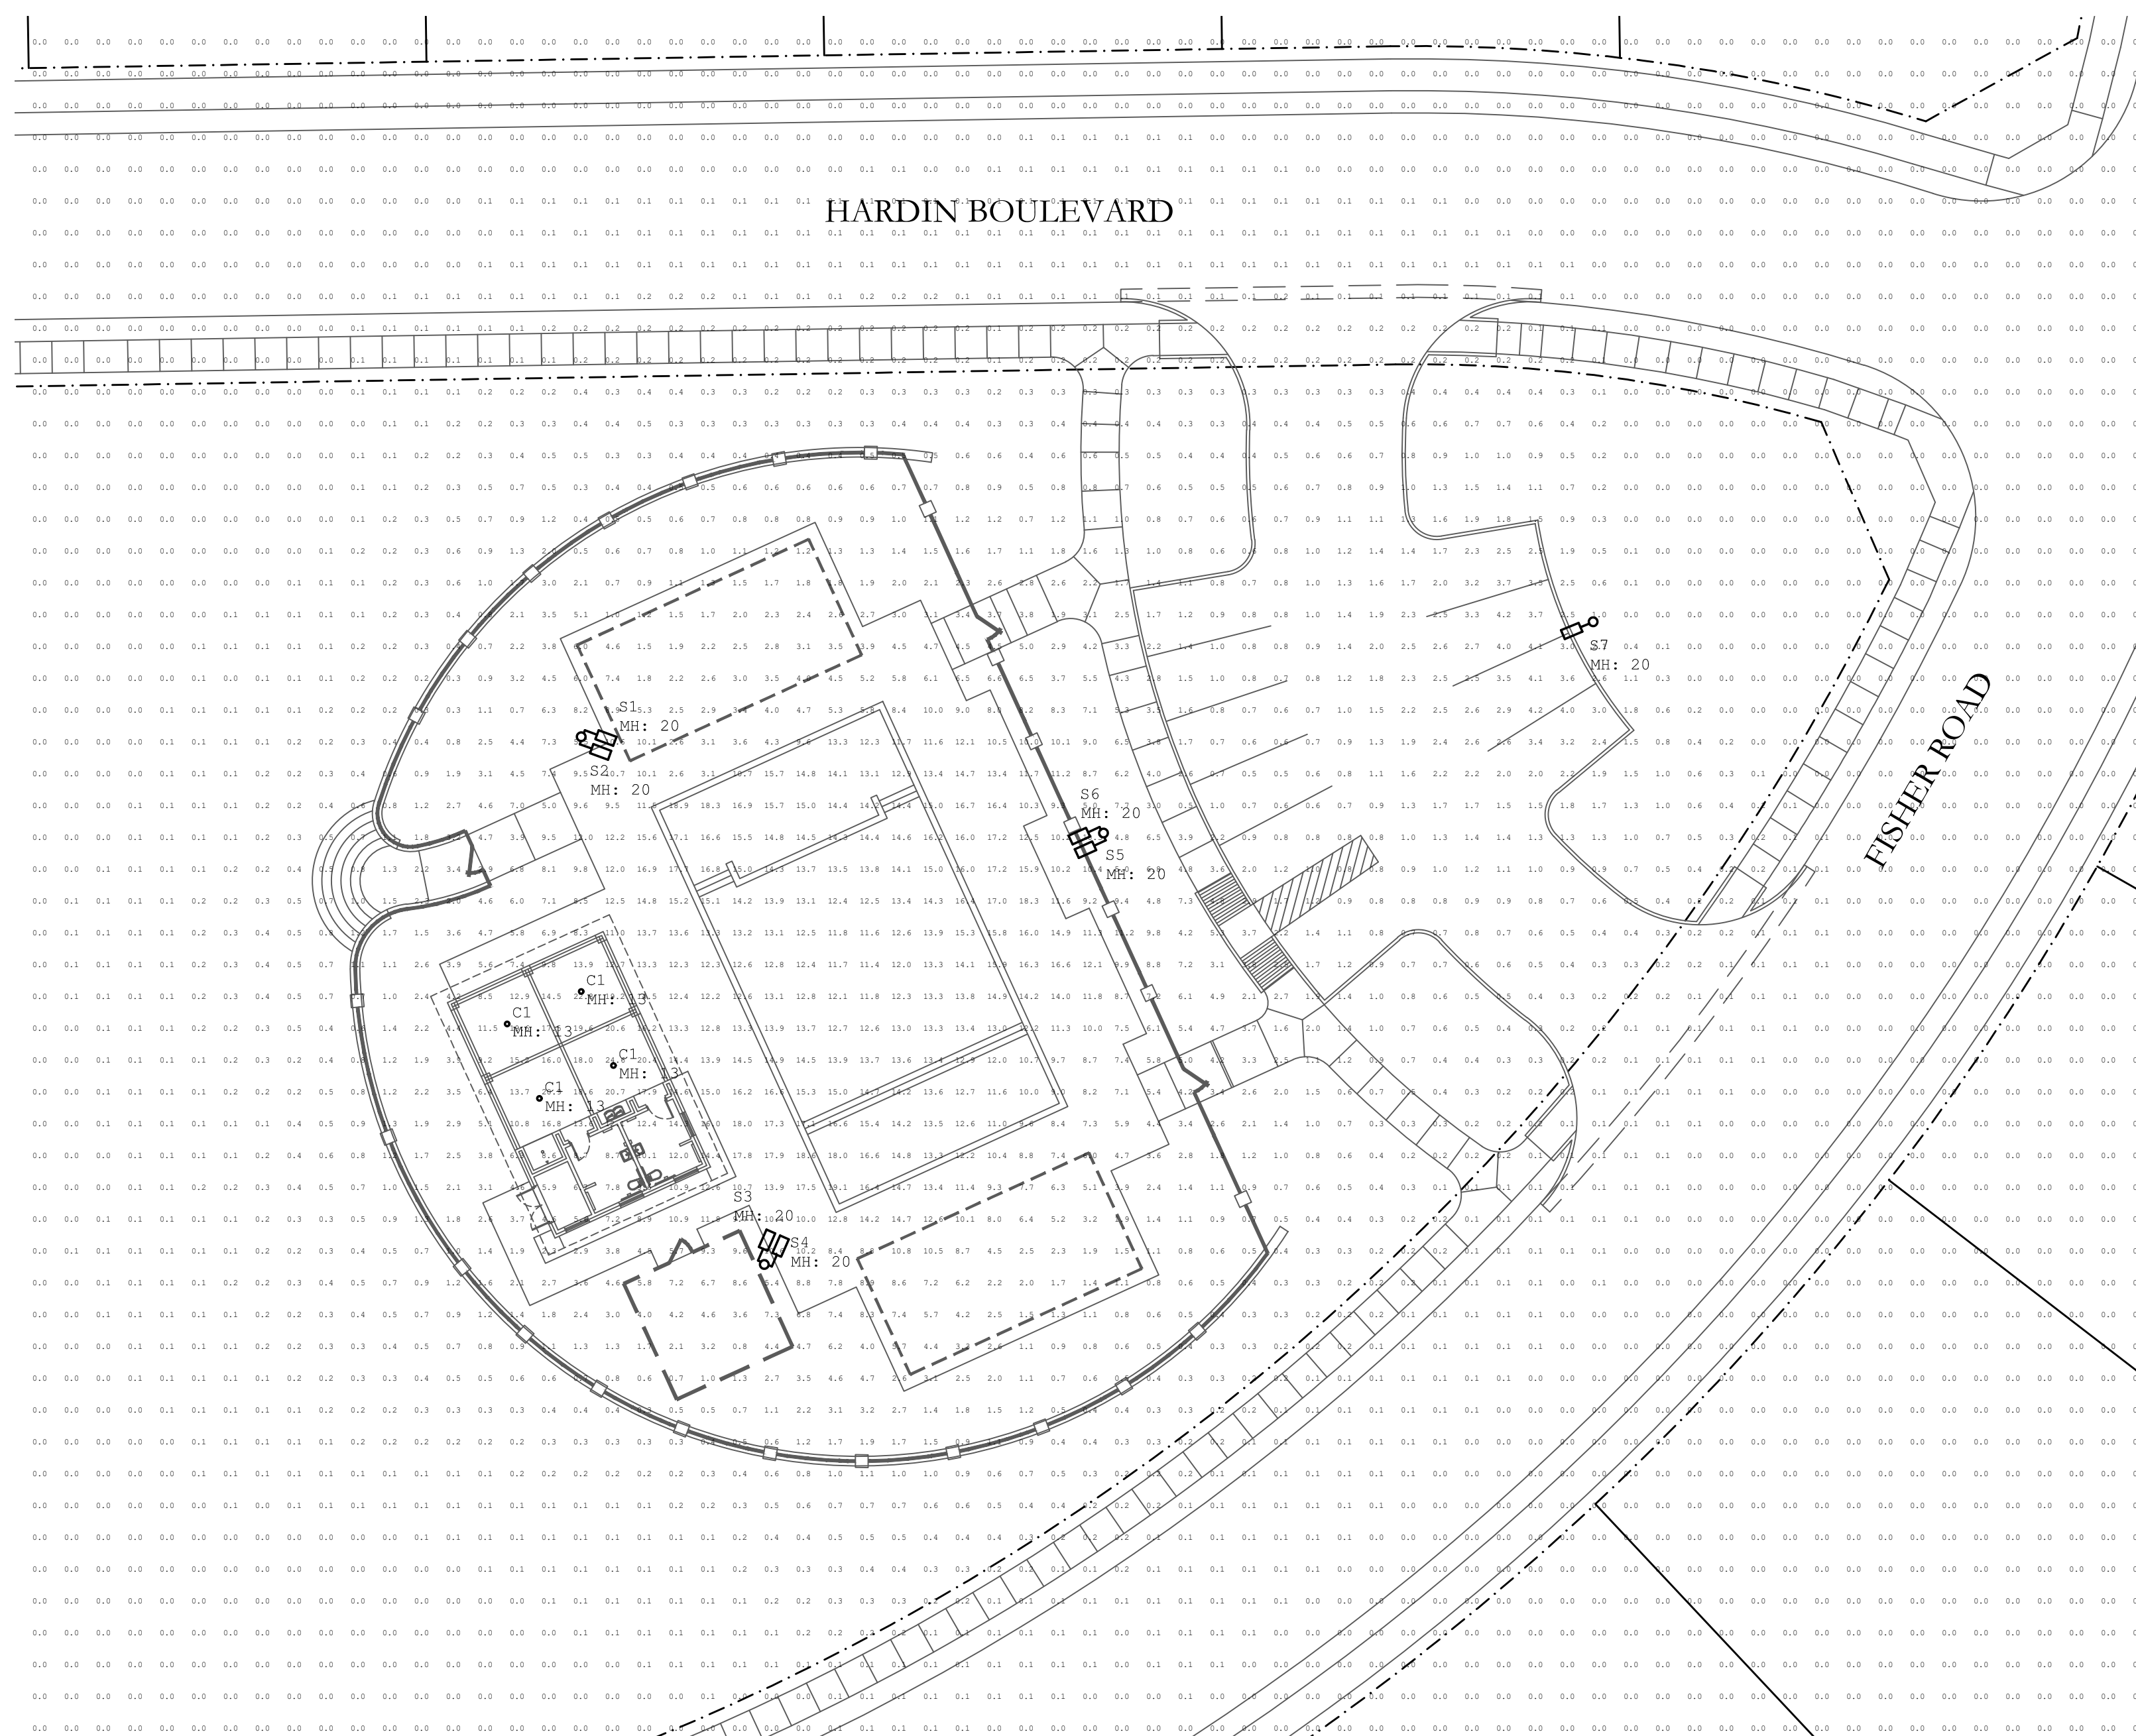

1 SITE PLAN - PHOTOMETRICS
SCALE 1" = 20'-0"

Symbol	Qty	Label	Arrangement	Description	Tag	LLF	Luminaire Lumens	Luminaire Watts	Total Watts	Mounting Height
⊙	4	C1	Single	DMP DCC DC4-(X)-D20WF-00000-40WH-(X)-R		0.900	2297	28	112	13
⊙	1	S1	SINGLE	EALS03_K4AH740 WITH ELS-EAL-FS4-BLCK- LEFT	PAIRED WITH S2	0.900	24800	239	239	20
⊙	1	S2	SINGLE	EALS03_K4AH740 WITH ELS-EAL-FS4-BLCK- LEFT	PAIRED WITH S1	0.900	24800	239	239	20
⊙	1	S3	SINGLE	EALS03_K4AH740 WITH ELS-EAL-FS4-BLCK- RIGHT	PAIRED WITH S4	0.900	24800	239	239	20
⊙	1	S4	SINGLE	EALS03_K4AH740 WITH ELS-EAL-FS4-BLCK- RIGHT	PAIRED WITH S3	0.900	24800	239	239	20
⊙	1	S5	SINGLE	EALS03_K4AH740	PAIRED WITH S6	0.900	29000	239	239	20
⊙	1	S6	SINGLE	EALS03_K4AH740	PAIRED WITH S5	0.900	29000	239	239	20
⊙	1	S7	SINGLE	EALS03_D4AF740 -ELS-EAL-RBL-BLCK		0.900	8900	70	70	20

Issue: 11/10/2023
Revisions:

Drawing Title:
**PHOTOMETRIC -
SITE PLAN**

Sheet
E1.00

APPROVED:
I hereby certify that the above and foregoing site plan for a development in the City of Rockwall, Texas, was approved by the Planning & Zoning Commission of the City of Rockwall on the ___ day of ___, ___.

WITNESS OUR HANDS, this ___ day of ___, ___.

Planning & Zoning Commission, Chairman

Director of Planning and Zoning

AOS JOB #: 4244-001-23



January 11, 2024

TO: Cody Johnson
Johnson Volk Consulting
704 Central Parkway East, Suite 1200
Plano, TX 75074

FROM: Henry Lee, AICP
City of Rockwall Planning and Zoning Department
385 S. Goliad Street
Rockwall, TX 75087

SUBJECT: SP2023-046; *Site Plan for Homestead Amenity Center*

Cody Johnson:

This letter serves to notify you that the above referenced case (*i.e. Site Plan*) that you submitted for consideration by the City of Rockwall was approved by the Planning and Zoning Commission on December 12, 2023. The following is a record of all recommendations, voting records and conditions of approval:

Staff Recommendations

- (1) All staff comments provided by the Planning, Engineering and Fire Department must be addressed prior to the submittal of engineering plans; and,
- (2) Any construction resulting from the approval of this Site Plan shall conform to the requirements set forth by the Unified Development Code (UDC), the International Building Code (IBC), the Rockwall Municipal Code of Ordinances, city adopted engineering and fire codes and with all other applicable regulatory requirements administered and/or enforced by the state and federal government.

Planning and Zoning Commission

On December 12, 2023, the Planning and Zoning Commission approved a motion to approve a Site Plan by a vote of 6-0, with Commissioner Womble absent.

Should you have any questions or concerns regarding your zoning case, please feel free to contact me a (972) 772-6434.

Sincerely,

A handwritten signature in black ink, appearing to read "Henry Lee".

Henry Lee, AICP, *Senior Planner*
City of Rockwall Planning and Zoning Department