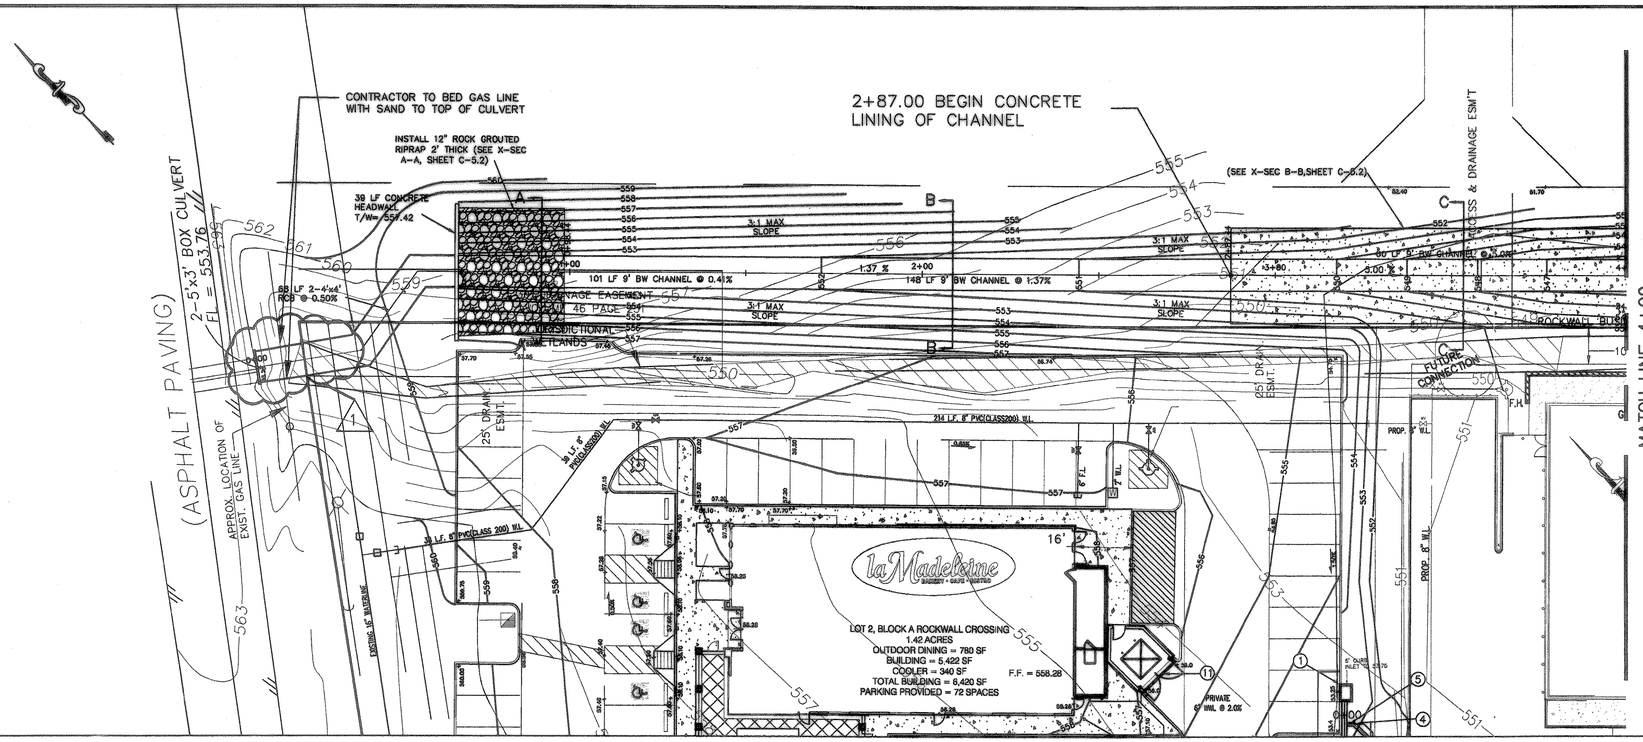

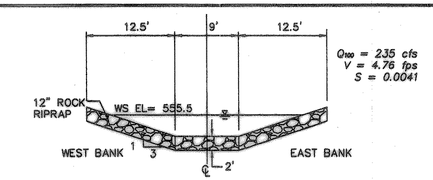

X-SECTION A-A
RIPRAP AT UPSTREAM END OF CHANNEL
SCALE: 1" = 10'

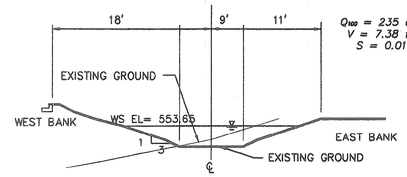

X-SECTION B-B
9' BW CHANNEL
SCALE: 1" = 10'

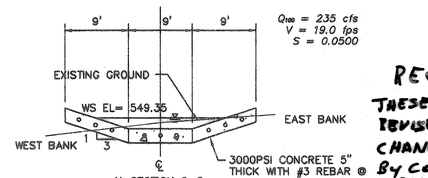

X-SECTION C-C
CONCRETE LINING
AT CENTER OF CHANNEL
SCALE: 1" = 10'

RECORD DRAWING
THESE PLANS HAVE BEEN REVISED TO REFLECT CHANGES AS INDICATED BY CONSTRUCTION RECORDS
11-16-06

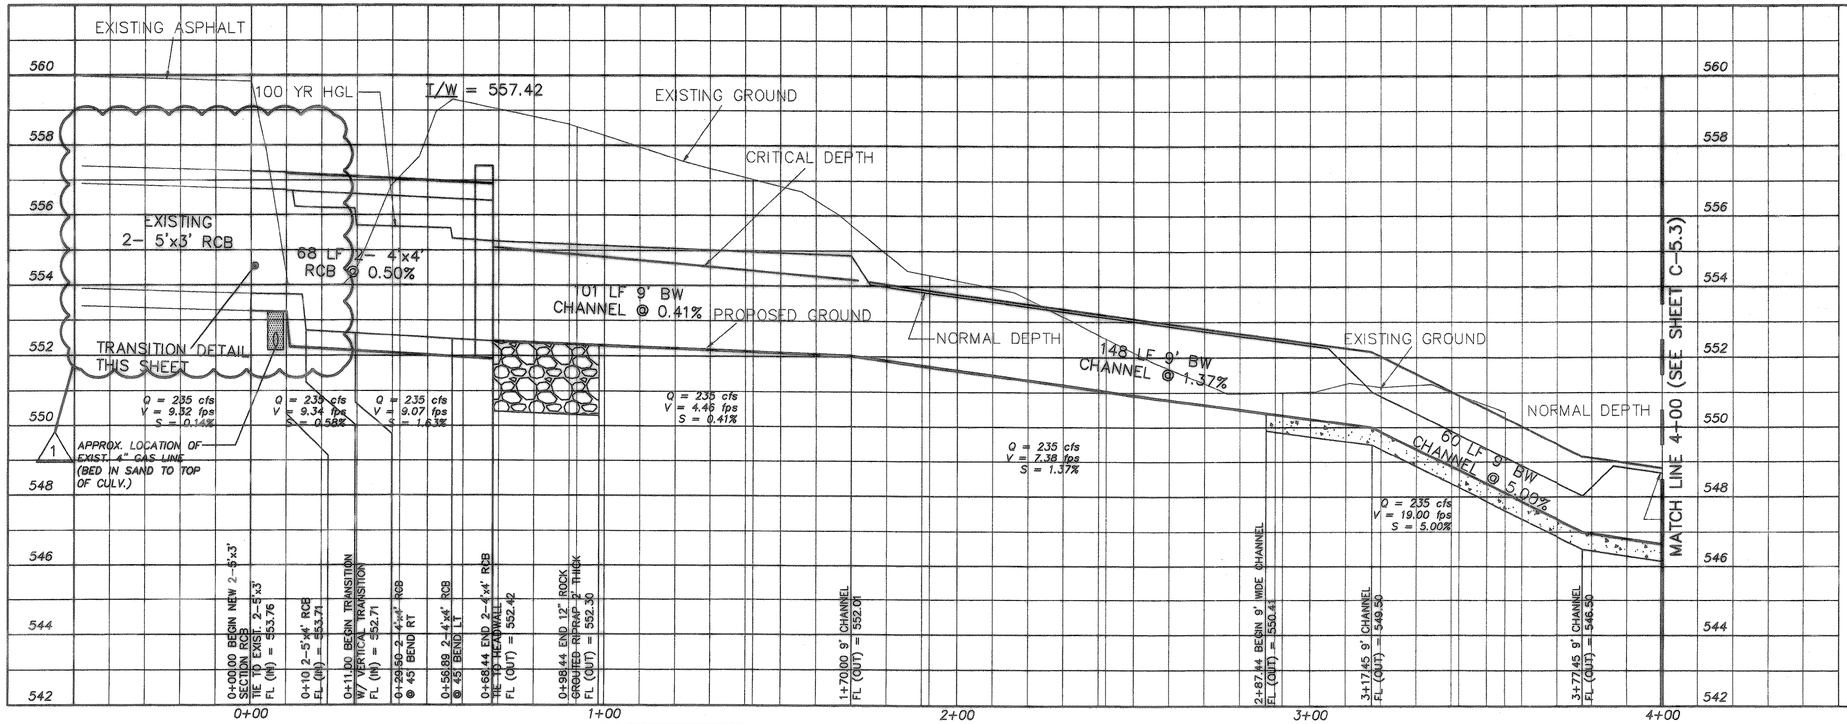

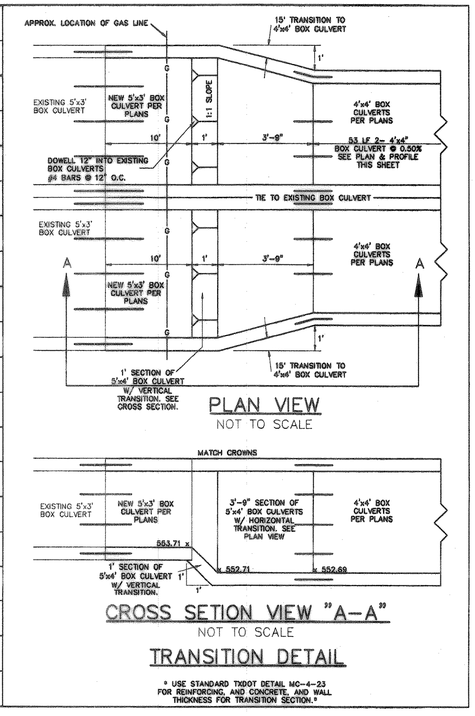

PLAN VIEW
NOT TO SCALE

CROSS SETION VIEW "A-A"
NOT TO SCALE

TRANSITION DETAIL

* USE STANDARD TXDOT DETAIL MC-4-23 FOR REINFORCING, AND CONCRETE, AND WALL THICKNESS FOR TRANSITION SECTION.*

REV	DATE	BY	DESCRIPTION
1	08/21/2006	ROC	ADD TRANSITIONS TO CULVERTS, TO ADJUST FOR SIZE DIFFERENCES. SEE DETAIL THIS SHEET.

TEXAS ONE CALL SYSTEM 1-800-245-4545 STOP! CALL BEFORE YOU DIG!!

0 10 20 40 (IN FEET)

DESIGNED: RS
DRAWN: FM
CHECKED: DPS

STATE OF TEXAS ROBERT DANIEL CALDERON 92681 LICENSED PROFESSIONAL ENGINEER

"THE SEAL APPEARING ON THIS DOCUMENT WAS AUTHORIZED BY ROBERT DANIEL CALDERON 92681 ON THE DATE SHOWN ON THE DAVIS/AMP. ALTERATION OF A SEALED DOCUMENT WITHOUT PROPER NOTIFICATION TO THE RESPONSIBLE ENGINEER IS AN OFFENSE UNDER THE TEXAS ENGINEERING PRACTICE ACT"

8-31-06 DATE

NAME

ENGINEERS ARCHITECTS THE WALLACE GROUP INC. SURVEYORS PLANNERS

LA MADELEINE RESTAURANT
ROCKWALL CROSSING
CHANNEL PLAN & PROFILE

SHEET C-5.2
OF 15 SHEETS