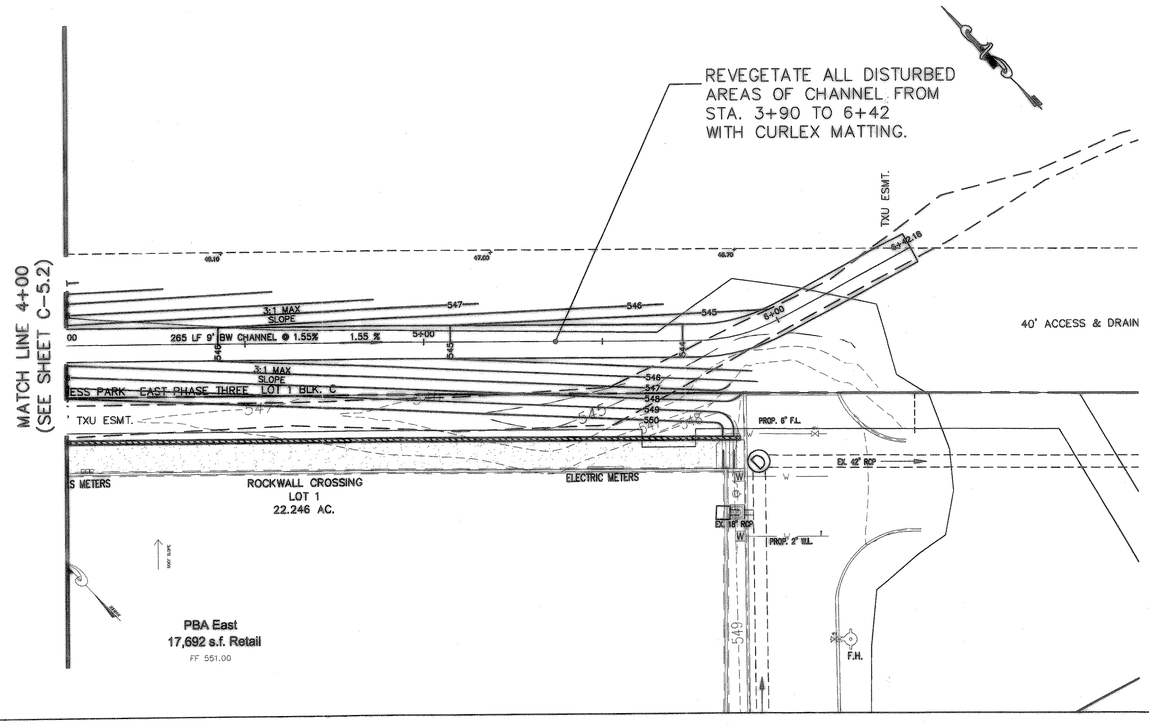

RECORD DRAWING

THESE PLANS HAVE BEEN REVISED TO REFLECT FIELD CHANGES AS INDICATED BY CONSTRUCTION RECORDS.

DATE 11-16-06

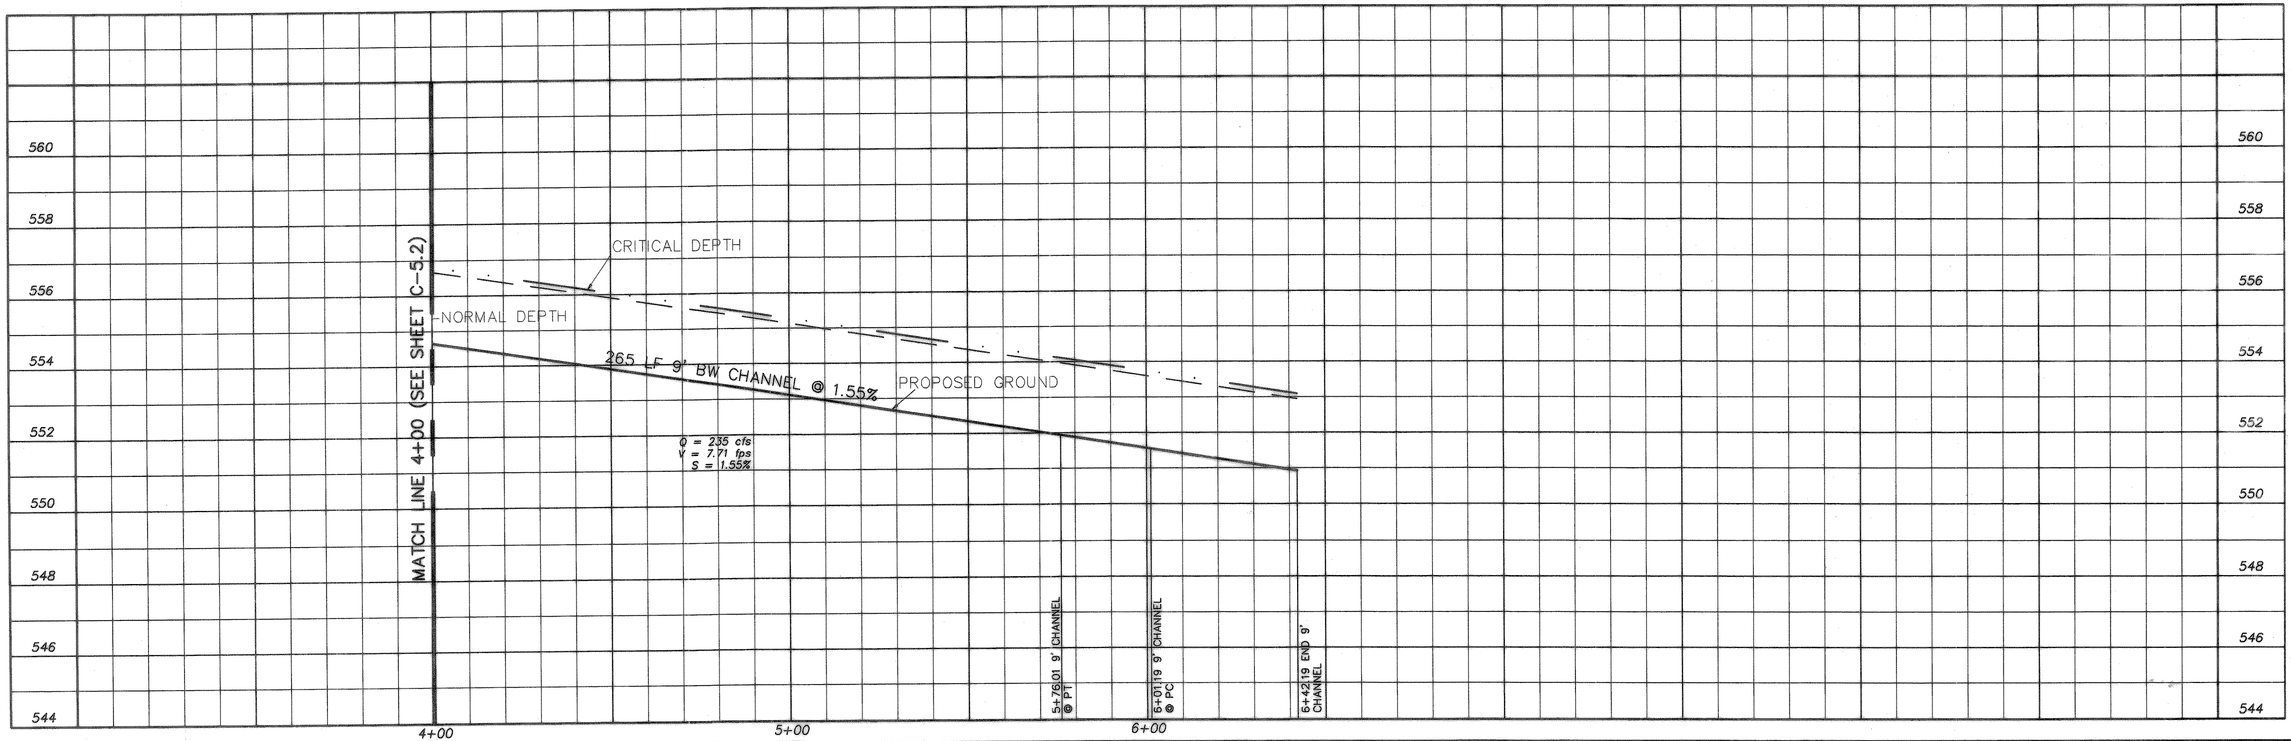

REV	DATE	BY	DESCRIPTION

TEXAS ONE CALL SYSTEM 1-800-245-4545 STOP-CALL BEFORE YOU DIG!

0 10 20 40 (IN FEET)

DESIGNED: RS
DRAWN: FM
CHECKED: DPS

STATE OF TEXAS ROBERT D. CALDERON 92681 LICENSED PROFESSIONAL ENGINEER

"THE SEAL APPEARING ON THIS DOCUMENT WAS AUTHORIZED BY ROBERT D. CALDERON # 92681 ON THE DATE SHOWN ON THE DAYSTAMP. ALTERATION OF A SEALED DOCUMENT WITHOUT PROPER NOTIFICATION TO THE RESPONSIBLE ENGINEER IS AN OFFENSE UNDER THE TEXAS ENGINEERING PRACTICE ACT"

11-16-06 DATE NAME

ENGINEERS SURVEYORS ARCHITECTS PLANNERS

THE WALLACE GROUP INC.

LA MADELEINE RESTAURANT

ROCKWALL CROSSING

CHANNEL PLAN & PROFILE

SHEET C-5.3 OF 15 SHEETS