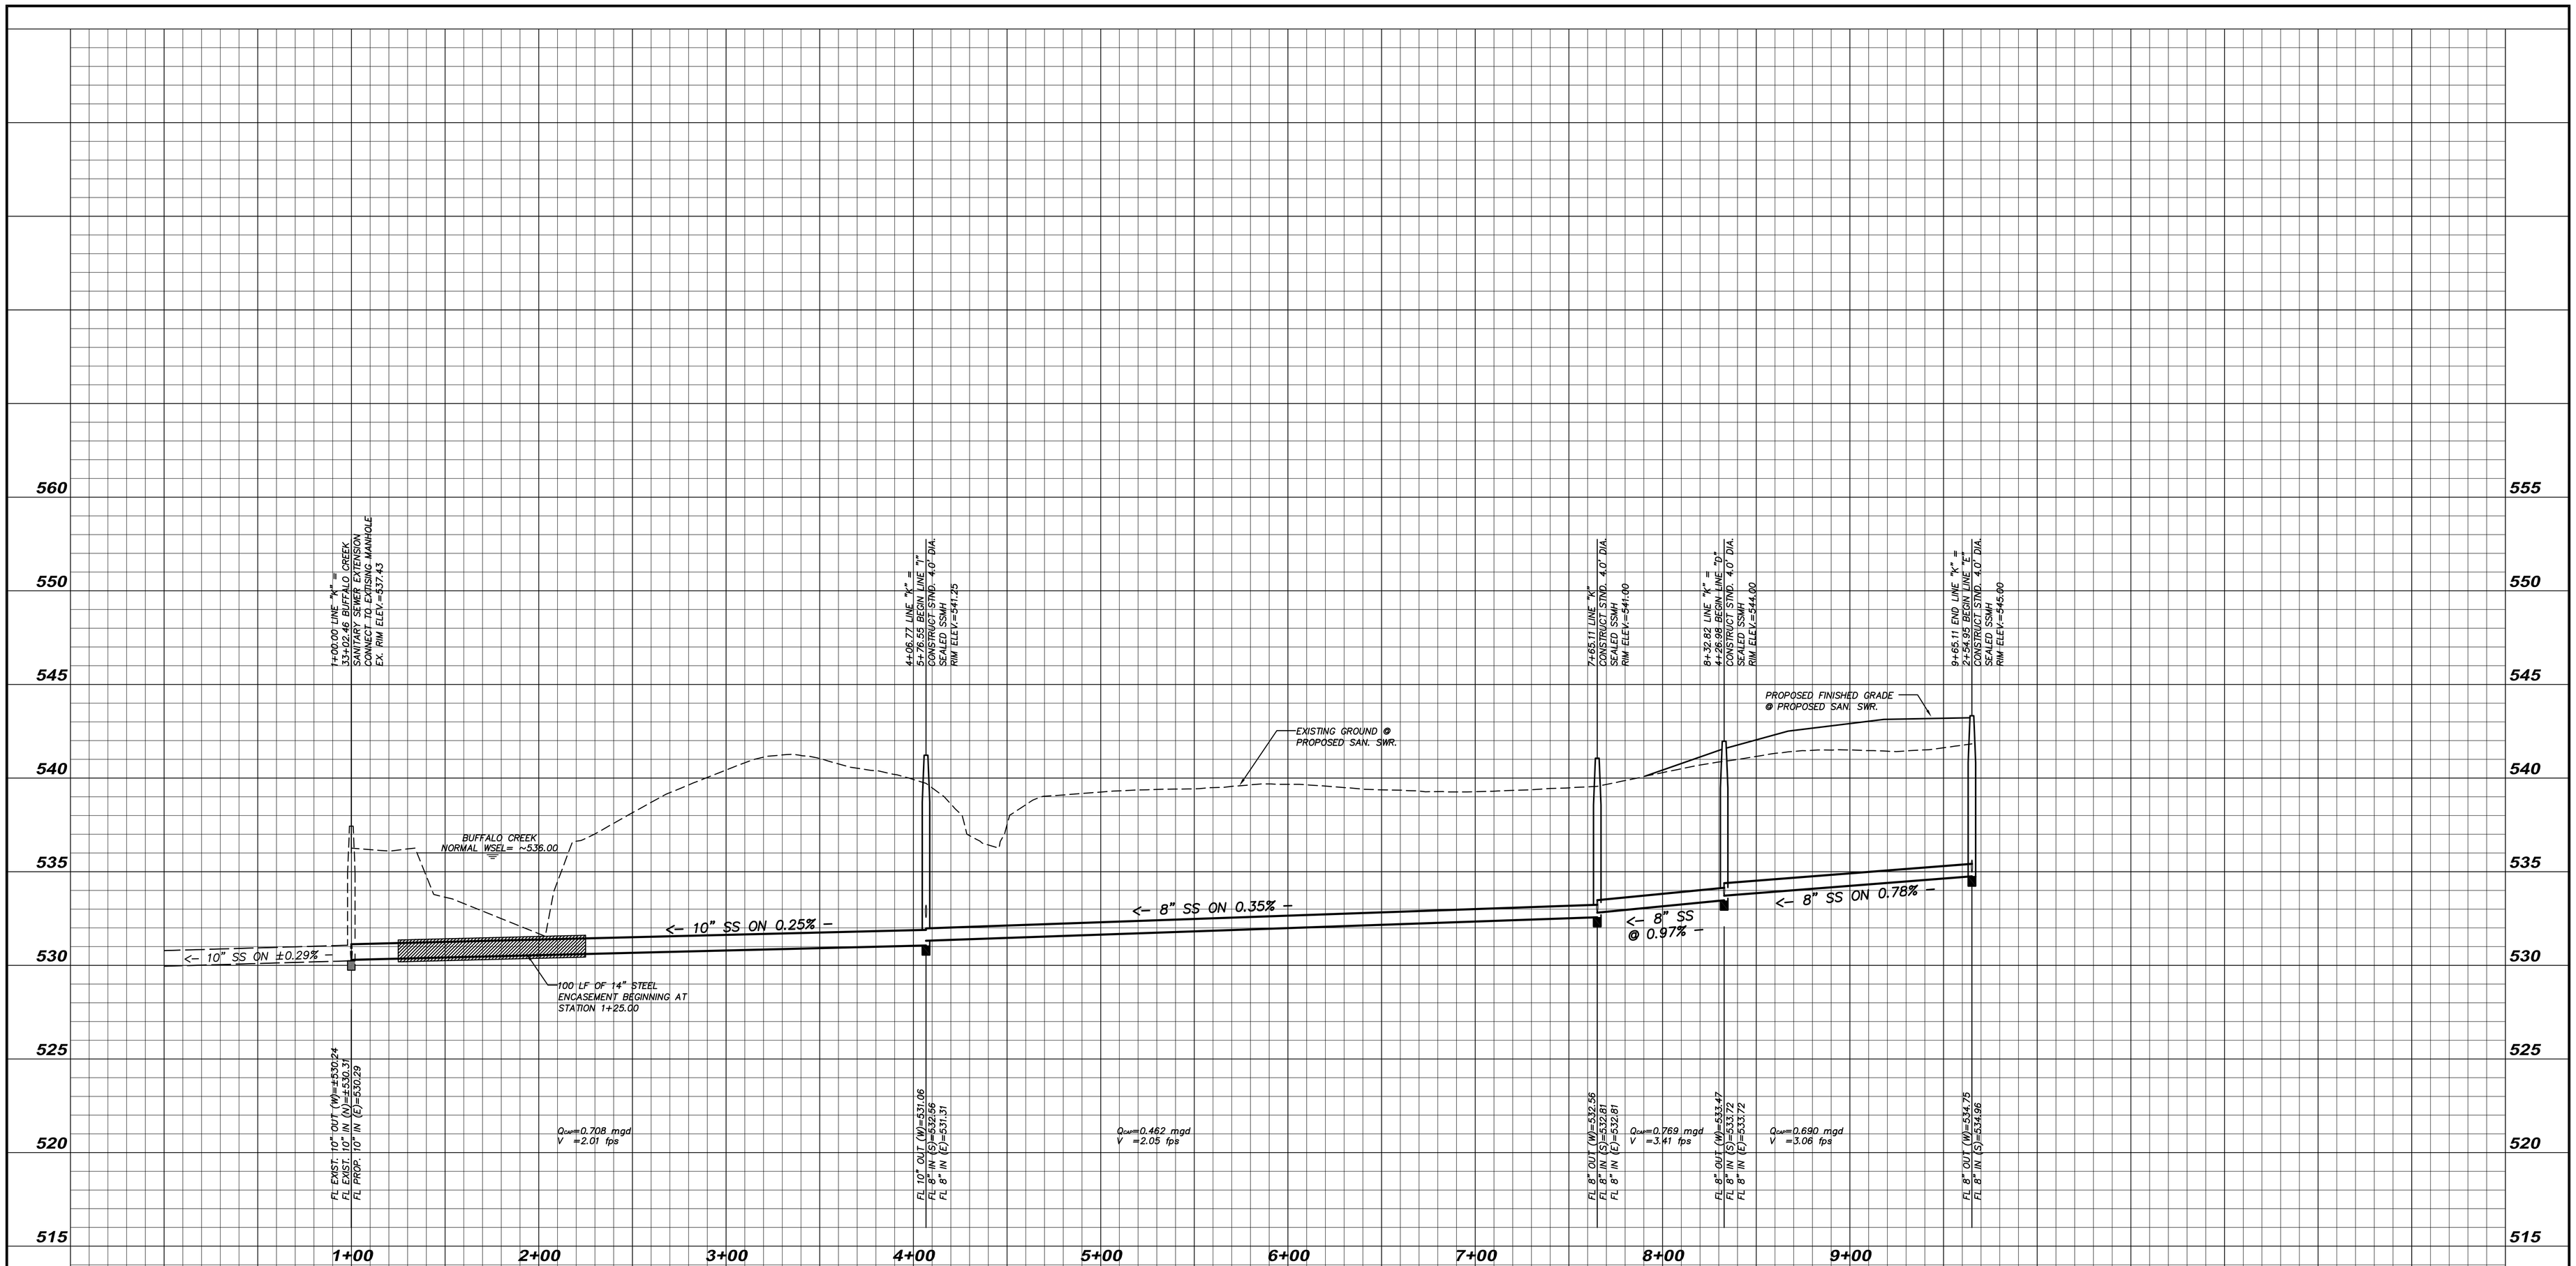

SANITARY SEWER LINE "K"

RECORD DRAWING
RECORD INFORMATION PROVIDED BY
CONASTER CONSTRUCTION, FORT WORTH, TEXAS
ELEVATION VERIFICATION PERFORMED BY
SURVEY CONSULTANTS, INC., PLANO, TEXAS

NOTES:
1. CONTRACTOR TO ADJUST PROPOSED MANHOLE RIM ELEVATION TO MATCH PROPOSED FINISHED GRADE.
2. ALL SANITARY SEWER MANHOLES TO BE SEALED.

STATE OF TEXAS
ROBERT K. MANAOIS
86508
LICENSED
PROFESSIONAL ENGINEER

REV.	DATE	REMARKS	BY
			JRY

SANITARY SEWER PROFILES

MANSIONS FAMILY

CITY of ROCKWALL, TEXAS

RKM Consulting Engineers, Inc.
7616 LBJ Freeway, Suite 530
Dallas, Texas 75251
phone (214) 432-8070
fax (214) 432-8069
Firm No. F-7237

Copyright © 2009 RKM Consulting Engineers, Inc.

CHECKED	DESIGN	DRAWN	JOB	DATE	SCALE	SHEET
RKM	JRY	JRY	1026-005	05/27/09	1"=40' (H) 1"=4' (V)	29-B OF 33

MANSIONS FAMILY - ROCKWALL, RKMCE PROJECT # 1026-005

I:\PROJECTS\1026 - WESTERN RIM INVESTMENTS\1026-005 ROCKWALL\RECORD DRAWINGS - MANSIONS\CAD FILES\26-005 M SS Profiles.dwg Plotted on: 02/18/2010 - 03:01 pm