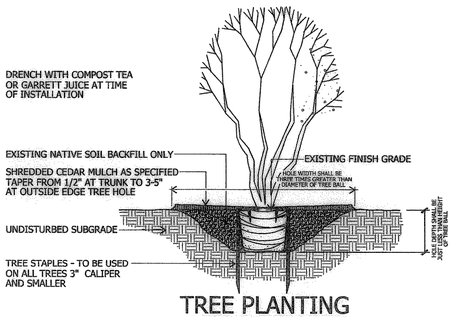

TREE PLANTING
TYPICAL MULTI-TRUNK TREE
not to scale

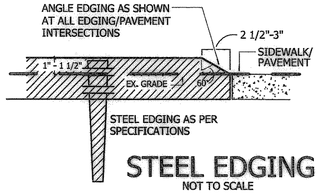

STEEL EDGING
NOT TO SCALE

CITY REQUIREMENTS

STREET FRONTAGE
10' LANDSCAPE BUFFER REQUIRED
10' LANDSCAPE BUFFER PROVIDED

STREET TREES
1 PER 50 LF STREET FRONTAGE
RALPH HALL PARKWAY
598.06' / 50 = 11.96 = 12 TREES REQUIRED
12 TREES PROVIDED
SUMMER LEE DRIVE
365.36' / 50 = 7.31 = 7 TREES REQUIRED
7 TREES PROVIDED

PARKING LOT LANDSCAPING
5% INTERIOR LANDSCAPE REQUIRED
145,652 SF x 5% = 7,283 SF REQUIRED
13,285 SF PROVIDED (9.1%)
1 TREE PER 10 SPACES
414 SPACES / 10 = 41.4 = 41 TREES REQUIRED
47 TREES PROVIDED 6/15

TOTAL LANDSCAPE AREA
15% TOTAL LANDSCAPE REQUIRED
TOTAL SITE
258,102 SF x 20% = 51,620 SF REQUIRED
53,160 SF PROVIDED (20.6%)

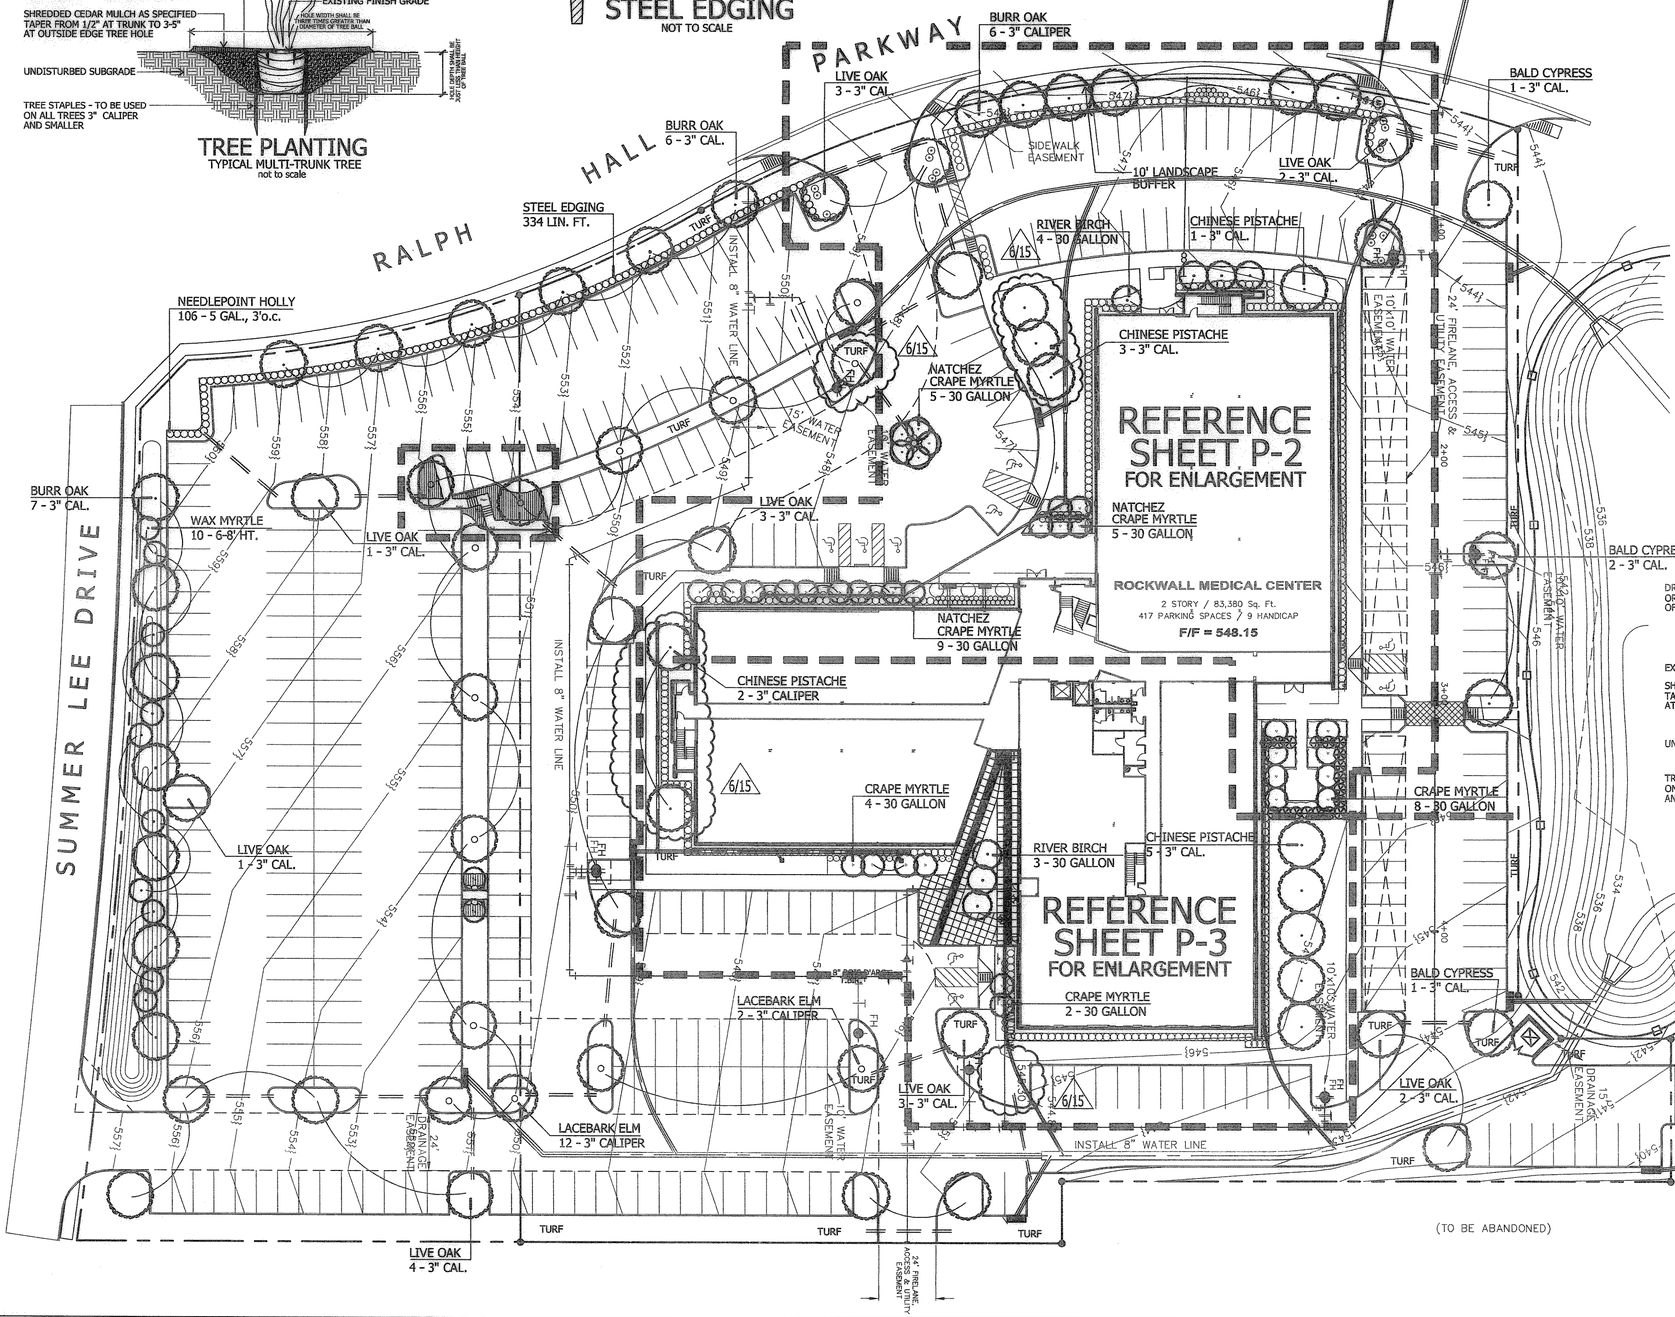

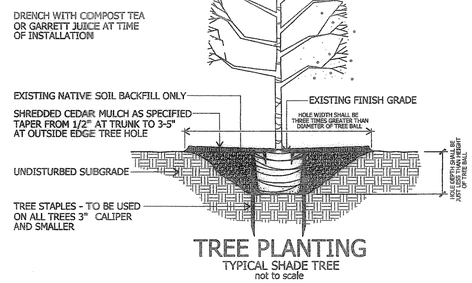

TREE PLANTING
TYPICAL SHADE TREE
not to scale

north
scale: 1" = 30'-0"

appr. by:
drawn by:
date: 09-30-04

revisions
10-14-04
10-29-04
04-12-05
05-02-05
05-19-05
6/15 06-15-05

Leeming Design Group
Landscape Architecture
P.O. Box 153593
Fort Worth, Texas 76155
972.263.0605
Fax 972.264.8060

SITE LANDSCAPE

ROCKWALL M.O.B.
RALPH HALL PARKWAY
ROCKWALL, TEXAS

file name:
c:\rockwallMOB\phase2\ldg-ph2-base.FULL.dwg.

sheet
P-1