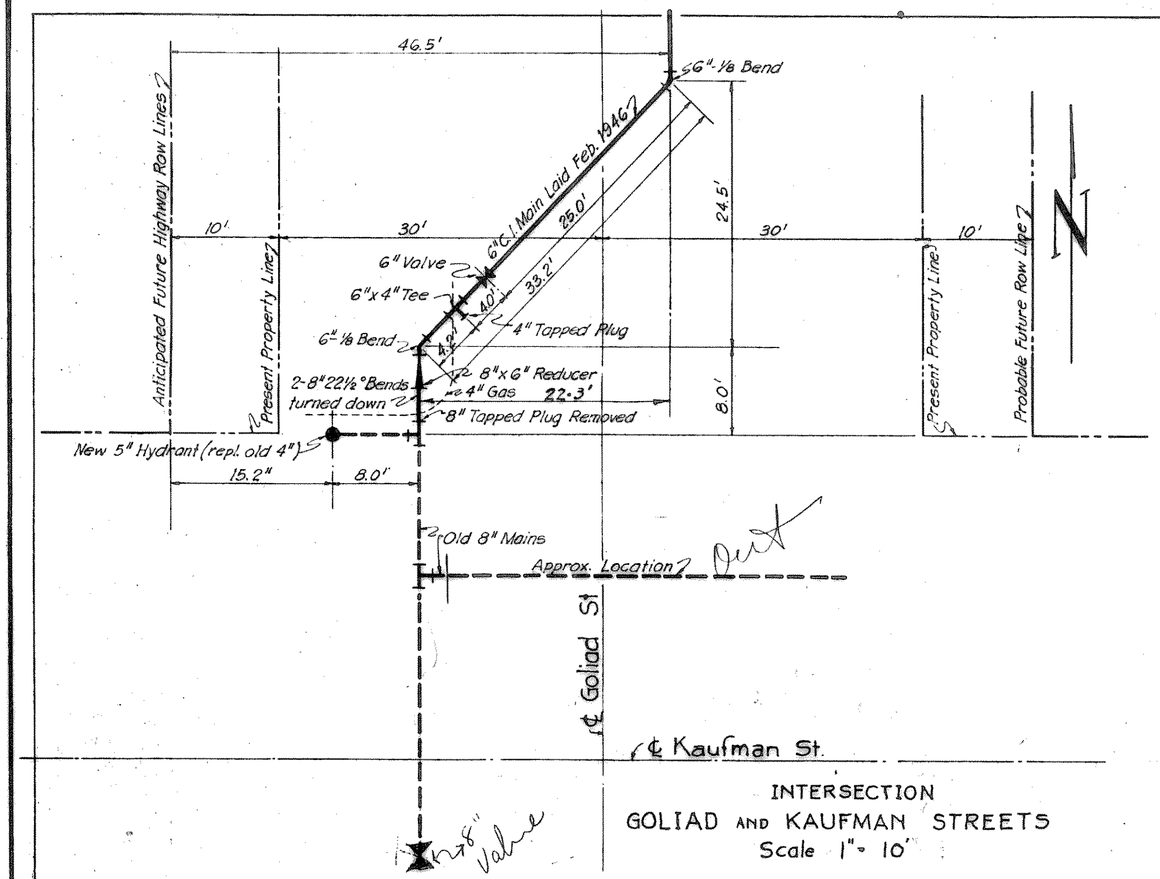

INTERSECTION
GOLIAD AND KAUFMAN STREETS
Scale 1" = 10'

MISCELLANEOUS NOTES

Location Of Testing Taps

Boydston And Clark Streets — 1.5 Feet West Of 6 Inch Valve
Rose And Storr's Streets — 1.5 Feet South Of Valve On Rose Street Line
Hartman Branch — 25.5 Feet East Of Valve On Clark Street
Washington And Goliad — 1.1 Feet West Of Bell Of Valve
Goliad North of Kaufman — 63 Feet North Of North Line Kaufman.
Lillian Street — 4.5 Feet South Of North Wall Of Church
96 Feet East Of Tee In Atherton Street

FREESE & NICHOLS
Consulting Engineers
Fort Worth, Texas

INTERSECTION DETAILS
SCALE 1" = 10'