Sewer Line N PROFILE

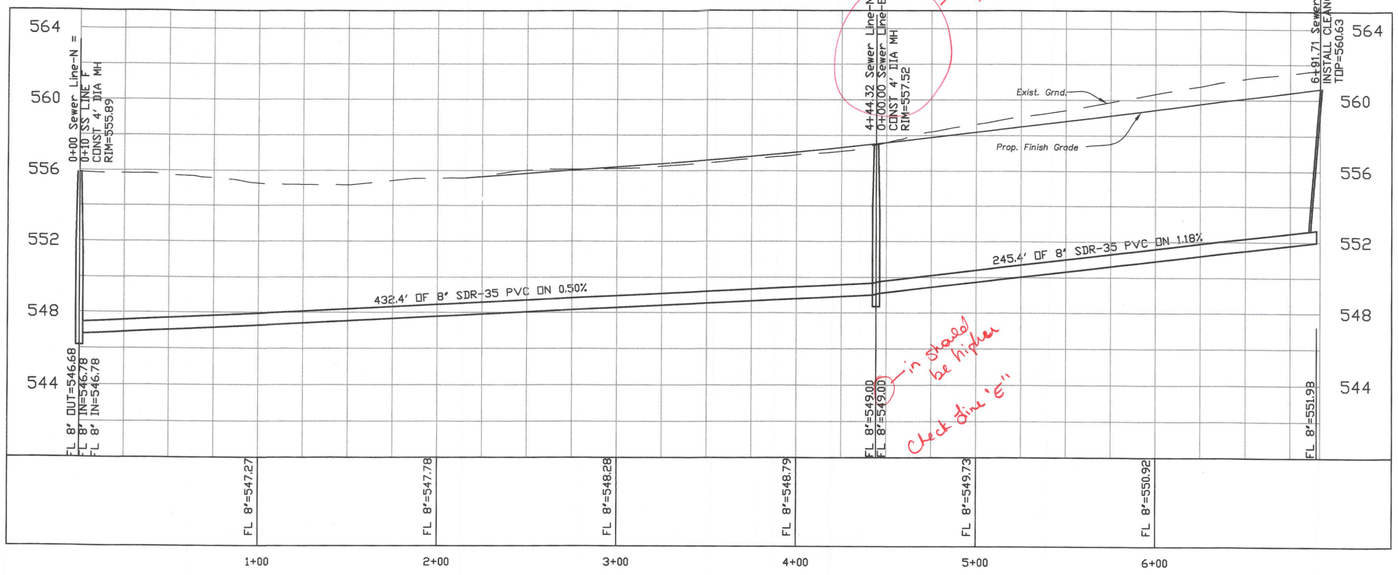

Sewer Line-O PROFILE

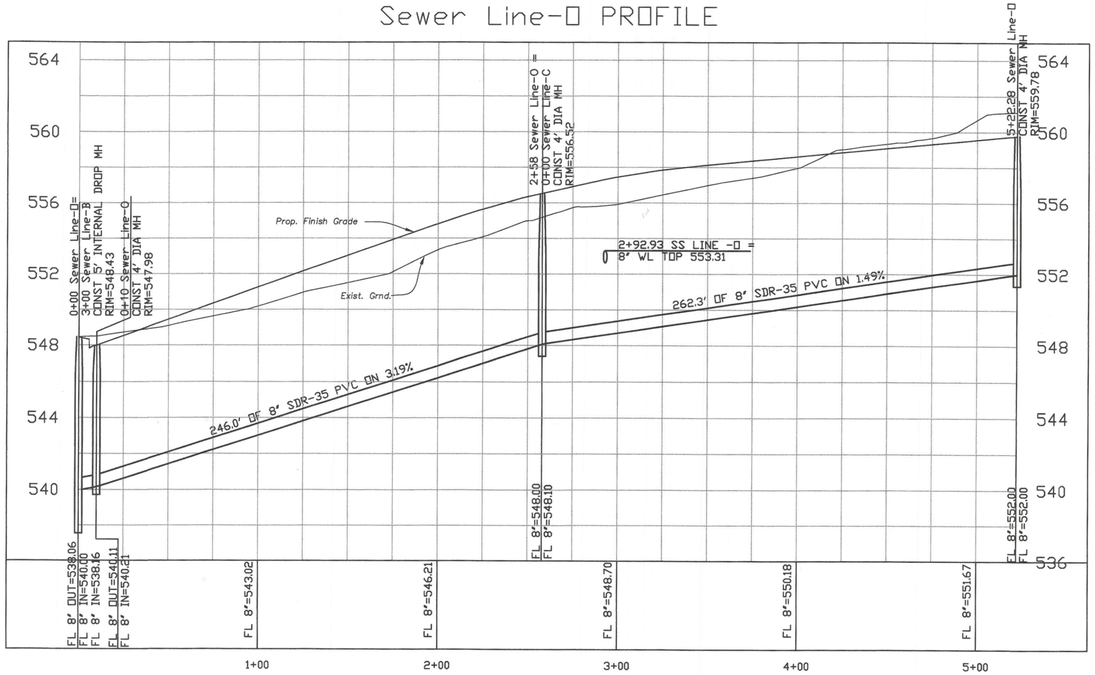

Revision	Date	Description

Owner:
SPRING HAVEN INVESTMENTS, INC.
6750 HILLCREST PLAZA DR. • STE 325
DALLAS, TEXAS 75230 • Phone: 972-386-3333

The Highlands

F.C. CUNY CORPORATION
#2 Horizon Court • Ste. 500 • Heath, Texas 75032
Phone: 469-402-7700
Fax: 469-402-0700

THE SEAL APPEARING ON THIS DOCUMENT WAS AUTHORIZED BY CHRISTOPHER R. CUNY, P.E. 65642

STATE OF TEXAS
CHRISTOPHER R. CUNY
65642
REGISTERED PROFESSIONAL ENGINEER

Drawn By:	Checked By:
MSC	JW
Date:	Project No.:
09/25/2007	06-004

Sheet Title:
SEWER LINE N & O Profile

Scale:	Sheet No.:
1" = 40'	54 of 61