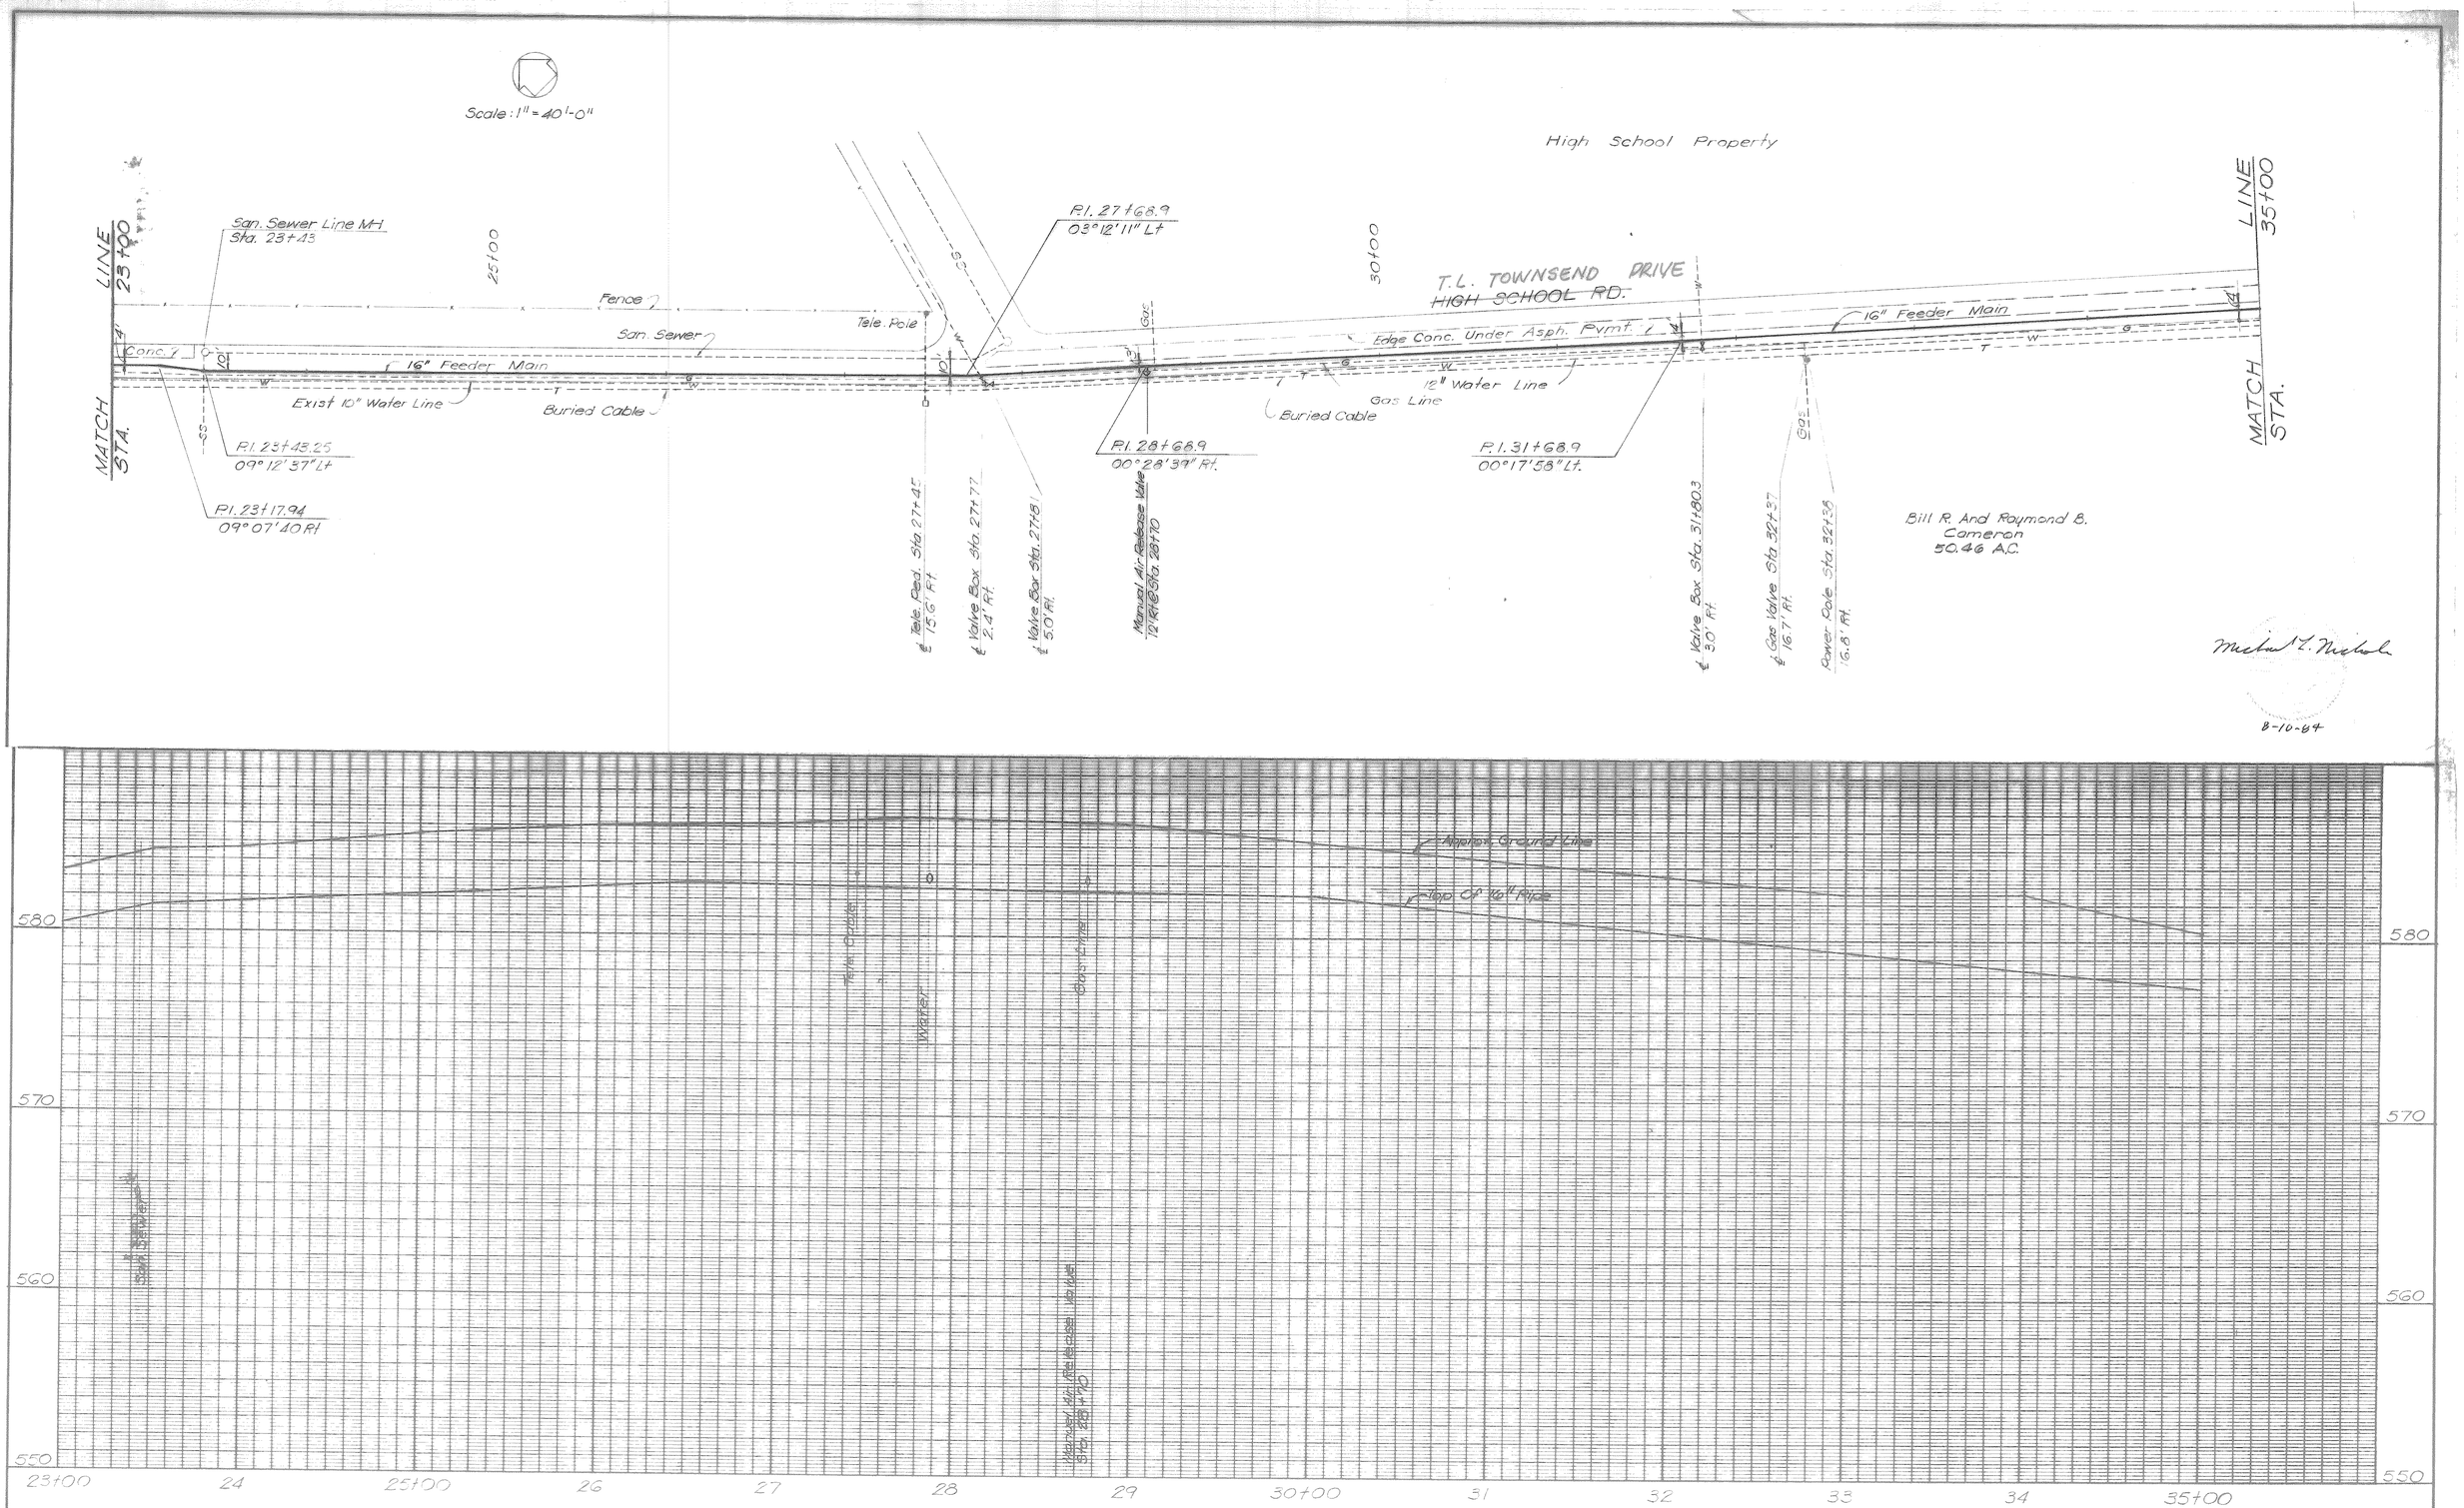

DATE	REVISION	BY	DESIGNED MLN DRAWN BGD TRACED CHECKED	JOB NO. ROK 84065 DATE SCALE H=40' V=4'	FREESE AND NICHOLS CONSULTING ENGINEERS FORT WORTH-AUSTIN, TEXAS	CITY OF ROCKWALL 16" FEEDER MAIN	PLAN AND PROFILE STA.23+00 TO STA.35+00	SHEET 4 of 15

027