


Michael H. Medel  
8-10-89

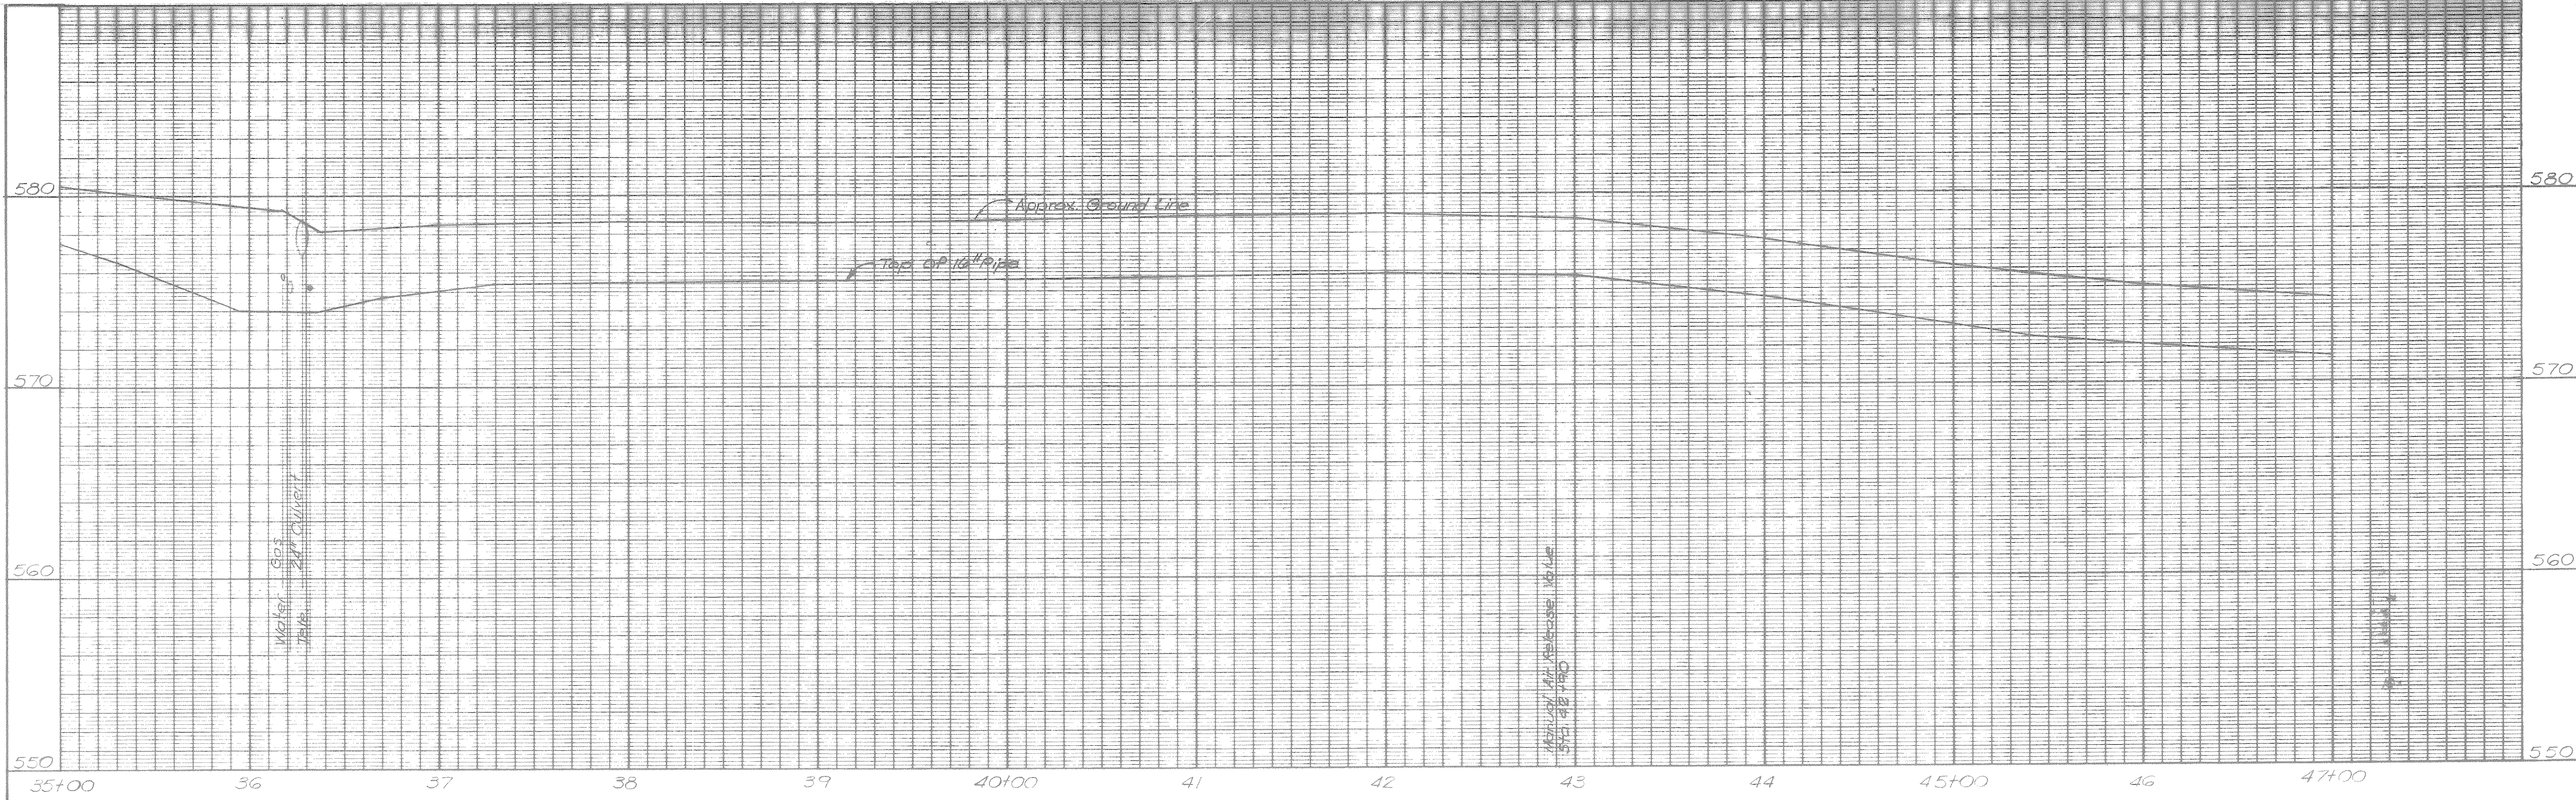

DESIGNED MLM 90	JOB NO. ROK 84065	FREESE AND NICHOLS CONSULTING ENGINEERS FORT WORTH-AUSTIN, TEXAS	CITY OF ROCKWALL 16" FEEDER MAIN	PLAN AND PROFILE STA. 35+00 TO STA. 47+00	SHEET 5 of 15
DATE	DATE	SCALE H=40' V=4'			
TRACED	CHECKED				
REVISION	BY				