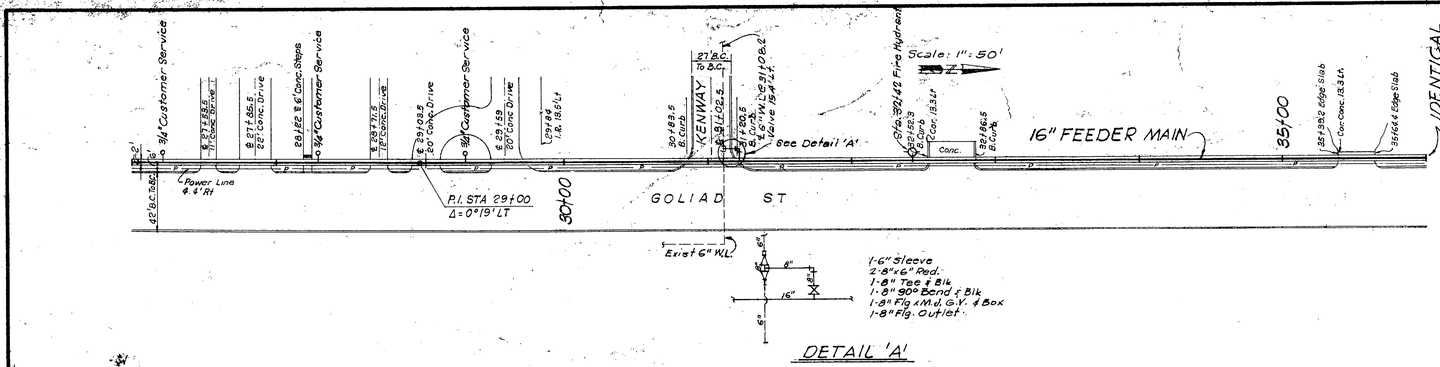

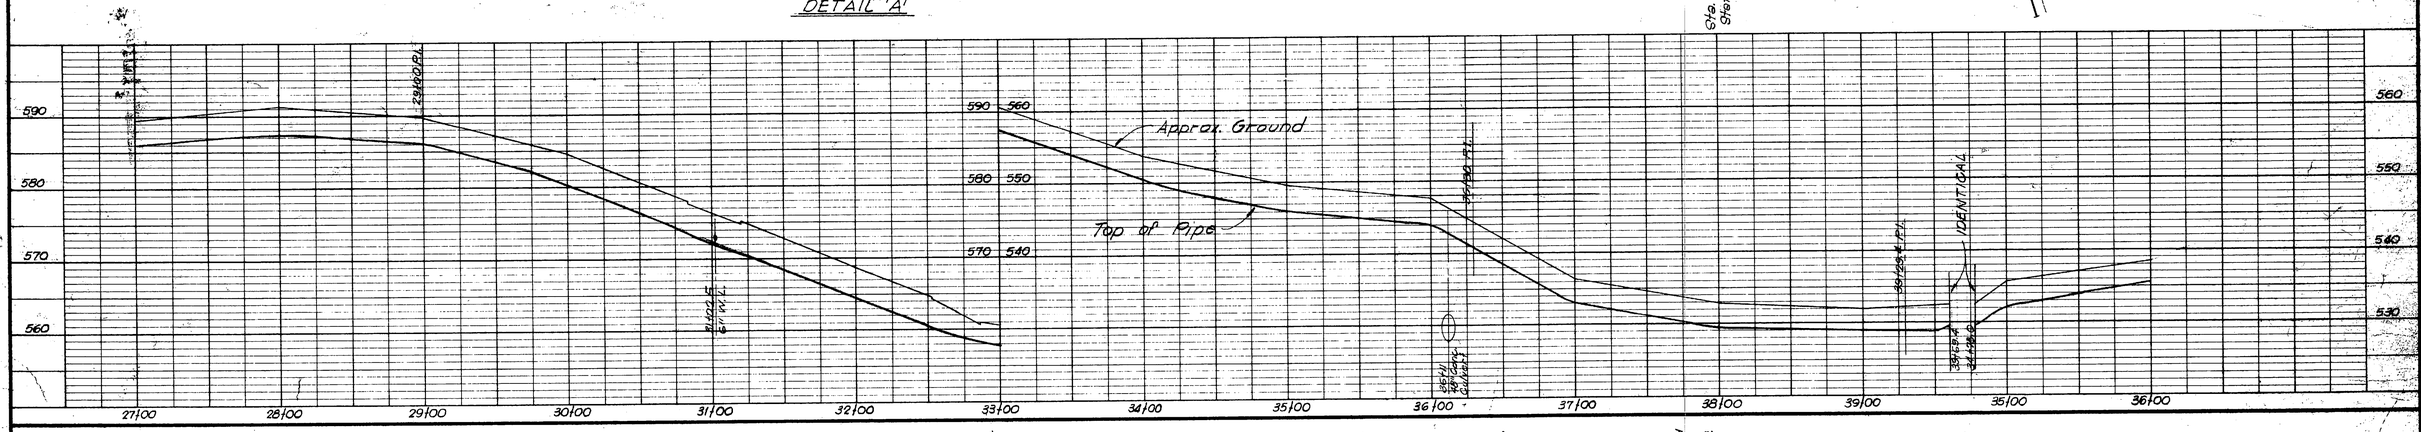

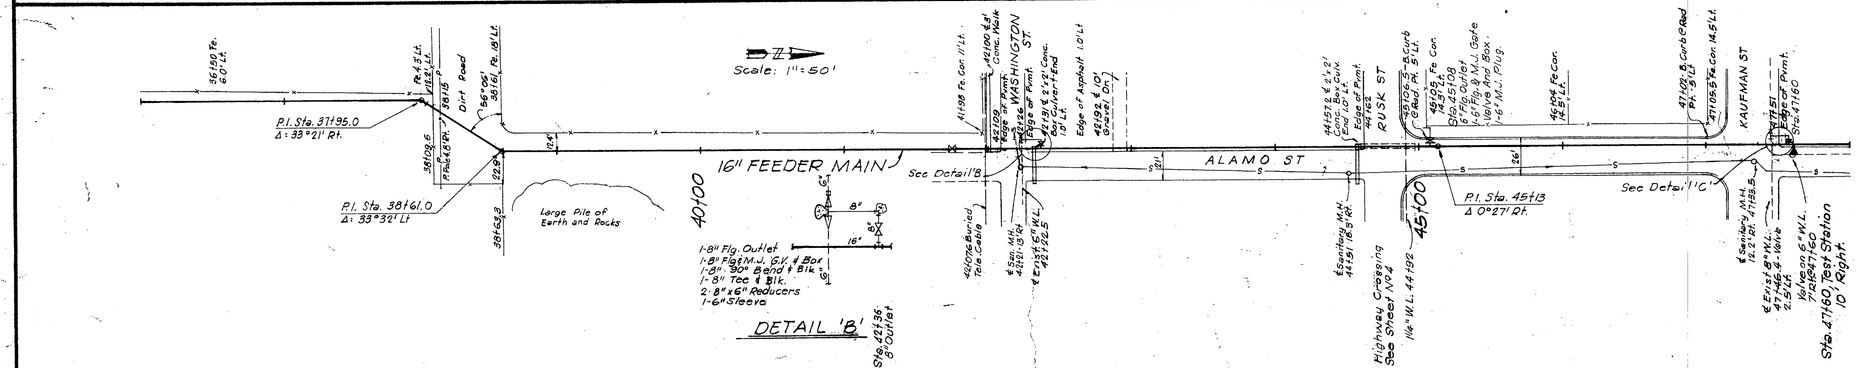

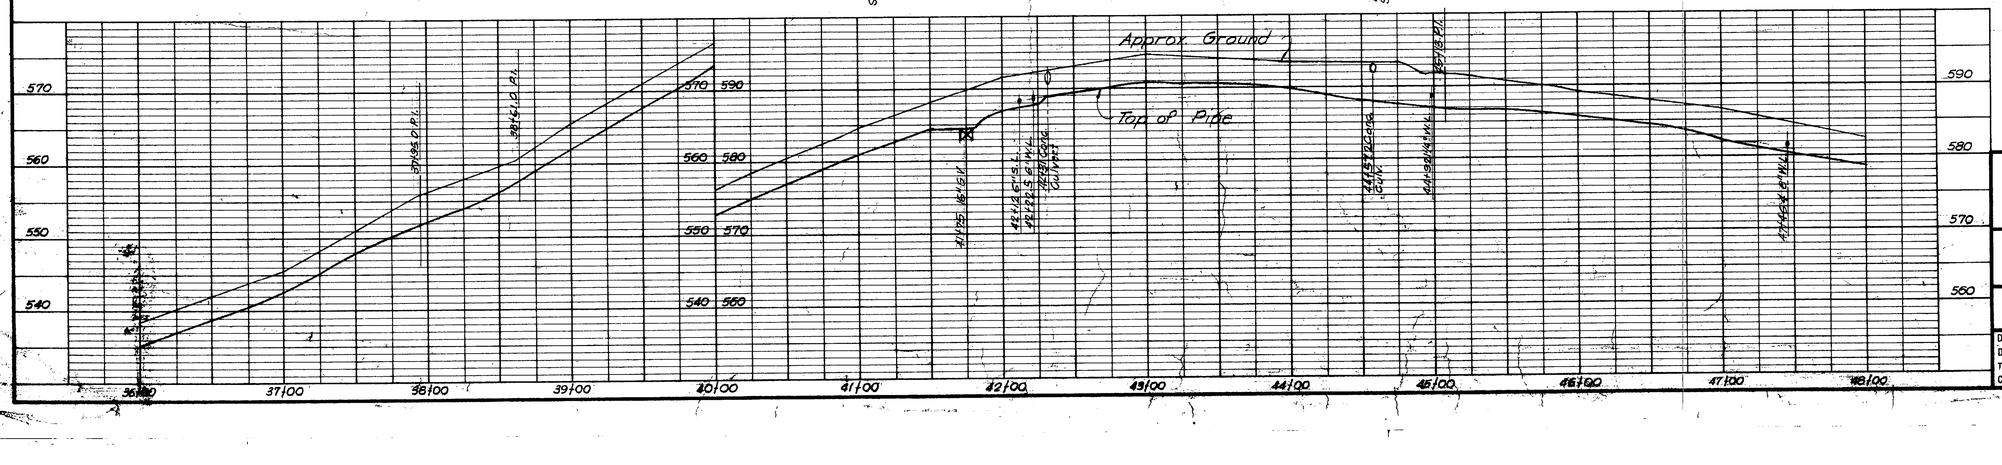

STATE OF TEXAS
ROBERT L. NICHOLS
10061
REGISTERED
PROFESSIONAL ENGINEER

ROCKWALL, TEXAS
WATER SYSTEM IMPROVEMENTS
16" FEEDER MAIN
PLAN AND PROFILE

DESIGNED	D.L.D
DRAWN	M.E.J.
TRACED	
CHECKED	R.L.N.

FREESE, NICHOLS & ENDRESS
CONSULTING ENGINEERS

DATE: JAN. 1972
SCALE: AS SHOWN
JOB NO. 7109?
SHEET 5 OF 5

022