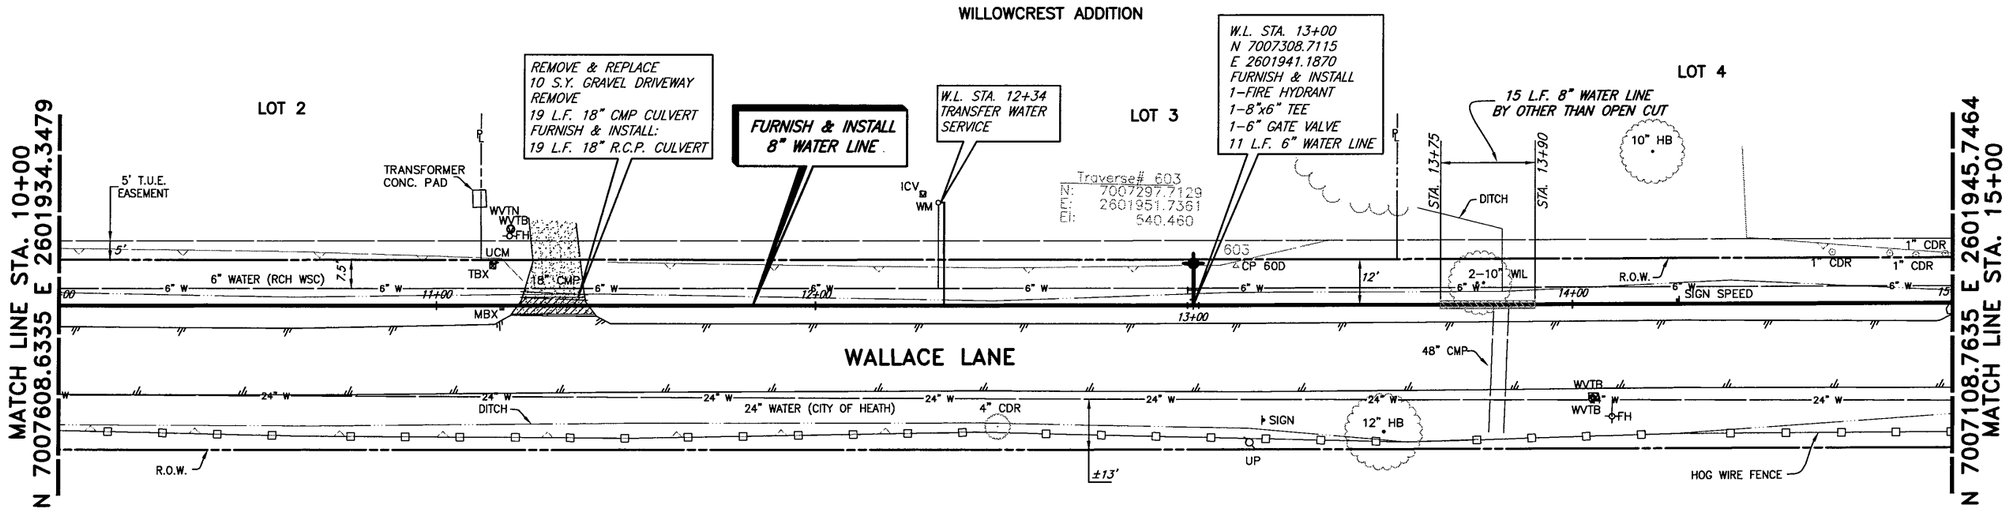

CAUTION!!
RCH WSC WATER LINES IN AREA.
CONTRACTOR TO CONFIRM LOCATIONS
PRIOR TO CONSTRUCTION.
CONTACT MR. DWIGHT LINDOP WITH
RCH WSC AT 972-670-9091 PRIOR
TO CONSTRUCTION.

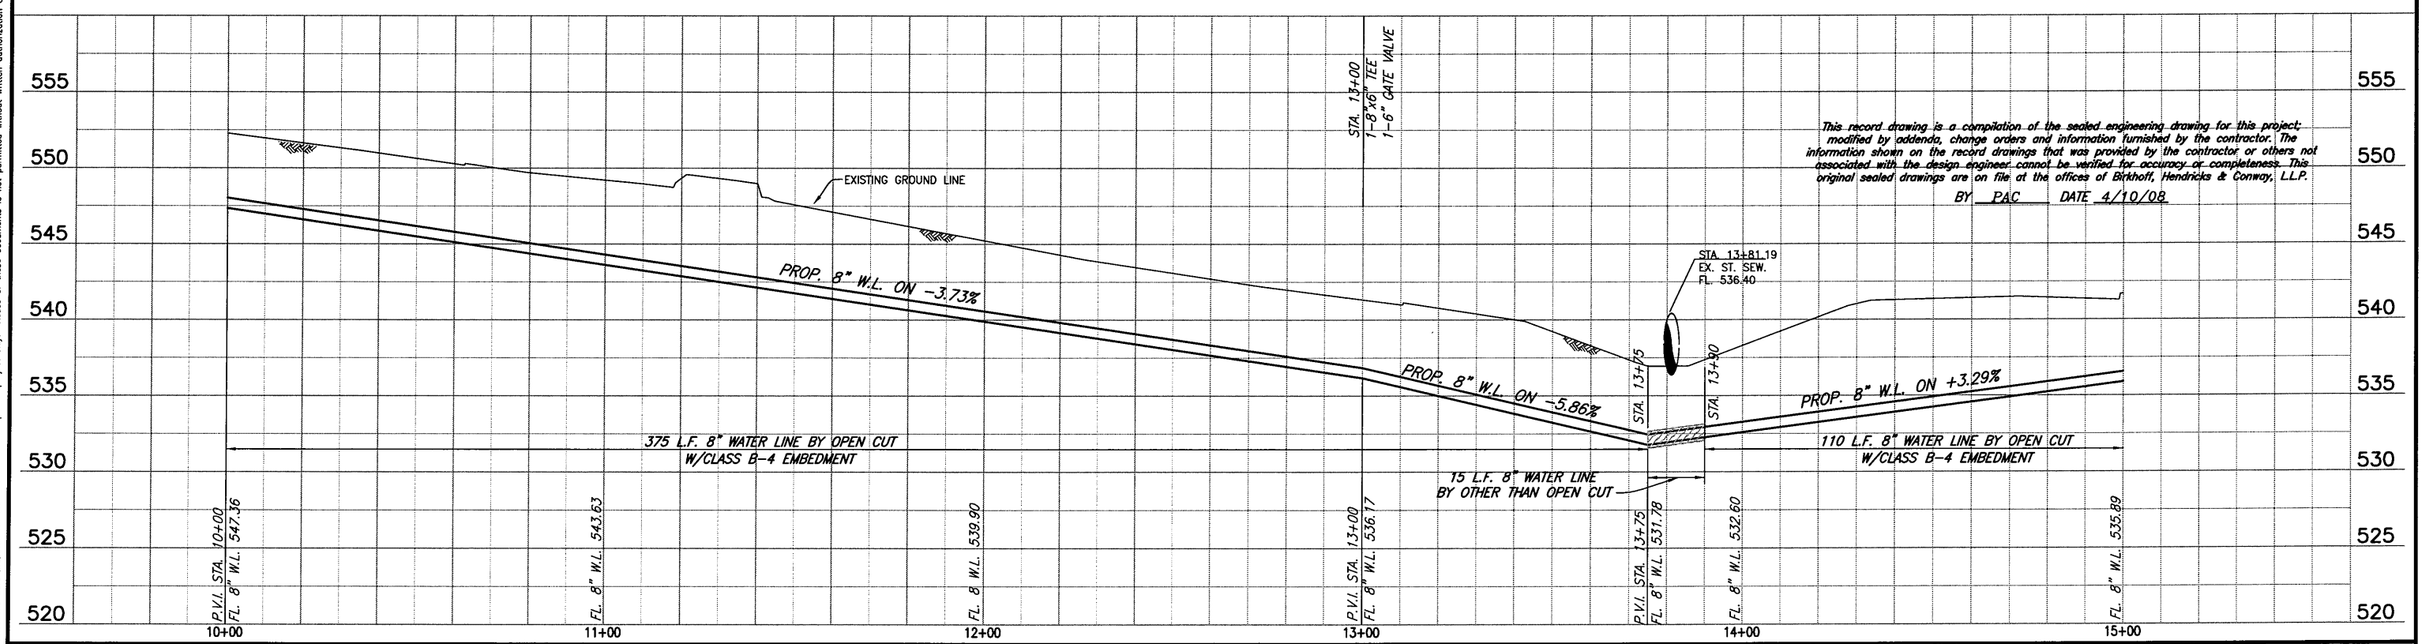

This record drawing is a compilation of the sealed engineering drawing for this project; modified by addenda, change orders and information furnished by the contractor. The information shown on the record drawings that was provided by the contractor or others not associated with the design engineer cannot be verified for accuracy or completeness. This original sealed drawings are on file at the offices of Birkhoff, Hendricks & Conway, L.L.P.

BY PAC DATE 4/10/08

BIRKHOFF, HENDRICKS & CONWAY, L.L.P.
CONSULTING ENGINEERS
7502 Greenville Ave., Suite 220
Dallas, Texas
(214) 361-7900

STATE OF TEXAS
PAUL A. CARLINE
85400
LICENSED
PROFESSIONAL ENGINEER

THESE DOCUMENTS ARE FOR BIDDING, CONSTRUCTION, AND PERMIT PURPOSES.
DATE: 6/12/07

CITY OF ROCKWALL, TEXAS
WALLACE LANE WATER LINE
8" WATER LINE (LINE C)
PLAN-PROFILE
STA. 10+00 TO STA. 15+00

BHC PROJECT NO. 2006-150
January, 2008

SHEET NO. 27

These plans and related specifications were prepared for construction of this specific project only. Reuse of these documents is not permitted without written authorization of Birkhoff, Hendricks, & Conway, L.L.P.