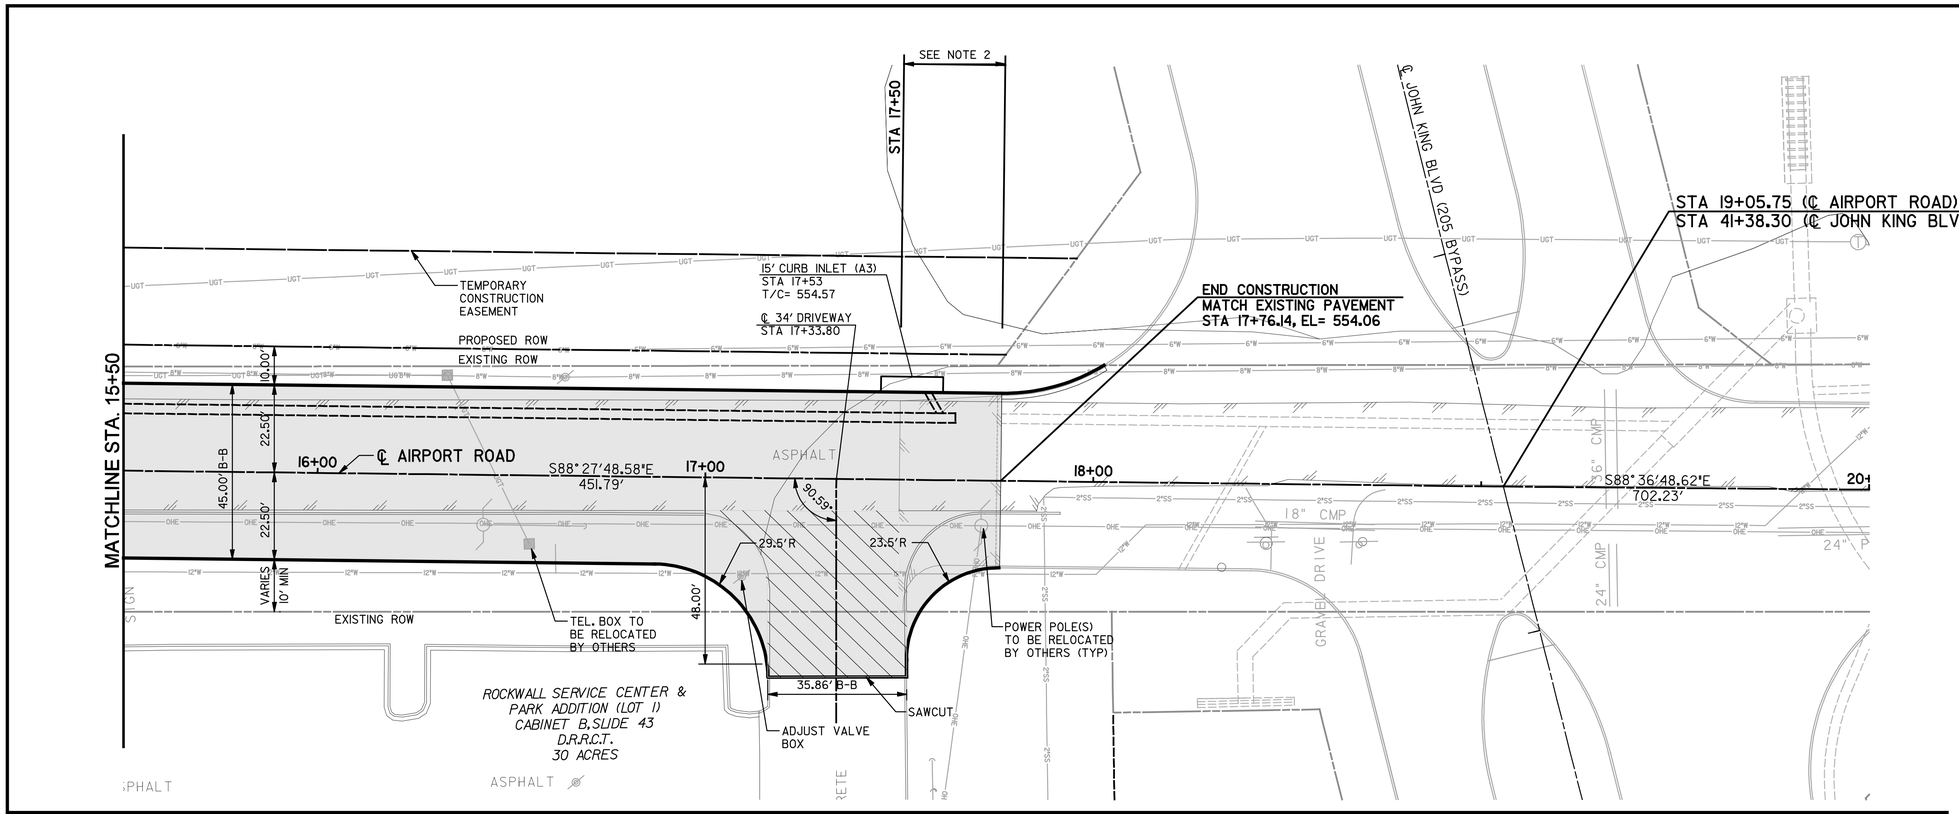

N

20 0 20 40
SCALE IN FEET
HORIZONTAL

5 0 5 10
SCALE IN FEET
VERTICAL

LEGEND

- PROPOSED CONCRETE PAVEMENT
- PROPOSED HMAC PAVEMENT
- EXISTING CONCRETE TO BE REMOVED
- CURB INLET
- MANHOLE
- DRAINAGE FLOW
- ×451.25 SPOT ELEV. (PROP.)

NOTE:

1. ALL DIMENSIONS ARE TO BACK OF CURB UNLESS OTHERWISE NOTED.
2. TRANSITION PAVEMENT SECTION FROM NORMAL PARABOLIC TO CONSTANT CROSS-SLOPE AT TIE-IN TO EXISTING PAVEMENT AT JOHN KING BLVD.

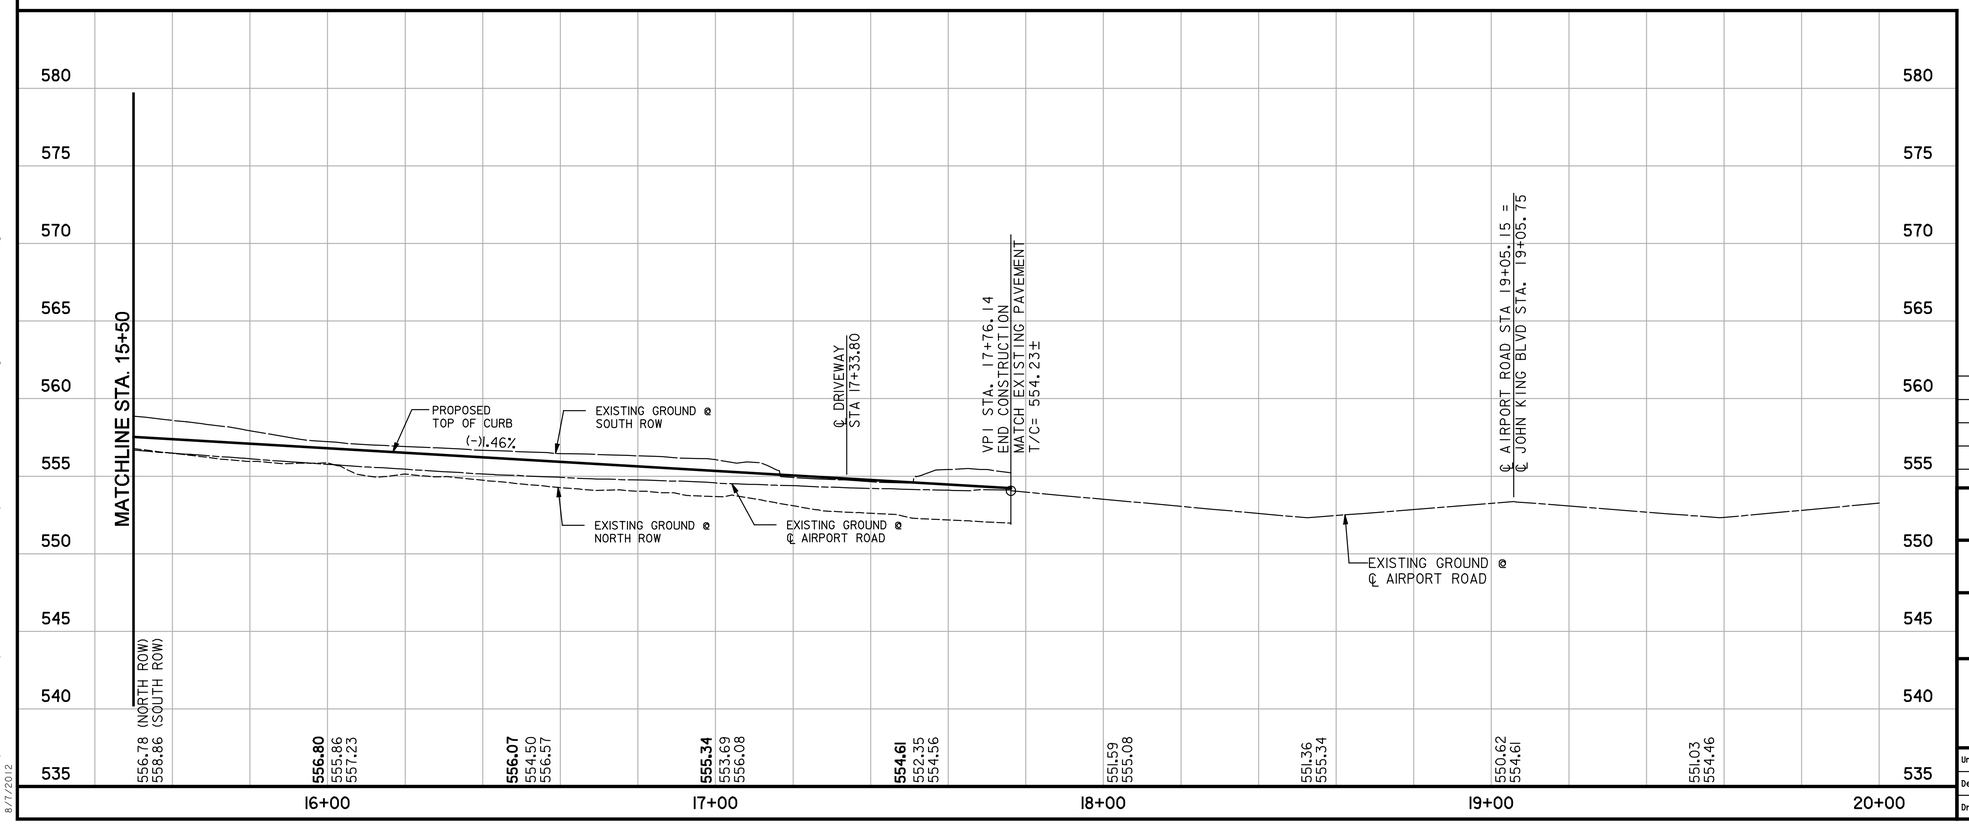

NO.	REVISION	BY	DATE

AIRPORT ROAD

PLAN & PROFILE
STA. 15+50 TO STA. 17+76

City of Rockwall, Texas

AECOM

AECOM TECHNICAL SERVICES, INC.
16000 DALLAS PARKWAY, SUITE 350
DALLAS TEXAS 75248
WWW.AECOM.COM
TBPE REG. NO. F-3580

Unit	PW-DAL	Scale:	Horiz: AS SHOWN Vert: AS SHOWN	Date	8/2/2012
Designed	THG	Checked	THG	Project No.	60004153
Drawn	JJ	Approved	THG	Sheet	15 of 26

\\usdallfp002\PW\4328\Airport_Road\CADD\Sheet\Airport Road_Record Drawings_8-3-10\15_PP_04.dgn
8/7/2012