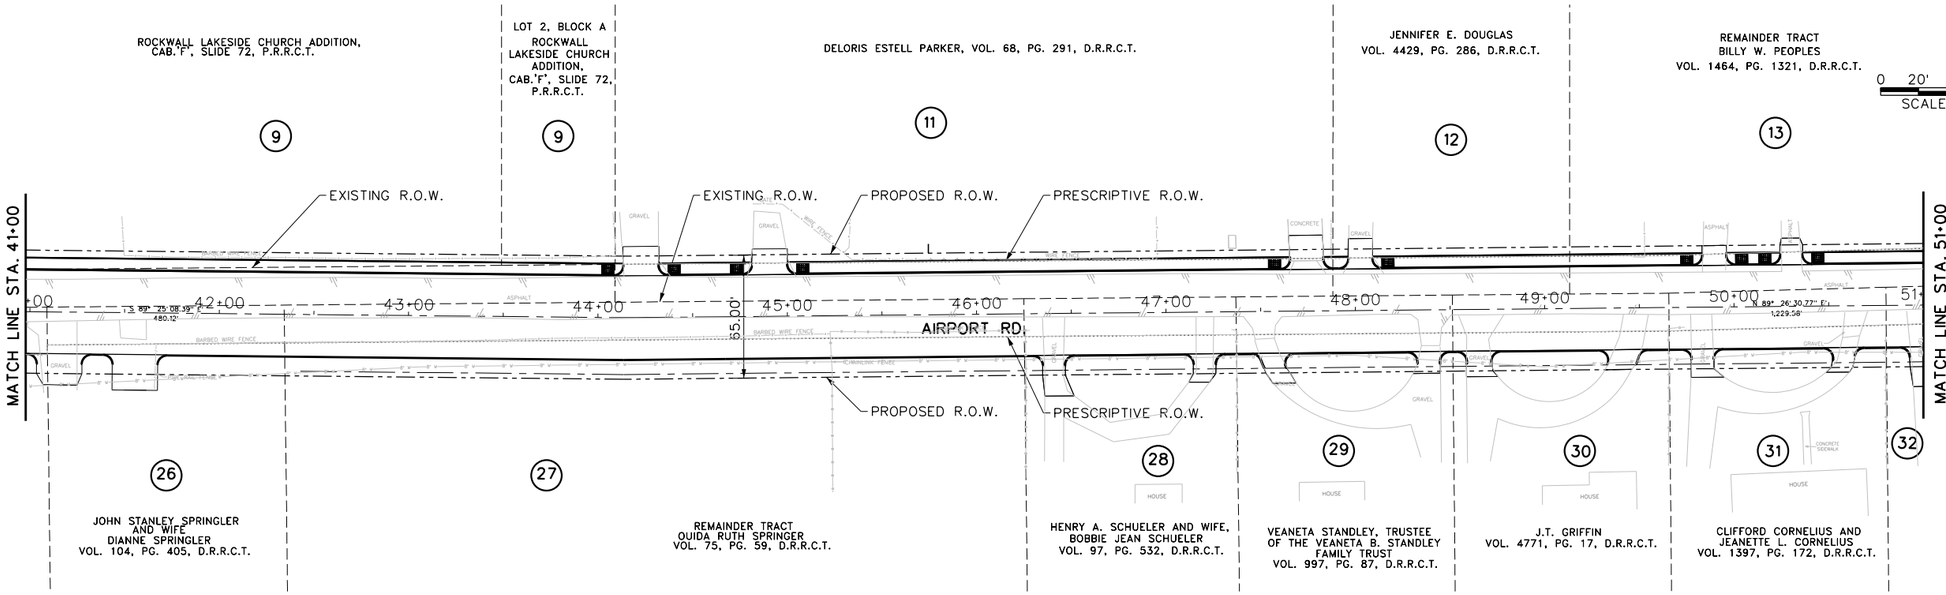

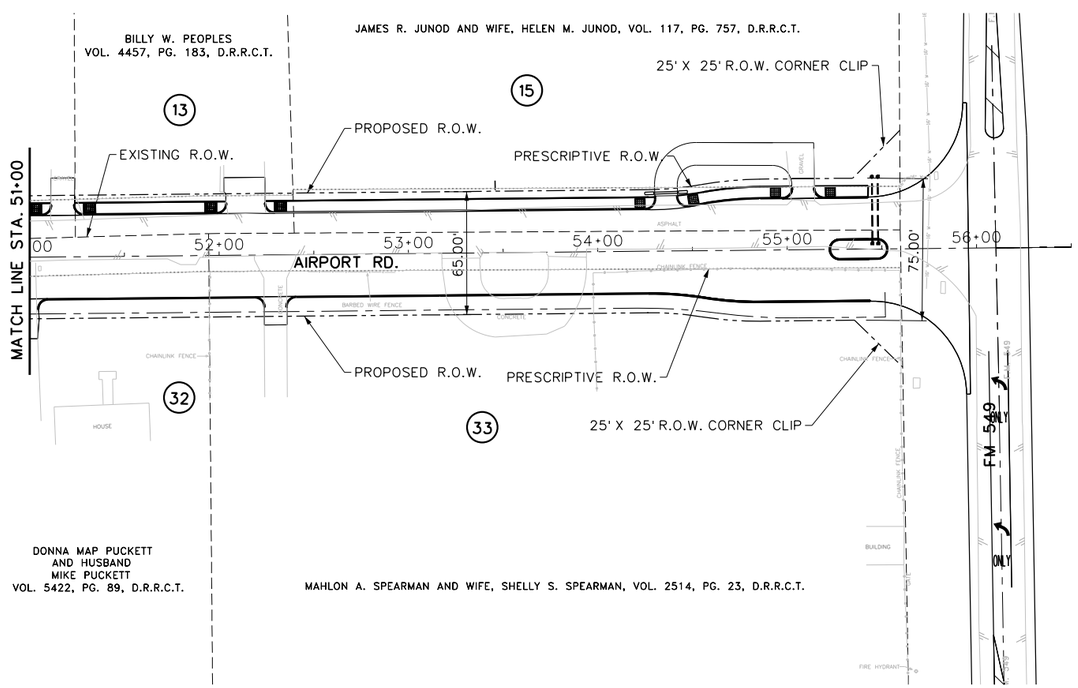

LEGEND

- PROPOSED ROW
- EXISTING ROW
- PRESCRIPTIVE ROW
- (#) ROW DOCUMENT NUMBER

NOTE:
PROPERTY OWNER NAMES AND ADDRESSES SHOWN ARE TO THE BEST OF OUR KNOWLEDGE. FOR THE LATEST INFORMATION, PLEASE REFER TO THE RIGHT-OF-WAY DOCUMENTS, AVAILABLE FROM CITY UPON REQUEST.

This Record Drawing is a combination of the sealed engineering contract drawings for this project and field alterations as marked by the contractor reflecting changes in the project as constructed. The original sealed drawings are on file at the office of
FREESE AND NICHOLS, INC.
4055 INTERNATIONAL PLAZA, SUITE 200
FORT WORTH, TEXAS 76109
(817) 735-7300 RECORD DRAWINGS
FIRM # F-2144
11/18/2013

THE SEAL THAT ORIGINALLY APPEARED ON THIS DOCUMENT WAS REGISTERED UNDER Kevin R. Janusz 74411 ALTERATION OF A SEALED DOCUMENT WITHOUT PROPER NOTIFICATION OF THE PROFESSIONAL ENGINEER IS A VIOLATION OF THE TEXAS ENGINEERING PRACTICE ACT.

Freese and Nichols, Inc. Texas Board of Professional Engineers Reg. No. F-2144

FREESE NICHOLS
9701 N. Market Street, Suite 500, LB 51
Dallas, TX 75202-2001
Phone - (214) 217-2200
Fax - (214) 217-2220
Web - www.freese.com

CITY OF ROCKWALL, TEXAS
AIRPORT ROAD RECONSTRUCTION
CIVIL
RIGHT-OF-WAY MAP
STA 41+00 TO END

NO.	ISSUE	BY	DATE

VERIFY SCALE Bar is one inch on original drawing. If not one inch on this sheet, adjust scale.
0 1

F&N JOB NO.	ROK08461
DATE	05/15/12
DESIGNED	KRJ
DRAWN	SLI
REVISED	
CHECKED	
FILE NAME	cv-trt-gn-rowm03.sht

SHEET RW-3
SEQ. 8 OF 79

MicroStation V8 User: 02069Office: Dallas
ROK08461 N:\IF\Drawings\cv-trt-gn-rowm03.sht
Plotted by SLI on Jan 29, 2013 - 08:12:07 AM Plotter: HP Designjet 1055CM-C6073A Model: Default
Plot Scale: 80.0000 ' / in. Project: Freese and Nichols, Inc.
Date: Jan. 29, 2013 - 08:12:07 AM

cv-trt-pl-alignd1.dgn
cv-trt-pl-roadway01.dgn
cv-trt-pl-design01.dgn
RS
cv-trt-pl-topo.dwg

34Border.dgn
cv-trt-pl-alignd1.dgn
cv-trt-pl-roadway01.dgn
cv-trt-pl-design01.dgn
cv-trt-pl-topo.dwg