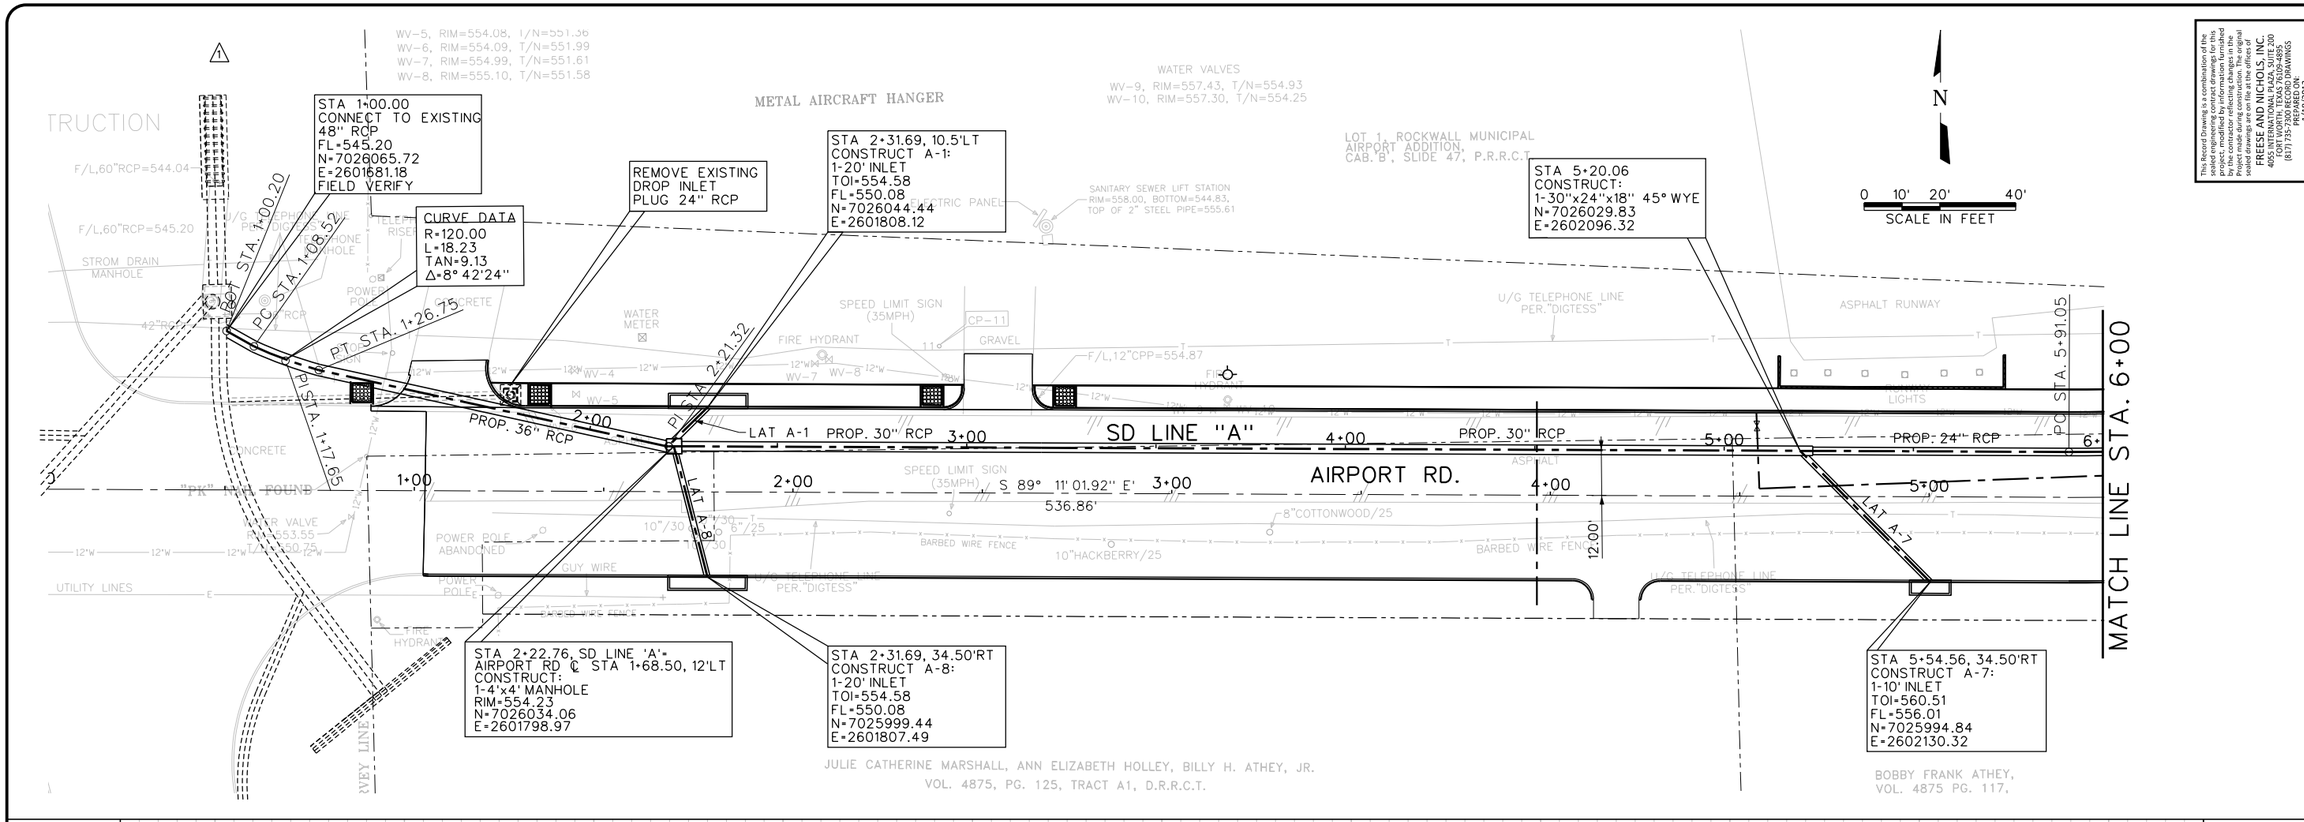

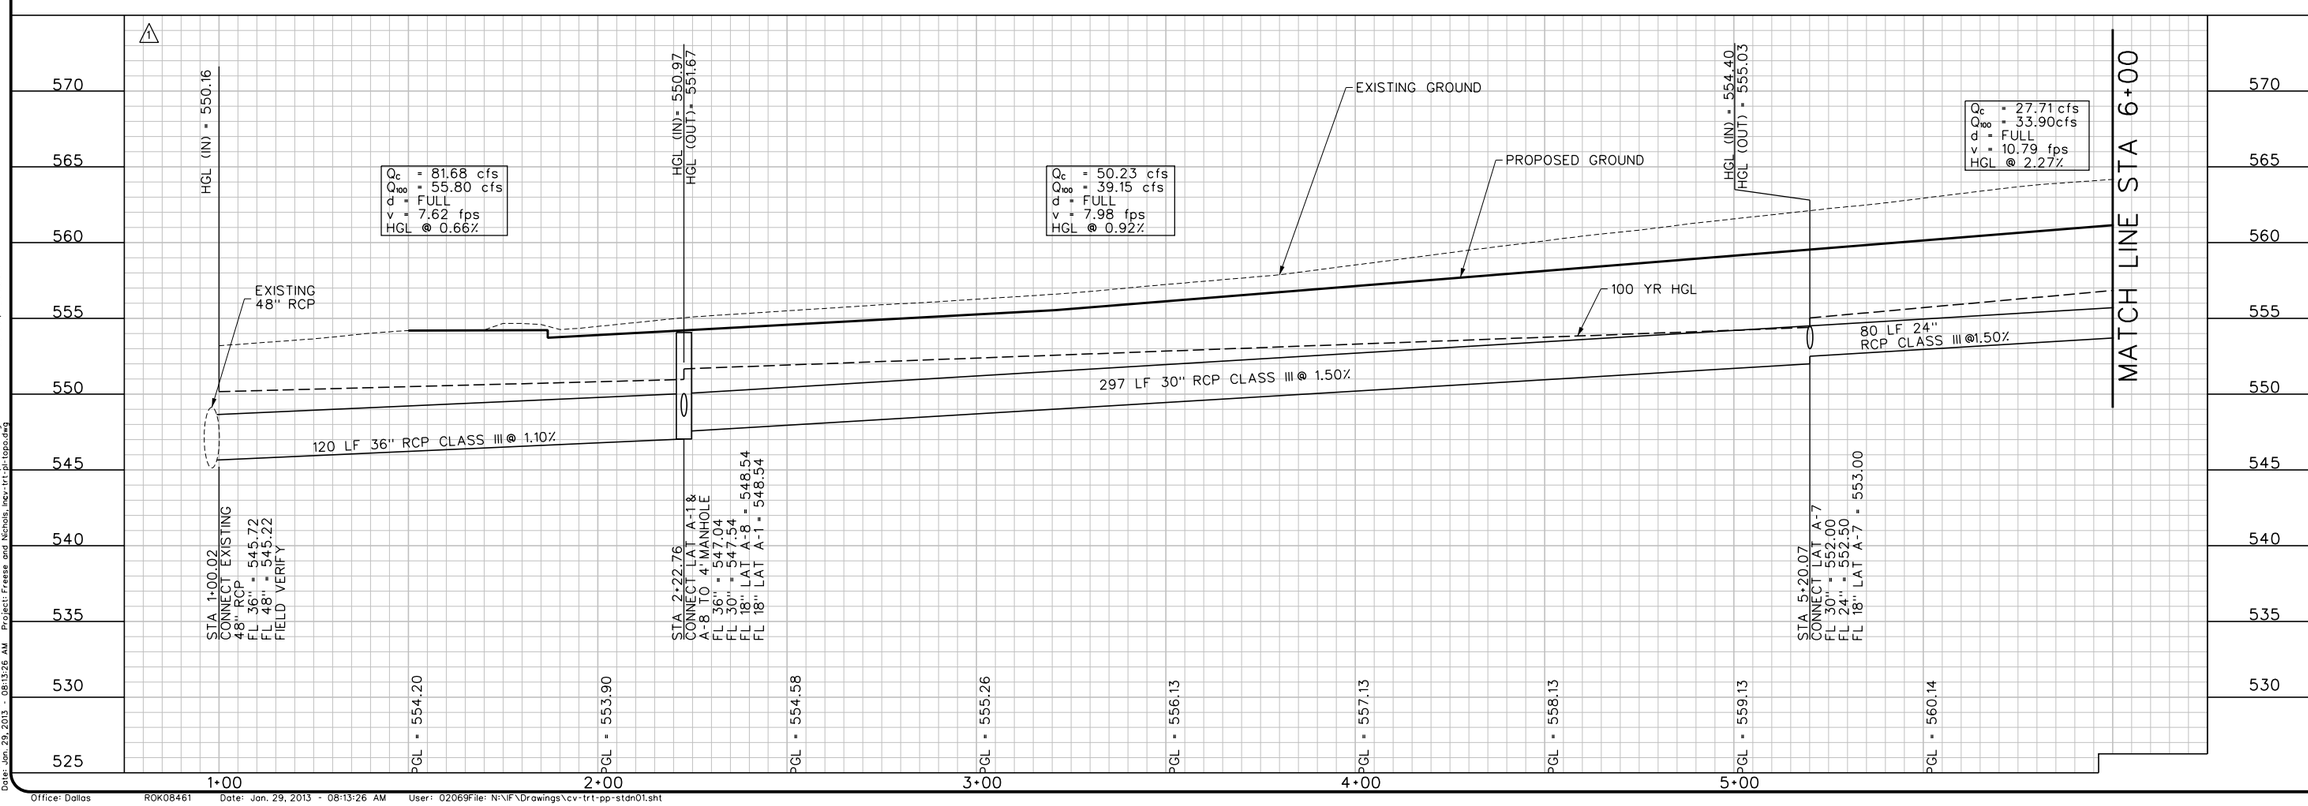

This Record Drawing is a combination of the sealed engineering contract drawings, for which the seal, signature and date have been affixed by the contractor reflecting changes in the field provided to Freese and Nichols. The original sealed drawings are on file at the offices of FREESE AND NICHOLS, INC. 4055 INTERNATIONAL PLAZA, SUITE 200 FORT WORTH, TEXAS 76109 (817) 735-7300 RECORD DRAWINGS PREPARED BY: 11/18/2013

THE SEAL THAT ORIGINALLY APPEARED ON THIS DOCUMENT WAS REMOVED PURSUANT TO TEXAS ADM. CODE 137.33 ON DATE: 2/4/11. ALTERATION ON A SEALED DOCUMENT WITHOUT PROPER AUTHORITY TO DO SO IS PROHIBITED AND MAY CONSTITUTE AN OFFENSE UNDER THE TEXAS ENGINEERING PRACTICE ACT.

Freese and Nichols, Inc. Texas Board of Professional Engineers Reg. No. F-244

FREESE AND NICHOLS
9400 N. Broadway, Suite 600
Oklahoma City, OK 73114
(405) 848-8000
www.freese.com

CITY OF ROCKWALL, TEXAS

AIRPORT ROAD RECONSTRUCTION

CIVIL

STORM DRAIN PLAN AND PROFILE BEGINNING TO STA 6+00

NO.	ISSUE	BY	DATE
1	SD LINE A REALIGNMENT	RMW	8/8/11

F&N JOB NO.	ROK08461
DATE	05/15/12
DESIGNED	KRJ
DRAWN	SLI
REVISED	
CHECKED	
FILE NAME	cv-trt-pp-stdn01.sht

VERIFY SCALE Bar is one inch on original drawing. If not one inch on this sheet, adjust scale.

SHEET SD-1

SEQ. 38 OF 79

MicroStation V8 User: 02069Office: Dallas
ROK08461 N:\IF\Drawings\cv-trt-pp-stdn01.sht
Plot: Plot Driver: HP7550.pltcfg Pen Table: Model: Default
Plot Scale: 40.0000 ' / in. Project: Freese and Nichols, Inc.-Trt-pp-stdn01.dwg
Date: Jan. 29, 2013 - 08:13:26 AM

Office: Dallas ROK08461 Date: Jan. 29, 2013 - 08:13:26 AM User: 02069File: N:\IF\Drawings\cv-trt-pp-stdn01.sht