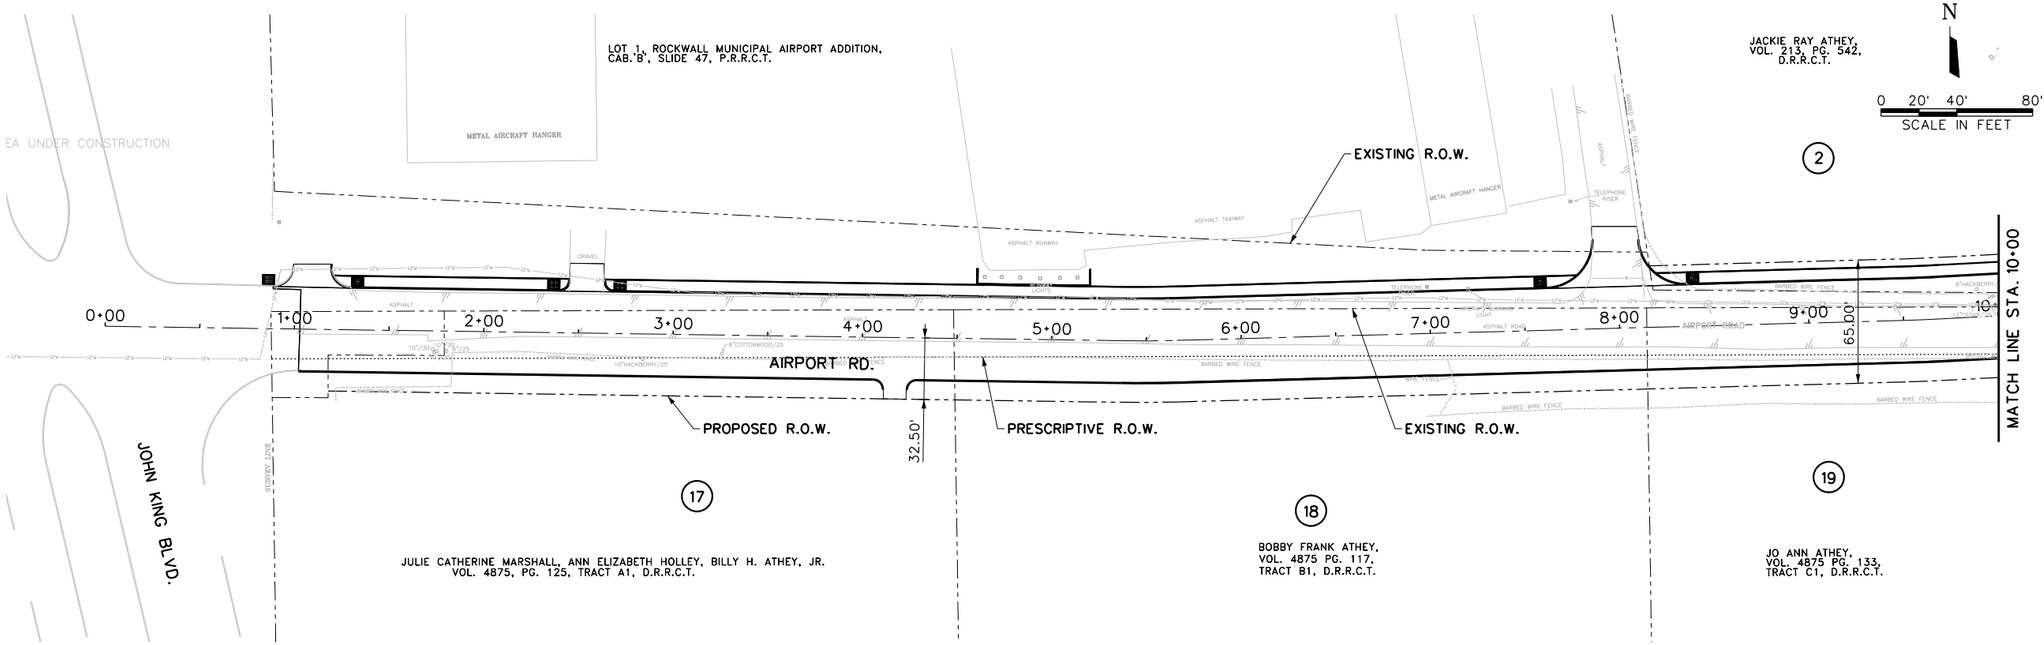

LEGEND

- PROPOSED ROW
- EXISTING ROW
- PRESCRIPTIVE ROW
- # ROW DOCUMENT NUMBER

NOTE:
PROPERTY OWNER NAMES AND ADDRESSES SHOWN ARE TO THE BEST OF OUR KNOWLEDGE. FOR THE LATEST INFORMATION, PLEASE REFER TO THE RIGHT-OF-WAY DOCUMENTS, AVAILABLE FROM CITY UPON REQUEST.

This Record Drawing is a combination of the sealed engineering contract drawings for this project, modified by information furnished by the contractor reflecting changes in the project made during construction. The original sealed drawings are on file at the office of

FREESE AND NICHOLS, INC.
4055 INTERNATIONAL PLAZA, SUITE 200
FORT WORTH, TEXAS 76109-4895
(817) 735-7300 RECORD DRAWINGS
PREPARED ON:
1/18/2013

THE SEAL THAT ORIGINALLY APPEARED ON THIS DOCUMENT WAS AUTHORIZED BY Kevin R. Johnson TEXAS NO. 93882 ON DATE: 2/4/11 ALTERATION ON A SEALED DOCUMENT WITHOUT PROPER NOTIFICATION OF THE RESPONSIBLE ENGINEER IS AN OFFENSE UNDER THE TEXAS ENGINEERING PRACTICE ACT.

Freese and Nichols, Inc. Texas Board of Professional Engineers Reg. No. 2144

FREESE NICHOLS
1701 N. Market Street, Suite 500, LB 51
Dallas, TX 75202-2001
Phone - (214) 217-2200
Fax - (214) 217-2201
Web - www.freese.com

CITY OF ROCKWALL, TEXAS
AIRPORT ROAD RECONSTRUCTION
CIVIL
RIGHT-OF-WAY MAP
BEGIN TO STA 20+50

NO.	ISSUE	BY	DATE

F&N JOB NO. ROK08461
DATE 05/15/12
DESIGNED KRJ
DRAWN SLI
REVISED
CHECKED
FILE NAME cv-trt-gn-rowm01.sht

VERIFY SCALE Bar is one inch on original drawing. If not one inch on this sheet, adjust scale.

SHEET RW-1
SEQ. 6 OF 79

MicroStation V8 User: 02069Office: Dallas
ROK08461 N:\IF\Drawings\cv-trt-gn-rowm01.sht
Plotter: Plotter_V8.1\PDF_File\PDF-Mono-Half.plt
Plot Scale: 80.0000 '/ in. Model: Default
Date: Jan. 29, 2013 - 08:12:04 AM Project: Freese and Nichols, Incv-trt-pl-topo.dwg
34Border.dgn
cv-trt-pl-align01.dgn
cv-trt-pl-row01.dgn
cv-trt-pl-design01.dgn
$R9$
cv-trt-pl-topo.dwg

Office: Dallas ROK08461 Date: Jan. 29, 2013 - 08:12:04 AM User: 02069File: N:\IF\Drawings\cv-trt-gn-rowm01.sht