


INSTALL:
 1- 6" FIRE HYDRANT
 AND ASSEMBLY
 1- 6" VALVE
 1- 12" VALVE
 1- 12" PLUG

END OF ASPHALT

SBC LINES

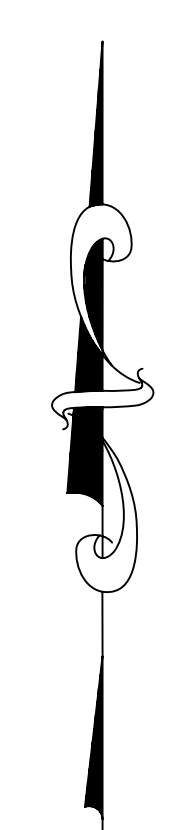

390 LF OF 12" WTR

EX. ASPHALT
 MUST KEEP
 THROUGH ACCESS
 DURING CONSTRUCTION

WARNING:
 STAY COMPLETELY OFF THIS
 PROPERTY!!!!!!!

MUNICIPAL AIRPORT

INSTALL:
 1- 6" FIRE HYDRANT
 VALVE & ASSEMBLY

BARB WIRE FENCE

PROP. 12" WATER
 (CLASS 200)

SBC LINES

300 LF OF 12" WTR

AS-BUILT

5' OFF FENCE

PROP. LINE

EX. BLDG


CONNECT TO
 EX. 12" STUBOUT

EX. 12" WTR

AIRPORT ROAD

12" WATER LINE

MUNICIPAL AIRPORT

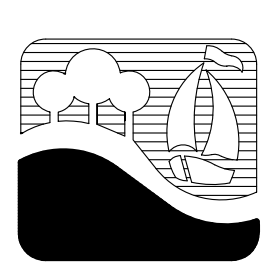

CITY OF ROCKWALL
 "THE NEW HORIZON"

SCALE
 1 inch = 50 ft.

DATE
 DEC. 06

DRAWING NAME
 PH1-WATER