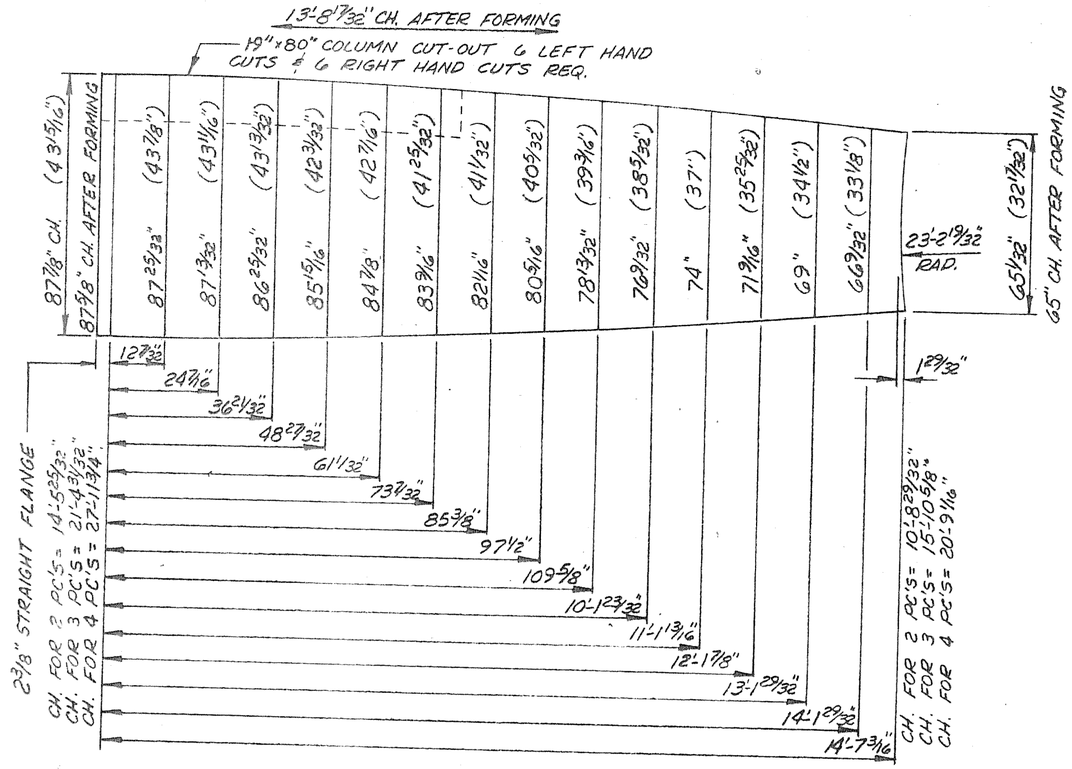

BOWL KNUCKLE

1/8" R (102 7/16") A.S.T.M. A-283 GR. C
24 SECTIONS REQ. PRESS TO 13'-0" RAD.
(955 LBS)

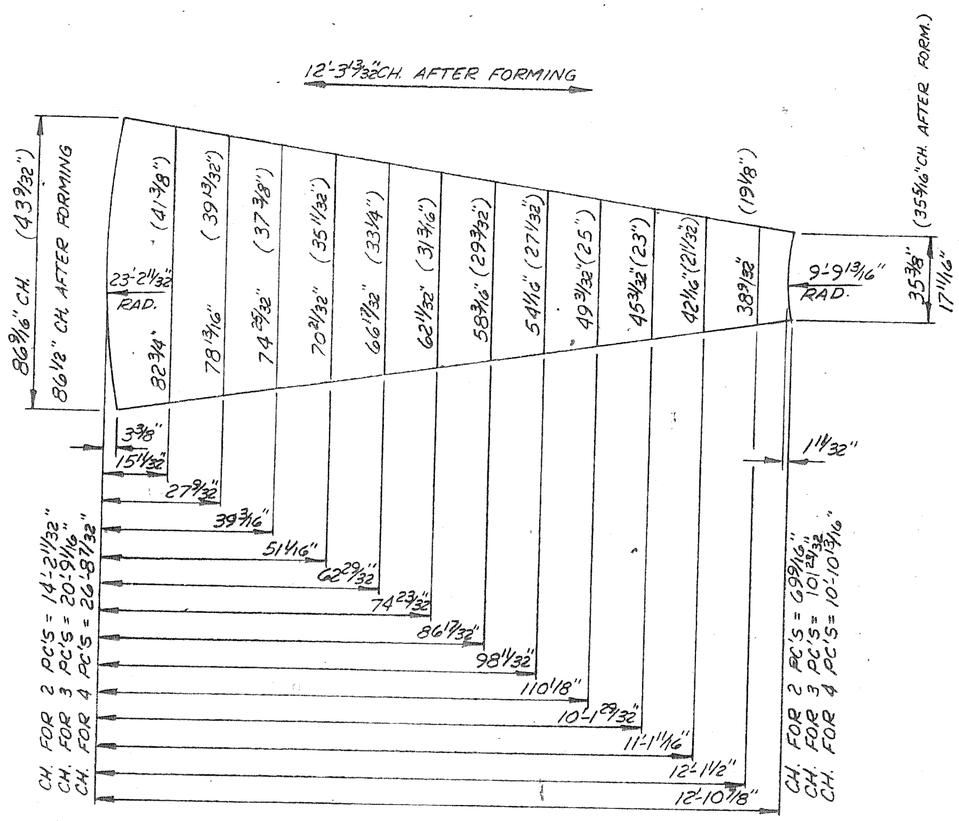

BOWL FINGER

1/4" R (102 7/16") A.S.T.M. A-283 GR. C
18 SECTIONS REQ. PRESS TO 13'-0" RAD.
(665 LBS)

NO.	DATE	BY	REVISION

UNIVERSAL TANK & IRON WORKS, INC.
INDIANAPOLIS, INDIANA

ENGINEER APPROVAL

☑ APPROVED ☐ APPROVED AS CORRECTED
☐ NOT APPROVED – REVISE AND RESUBMIT
CHECKED FOR GENERAL COMPLIANCE WITH PLANS AND SPECIFICATIONS. CONTRACTOR SHALL VERIFY ALL DIMENSIONS AND QUANTITIES, AND COORDINATE EQUIPMENT ASSEMBLY AND WORK OF ALL TRADES. NO DEVIATION FROM PLANS AND SPECIFICATIONS PERMITTED UNLESS SPECIFICALLY NOTED.
FREESE AND NICHOLS, CONSULTING ENGINEERS
BY [signature] DATE 4-27-78

BOWL DETAIL
56'-0" DIA. 500,000 GAL.

FOR:
ROCKWALL, TX.

DATE: 4-25-78 | SCALE: NONE
DRWN BY: LD/[illegible] | CHECKED: V.L.R.
JOB NO: 6544 | SHEET 8 OF 9

MARBAUGH ENG. SUPPLY